

**FINALIZED**


STATE	PROJECT NO.	SHEET	TOTAL SHEETS
ARIZONA	I-10-5(4)262	13	13

RIGHT OF WAY MAP NO. D-10-T-290  
 Original Approval: 7-26-60 & 6-15-62  
 ALIGNMENT, RIGHT OF WAY AND CONTROL OF ACCESS APPROVED IN ACCORDANCE WITH HIGHWAY PLANS  
 Revised Approval: 9-12-1963  
 APPROVED IN ACCORDANCE WITH RESOLUTION DATED JULY 26, 1960, BY THE ARIZONA HIGHWAY COMMISSION BY RES. G-21

SEE NO. 80450



STATE OF ARIZONA  
 STATE HIGHWAY DEPARTMENT

RIGHT OF WAY PLAN OF THE  
**TUCSON-BENSON U.S. 80**  
 STATE HIGHWAY  
 PROJECT NO. I-10-5(4)262  
 PIMA COUNTY

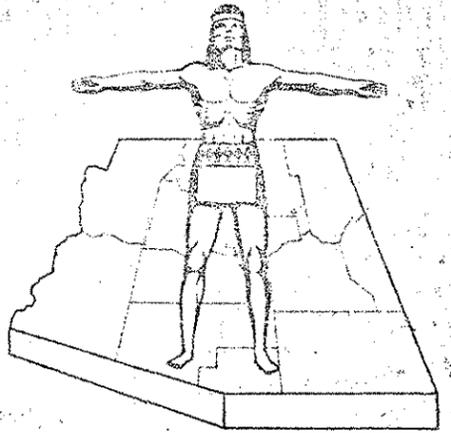

**NOTE:**

THE SOLID DOT, AS SHOWN BELOW, DOES NOT DESIGNATE A R/W MARKER BUT REPRESENTS AN ANGLE POINT OR CHANGE OF DIRECTION IN THE R/W LINE & IS FOR OFFICE USE ONLY

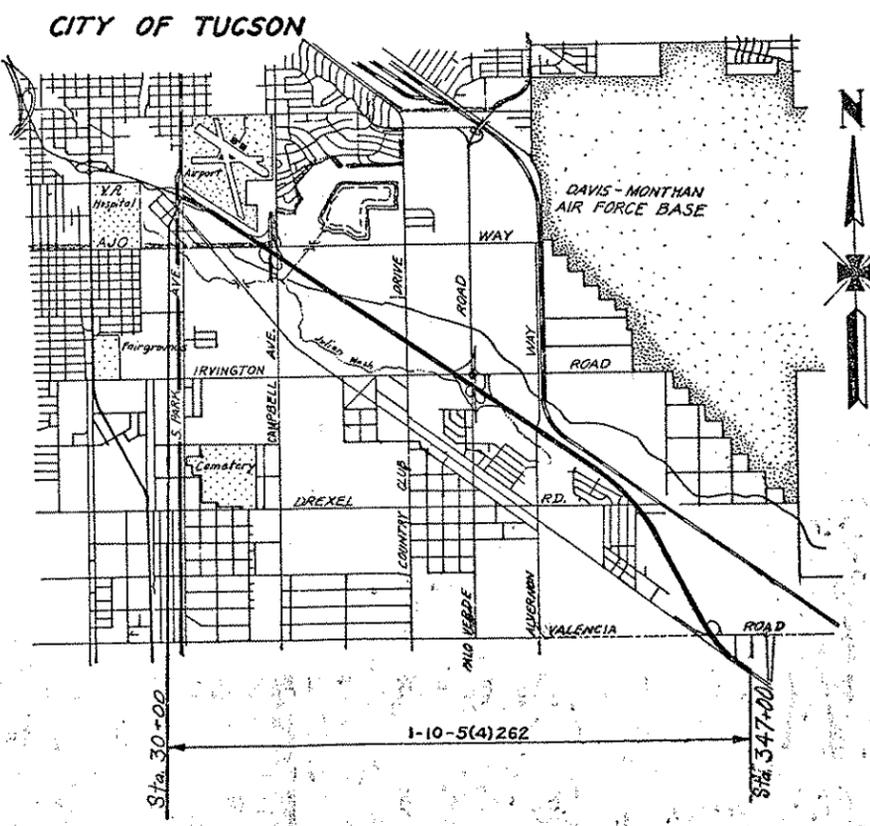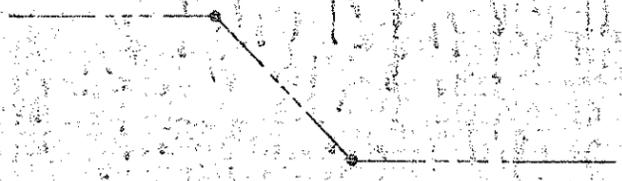

**CONVENTIONAL SIGNS**

HIGHWAY CENTER LINE	TELEPHONE LINE
STATE AND NATIONAL LINES	POWER LINE
CITY LIMITS	WATER LINE
COUNTY LINE	GAS LINE
TOWNSHIP AND RANGE LINES	SEWER LINE
SECTION LINE	STORM DRAIN
HIGHWAY R/W LINE (NEW)	UNDERGROUND TEL. CABLE
RAILROAD R/W LINE	BARBED WIRE FENCE
PROPERTY LINE	CHAIN LINK FENCE
LOT AND PROPERTY LINE (WITHIN EXISTING R/W)	POWER TRANSMISSION LINE
RAILROAD	TELEPHONE & POWER LINE
COMMON RR AND H/W R/W LINE	POWER POLE WITH TRANSFORMER
ACCESS TO BE DENIED	DOWN GUY
ACCESS AREA	LIGHT POLE
PARCEL ITEM NO'S	FIRE HYDRANT
FOREST, NAT'L MONUMENTS AND INDIAN BOUNDARIES	WATER METER
LAND GRANT BOUNDARY	WATER VALVE
R/W MARKER	MANHOLE
HIGHWAY R/W LINE (EXISTING)	EXIST. ROAD OR TRAVELED WAY
BOUNDARY OF LOT LINE	GAS METER
	GAS VALVE

ARIZONA HIGHWAY COMMISSION  
 APPROVED (REVISED) FOR R/W ACQUISITION  
 STATE HIGHWAY ENGINEER  
 DEPARTMENT OF COMMERCE  
 BUREAU OF PUBLIC ROADS  
 APPROVED (REVISED)  
 DIVISION ENGINEER DATE

MAP REVISIONS			
C.O. NO.	DATE	NAME	DESCRIPTION
2775	11-23-70	Hartrim	FINALIZED - Changes Shown In Orange

**TUCSON-BENSON HIGHWAY - U.S. 80  
VETERANS OVERPASS-EAST  
PIMA COUNTY**

REVISIONS			PROJECT NO.
C.O.	DATE	BY	1-10-5(4)262
4293	J.H.J.	J.H.J.	DRAWING NO. D-10-T-290
Revised owners name and areas on Parcel A-82, A-93 & Added Pt Lot 3, Sec 4 to A-89			SHEET NO. 2 of 13
5182	J.H.J.	J.H.J.	DRAWN BY Jan Croffey John Junger
5843	J.H.J.	J.H.J.	DATE COMP. 3-8-63
144	L.F.N.	L.F.N.	SCALE 1"=100'
149	J.H.J.	J.H.J.	
229	J.H.J.	J.H.J.	
270	J.H.J.	J.H.J.	

ACQUISITION RECORD					OWNERSHIP RECORD									
COMMISSION APPROVAL	TYPE OF INSTRUMENT	DATE	RECORDED		PARCEL NUMBER	OWNER	DESCRIPTION	TOTAL AREA	AREA GROSS INCLUDING EXISTING R/W	AREA NET EXCLUDING EXISTING R/W	EASEMENT AREA	REMAINDER		SHEET NUMBER
			BOOK	PAGE								LEFT	RIGHT	
5-19-64	F.O.C. 3-22-66	4-14-66	2723	183-6	A-71	Walter E. & Helen A. Murphy et al	Pt Lots 2 & 3 Sec 30 T145 R14E	14.8	2.7	12.1		3.4	8.0	4
3-19-64	F.O.C. 3-18-65	4-14-66	3336	172-4	A-72	Alice Dec. Gallo (SEE A-72-1 BELOW FOR LEASEHOLD)	Pt E 1/2 SW 1/4 Sec 30	21.1	11.8	11.4		1.3	8.1	4
4-14-64	F.O.C. 3-9-66	3-30-66	2712	140-2	A-73	Maud C. Mumm (Widow)	Pt E 1/2 SW 1/4 Sec 30	10.3	2.5	2.5		0.4	2.1	4
2-28-64	W.D. 2-15-64	4-9-64	2247	336-7	A-74	LeRoy Verda Mellott	Pt SE 1/4 SW 1/4 Sec 30	2.9	675 Sq Ft	675 Sq Ft		2.9	4.5	4
5-19-64	F.O.C. 10-24-64	12-3-64	2382	332-3	A-75	Harold M. & Florence Hartley	Pt SE 1/4 Sec 30	72.7	28.3	26.6	0.8	28.8	5.6	4
6-26-64	W.D. 6-16-64	7-30-64	2299	580-1	A-76	Benson Hwy. Development Co. Inc.	100' Strip in the NW 1/4 Sec 32	5.4	0.7	0.7		2.5	2.2	4
7-10-64	Esmt. 6-25-64	8-25-64	2315	365-7	A-77	Pima County	Pt SW 1/4 SW 1/4 Sec 29; NE 1/4 SW 1/4 Sec 32	253.0	41.3	29.0		147.9	63.3	4
5-19-64	F.O.C. 8-12-66	1-23-67	2916	172-8	A-78	Hughes Tool Co.	W 1/2 SW 1/4 SE 1/4 SW 1/4 SE 1/4 Sec 33 Lot 2, SW 1/4 NE 1/4 Lot 1 Sec 4 T155 R14E	393.6 397.3	83.3	46.7		336.8	77.2	6,7,8 9,10,11 12
6-15-64	W.D. 12-22-67	8-6-68	3302	166-172	A-80	Addie Heywood BENJAMIN S. ANDERSON, ET AL	Pt SE 1/4 SE 1/4 Sec 32 T145 R14E	2.0	0.1	0.1		5.7	1.9	8
5-19-64	F.O.C. 1-18-65	2-4-65	2425	233-5	A-81	Arizona Building Co et al	Pt East 200' SE 1/4 Sec 30	8.2	2.5	2.2		6.9	5.7	6,7,8
11-8-63	W.D. 10-11-63	12-13-63	2194	430-1	A-82	George A. & Della I. Conway	Pt NE 1/4 SE 1/4 Sec 32	13.09	1.3	0.9		6.0	7.8	8
2-17-59	W.D. 1-15-59	3-6-59	1392	196-7	A-83	Hyman & Francis Epstein	Pt NE 1/4 SE 1/4 Sec 32	0.5	0.5	0.5		0.4	1.0	7,8
11-8-63	W.D. 8-18-63	11-15-63	2182	355-6	A-84	Inland Land Co. Corp.	Pt NE 1/4 SE 1/4 Sec 32	3.1	1.7	1.4		0.0	8	
10-24-58	W.D. 11-28-58	12-2-58	1345	596-7	A-85	Edgar S. & Gertrude Holly	Pt NE 1/4 SE 1/4 Sec 32	1.07		0.54		0.0	7,8	
2-28-64	W.D. 2-17-64	4-2-64	2244	168-9	A-86	William J. & Phyllis Benson	Pt NE 1/4 SE 1/4 Sec 32	1.0	2340 Sq Ft	2340 Sq Ft			8,9	
12-1-64	F.O.C. 3-7-66	4-14-66	2723	175-8	A-87	Tucson Title Ins. Co. (Trust No 207584)	Lot 3, Sec 4 T155 R14E	377.337	12.9	9.6	1796 Sq Ft		27.9	10,11
10-11-63	W.D. 8-16-63	11-8-63	2179	237-240	A-88	S.D. Pottorff	Pt SW 1/4 NW 1/4 Sec 3	8.0	6.8	6.8	0.1	1.2	10	
5-19-64	F.O.C. 8-15-67	8-31-67	3069	134-8	A-89	Tucson Gas, Electric Light & Power Co.	W 1/2 NW 1/4 SW 1/4 (Pt SE 1/4 SE 1/4 Sec 3)	30.6	3.7	1.5	1.2	7.3	18.4	10,11
6-2-59	W.D. 5-13-59	6-26-59	1451	391-2	A-90	C.B. & Leone Luke Briggs	Pt E 1/2 NW 1/4 SW 1/4 Sec 3	19.5		4.68		14.82	10	
12-29-58	W.D. 12-30-58	1-12-59	1364	429-430	A-91	Randolph & Julia S. Jenks	Pt E 1/2 SW 1/4 (Pt SW 1/4 SE 1/4 Sec 3, Lying South of R.R. & North of Estrella Sub T155 R14E	43.42	23.6	23.32		22.17	20.1	10,11
10-24-58	W.D. 12-10-58	12-12-58	1351	507-8	A-92	John F. & Dolores M. Tylutki	Lot 1 Estrella Sub.	2.5		0.06		0.29	0.19	11
5-19-64	F.O.C. 5-2-67	5-10-67	2990	126-9	A-93	L.H. Kohl et al	Pt SE 1/4 NE 1/4 SW 1/4 Lot 2, Sec 30 Pt NE 1/4 NE 1/4 Sec 31 T145 R14E	345.26 352.4	3.4 3.2	4.26 2.96		2.4 2.4	3.39	4,5,6
5-19-64	F.O.C. 6-8-65	6-21-65	2518	213-6	A-94	Harman & Pauline Roy	Lots 1-2-3-4-5-6-7-8-9-10-11-12 Bk 15, Lots 2-3-4-5-13-14-15-16-17 Bk 14 & Lots 14-15-16 Bk 13 Roy Sub.	7.4	4.3	4.3		1.1	2.7	11
10-26-60	W.D. 10-4-60	11-10-60	1695	391-3	A-95	John S. & Edith J. Malloy et al	Lots 2-3-4-5-6 Bk 3, Lots 1-2-3-9-10 Bk 4 Desert View Addn.	64.1		12.74 11.53			51.36	11
10-26-60	D.D. Esmt. 10-7-60	11-10-60	1695	395	A-95-A						0.27			
10-26-60	"	11-10-60	1695	394	A-95-B						0.27			
10-26-60	"	11-10-60	1695	396	A-95-C						0.67			
5-19-64	F.O.C. 1-26-68	2-8-68	3179	115-8	A-96	Southern Arizona Land Co. et al	W 1/2 Sec 14 T155 R14E	423.4	216	6.5		15.1	15.3	446.5
5-19-64	Q.C.D. 8-27-68	10-25-68	3359	244-5	A-97	Fannie M. Kane (Widow)	Pt SE 1/4 SE 1/4 Sec 32 T145 R14E	2.4	0.3	1880 Sq Ft			2.1	8
2-20-64	W.D. 1-16-64	3-27-64	2241	371-2	A-98	E.L. & Goldie M. Jester et al	Pt NE 1/4 SE 1/4 Sec 32	11.9	3.9	3.9		5.1	2.9	7,8
8-20-64	W.D. 6-4-64	9-17-64	2331	96-7	A-98-A	Eugene R. & Mary Lou Jewett, G.P.	Pt W 1/2 SE 1/4 Sec 32	61.5	3.0	3.0		0.1	58.4	7
12-1-64	F.O.C. 6-21-66	1-23-67	2916	165-8	A-99	Eugene M. Felix (widower)	Lots 1 & 2 Bk 2, Lots 1 thru 8 Bk 3, Montmore Addn. Lot 7, Bk 4	23,332 24,452 38,255	6,938 10,454 None	6,938 10,454 None		0.1	0.2	9 10
8-6-65	ESMT. 7-16-65 ESMT. 10-9-64	8-11-65 8-24-64	2558 228-32	212-5 228-32	D-192	Southern Pacific Railroad	Pt SW 1/4 NW 1/4 Sec 3 & Sec 4 T155 R14E	4.0	0.2	0.2		0.0	3.8	9
5-19-64	F.O.C. 8-15-67	8-31-67	3069	134-8	A-89	Tucson Gas, Electric Light & Power Co.	Pt Lot 3 Sec 4	1.3		911 Sq Ft			1.2	4
5-19-64	F.O.C. 3-7-66	4-14-66	2723	172-4	A-72-1	Alice Dec. Gallo, (Std Oil Co. Leasehold)	Pt E 1/2 SW 1/4 Sec 30 T145 R14E	1.3		911 Sq Ft			1.2	4
5-19-64	F.O.C. 5-2-67	5-10-67	2990	126-9	A-93-1	Ranch Trailer Sale (Lessee)	Pt NE 1/4 SW 1/4 & Pt SE 1/4 NW 1/4 Sec 30 T145 R14E	14.999		6,541.0		83,458.0	4	
6-26-64	Q.C.D. 6-4-64	7-31-64	2300	504	A-71-1	Johnnie L. Ritter & Angelo Ritter, H/W	Pt NE 1/4 SW 1/4 Sec 25 T145 R14E	1.5		Access Rights Only			1.3	4
6-26-64	Q.C.D. 6-3-64	7-31-64	2300	507	A-71-2	Lee Ritter & Coram Ritter, H/W	Pt NW 1/4 SW 1/4 Sec 30 T145 R14E	2.0					2.0	4
					A-71-3	Lucy Palermo (Co-widow)	Lots 1 & 2 Bk 3, Broadway of America Addn.	24,791.0					24,791.0	
					A-71-4	Shirley Gattlieb (Widow, Estate of Eugene D. Hunt)	Lots 6 & 7 Bk 1 & 18 Bk 2, Broadway of America Addn.	85,250.0					85,250.0	
5-19-64	F.O.C. 4-26-66	5-31-66	2755	93-4	A-71-5	Joseph E. & Betty J. Starttch	SW 1/4 Sec 25 T145 R14E Lot 262 Nat Hwy	4.3				4.3	4	
5-19-64	F.O.C. 8-12-66	1-23-67	2916	172-8	A-78	Hughes Tool Co.	Lot 4 Sec 4 T155 R14E	35			0.9	34.0	0.1	13
12-1-64	F.O.C. 3-7-66	4-14-66	2723	175-8	A-87	Tucson Title Ins. Co. (Trust #207584)	Pt Lot 3 Sec 4	21.8			3.9	9.2	8.7	13
5-19-64	F.O.C. 8-15-67	8-31-67	3069	134-8	A-89	Tucson Gas, Electric Light & Power Co.	Pt Lot 3 Sec 4	3.8			0.4	2.3	1.1	13
2-19-65	W.D. 1-15-65	3-12-65	2448	28	A-89-1	United Presbyterian Church	Lots 3, 4, 5, 6, 7, 8 Bk 2, Montmore Addn.	44,680.0			15,497.0	17,183.0	12,000.0	9
12-1-64	F.O.C. 6-21-66	1-23-67	2916	165-8	A-99	Eugene M. Felix (widower)	Lots 2, 3, 4, 5, 6 Bk 4	32,630.0			4,669.0	47,961.0	9	
5-19-64	F.O.C. 8-12-66	1-23-67	2916	172-8	A-78	Hughes Tool Co.	Lots 1, 7, 8, 9 Bk 4	36,255.0			15,367.0	18,034.0	13	
12-1-64	F.O.C. 6-21-66	1-23-67	2916	165-8	A-99	Eugene M. Felix (widower)	Lots 1 thru 7 Bk 3	54,196.1			10,623.0	37,924.0	13	
5-19-64	F.O.C. 8-15-67	8-31-67	3069	134-8	A-89	Tucson Gas, Electric Light & Power Co.	SW 1/4 Sec 4 T155 R14E	56.7			4.7	14.1	37.9	13
	W.D. 3-8-65	3-9-65	2445	252	A-90-A	C. & Leone Luke Briggs	Pt W 1/2 NW 1/4 SW 1/4 Sec 3				1.6	7.2	9.7	13
	W.D.	7-10-64	2292	88	A-91-A	Randolph & Julia S. Jenks	Pt E 1/2 NW 1/4 SW 1/4 Sec 3				1.8	7.0	4.7	13
5-19-64	F.O.C. 3-22-66	4-14-66	2723	183-6	A-75-1	Walter E. & Helen A. Murphy et al	Pt SE 1/4 SW 1/4 Sec 30 T145 R14E	6.1			0.1	6.0	5	
7-24-64	Esmt. 7-7-64	9-21-64	2333	224-5	A-75-2	Harold M. & Florence Hartley, J.T.	See Description A-75 above	78.7			0.8	28.8	20.8	5,6
					A-75-3	Disque D. Dean, John Ellis & David D. McCarty	Lots 1 & 2 Bk 3 & Lot 32 Bk 3 Broadway of America				Temporary	Constr.	Easement	5
					A-75-4	Mary K. Trainor	Lots 29, 30 & 31				Temporary	Constr.	Easement	5
6-11-65	Deed 5-25-65	7-9-65	2531	408-9	A-81-A	Ariz. Building Co. et al	Pt E 200' SE 1/4 Sec 30 T145 R14E	57		0.47		5.23	6	
11-4-63	W.D. 7-7-63	1-13-70	3660	233-6	A-71-B	Salih O. & Mareva D. Willrett, H/W	Pt Lot 3 Sec 30 T145 R14E	12,000.0		114 sq ft			4	
12-15-65	Deed	9-24-68	3336	270-71	A-72-A	Alice Dec. Gallo	Pt E 1/2 SW 1/4 Sec 30 T145 R14E	9.4 Ac.		1.3			125,656 sq ft	4

REVISIONS (CONT.)			
C.O.	DATE	BY	DESCRIPTION
221	1-10-64	J.H.J.	Revised Area on Parcel No. A-76
286	4-25-64	J.H.J.	Showed Areas of A-28 & A-28A on Two different lines & corrected Areas of A-81
322	4-20-64	James	Revised Ramp E, Deleted A-713 & A-71-4
333	5-29-64	James	Add R.R. & Sec. 4, Revised description A-75, A-80, A-87, A-89, A-96, A-99, D-192, H/W A-81, A-89 & A-99
340	6-26-64	James	Add Drain Easement, Item A-75 & A-75
339	6-17-64	James	Amended Item A-78 & D-192
364	6-26-64	J.H.J.	Added Case Area A-87
367	6-26-64	J.H.J.	Corrected Case Area & Remainder on Parcel A-75 Add parcel A-75A
376	7-17-64	J.H.J.	Revised Areas A-79
467	8-1-64	James	Added Item A-75-2 & A-75-3
478	1-28-64	James	Revised Area of ITEM A-87-1 & A-99
485	1-28-64	James	Revised Area of Item A-89-1 & A-99
549	1-23-70	Horrim	Parcel A-99 - Areas of RW take E of J.W. Easement Revised
592	8-16-64	L.R.	Revised R/W, Added Parcel A-81-A, 0.47 AC.
861	5-8-65	L.F.W.	Revised Parcel A-96
2131	2-4-69	J.Nez	Added Part A-71-6
2775	11-23-70	Horrim	FINALIZED - Changes Shown in Orange
3504	2-27-74	Hills	Added Parcel A-72-A

\* Parcel acquired by Pima County directly

**JULIAN WASH OWNERSHIP**  
The area shown in the total area column is that portion of the parcel lying Southwestly of Southwestly R/W of the Interstate Highway 1-10-5(






**TUCSON-BENSON HWY. - U.S. 80  
VETERANS OVERPASS - EAST  
PIMA COUNTY**

REVISIONS		PROJECT NO.	I-10-5(4)262
NO.	DATE	BY	DESCRIPTION
1	8-15-63	J. Groff	Changed distance to 258'-42" on A-74
2	8-15-63	J. H.J.	Removed Access Control on Ajo Rd from Sta. 109+50 to 111+50, Parcel A-75
3	9/16/64	L.T.W.	Added Gate Sta. 79+15.2
4	11/16/64	W. H. H.	Add Drain Easement from 775-19475
5	6-26-64	S.T.L.	Added Parcel A-75-A
6	9/17/64	W. H. H.	" " A-75-2 & A-75-3
7	11-23-70	For Trim	FINALIZED - Changes Shown Orange

DRAWING NO.	D-10-T-290
SHEET NO.	5 of 13
DRAWN BY	JON GROFF / Junger
DATE	6-20-61. Revised 3-8-63
SCALE	1" = 100'


Hard Copy 10-H-255 & 256

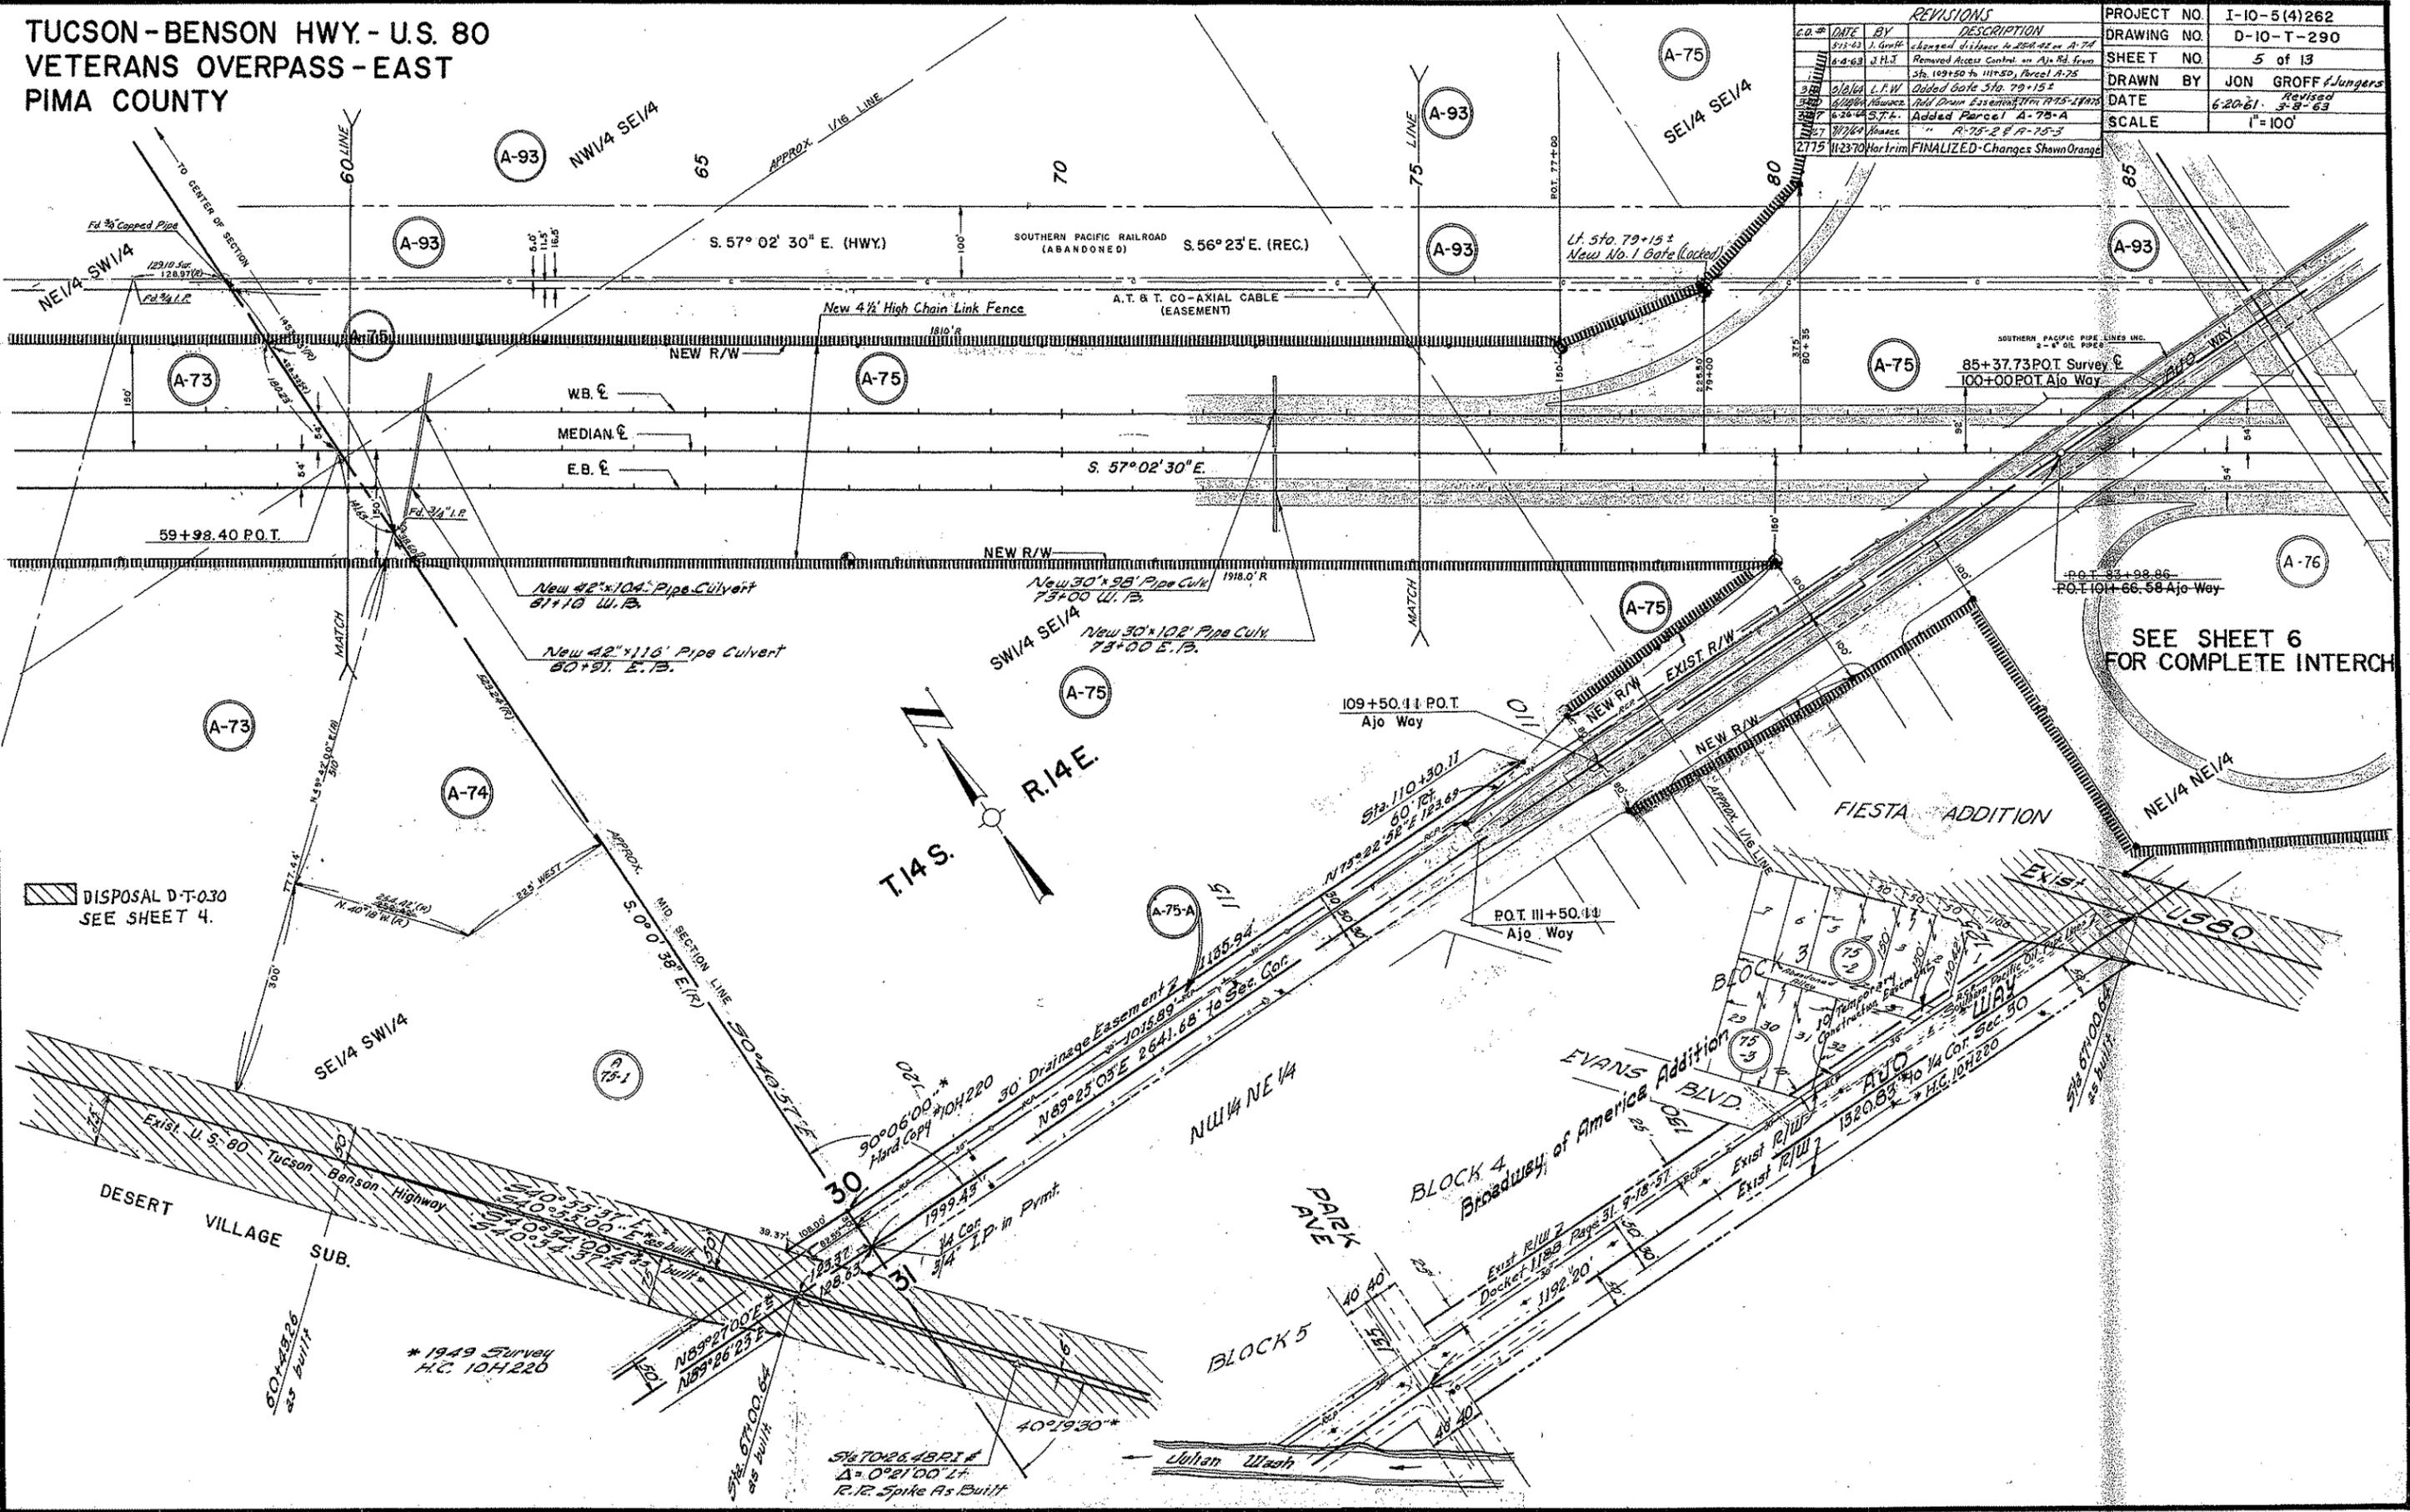

**TUCSON-BENSON HWY. - U.S. 80  
VETERANS OVERPASS-EAST  
PIMA COUNTY**

REVISIONS (Cont)				REVISIONS				PROJECT NO.	I-10-5(4)262
C.O.	DATE	BY	DESC.	C.O.	DATE	BY	DESCRIPTION	DRAWING NO.	D-10-T-290
1020	2/24/66	R.R.	Added beginning & ending Const. Project Limits. Called Out Exist Gate 225+50 to Sta. 29+00. Added Const. differences in bearings & stations as shown.				Changed bearings & S.E. line Sec. 31, changed Sta. on some lines of cut access control back on east end of Hwy.	SHEET NO.	6 of 13
1389	12/15/66	R.R.	Added Campbell Ave. Interchange Callout.	495	8-7-68	J.H.T.	Added by an Relocated Campbell Ave. Shovel.	DRAWN BY	JON GROFF & Jungers
2775	11-23-70	Warren	FINALIZED-Changes Shown in Orange	134	1968	Gott	Added UNRECORDED to Fiscal Sub.	DATE	6-20-61 Revised 3-8-63
6228	7-29-83	R.R.	Road Access Control Ct. P.O.T. 85+00	229	2/28/69	Watts	Calc. R/W From Field Ties. F.M. 1968 Rev.	SCALE	1" = 100'
				310	4/10/68	L.F.H.	Added Gate #312. 55-85'		
				340	4/24/68	Watts	Added Dr. Easement. Ajo Way.		
				367	6-24-68	B.T.L.	Added Parcel A-75-A		
				692	8-17-68	E.L.R.	REVISED R/W ADDED PARCEL A-B1-A		
							ADDED SHORE LIMITS IN QUARTS C, D, E, B&A BELL AVE		

Hard Copy 10-H-255 & 256

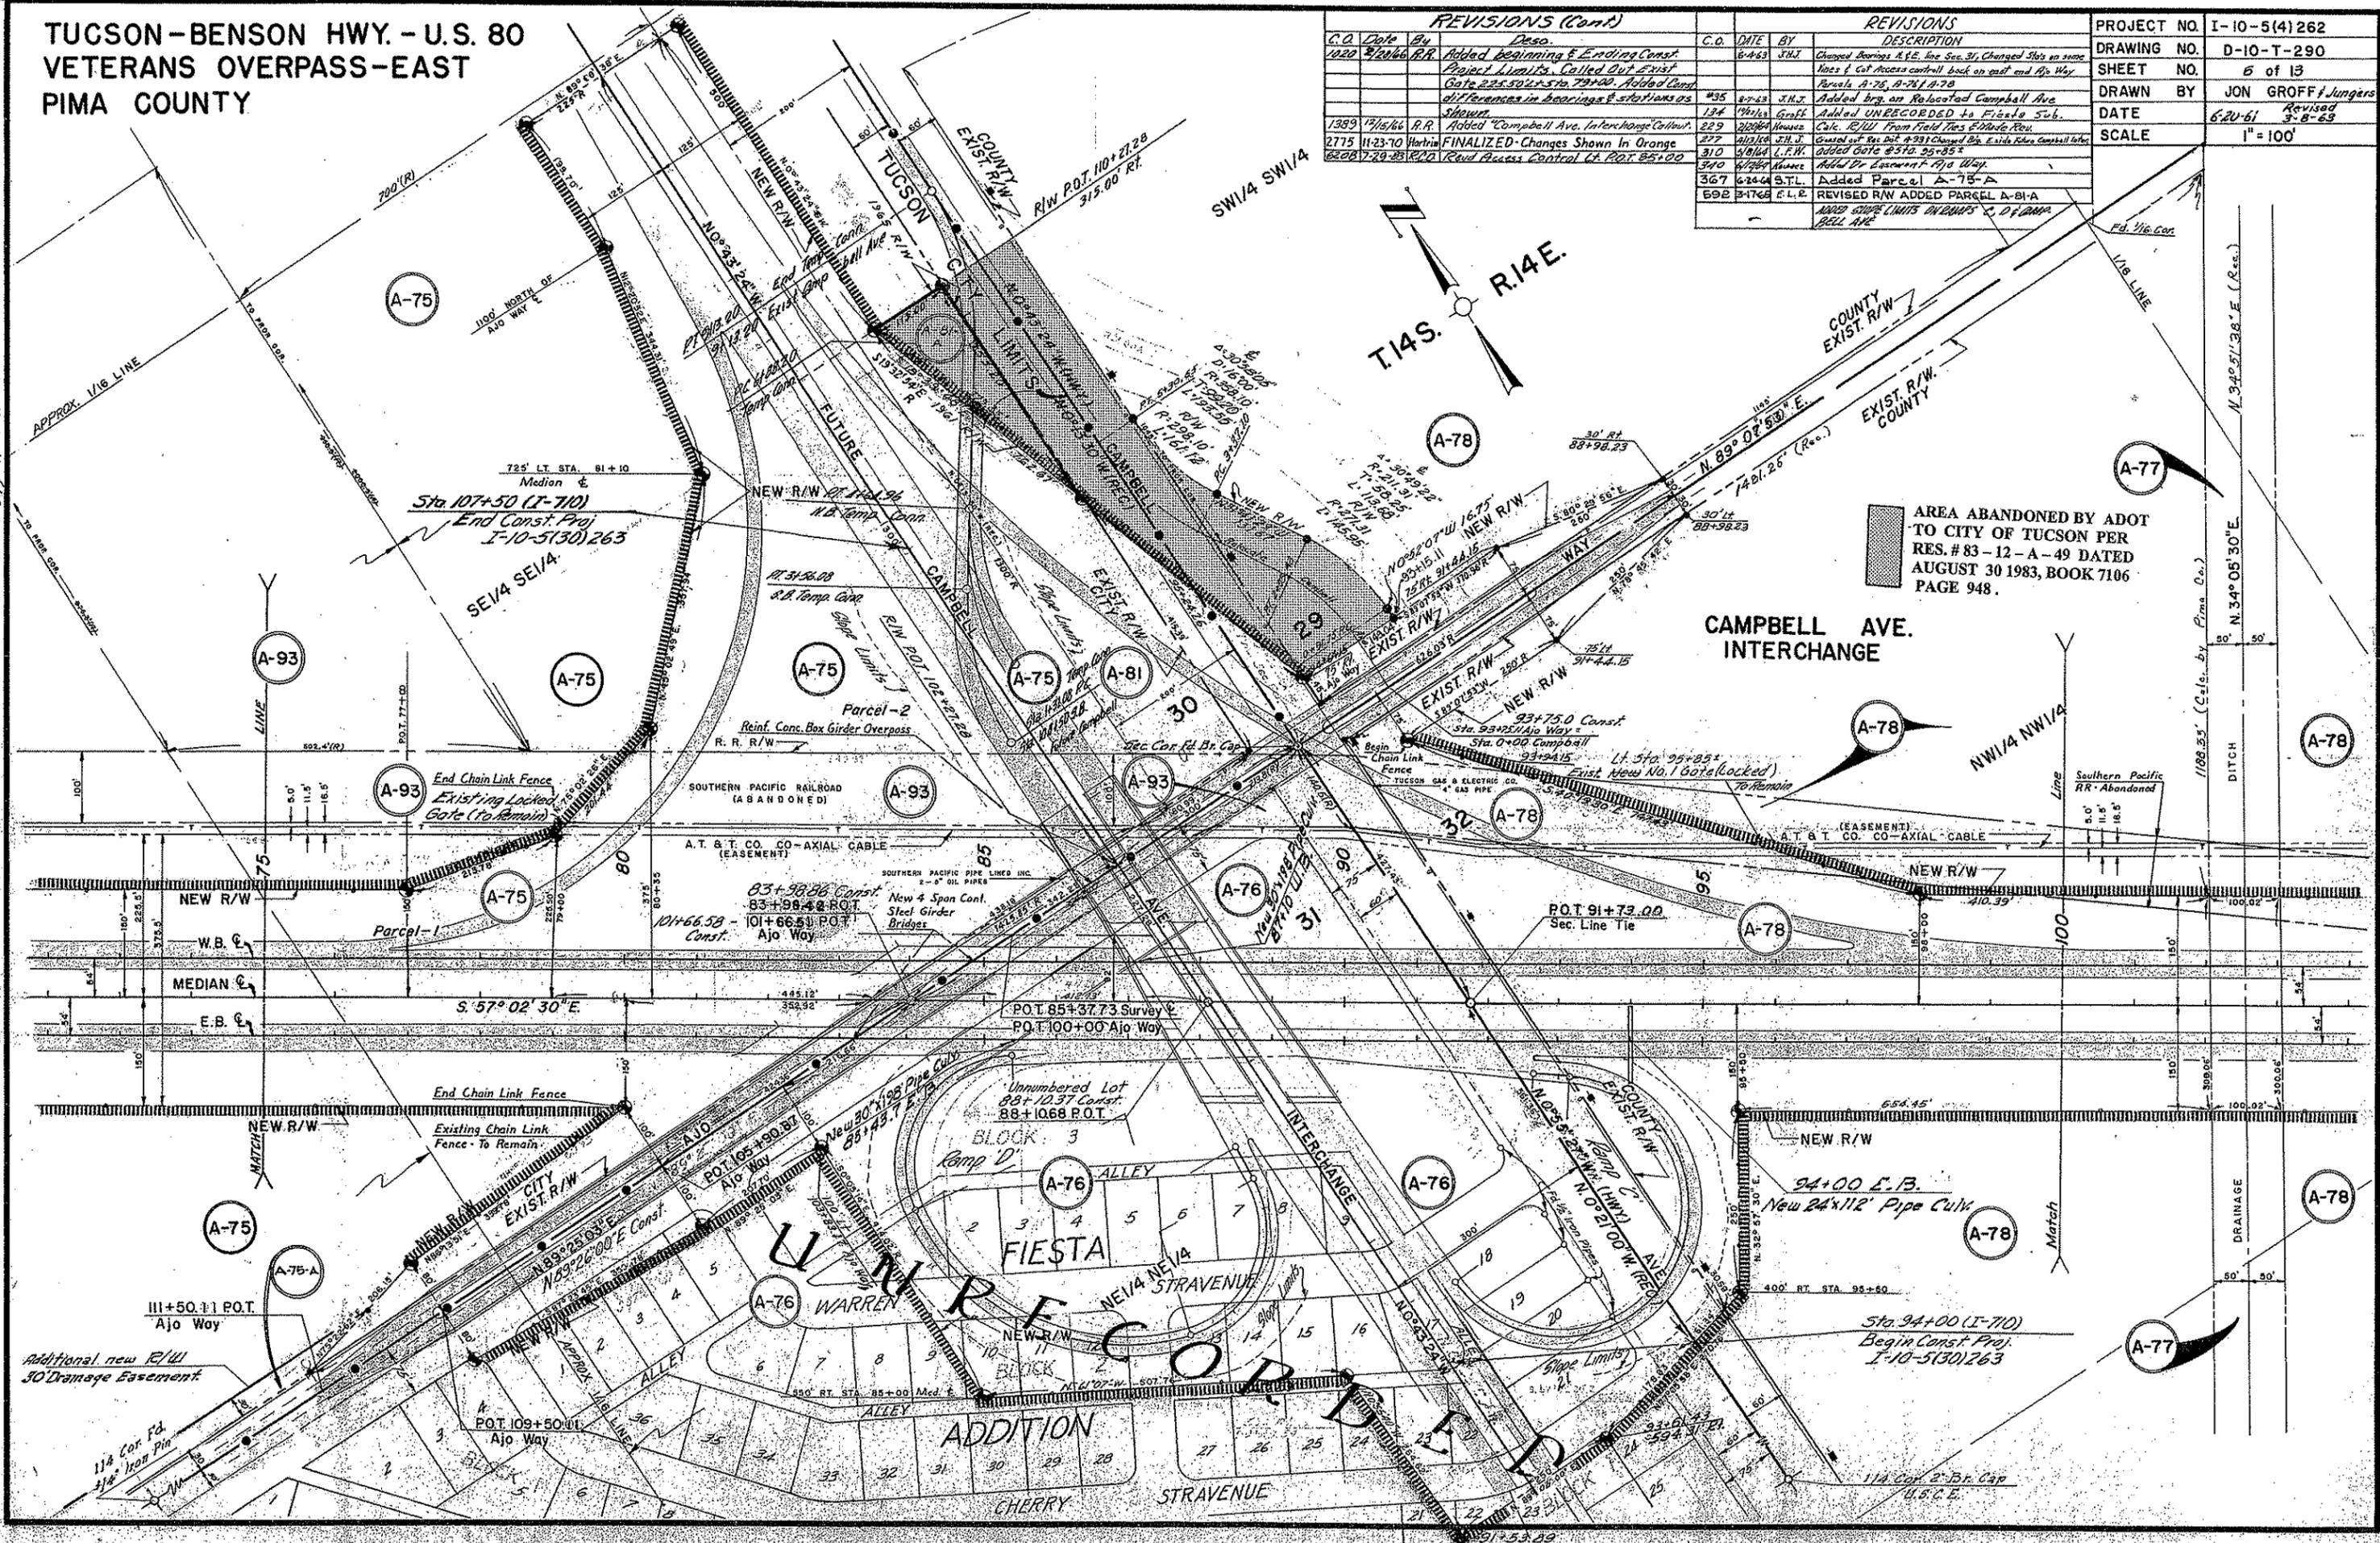

AREA ABANDONED BY ADOT TO CITY OF TUCSON PER RES. # 83-12-A-49 DATED AUGUST 30 1983, BOOK 7106 PAGE 948.

**CAMPBELL AVE. INTERCHANGE**



**UNRECORDED**

**FIESTA ADDITION**

TUCSON-BENSON HWY. - U.S. 80  
 VETERANS OVERPASS-EAST  
 PIMA COUNTY

REVISIONS			PROJECT NO.
NO.	DATE	BY	I-10-5(4) 262
270	4-13-61	J.H.J.	DRAWING NO. D-10-T-290
			SHEET NO. 7 of 13
271	4-27-61	J.H.J.	DRAWN BY JON GROFF
2775	11-23-70	Warlim.	DATE 6-20-61
			SCALE 1" = 100'


Hard Copy 10-11-2005 \$256

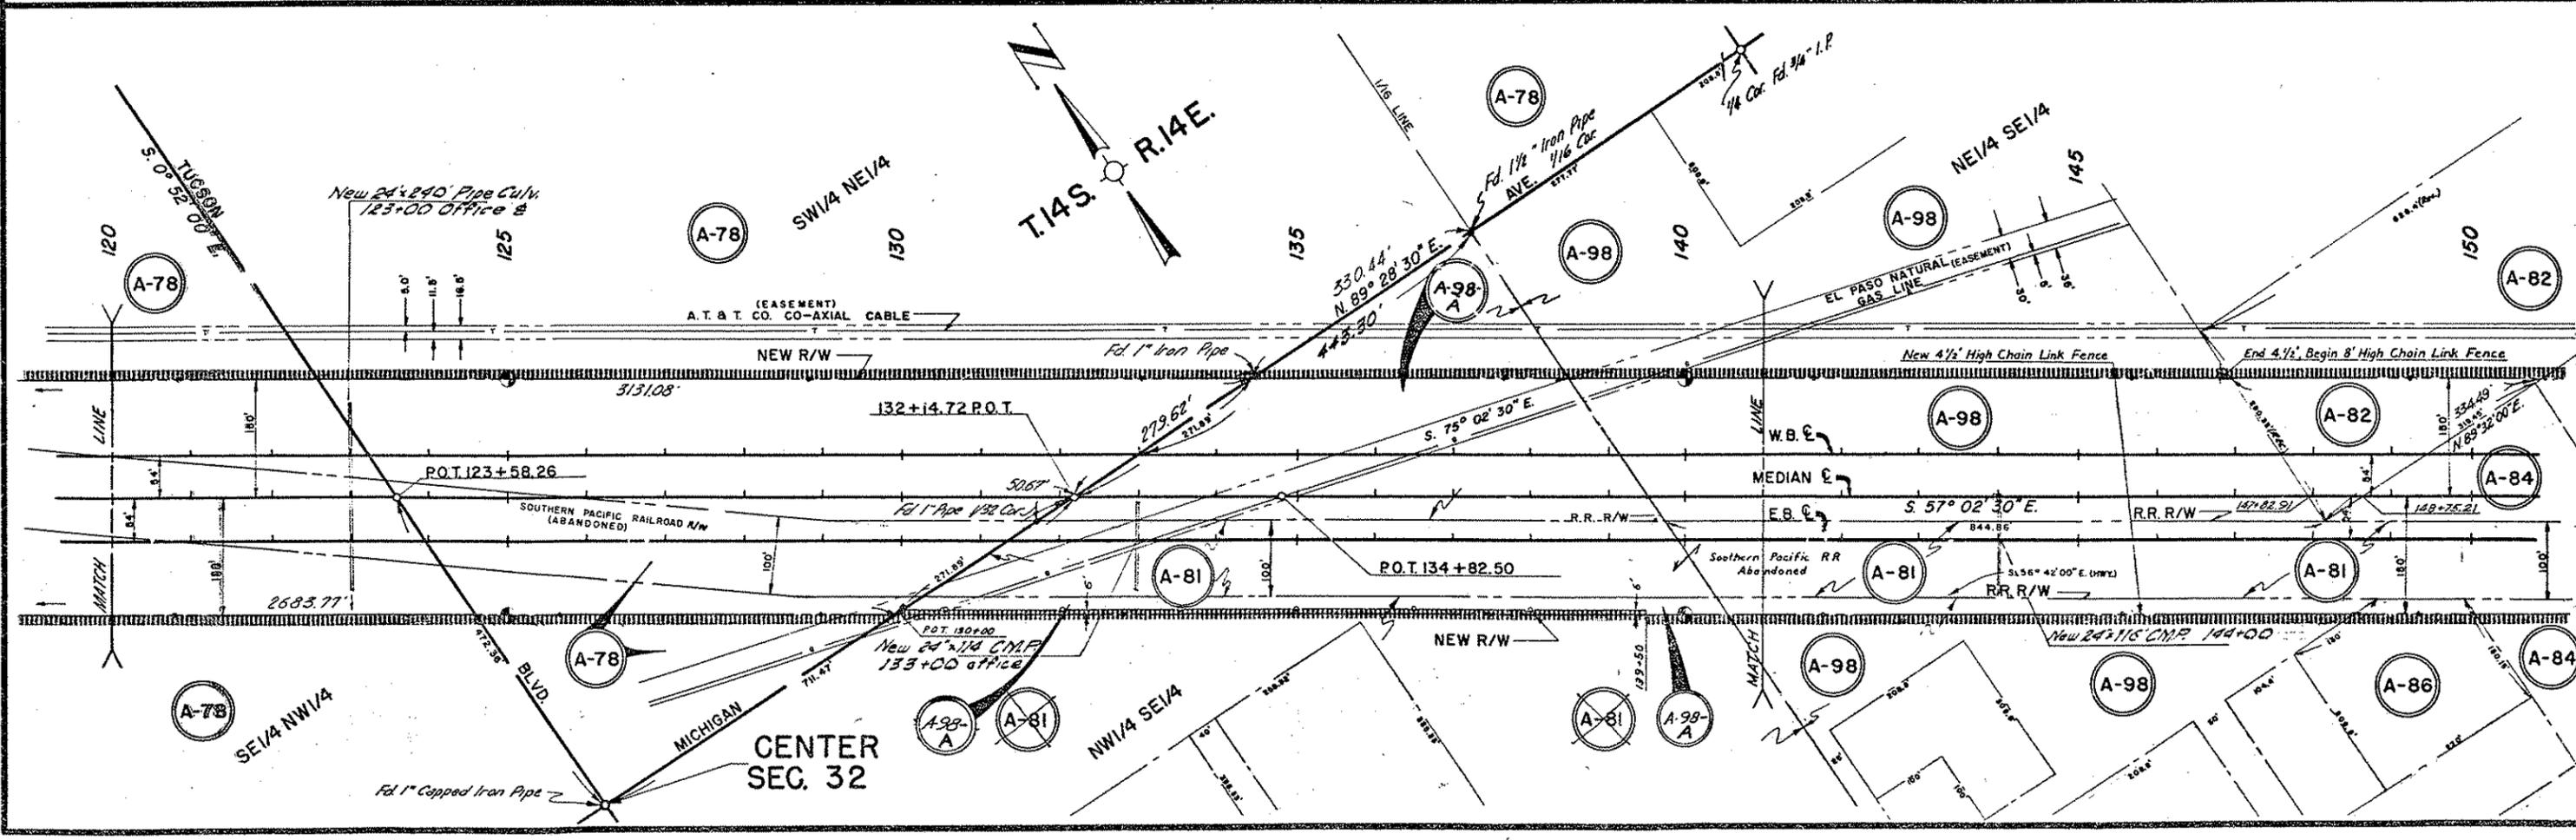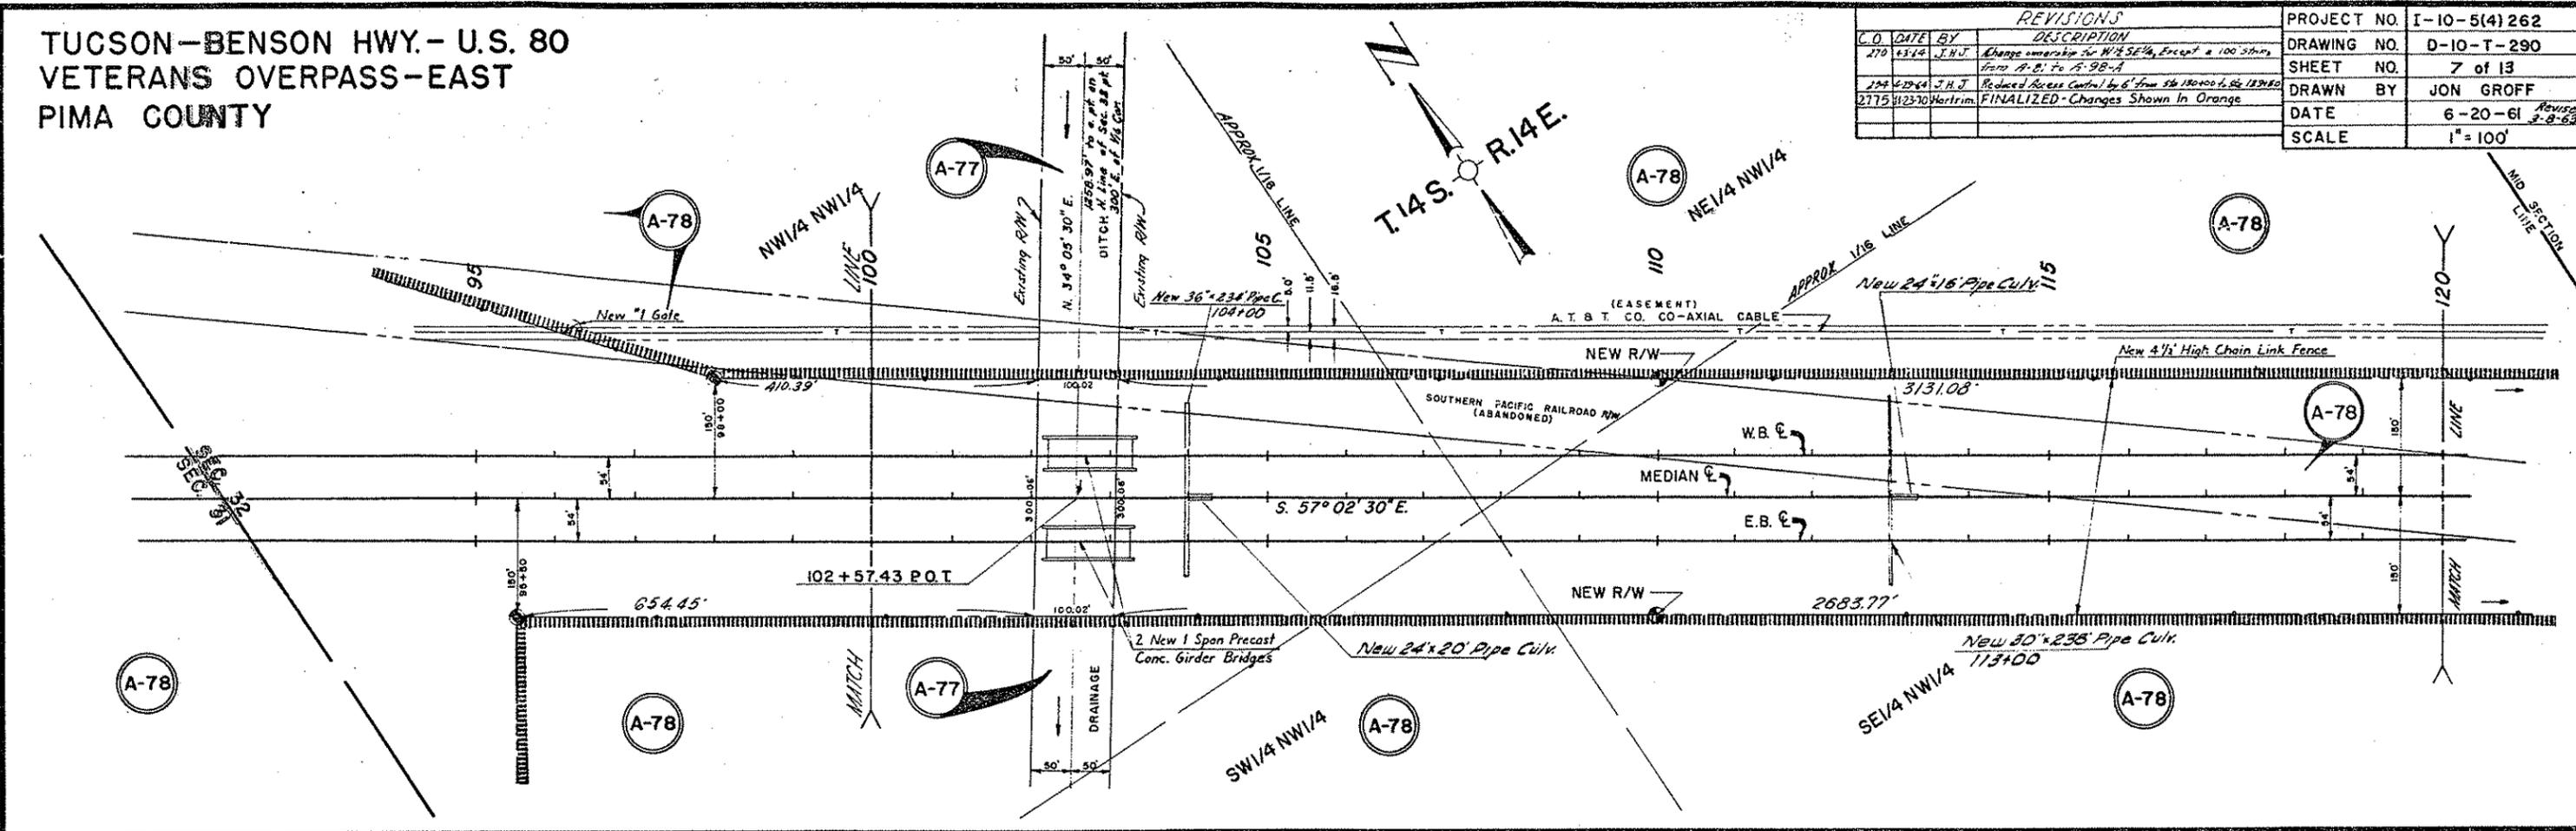

**TUCSON-BENSON HWY. - U.S. 80  
VETERANS OVERPASS - EAST  
PIMA COUNTY**

REVISIONS		PROJECT NO.	I-10-5(4)262
DATE	BY	DESCRIPTION	DRAWING NO.
4-23-61	J.H.J.	Change width of S. Country Club Rd. from 50' to 75', Added 60' Rd. Way & Reduced Parcel A-82 to Area within New R/W	D-10-T-290
			SHEET NO.
			8 of 13
			DRAWN BY
			JON GROFF/Jungars
			DATE
			6-28-61
			SCALE
			1" = 100'

END PROJ. I-10-5(4)262 BEG. PROJ. I-10-5(17)265

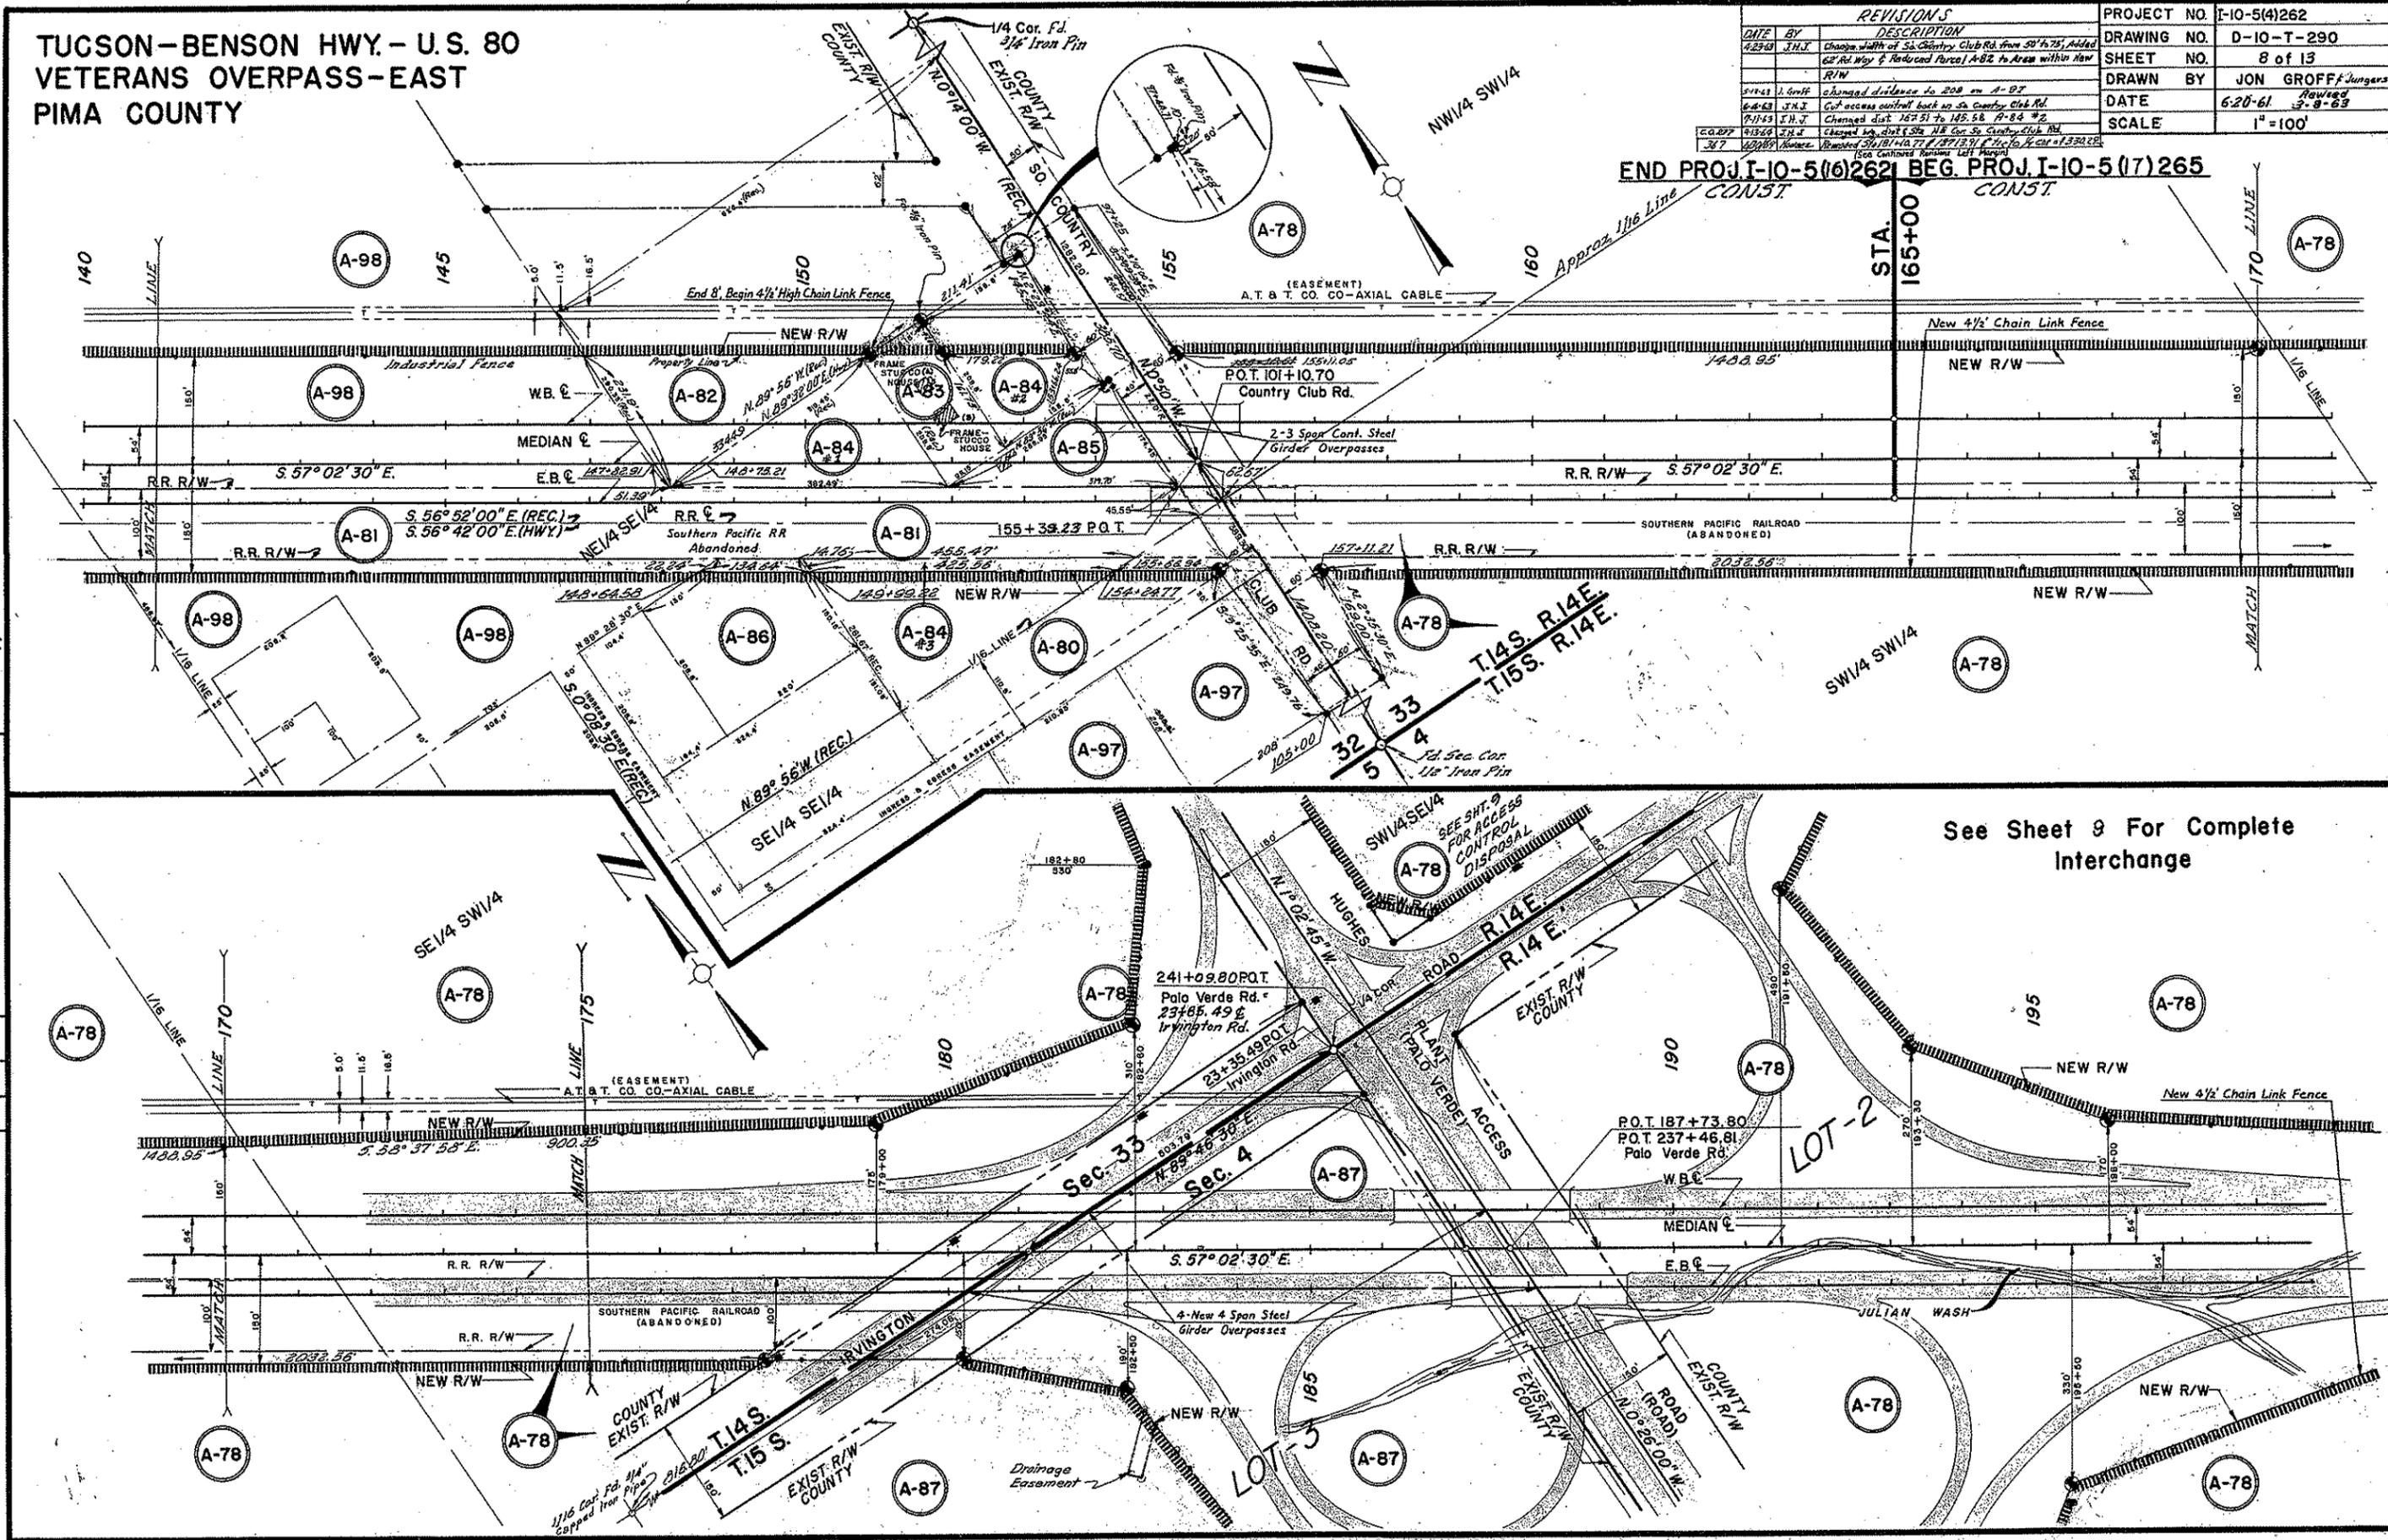

REVISIONS	
CO. DATE	DESCRIPTION
10-25-61	Chg. Dist. from 241.52' to 249.76', Bearing from S. 57° 02' 30" E. to S. 57° 02' 30" E. in A-97 & A-98.
11-15-61	FINALIZED - Changes Shown in Orange

Hard Copy 10-11-2008 P.256

See Sheet 9 For Complete Interchange

**TUCSON-BENSON HWY. - U.S. 80  
VETERANS OVERPASS-EAST  
PIMA COUNTY**

**REVISIONS (Cont.)**

C.O.	DATE	BY	DESCRIPTION
689	5-18-63	H. Robinson	Added Two Lane Towers #2 & #5 South of Median & 20' Spaced by changing control of access in Hatch Lane
1389	12-15-66	A. B.	Added Proprietary 48" & Palo Verde 28" Jumper Change "Cut" West
2175	11-23-70	HARTRIM	FINALIZED Changes Shown In Drawings
7187	11-24-85	CP	Add Note About New R/W Acq. By Pima County

**REVISIONS**


DATE	BY	DESCRIPTION
4-23-68	J.H.J.	Changed S. 1st of Lot 3 From A-87 to A-89
6-4-63	J.H.J.	Added Drain, Eas. Sta. 183 & Removed Access Control across Julian Wash, A-87 to A-89
10/1/63	Groff	Added Tucson Gas & Elec. Eas.
2/20/64	Kowacz	Draft Julian Wash Calc Area Mortimer field
4/13/64	J.H.J.	Cut Access Control to N. R/W line Julian Wash E. side Palo Verde
11/17/64	Kowacz	Extended P.R. R/W into Interchange
6/18/64	J.H.J.	Added Box Culvert on Eas. Plat. Sta. 183
3/57	Kowacz	Correct Box Culvert to 188' x 10' 10" 1/2"
9/23/64	Kowacz	Drafted J.W. in Report, move Sta.

**PROJECT NO. I-10-5(A)262**

<b>DRAWING NO. D-10-T-290</b>
<b>SHEET NO. 9 of 13</b>
<b>DRAWN BY Jan Groff J.H.J.</b>
<b>DATE COMP. 6-20-61 Revised 3-8-63</b>
<b>SCALE 1"=100'</b>

CHECKED BY:

HARD COPY 10-11-235 & 256


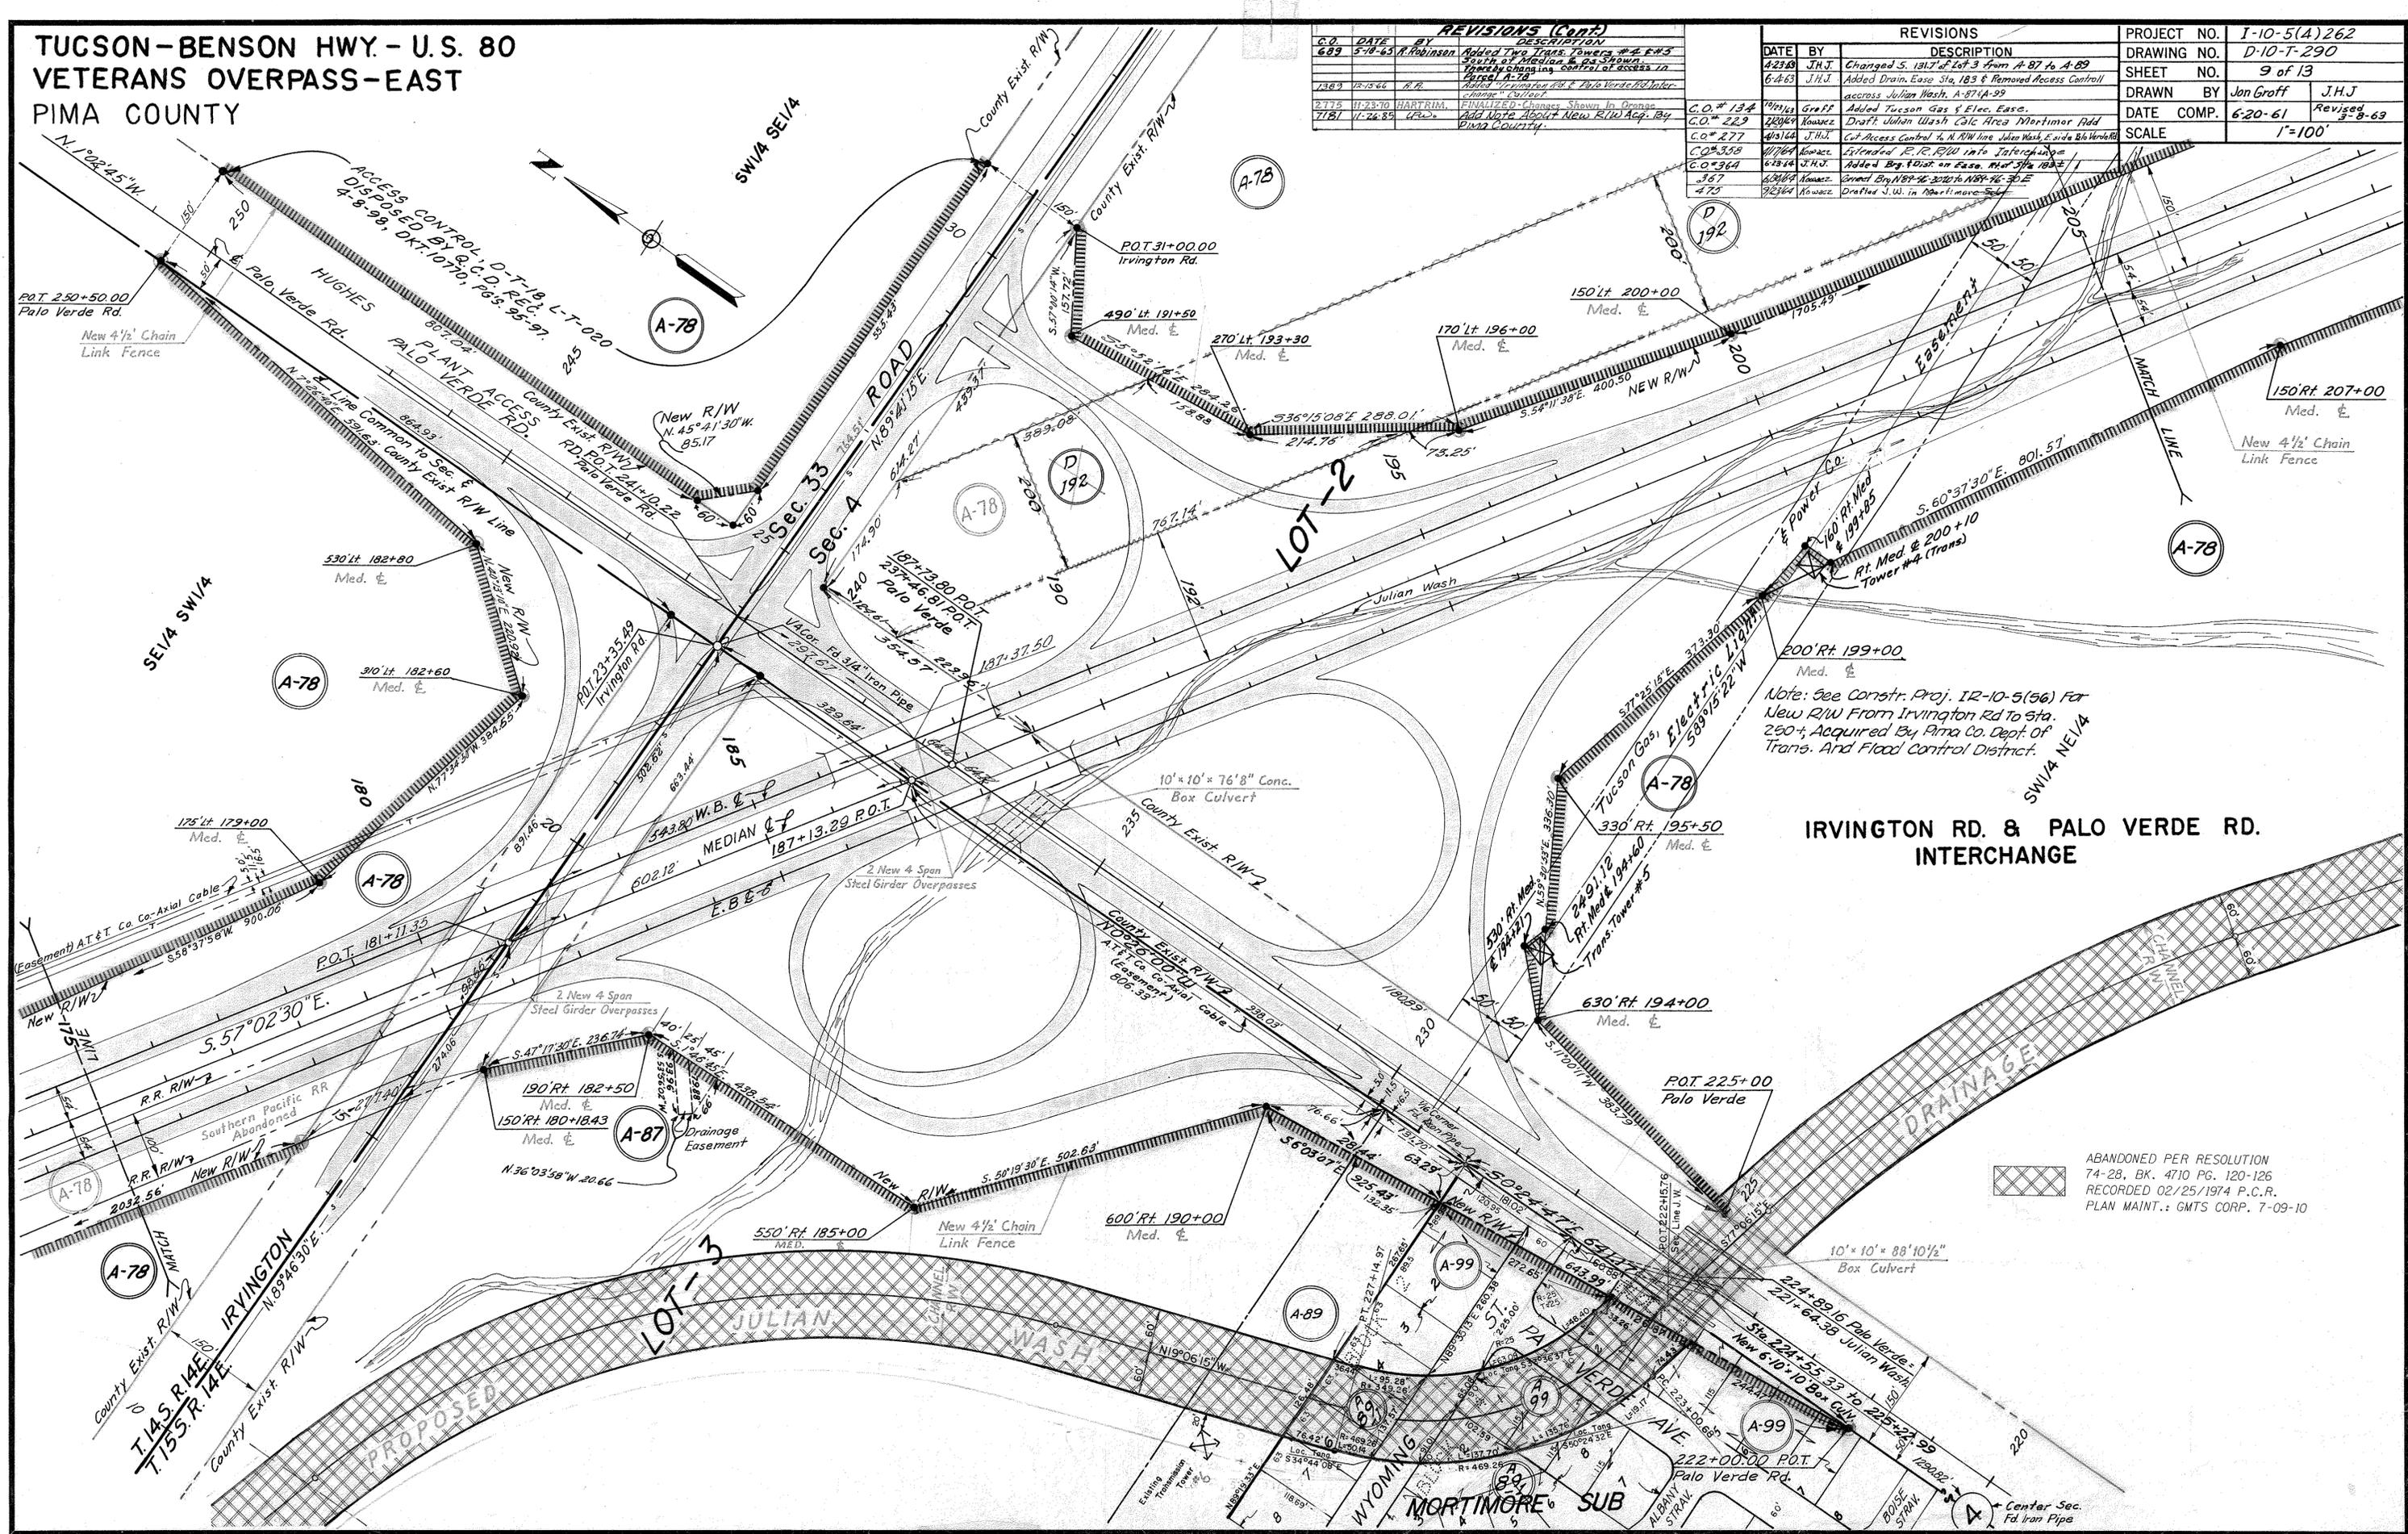


**IRVINGTON RD. & PALO VERDE RD.  
INTERCHANGE**

ABANDONED PER RESOLUTION  
74-28, BK. 4710 PG. 120-126  
RECORDED 02/25/1974 P.C.R.  
PLAN MAINT.: GMTS CORP. 7-09-10

TUCSON-BENSON HWY. - U.S. 80  
 VETERANS OVERPASS-EAST  
 PIMA COUNTY

REVISIONS				PROJECT NO.	I-10-5(4)262
C.O. No.	DATE	BY	DESCRIPTION	DRAWING NO.	D-10-T-290
C.O. # 134	6-4-63	J.H.I.	Cut access control on Alvernon Rd.	SHEET NO.	10 of 13
C.O. # 189	10/1/63	J.H.I.	Added Tucson G.E.L.P.C. Easement	DRAWN BY	JON GROFF/Jagers
7333	10/1/63	J.H.I.	Revised Drain. Eas. Lt. Sta. 224	DATE	6-20-61
C.O. # 367	4-26-64	J.H.I.	Added Ties to Drainage Eas. @ Sta. 224+21.00	SCALE	1" = 100'
			Changed Sta. 218+75.94 to 218+75.94		
C.O. # 549	7/1/65	Brandor	Changed Controlled Access at Alver on Road		
			Changed Distances to Beginning of Alvernon Rd. Next to		
			470+11.00 to 470+11.00		
2775	11-23-70	Hartman	FINALIZED - Changes Shown in Orange		
7181	11-26-85	GRU	Add Note About New R/W Acq. By Pima Co.		

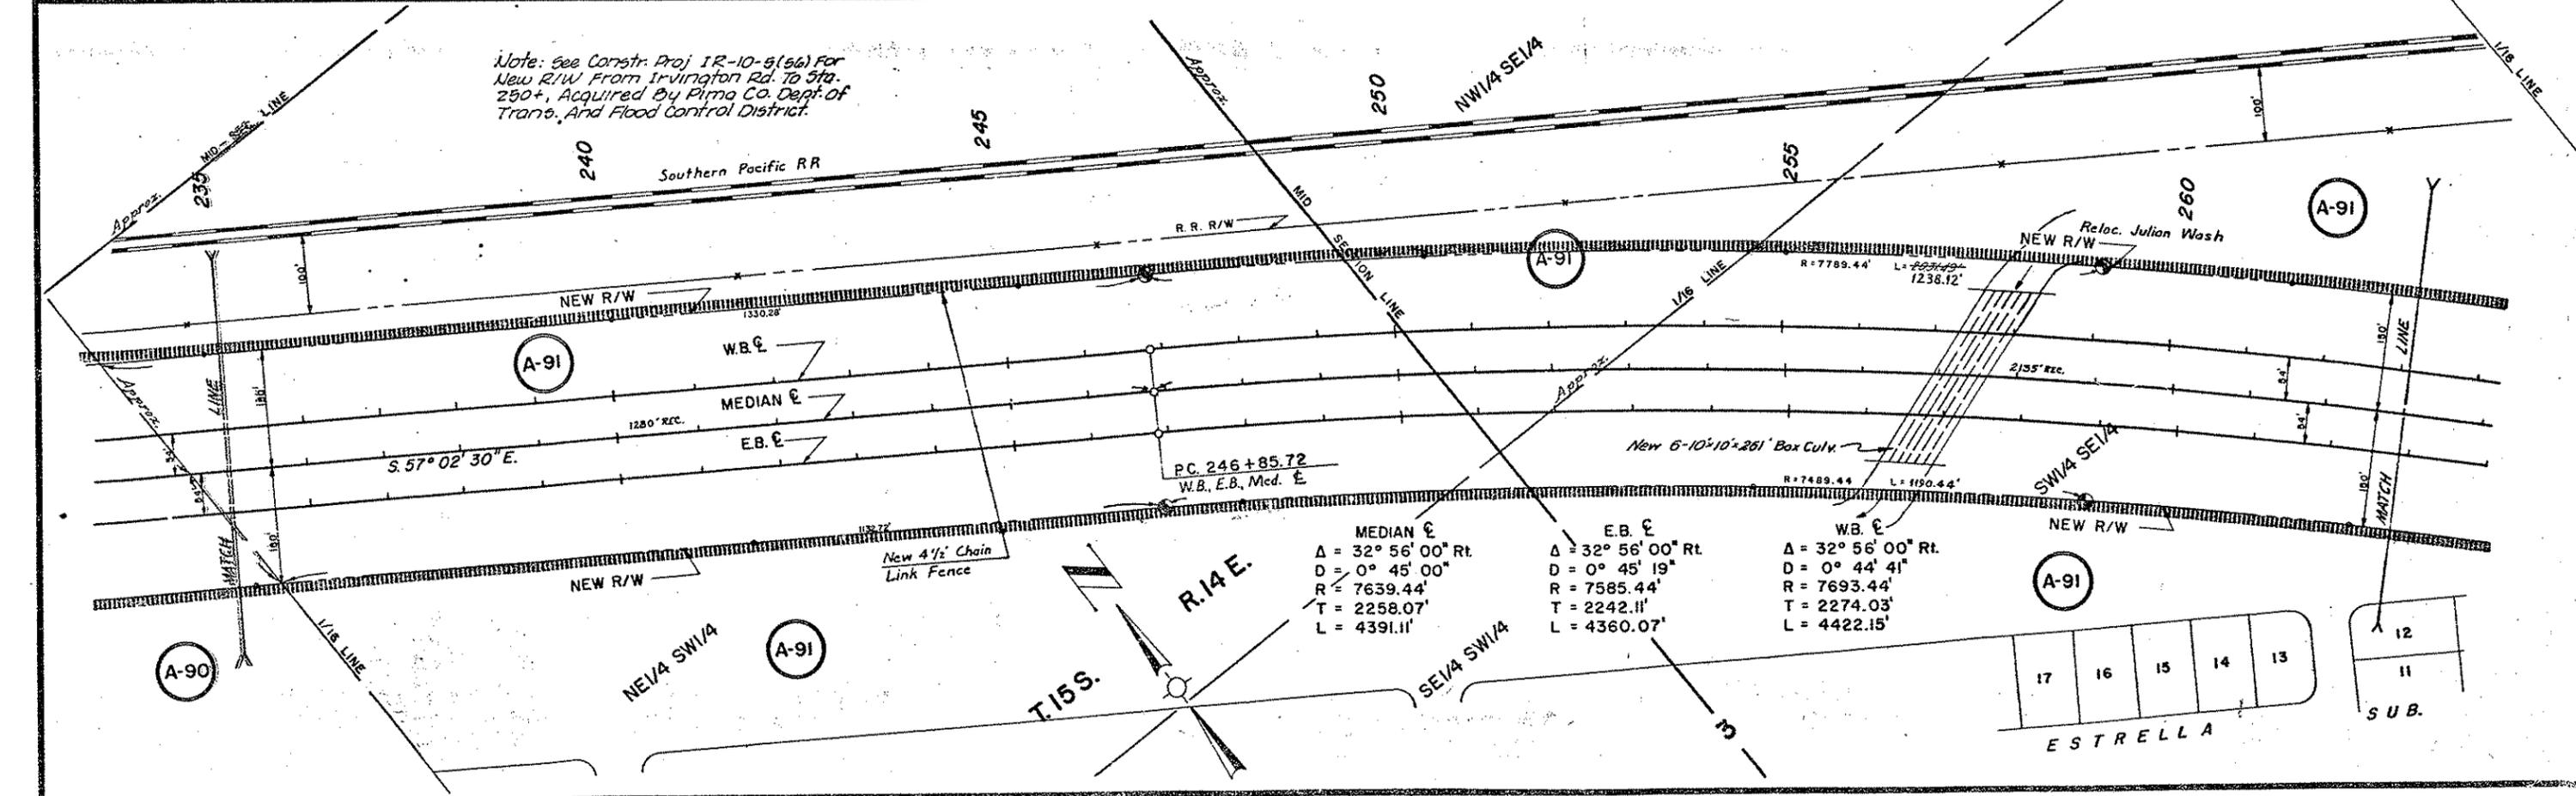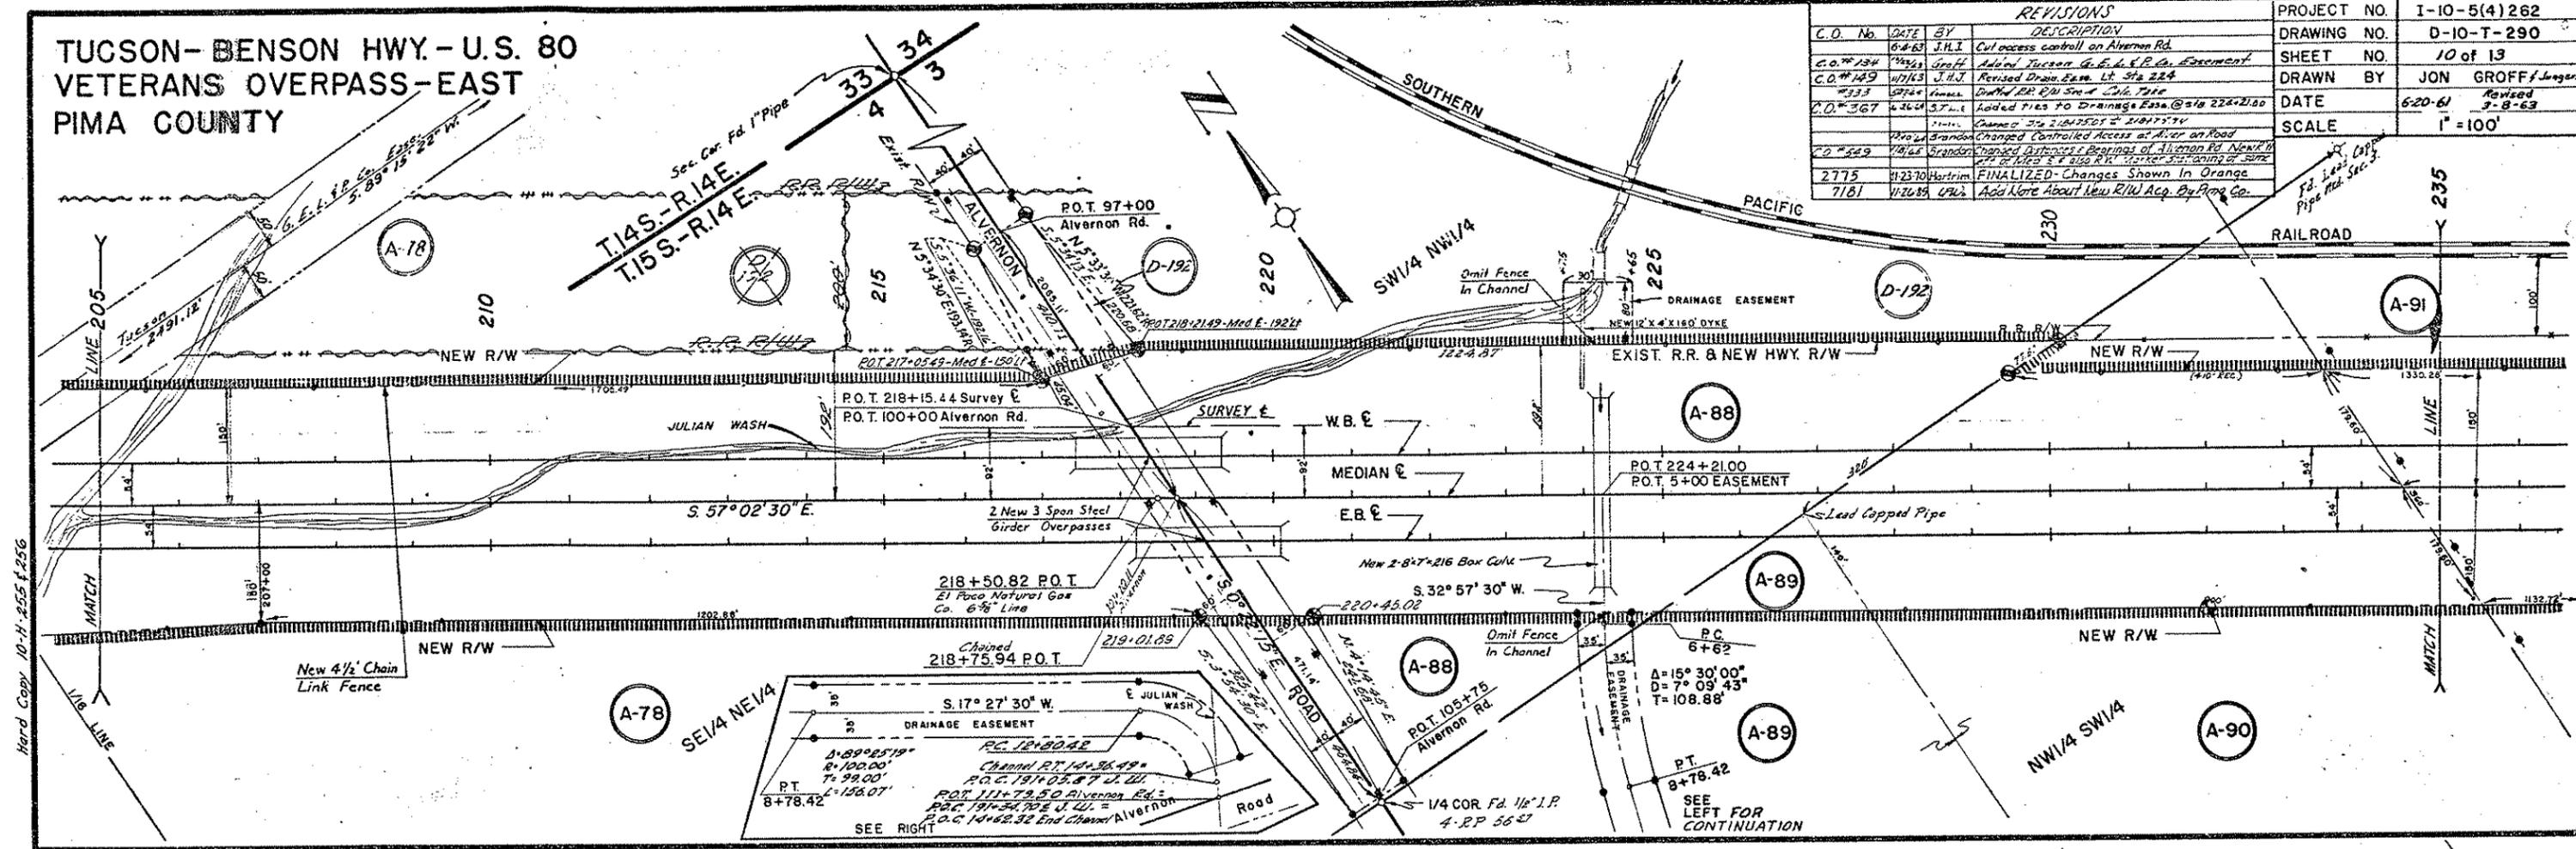

Note: See Constr. Proj. IR-10-5(96) For New R/W From Irvington Rd. to Sta. 250+, Acquired By Pima Co. Dept. of Trans. And Flood Control District.


17	16	15	14	13
ESTRELLA				
SUB.				

Hard Copy 10-11-255 f.256

TUCSON-BENSON HWY.- U.S. 80  
VETERANS OVERPASS-EAST  
PIMA COUNTY


PROJECT NO.	I-10-5(4) 262
DRAWING NO.	D-10-T-290
SHEET NO.	11 of 13
DRAWN BY	JON GROFF
DATE	6-20-61 <i>Revised 9-8-63</i>
SCALE	1" = 100'

Hard Copy 10-H-255 \$ 256

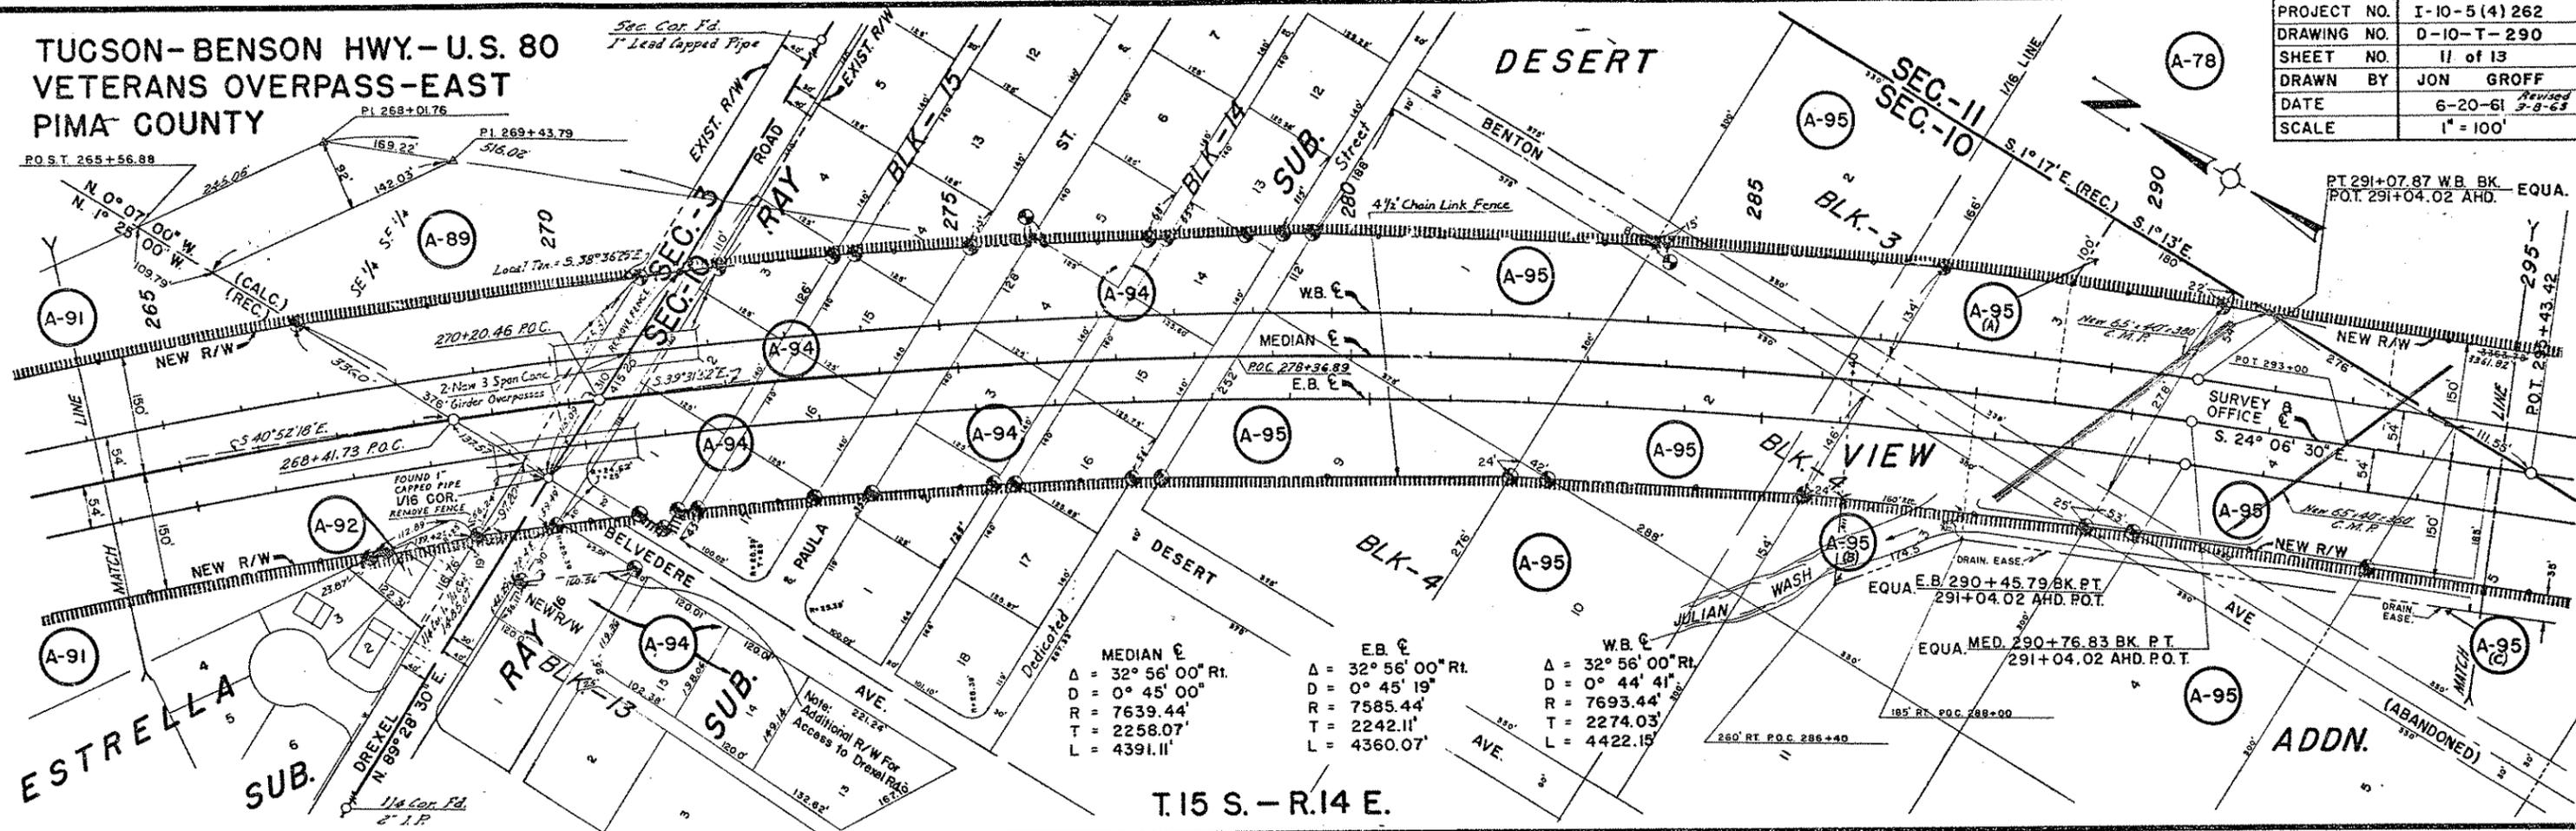

MEDIAN E	E.B. E	W.B. E
Δ = 32° 56' 00" Rt.	Δ = 32° 56' 00" Rt.	Δ = 32° 56' 00" Rt.
D = 0° 45' 00"	D = 0° 44' 41"	D = 0° 44' 41"
R = 7639.44'	R = 7585.44'	R = 7693.44'
T = 2258.07'	T = 2242.11'	T = 2274.03'
L = 4391.11'	L = 4360.07'	L = 4422.15'


T.15 S. - R.14 E.

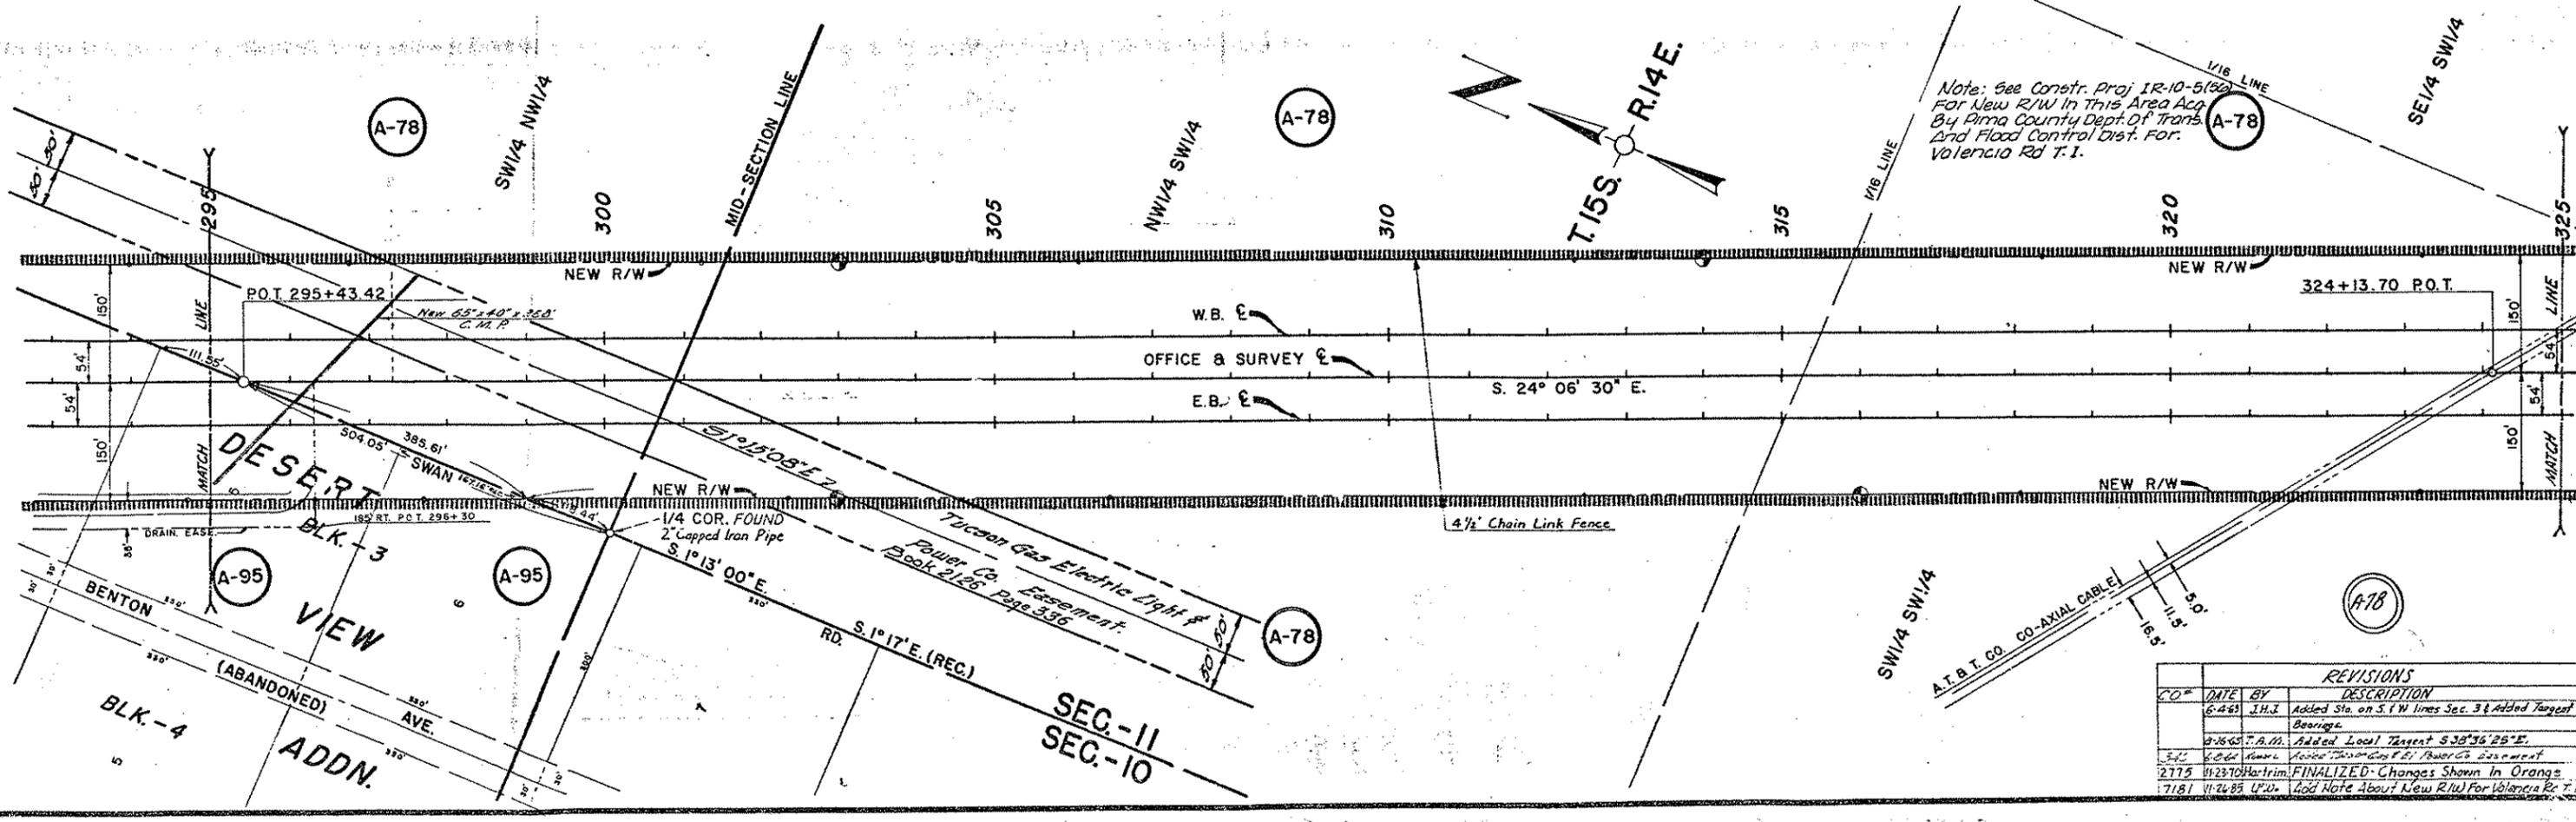

REVISIONS		
NO.	DATE	DESCRIPTION
6-4-63	J.H.J.	Added Sta. on S.F.W. lines Sec. 3 & Added Target Bearings
9-16-63	T.A.M.	Added Local Target S 32° 36' 25" E.
5-42	6-26-61	Added Survey Notes & Bearings
2773	11-23-70	FINALIZED - Changes Shown in Orange
7181	11-24-85	Add Note About New R/W For Valencia Rd T.1

**TUCSON-BENSON HWY. - U.S. 80  
VETERANS OVERPASS - EAST  
PIMA COUNTY**

REVISIONS			PROJECT NO.	I-10-5(4)262
C.O. No.	DATE	BY	DRAWING NO.	D-10-T-290
53-63	J.R.S.	Gr back Access Control A Sta 338+90	SHEET NO.	12 of 13
428-86	STL	J.M. Tie in Sta 338+90	DRAWN BY	JON GROFF / Jungers
261	11-2-80	LFW Rev. Drags & Drafts Along New R/W	DATE	6-20-61 Revised 3-8-63
		Line in Parcel A-96	SCALE	1" = 100'
1309	1/23/80	R.R. Added Callout "Valencia Rd Interchange"		
2775	11/23/80	Hartrim FINALIZED - Changes Shown in Orange		
7181	11/26/80	UPD Add Note About New R/W For Valencia Rd. T.I.		
7676	5-4-88	MTR. Added & Zipped Abandoned Area & Note.		

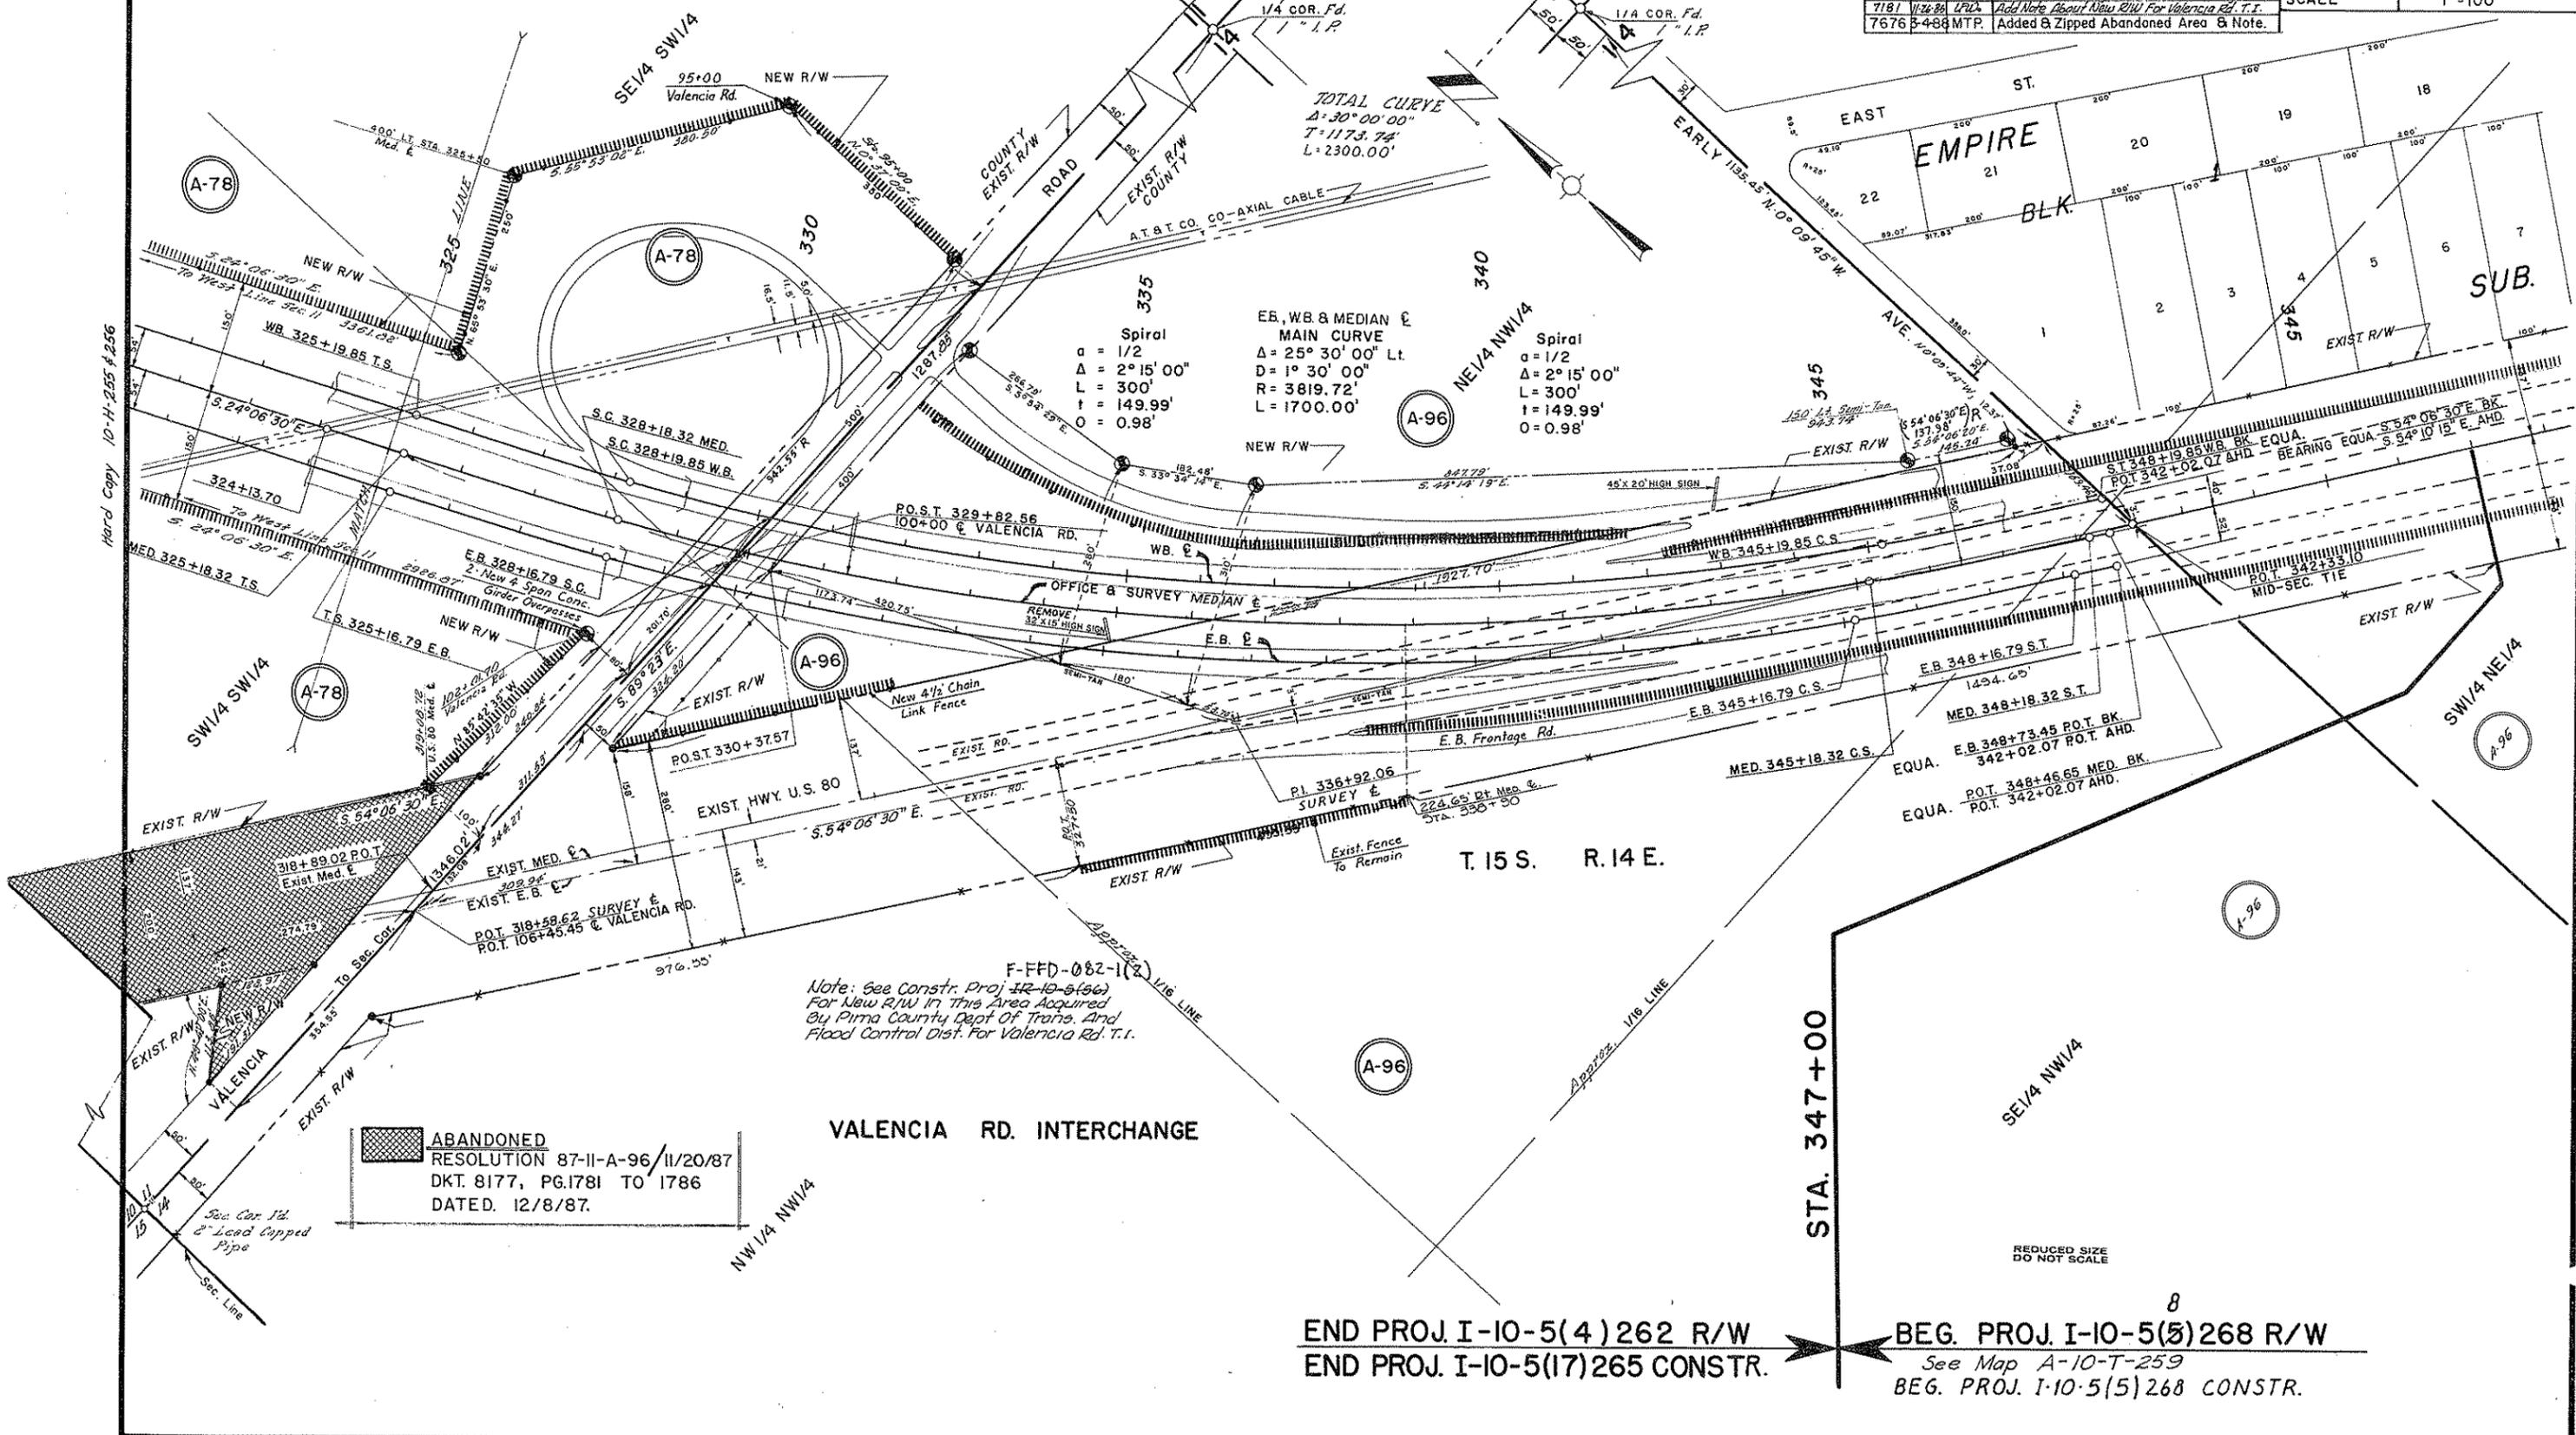

F-FFD-082-1(1)  
 Note: See Constr. Proj IR-10-5(66)  
 For New R/W in This Area Acquired  
 By Pima County Dept Of Trans. And  
 Flood Control Dist. For Valencia Rd. T.I.

ABANDONED  
 RESOLUTION 87-II-A-96/11/20/87  
 DKT. 8177, PG.1781 TO 1786  
 DATED. 12/8/87.


END PROJ. I-10-5(4)262 R/W  
 END PROJ. I-10-5(17)265 CONSTR.      STA. 347+00

BEG. PROJ. I-10-5(5)268 R/W  
 See Map A-10-T-259  
 BEG. PROJ. I-10-5(5)268 CONSTR.

REDUCED SIZE  
 DO NOT SCALE

**TUCSON-BENSON HWY. - U. S. 80  
VETERANS OVERPASS-EAST  
PIMA COUNTY**

REVISIONS			PROJECT NO.	I-10-5(4) 262
C.O. DATE	BY	DESCRIPTION	DRAWING NO.	D-10-T-290
367	Kowacz	Remove 529' x 28' Area, Correct 87' 11" to 87' 28"	SHEET NO.	13 of 13
		Correct 237+72.80 to 237+46.81 ALL OVER.	DRAWN BY	Kowacz
2775	11/23/70	Hartrim	DATE COMP.	3-2-64
5984	8-27-70	H. MILLS	SCALE	1" = 400'
7181	11-14-80	47W		
		Denoted Abandoned Land JULIAN WASH		
		Add Note About New R/W Acq. By Pima Co.		

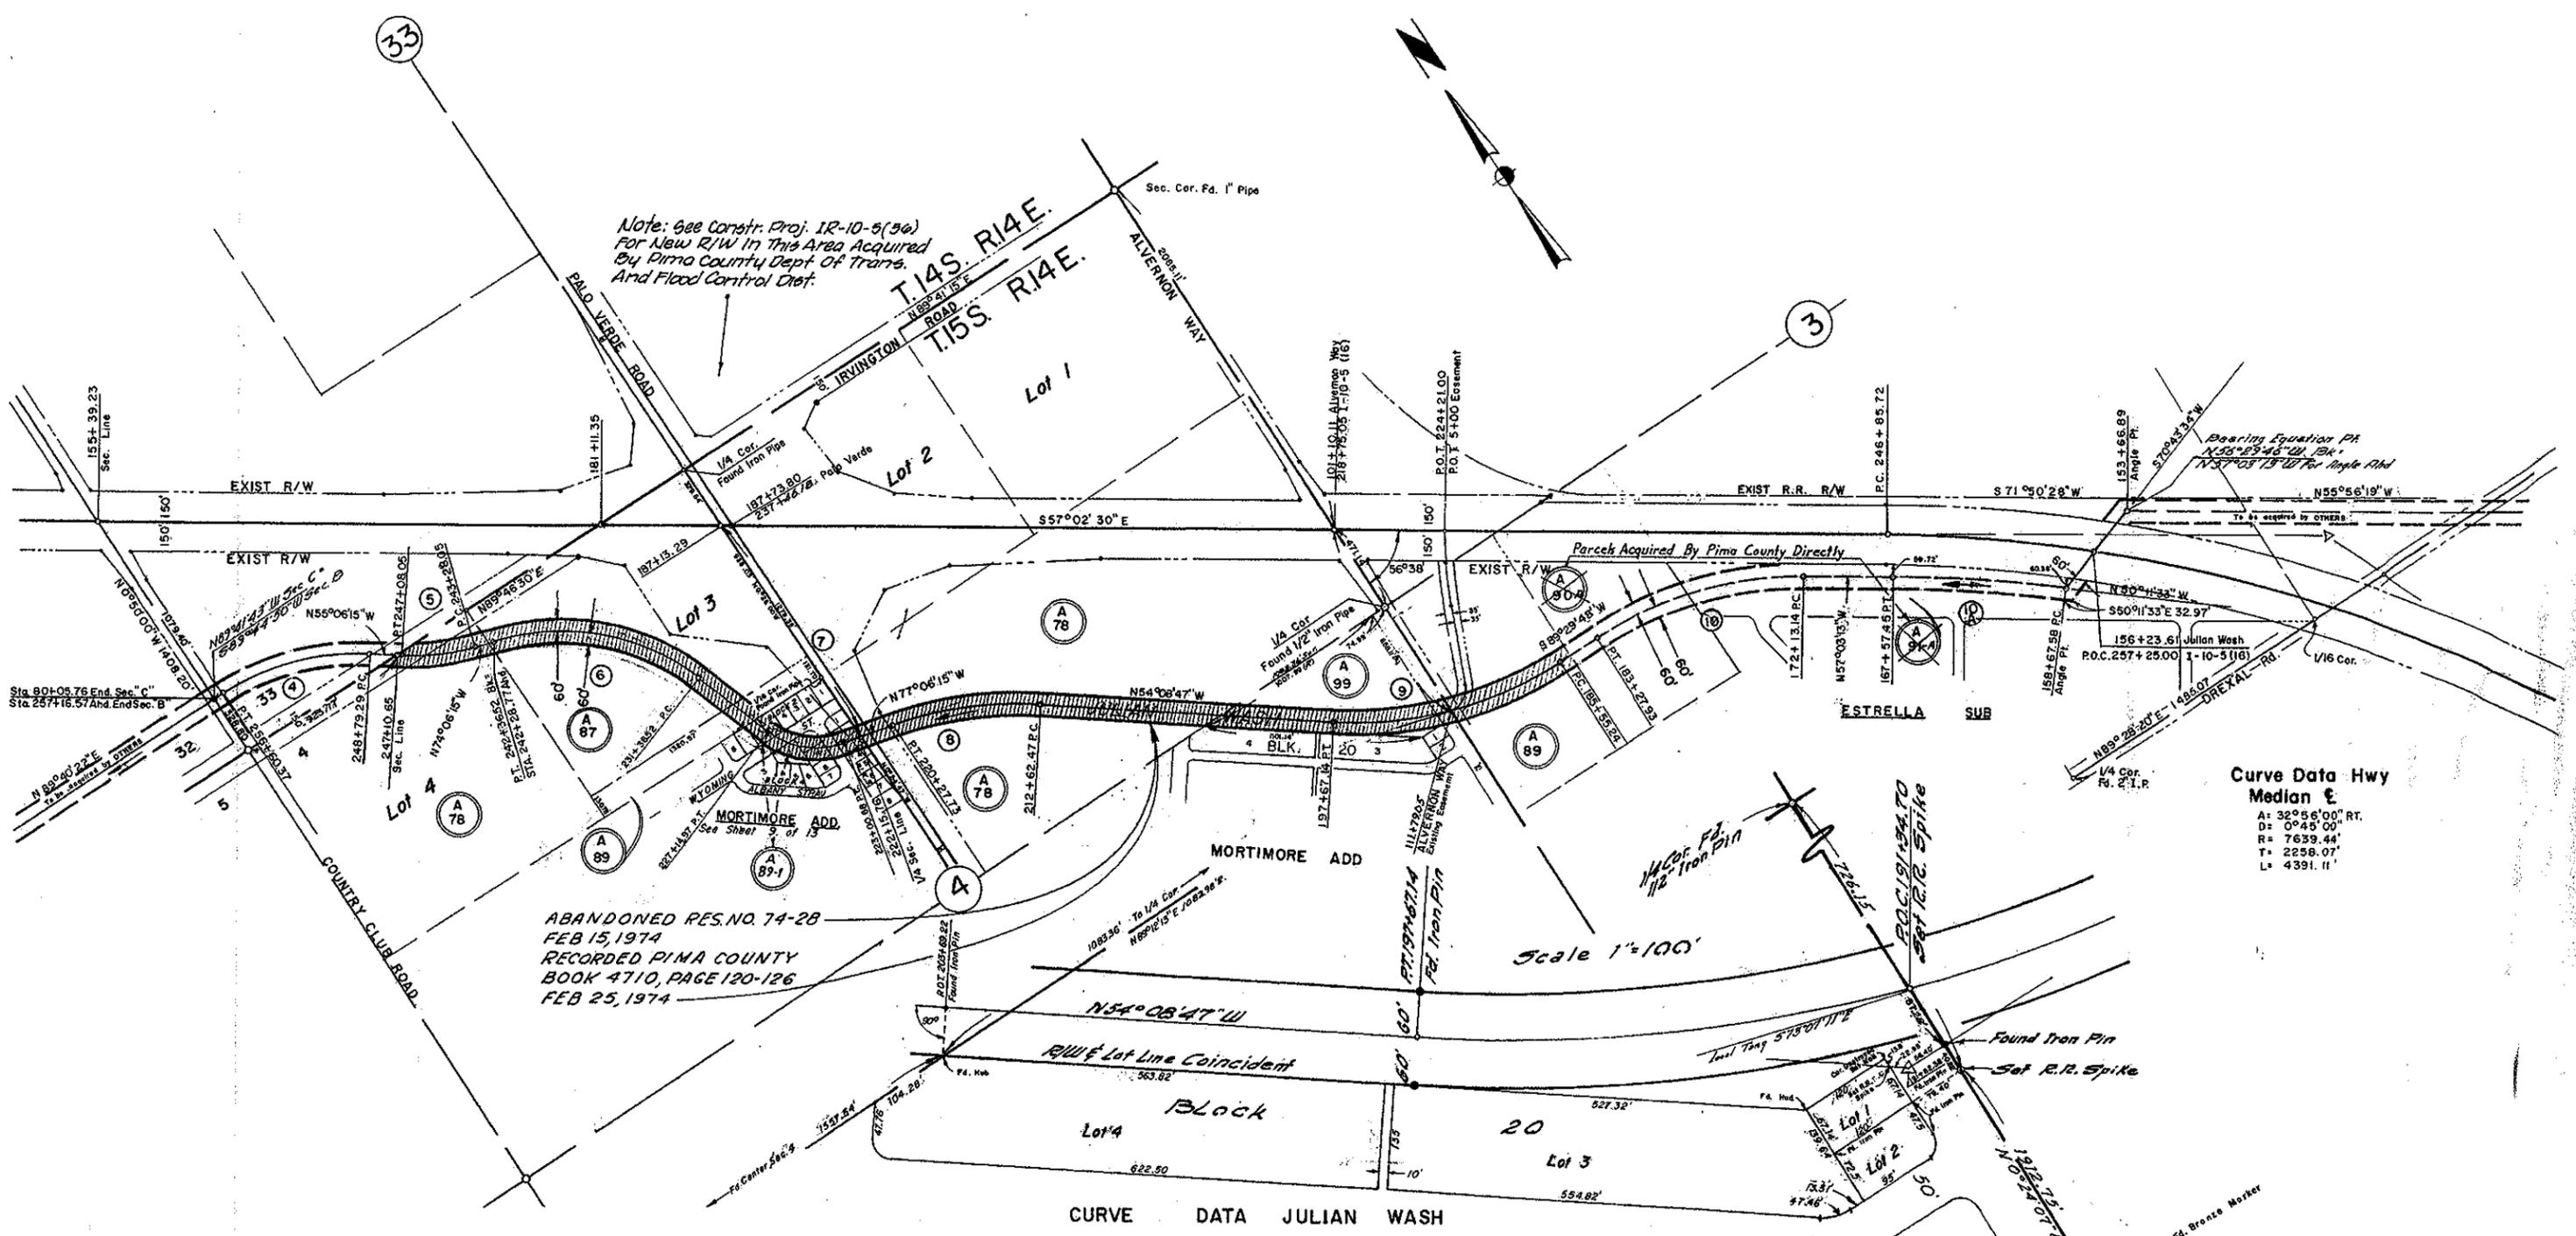

**Curve Data Hwy Median E**

A:	32° 56' 00" RT.
D:	0° 45' 00"
R:	7639.44'
T:	2258.07'
L:	4391.11'

**CURVE DATA JULIAN WASH**

	4	5	6	7	8	9	10	10A
A	35° 08' 55"	19° 00' 00"	55° 00' 00"	58° 00' 00"	22° 57' 28"	36° 21' 25"	33° 26' 59"	6° 51' 40"
D	4° 30' 00"	5°	5°	14° 14'	3°	3°	3°	0° 46' 16"
R	1273.24'	1145.92'	1145.92'	409.26'	1909.86'	1909.86'	1909.86'	7429.44'
T	403.27'	191.76'	596.53'	226.86'	387.83'	627.14'	573.89'	446.37'
L	781.08'	380.00'	1100.00'	814.29'	765.26'	1211.90'	1114.99'	889.67'

CHECKED BY: BRADLEY

HARD COPY