

★ PROJECT LOCATION

COUNTY NAME: PINAL  
 LENGTH OF PROJECT: 2.1 MILES  
 ADOT DISTRICT: CENTRAL (C)  
 DRAWING NUMBER: D-11-T-497

# NOTICE OF RIGHT OF WAY PROJECT

## MARICOPA ROAD

### MARICOPA UNION PACIFIC RAILROAD CROSSING

### 347 PN 172 H7007

### 347-A(204)A

**ARIZONA DEPARTMENT  
 OF  
 TRANSPORTATION**


INFRASTRUCTURE  
 DELIVERY AND OPERATIONS DIVISION



THIS SHEET WAS PRODUCED TO NOTIFY THE PUBLIC THAT A RIGHT OF WAY PROJECT HAS COMMENCED AND IS UNDER DEVELOPMENT FOR THE PORTION OF THE HIGHWAY(S) SHOWN AND DENOTED ON THIS SHEET. THE RIGHT OF WAY PROJECT UNDER DEVELOPMENT MAY CONSIST OF ONE OR MORE OF THE FOLLOWING PRODUCTS AND/OR SHEETS: RESULTS OF SURVEY, RIGHT OF WAY PLANS, DETAIL SHEETS AND MONUMENTATION SURVEYS. TO OBTAIN CURRENT STATUS OF THE PROJECT UNDER DEVELOPMENT AND TO INQUIRE IF ANY PRELIMINARY SHEETS OR OTHER INFORMATION IS AVAILABLE, PLEASE CONTACT THE RIGHT OF WAY PLANS SECTION AT:

DAN MILLER - (602) 712-6174, DMILLER3@AZDOT.GOV, OR  
 MICHAEL MAYES - (602) 712-8782, MMAYES@AZDOT.GOV.


WHEN ONE OR MORE OF THE ABOVE PRODUCTS HAS BEEN COMPLETED AND ACCEPTED BY THE RIGHT OF WAY PLANS SECTION, THIS NOTICE OF RIGHT OF WAY PROJECT SHEET WILL BE REPLACED ON THIS SITE BY THOSE PRODUCTS.

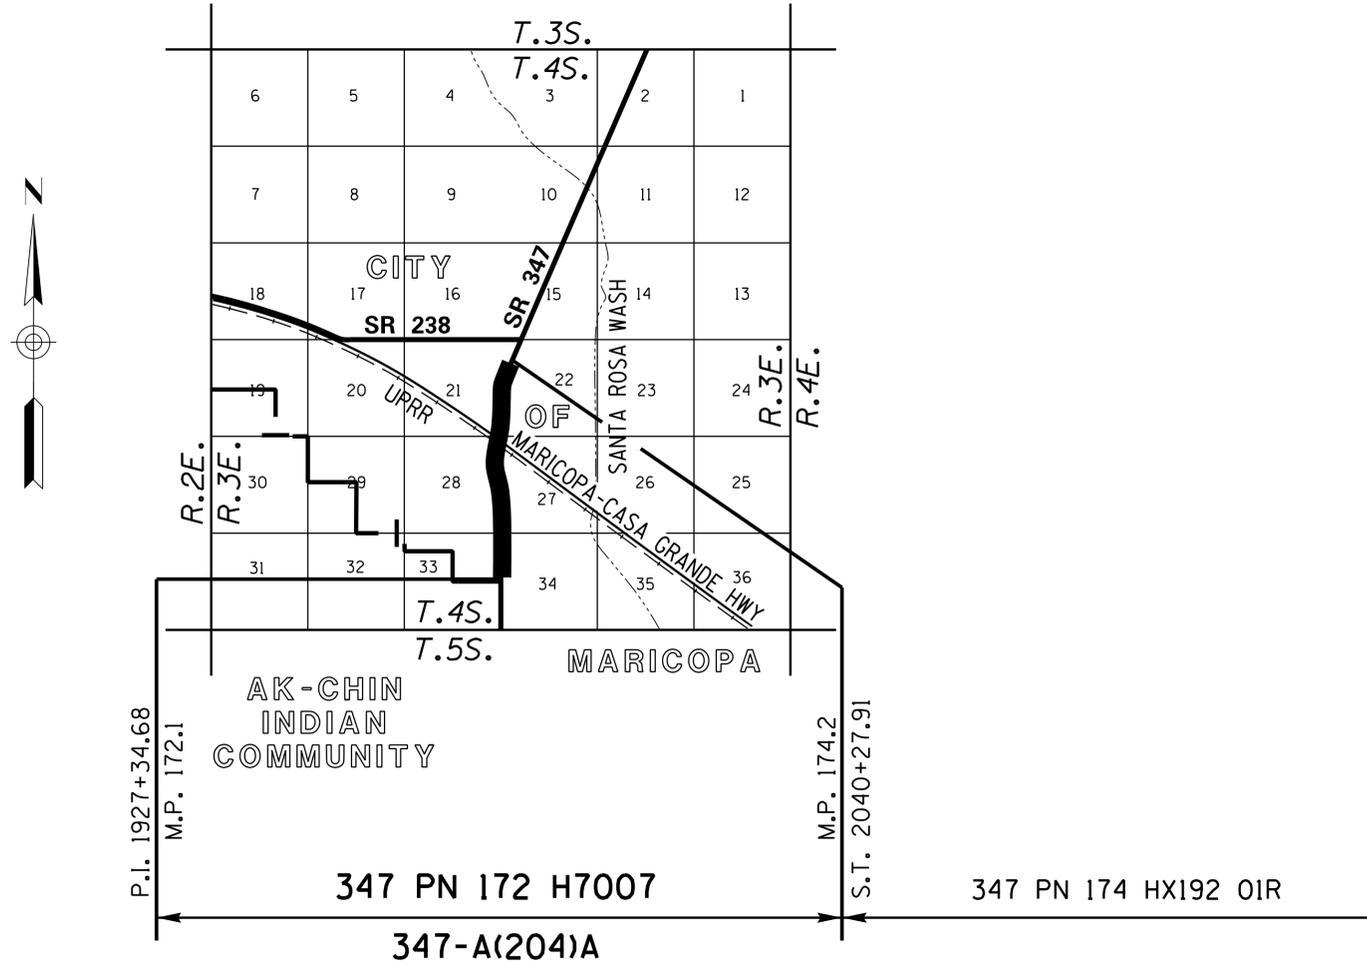

*Professional Land  
 Surveyor AZ No. 19817  
 Digitally signed by Jim  
 Crume  
 Date: 2016.02.18  
 14:57:42 -07'00'  
 (Expires 6-30-17)  
 ELECTRONIC SEAL  
<http://www.hls.state.az.us/>*







# RESULTS OF SURVEY

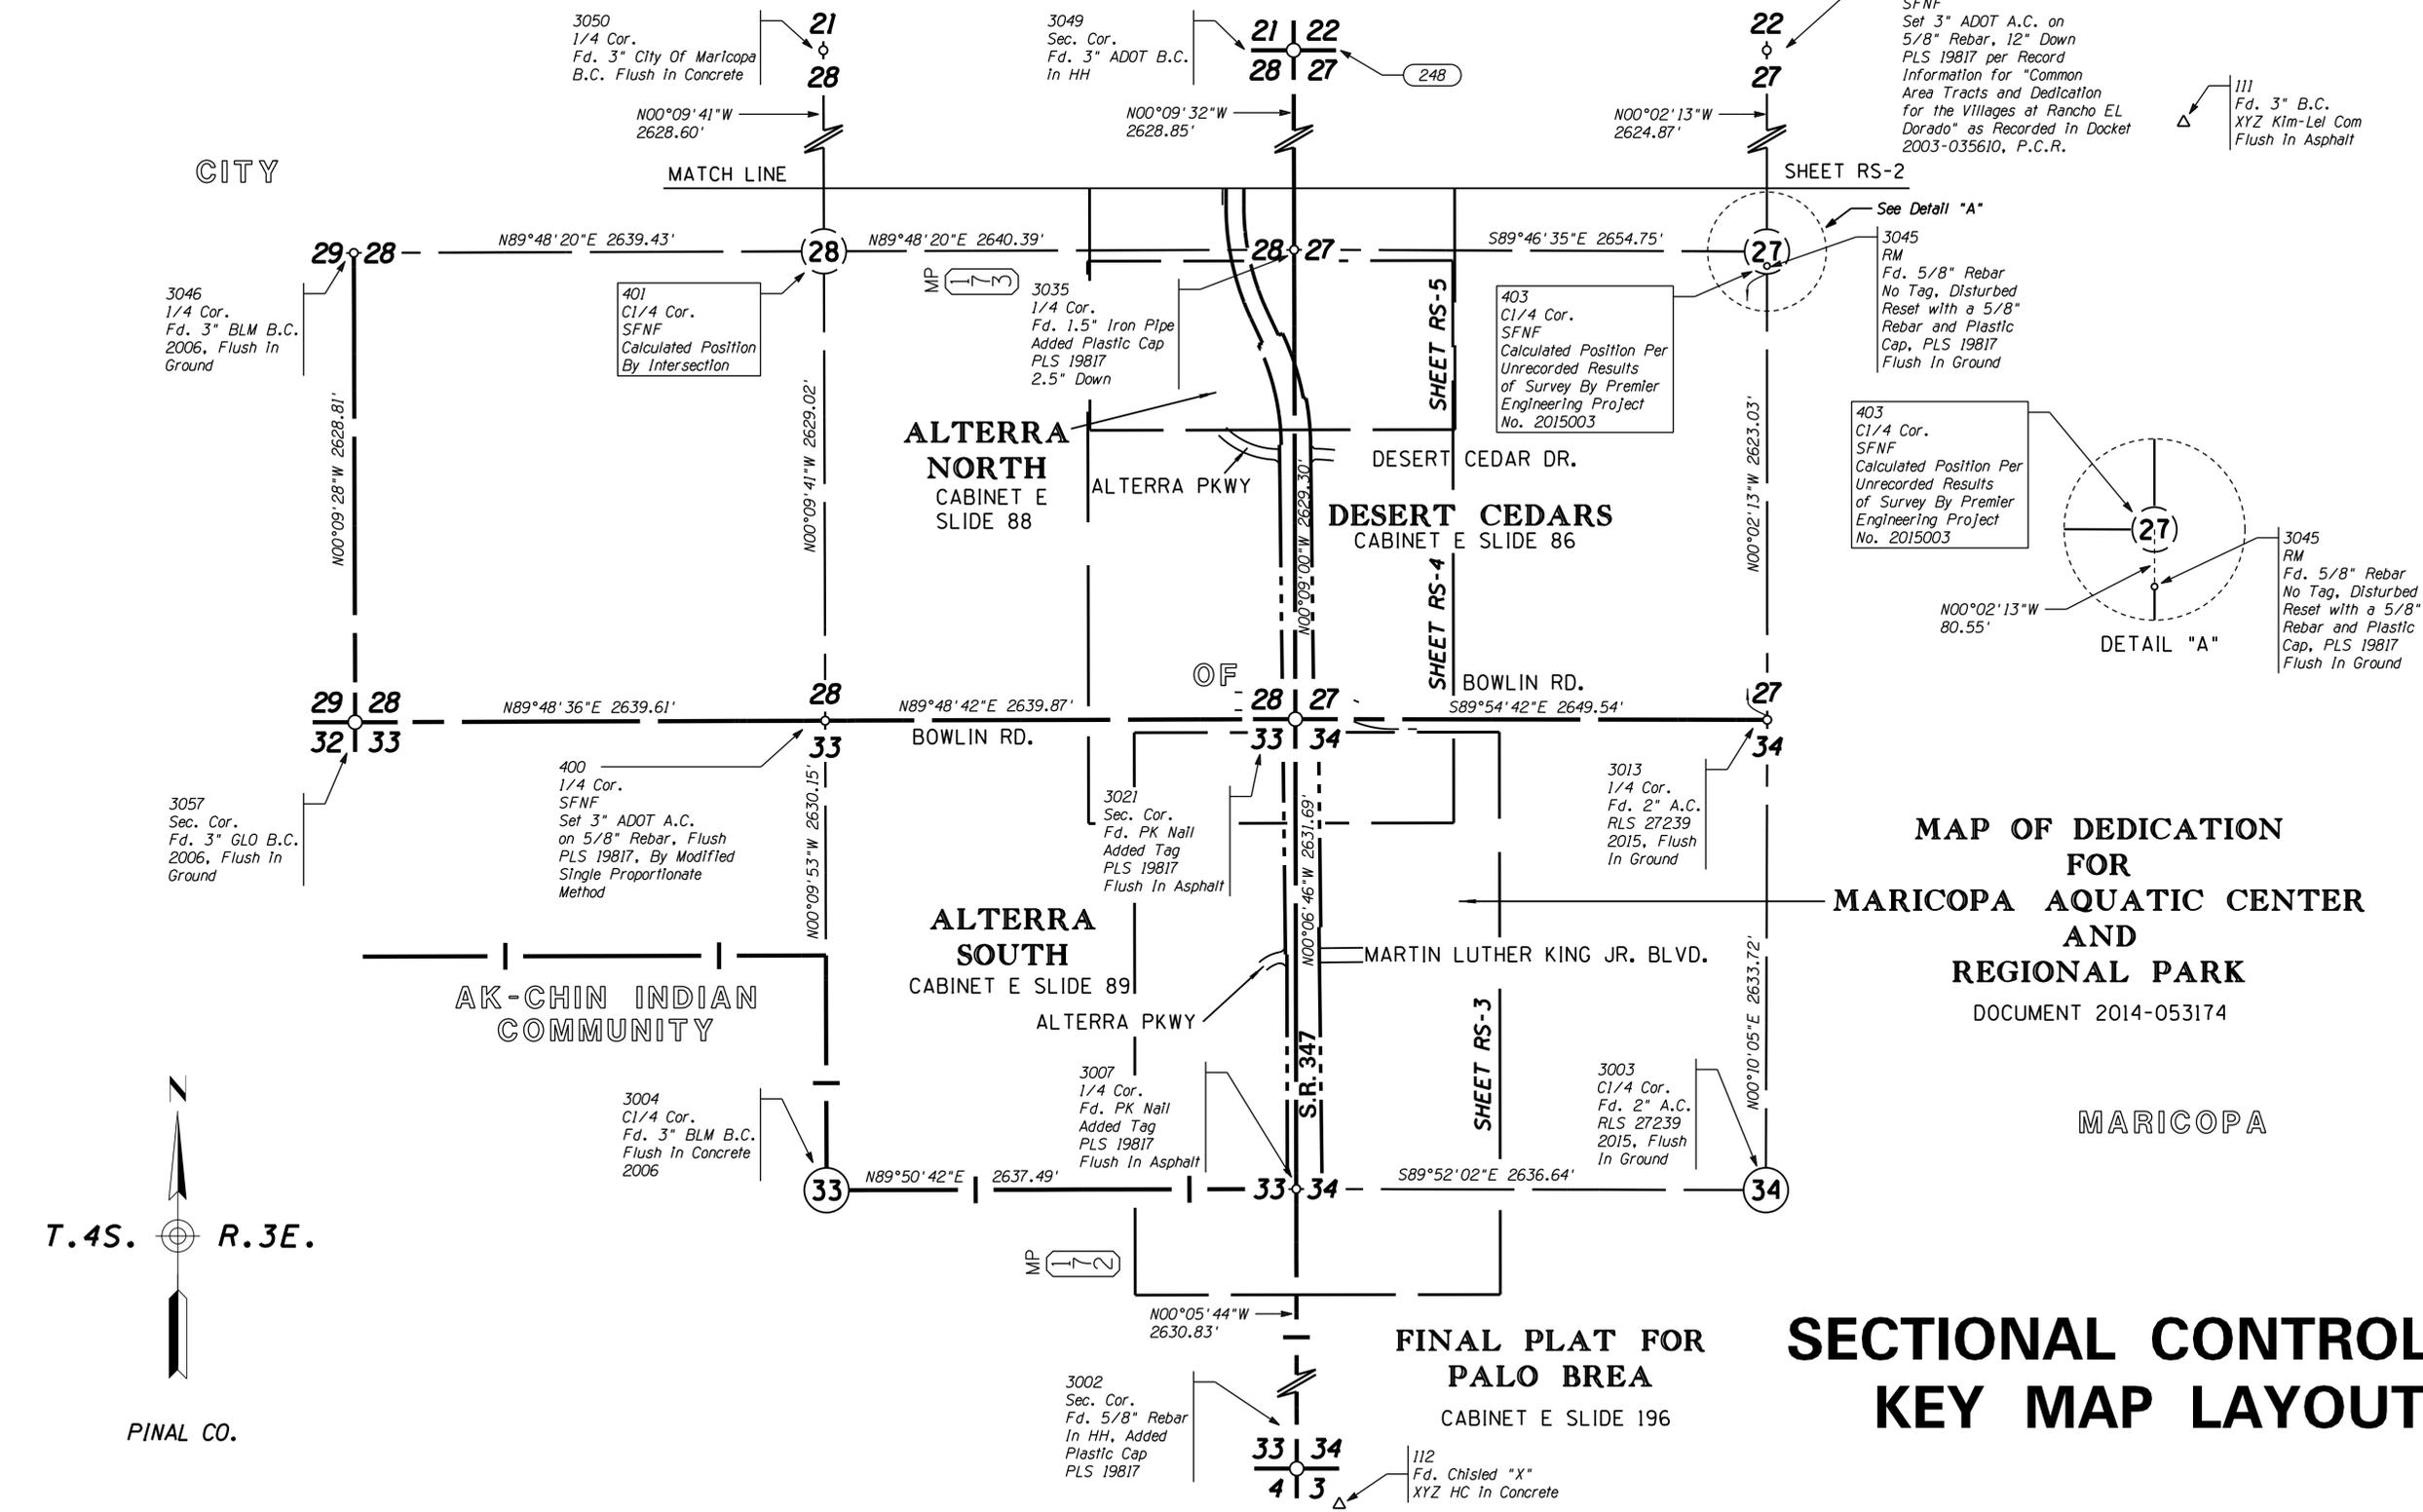

CHANGE ORDER REVISIONS				DRAWING NO.		ARIZONA DEPARTMENT OF TRANSPORTATION	
C.O. NO.	DATE	BY	DESCRIPTION OF REVISIONS	D-11-T-497	INFRASTRUCTURE DELIVERY AND OPERATIONS DIVISION		Professional Land
				SURVEY	RIGHT OF WAY PLANS SECTION		Surveyor AZ No. 19817
				JULY 2015	HIGHWAY NAME:		Digitally signed by Jim
				B.CRUME/JULY 2015	MARICOPA ROAD		Crume
				KEN RICHMOND	FEDERAL AID NO.:		Date: 2016.02.18
					347-A(204)A		14:58:01 -07'00"
					PROJECT NO.:		(Expires 6-30-17)
					347 PN 172 H7007		ELECTRONIC SEAL
					ROUTE NO.:		http://www.btr.state.az.us/
					MARICOPA UNION PACIFIC RAILROAD CROSSING		Certified Federal
					SHEET		Surveyor No. 1293
					RS-1		(Expires 10-2-17)
							http://www.sfdcs.org/roster.asp

# RESULTS OF SURVEY

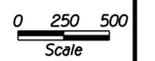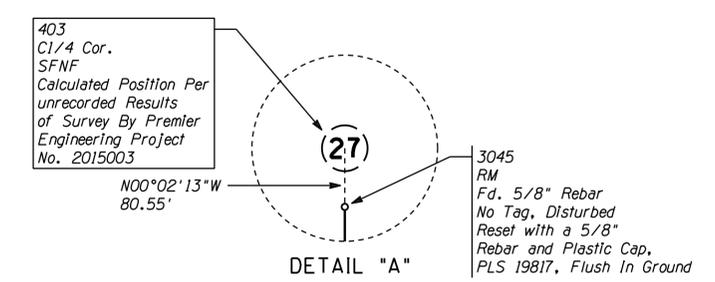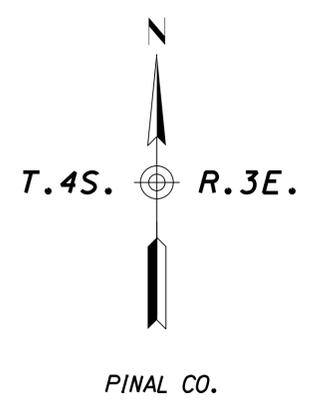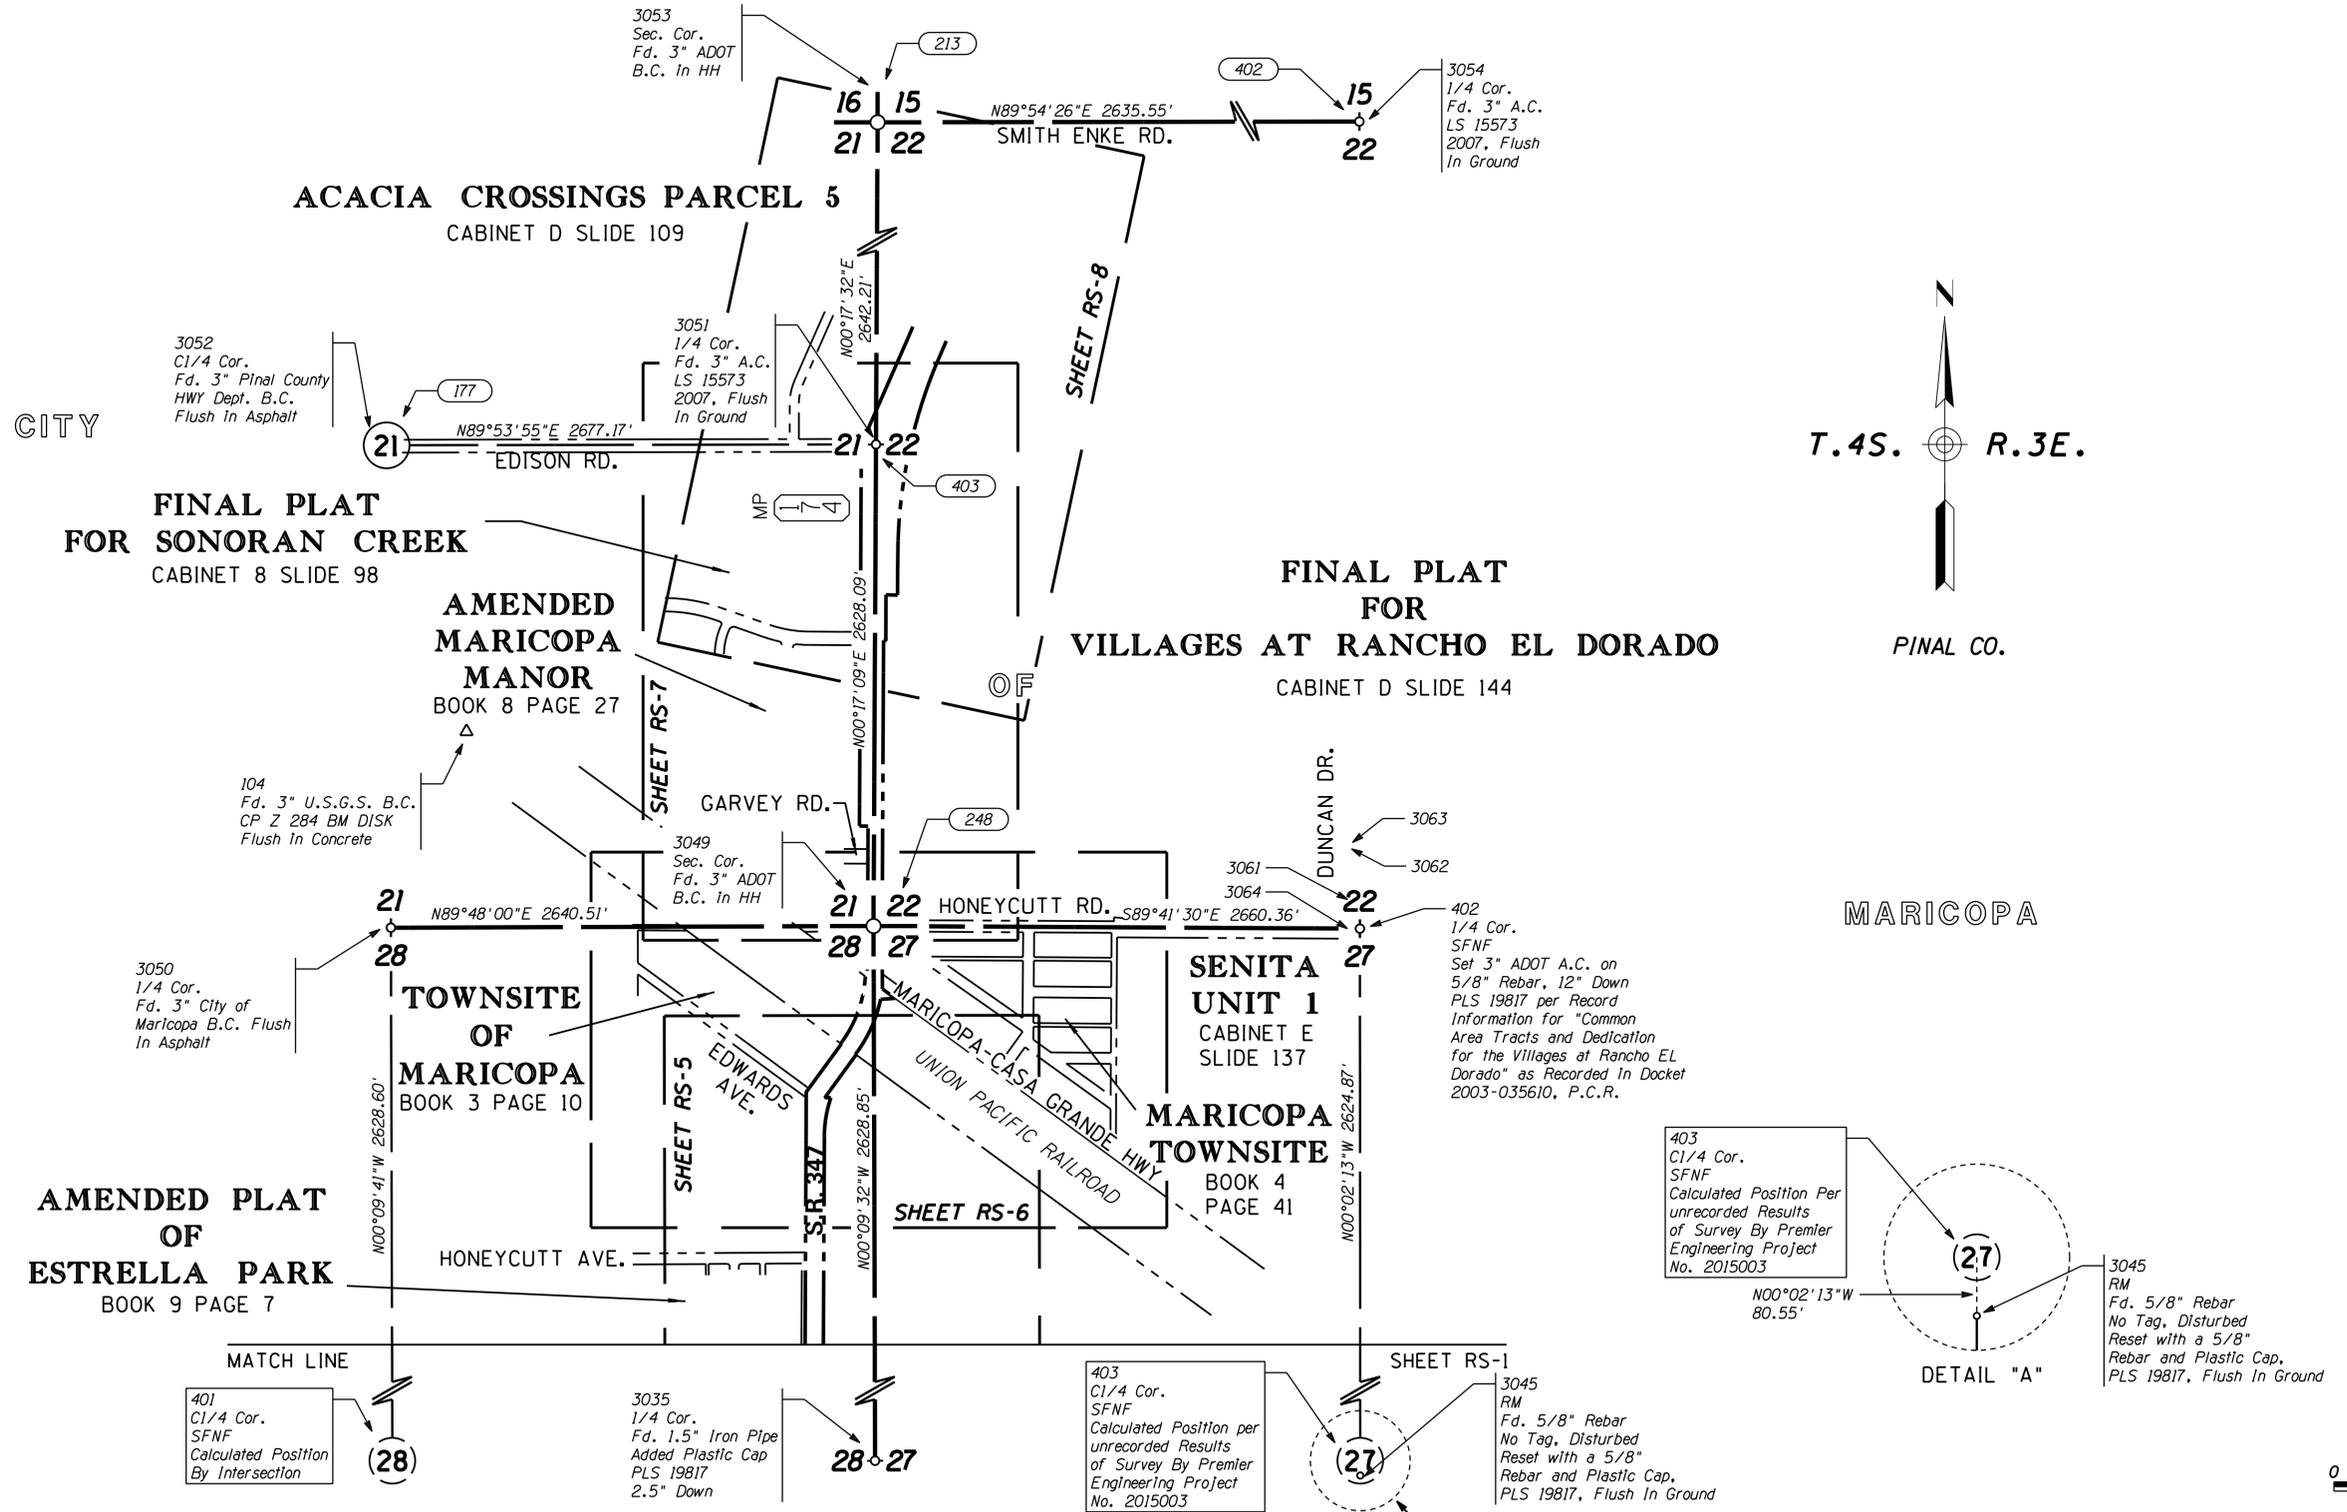


## SECTIONAL CONTROL & KEY MAP

248 Point Numbers Shown on R/W Project 347 PN 174 HX192 OIR Results of Survey

- LEGEND**
- 302 Set Monument
  - 300 Found Monument
  - 301 Calculated position
  - Existing ADOT R/W monument
  - SFNF Searched For Not Found

CHANGE ORDER REVISIONS				DRAWING NO.	ARIZONA DEPARTMENT OF TRANSPORTATION INFRASTRUCTURE DELIVERY AND OPERATIONS DIVISION RIGHT OF WAY PLANS SECTION	
C.O. NO.	DATE	BY	DESCRIPTION OF REVISIONS	D-11-T-497	HIGHWAY NAME: MARICOPA ROAD	
				SURVEY	DATE: 2016.02.18	
				DRAWN/DATE	14:58:23 -07'00'	
				ADOT REVIEW	FEDERAL AID NO.: 347-A(204)A	
				RITOCH-POWELL & ASSOCIATES 602.263.1177 www.rtochpowell.com	PROJECT NO.: 347 PN 172 H7007	
					Certified Federal Surveyor No. 1293 (Expires 10-2-17) <a href="http://www.cfdcs.org/roster.asp">http://www.cfdcs.org/roster.asp</a>	
				ROUTE NO.: S.R. 347	LOCATION: MARICOPA UNION PACIFIC RAILROAD CROSSING	


# RESULTS OF SURVEY

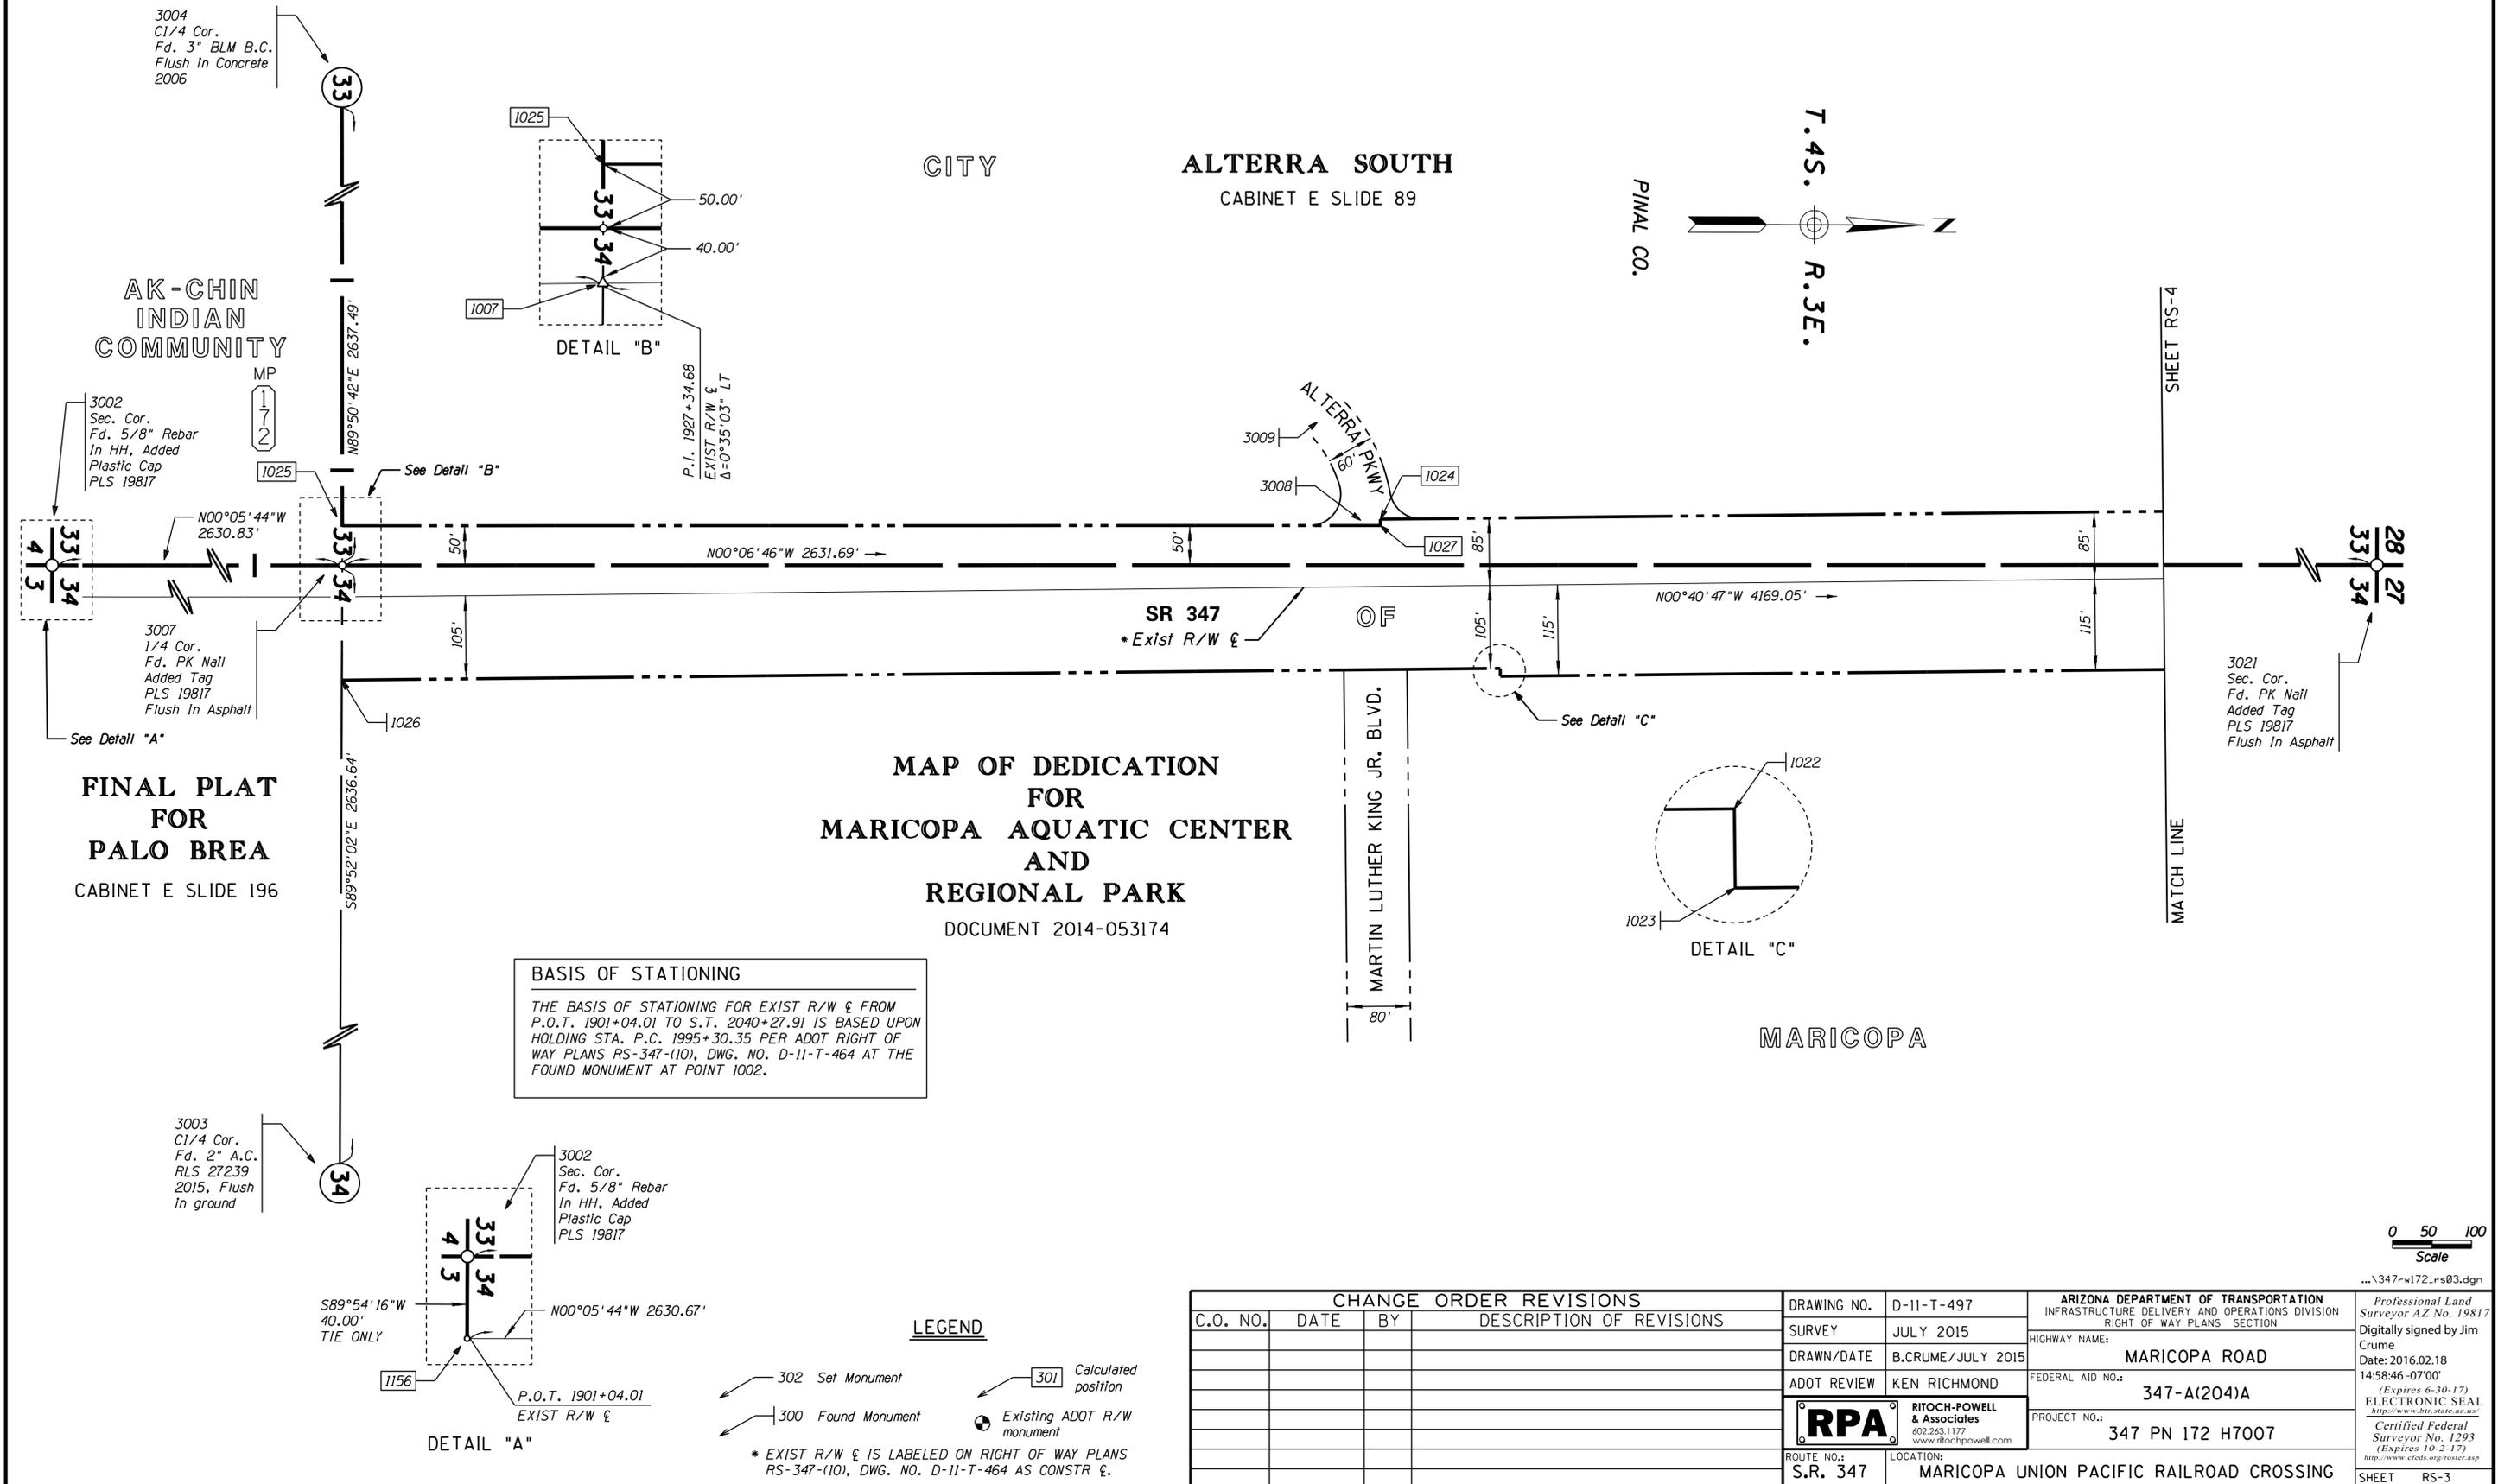

## MAP OF DEDICATION FOR MARICOPA AQUATIC CENTER AND REGIONAL PARK

DOCUMENT 2014-053174


**BASIS OF STATIONING**  
 THE BASIS OF STATIONING FOR EXIST R/W & FROM P.O.T. 1901+04.01 TO S.T. 2040+27.91 IS BASED UPON HOLDING STA. P.C. 1995+30.35 PER ADOT RIGHT OF WAY PLANS RS-347-(10), DWG. NO. D-11-T-464 AT THE FOUND MONUMENT AT POINT 1002.

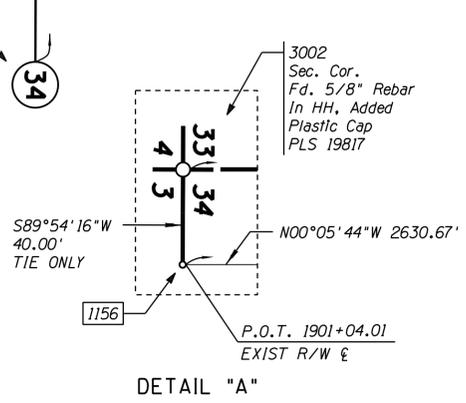

DETAIL "A"



DETAIL "B"

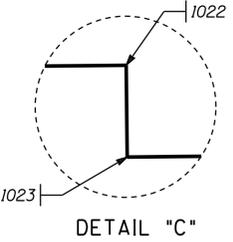


DETAIL "C"

**LEGEND**

- 302 Set Monument
- 300 Found Monument
- 301 Calculated position
- Existing ADOT R/W monument

\* EXIST R/W & IS LABELED ON RIGHT OF WAY PLANS RS-347-(10), DWG. NO. D-11-T-464 AS CONSTR &.





CHANGE ORDER REVISIONS				DRAWING NO.	ARIZONA DEPARTMENT OF TRANSPORTATION	
C.O. NO.	DATE	BY	DESCRIPTION OF REVISIONS	D-11-T-497	INFRASTRUCTURE DELIVERY AND OPERATIONS DIVISION	
				SURVEY	RIGHT OF WAY PLANS SECTION	
				DRAWN/DATE	HIGHWAY NAME: MARICOPA ROAD	
				ADOT REVIEW	FEDERAL AID NO.: 347-A(204)A	
				RITOCH-POWELL & ASSOCIATES 602.263.1177 www.rtochpowell.com	PROJECT NO.: 347 PN 172 H7007	
					ROUTE NO.: S.R. 347	LOCATION: MARICOPA UNION PACIFIC RAILROAD CROSSING

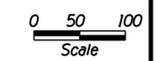

Scale

Professional Land Surveyor AZ No. 19817  
 Digitally signed by Jim Crume  
 Date: 2016.02.18 14:58:46 -07'00'  
 (Expires 6-30-17)  
 ELECTRONIC SEAL  
 http://www.bls.state.az.us/  
 Certified Federal Surveyor No. 1293  
 (Expires 10-2-17)  
 http://www.cfdcs.org/roster.asp


# RESULTS OF SURVEY

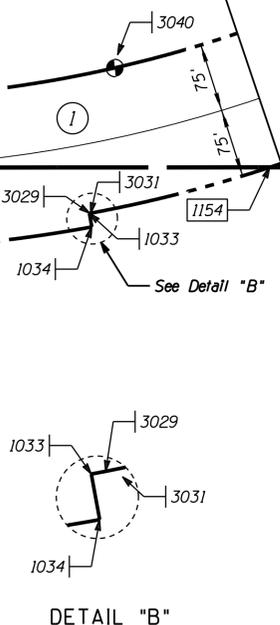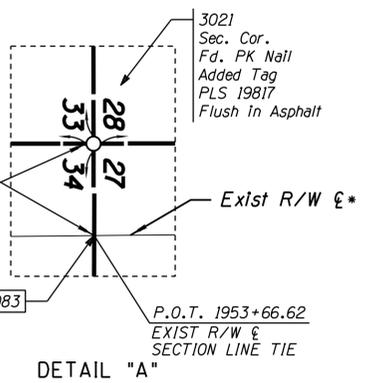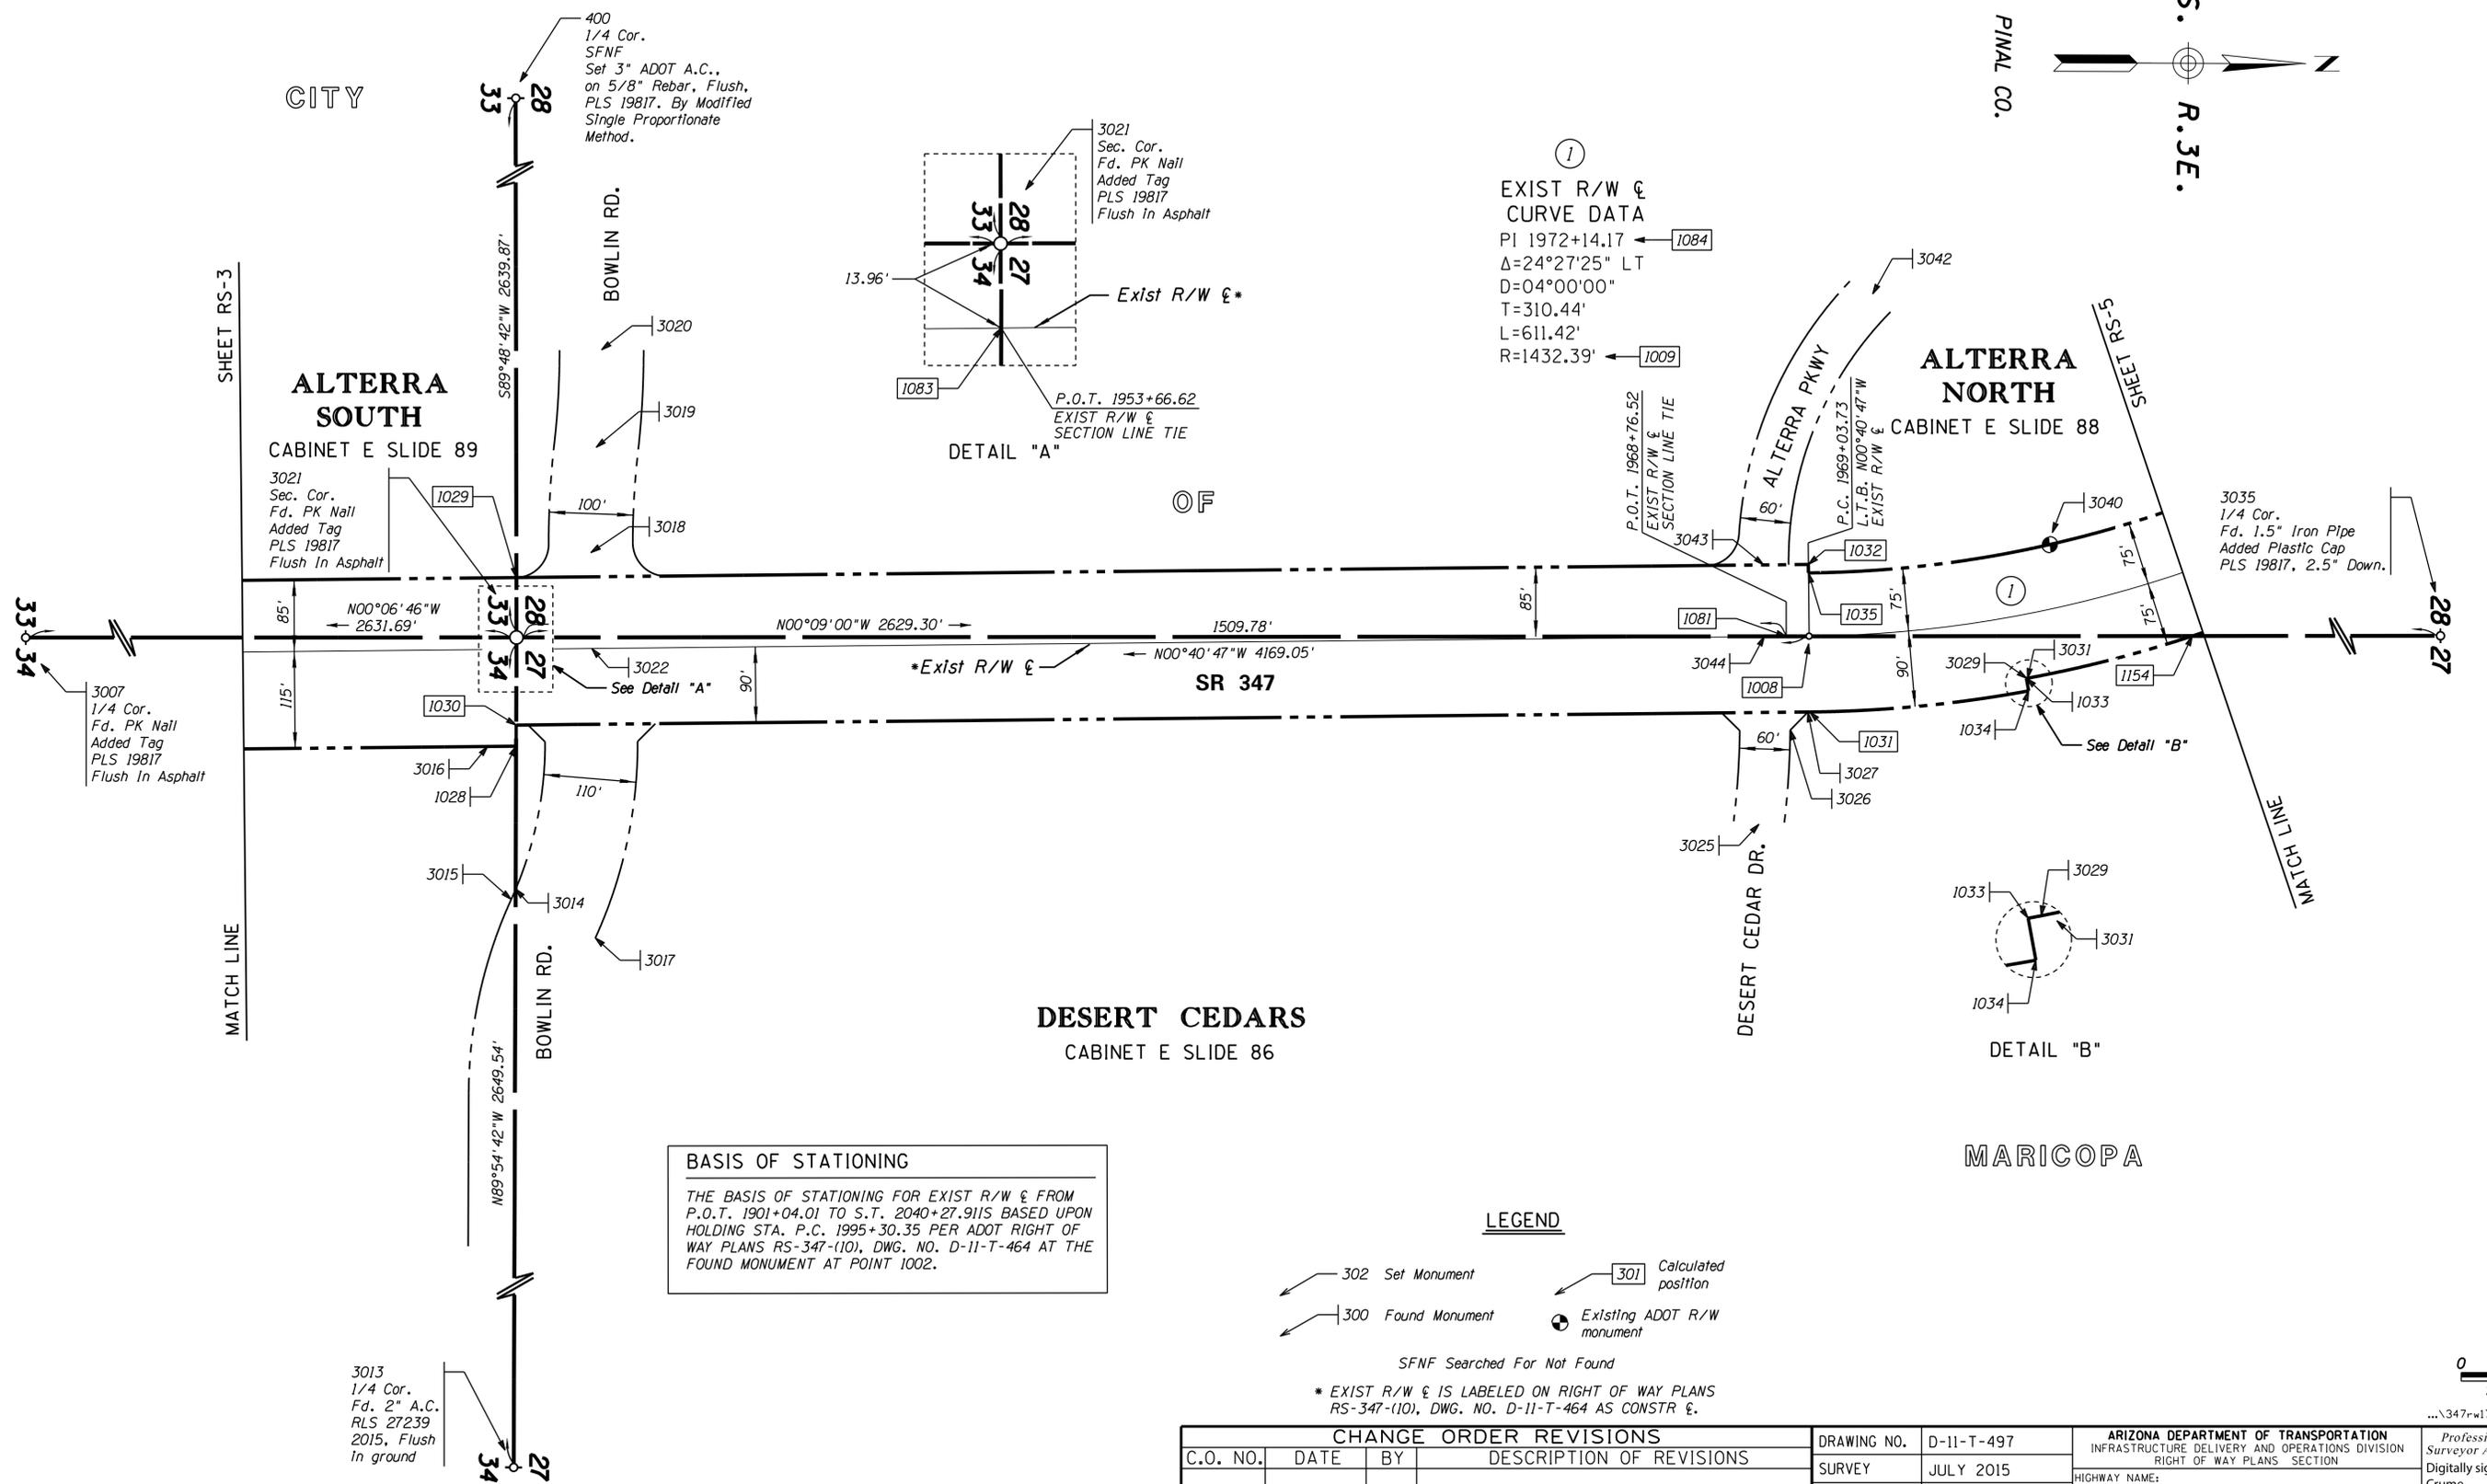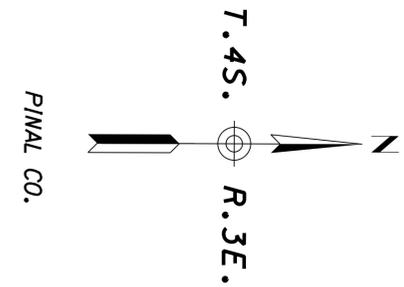

**BASIS OF STATIONING**  
 THE BASIS OF STATIONING FOR EXIST R/W & FROM P.O.T. 1901+04.01 TO S.T. 2040+27.9115 BASED UPON HOLDING STA. P.C. 1995+30.35 PER ADOT RIGHT OF WAY PLANS RS-347-(10), DWG. NO. D-11-T-464 AT THE FOUND MONUMENT AT POINT 1002.



**LEGEND**  
 302 Set Monument  
 300 Found Monument  
 301 Calculated position  
 Existing ADOT R/W monument  
 SFNF Searched For Not Found

\* EXIST R/W & IS LABELED ON RIGHT OF WAY PLANS RS-347-(10), DWG. NO. D-11-T-464 AS CONSTR &.

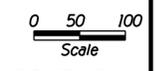

CHANGE ORDER REVISIONS				DRAWING NO.	D-11-T-497	ARIZONA DEPARTMENT OF TRANSPORTATION INFRASTRUCTURE DELIVERY AND OPERATIONS DIVISION RIGHT OF WAY PLANS SECTION	Professional Land Surveyor AZ No. 19817 Digitally signed by Jim Crume Date: 2016.02.18 14:59:11 -07'00' (Expires 6-30-17) ELECTRONIC SEAL <a href="http://www.btr.state.az.us/">http://www.btr.state.az.us/</a>
C.O. NO.	DATE	BY	DESCRIPTION OF REVISIONS	SURVEY	JULY 2015		
				DRAWN/DATE	B.CRUME/JULY 2015	HIGHWAY NAME:	MARICOPA ROAD
				ADOT REVIEW	KEN RICHMOND	FEDERAL AID NO.:	347-A(204)A
				<b>RPA</b> RITTOCH-POWELL & Associates 602.263.1177 www.rittochpowell.com		PROJECT NO.:	347 PN 172 H7007
				ROUTE NO.:	S.R. 347	LOCATION:	MARICOPA UNION PACIFIC RAILROAD CROSSING
							Certified Federal Surveyor No. 1293 (Expires 10-2-17) <a href="http://www.sfdca.org/roster.asp">http://www.sfdca.org/roster.asp</a>

# RESULTS OF SURVEY

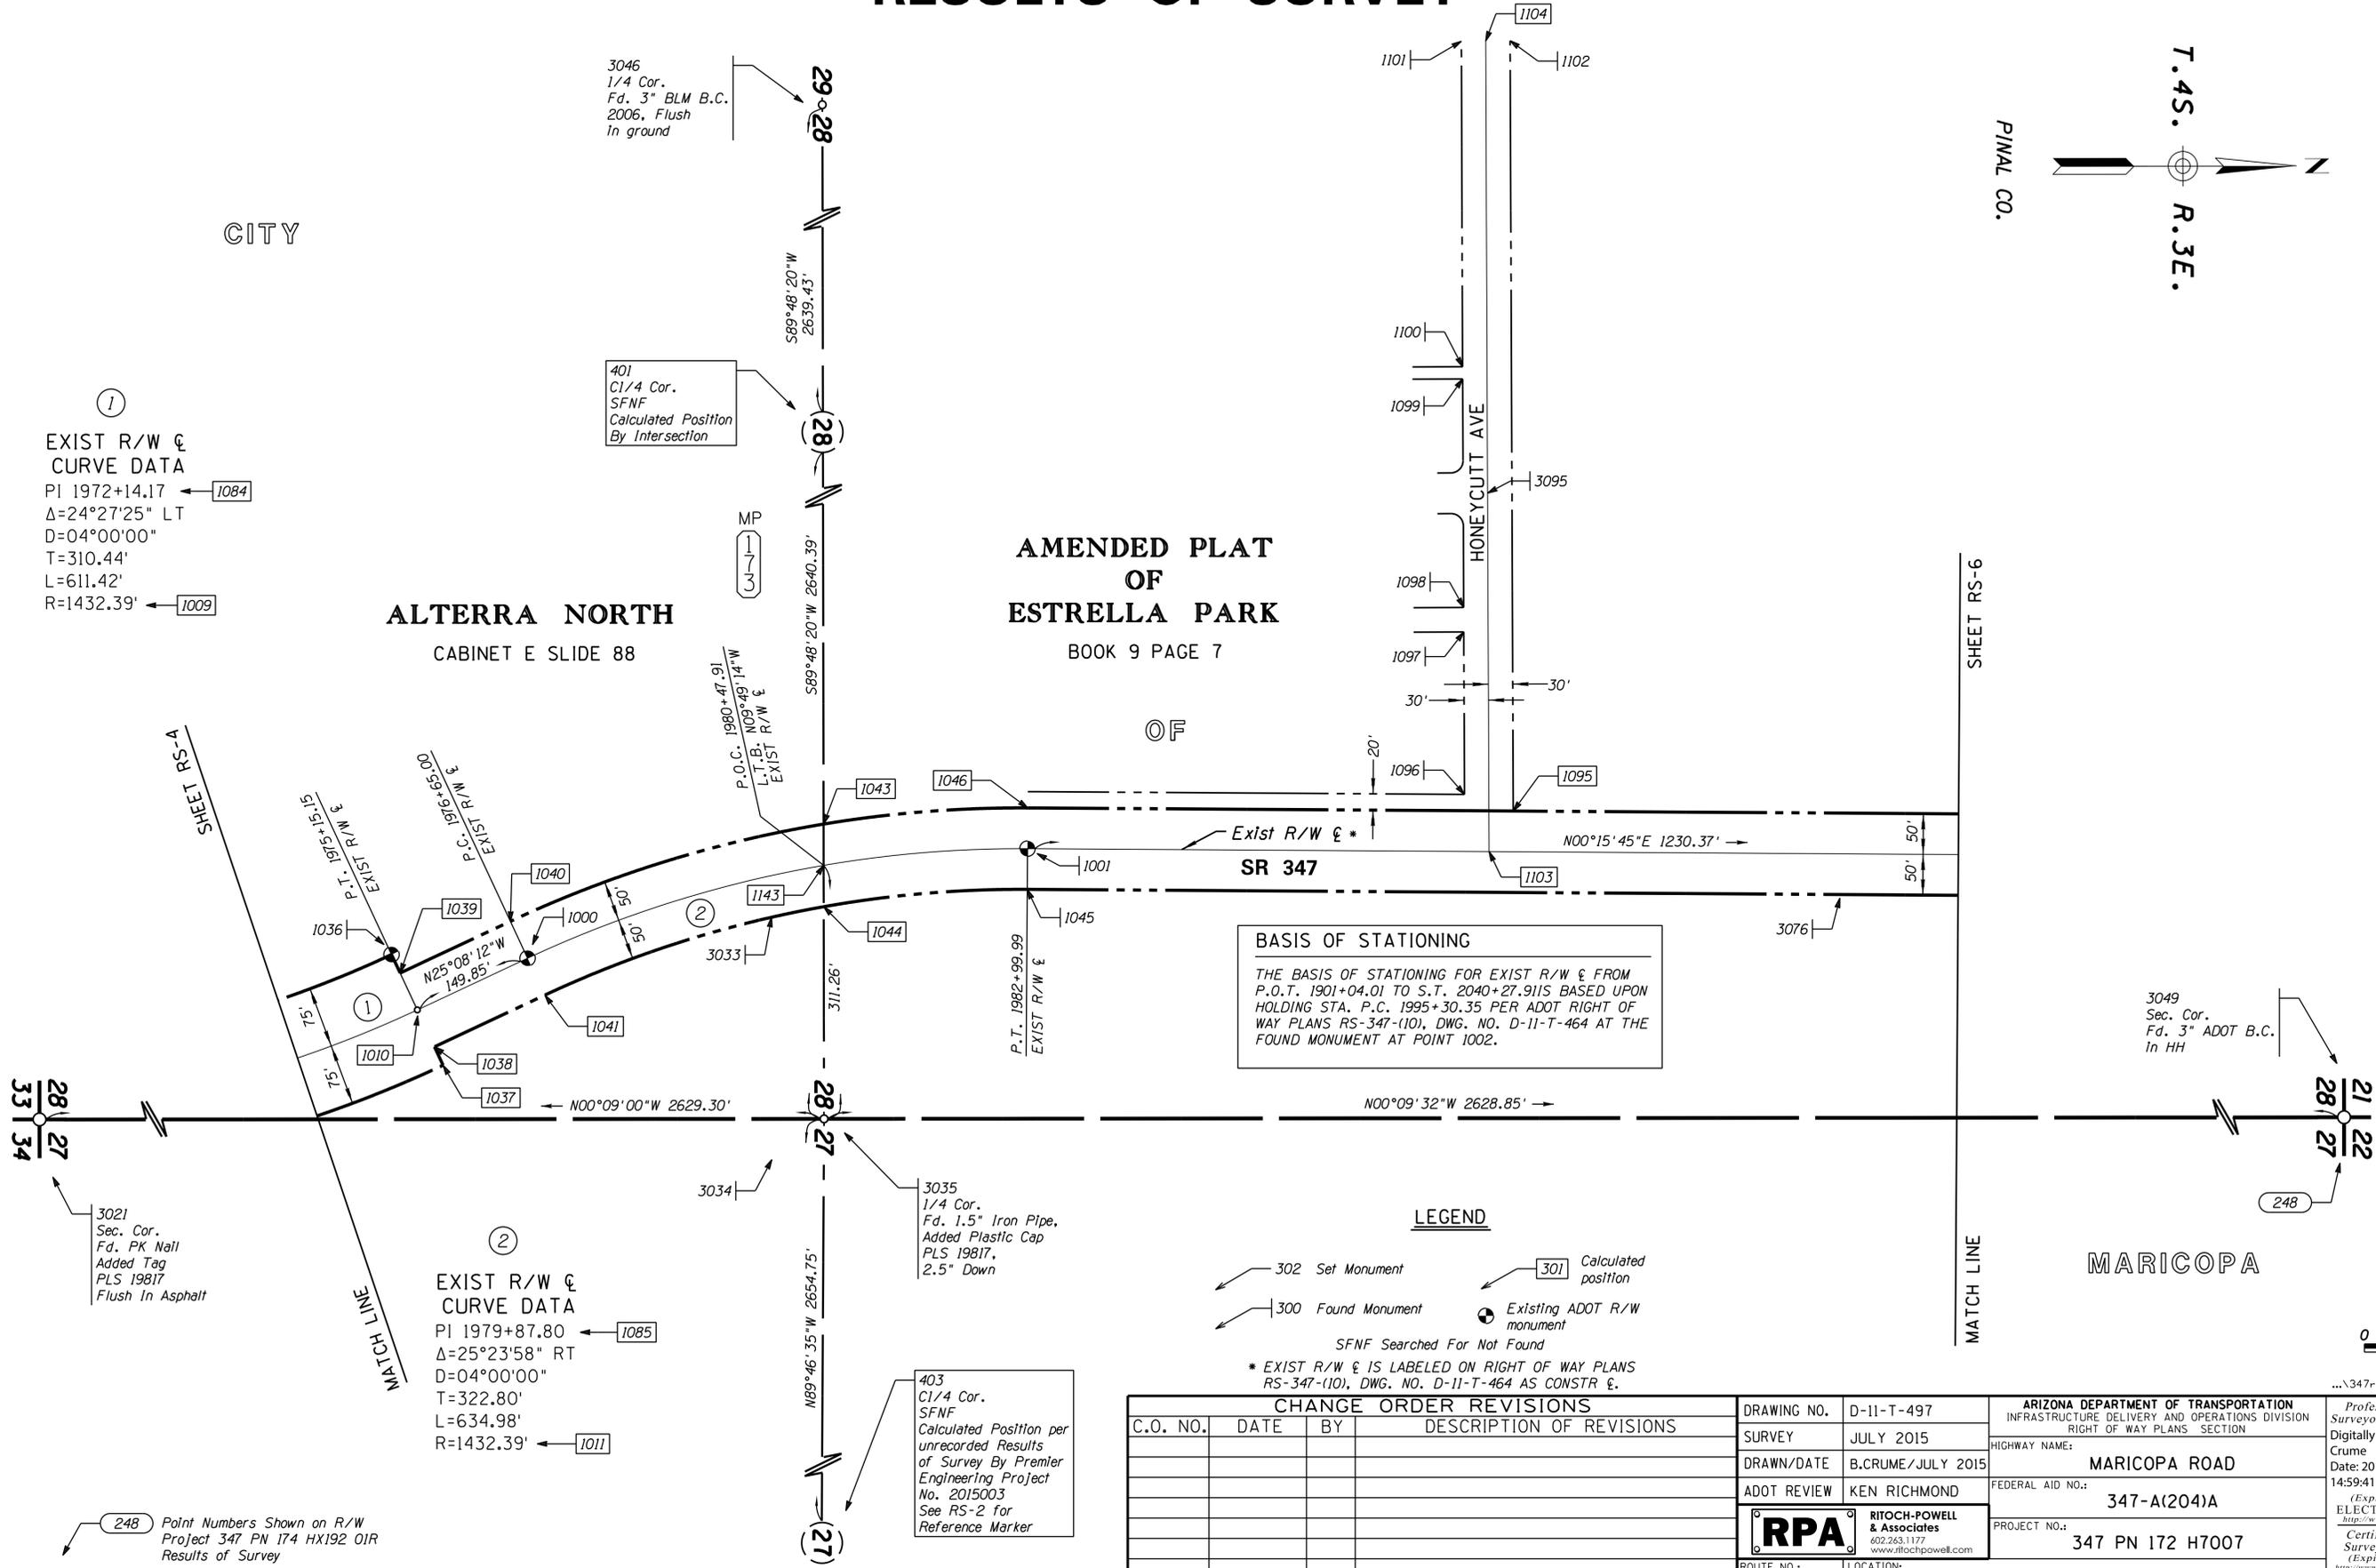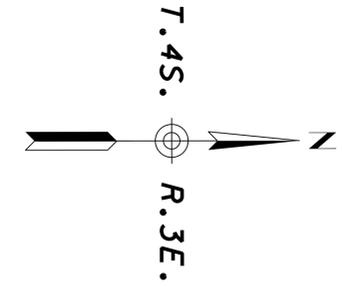

①  
EXIST R/W & CURVE DATA  
PI 1972+14.17 ← 1084  
Δ=24°27'25" LT  
D=04°00'00"  
T=310.44'  
L=611.42'  
R=1432.39' ← 1009

**ALTEIRA NORTH**  
CABINET E SLIDE 88

**AMENDED PLAT OF ESTRELLA PARK**  
BOOK 9 PAGE 7

**BASIS OF STATIONING**  
THE BASIS OF STATIONING FOR EXIST R/W & FROM P.O.T. 1901+04.01 TO S.T. 2040+27.9115 BASED UPON HOLDING STA. P.C. 1995+30.35 PER ADOT RIGHT OF WAY PLANS RS-347-(10), DWG. NO. D-11-T-464 AT THE FOUND MONUMENT AT POINT 1002.

**LEGEND**

- 302 Set Monument
- 300 Found Monument
- 301 Calculated position
- Existing ADOT R/W monument

SFNF Searched For Not Found

\* EXIST R/W & IS LABELED ON RIGHT OF WAY PLANS RS-347-(10), DWG. NO. D-11-T-464 AS CONSTR. &

②  
**EXIST R/W & CURVE DATA**  
PI 1979+87.80 ← 1085  
Δ=25°23'58" RT  
D=04°00'00"  
T=322.80'  
L=634.98'  
R=1432.39' ← 1011

403  
C1/4 Cor.  
SFNF  
Calculated Position per unrecorded Results of Survey By Premier Engineering Project No. 2015003  
See RS-2 for Reference Marker

CHANGE ORDER REVISIONS			
C.O. NO.	DATE	BY	DESCRIPTION OF REVISIONS

DRAWING NO.	D-11-T-497	ARIZONA DEPARTMENT OF TRANSPORTATION INFRASTRUCTURE DELIVERY AND OPERATIONS DIVISION RIGHT OF WAY PLANS SECTION	Professional Land Surveyor AZ No. 19817 Digitally signed by Jim Crume Date: 2016.02.18 14:59:41 -07'00' (Expires 6-30-17) ELECTRONIC SEAL <a href="http://www.bls.state.az.us/">http://www.bls.state.az.us/</a> Certified Federal Surveyor No. 1293 (Expires 10-2-17) <a href="http://www.cfed.org/roster.asp">http://www.cfed.org/roster.asp</a>
SURVEY	JULY 2015		
DRAWN/DATE	B.CRUME/JULY 2015	HIGHWAY NAME:	MARICOPA ROAD
ADOT REVIEW	KEN RICHMOND	FEDERAL AID NO.:	347-A(204)A
ROUTE NO.:	S.R. 347	PROJECT NO.:	347 PN 172 H7007
LOCATION:	MARICOPA UNION PACIFIC RAILROAD CROSSING		
			SHEET RS-5



# RESULTS OF SURVEY


## HONEYCUTT RD. & BASIS OF STATIONING

THE BASIS OF STATIONING FOR HONEYCUTT RD. & FROM P.O.T. 10+00.00 TO P.O.T. 36+53.36 IS BASED UPON HOLDING STA. P.O.T. 10+00.00 PER ADOT RIGHT OF WAY PLANS RS-347-(10), DWG. NO. D-11-T-464.




## RAILROAD BASIS OF STATIONING

THE UNION PACIFIC RAILROAD CENTERLINE WAS DETERMINED BY THE LOCATION OF THE RAILROAD TRACK CENTERLINE AT PT. 3110 AND A 100' OFFSET FROM THE FOUND RIGHT OF WAY LINE MONUMENT AT PT. 1151. OFFSET MEASUREMENTS WERE THEN CHECKED TO PT'S. 3103, 3073 & 3101 AND FOUND TO VARY FROM 0.00' TO 0.53'. THE BASIS OF STATIONING IS BASED UPON P.O.T. 22729+97.00 SECTION LINE TIE AS SHOWN ON RAILROAD STRIP MAP 704-11-3 (V-12-11).

402  
1/4 Cor.  
SFNF  
Set 3" ADOT A.C. on 5/8" Rebar, 12" down  
PLS 19817 per Record information for  
"Common Area Tracts and Dedication for  
the Villages at Rancho EL Dorado" as  
Recorded in Docket 2003-035610, P.C.R.  
P.O.T. 36+53.36  
HONEYCUTT RD. &

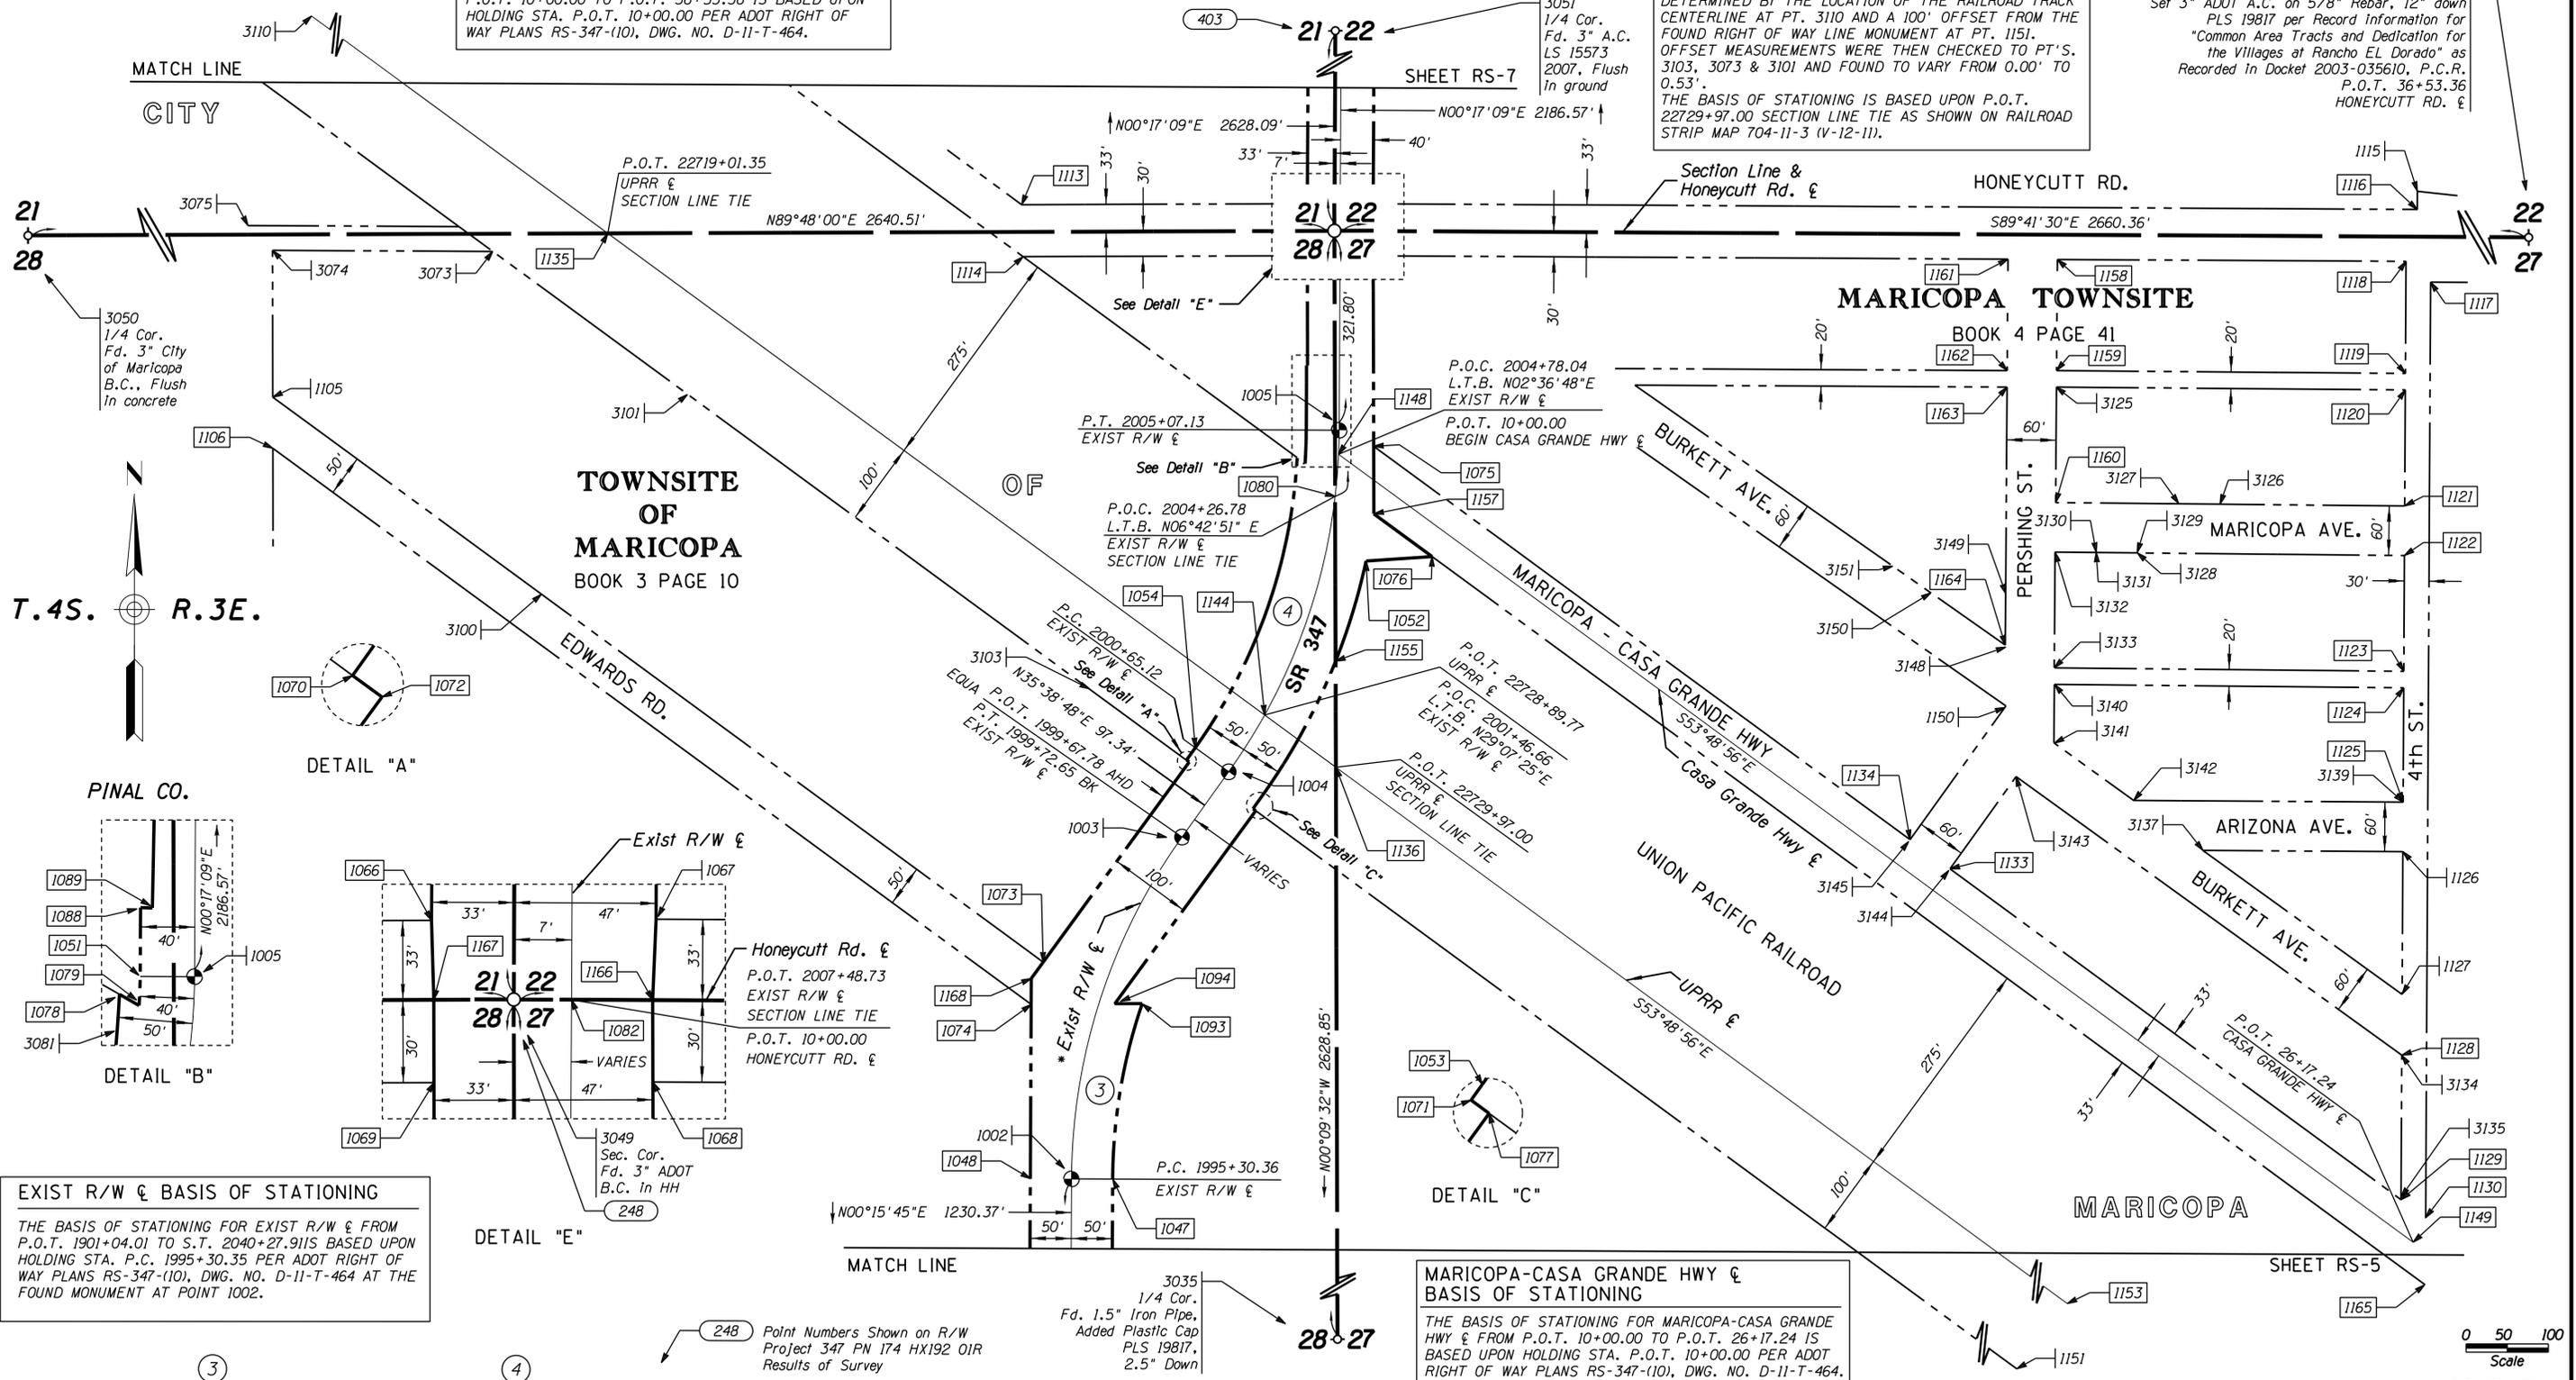

T. 4S. R. 3E.

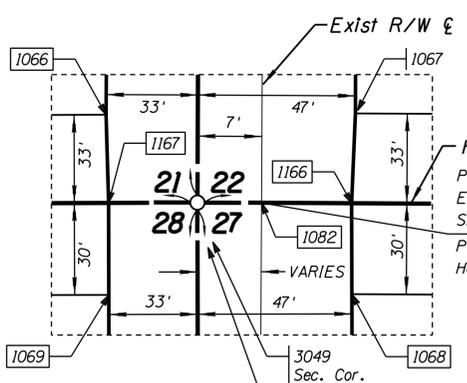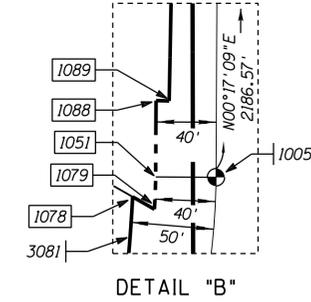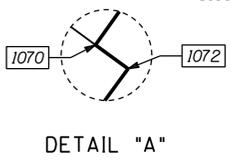

**EXIST R/W & BASIS OF STATIONING**  
THE BASIS OF STATIONING FOR EXIST R/W & FROM P.O.T. 1901+04.01 TO S.T. 2040+27.9115 BASED UPON HOLDING STA. P.C. 1995+30.35 PER ADOT RIGHT OF WAY PLANS RS-347-(10), DWG. NO. D-11-T-464 AT THE FOUND MONUMENT AT POINT 1002.

**MARICOPA-CASA GRANDE HWY & BASIS OF STATIONING**  
THE BASIS OF STATIONING FOR MARICOPA-CASA GRANDE HWY & FROM P.O.T. 10+00.00 TO P.O.T. 26+17.24 IS BASED UPON HOLDING STA. P.O.T. 10+00.00 PER ADOT RIGHT OF WAY PLANS RS-347-(10), DWG. NO. D-11-T-464.

**EXIST R/W & CURVE DATA**  
PI 1997+58.82 ← 1086  
Δ=35°23'02" RT  
D=08°00'00"  
T=228.46'  
L=442.30'  
R=716.20' ← 1012

**EXIST R/W & CURVE DATA**  
PI 2002+93.42 ← 1087  
Δ=35°21'39" LT  
D=08°00'00"  
T=228.30'  
L=442.01'  
R=716.20' ← 1013


### LEGEND

- ← 302 Set Monument
  - ← 300 Found Monument
  - Existing ADOT R/W monument
  - Calculated position
- SFNF Searched For Not Found  
\* EXIST R/W & IS LABELED ON RIGHT OF WAY PLANS RS-347-(10), DWG. NO. D-11-T-464 AS CONSTR. &

CHANGE ORDER REVISIONS				DRAWING NO.	D-11-T-497	ARIZONA DEPARTMENT OF TRANSPORTATION INFRASTRUCTURE DELIVERY AND OPERATIONS DIVISION RIGHT OF WAY PLANS SECTION	Professional Land Surveyor AZ No. 19817 Digitally signed by Jim Crume Date: 2016.02.18 15:00:17 -0700' (Expires 6-30-17) ELECTRONIC SEAL <a href="http://www.btr.state.az.us/">http://www.btr.state.az.us/</a> Certified Federal Surveyor No. 1293 (Expires 10-2-17) <a href="http://www.cfed.org/roster.asp">http://www.cfed.org/roster.asp</a>
C.O. NO.	DATE	BY	DESCRIPTION OF REVISIONS	SURVEY	JULY 2015		
				DRAWN/DATE	B.CRUME/JULY 2015	HIGHWAY NAME: <b>MARICOPA ROAD</b>	Date: 2016.02.18 15:00:17 -0700' (Expires 6-30-17) ELECTRONIC SEAL <a href="http://www.btr.state.az.us/">http://www.btr.state.az.us/</a> Certified Federal Surveyor No. 1293 (Expires 10-2-17) <a href="http://www.cfed.org/roster.asp">http://www.cfed.org/roster.asp</a>
				ADOT REVIEW	KEN RICHMOND	FEDERAL AID NO.: <b>347-A(204)A</b>	
				ROUTE NO.:	S.R. 347	PROJECT NO.:	<b>347 PN 172 H7007</b>
				LOCATION:	MARICOPA UNION PACIFIC RAILROAD CROSSING		SHEET RS-6


# RESULTS OF SURVEY

CITY

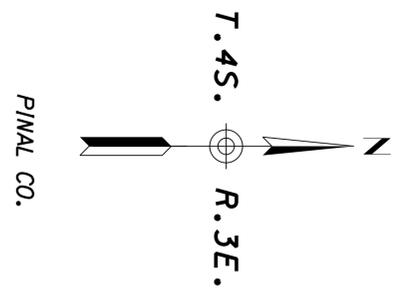


## MAP OF DEDICATION FOR SONORAN CREEK CABINET H SLIDE 98

**AMENDED MARICOPA MANOR**  
BOOK 8 PAGE 27

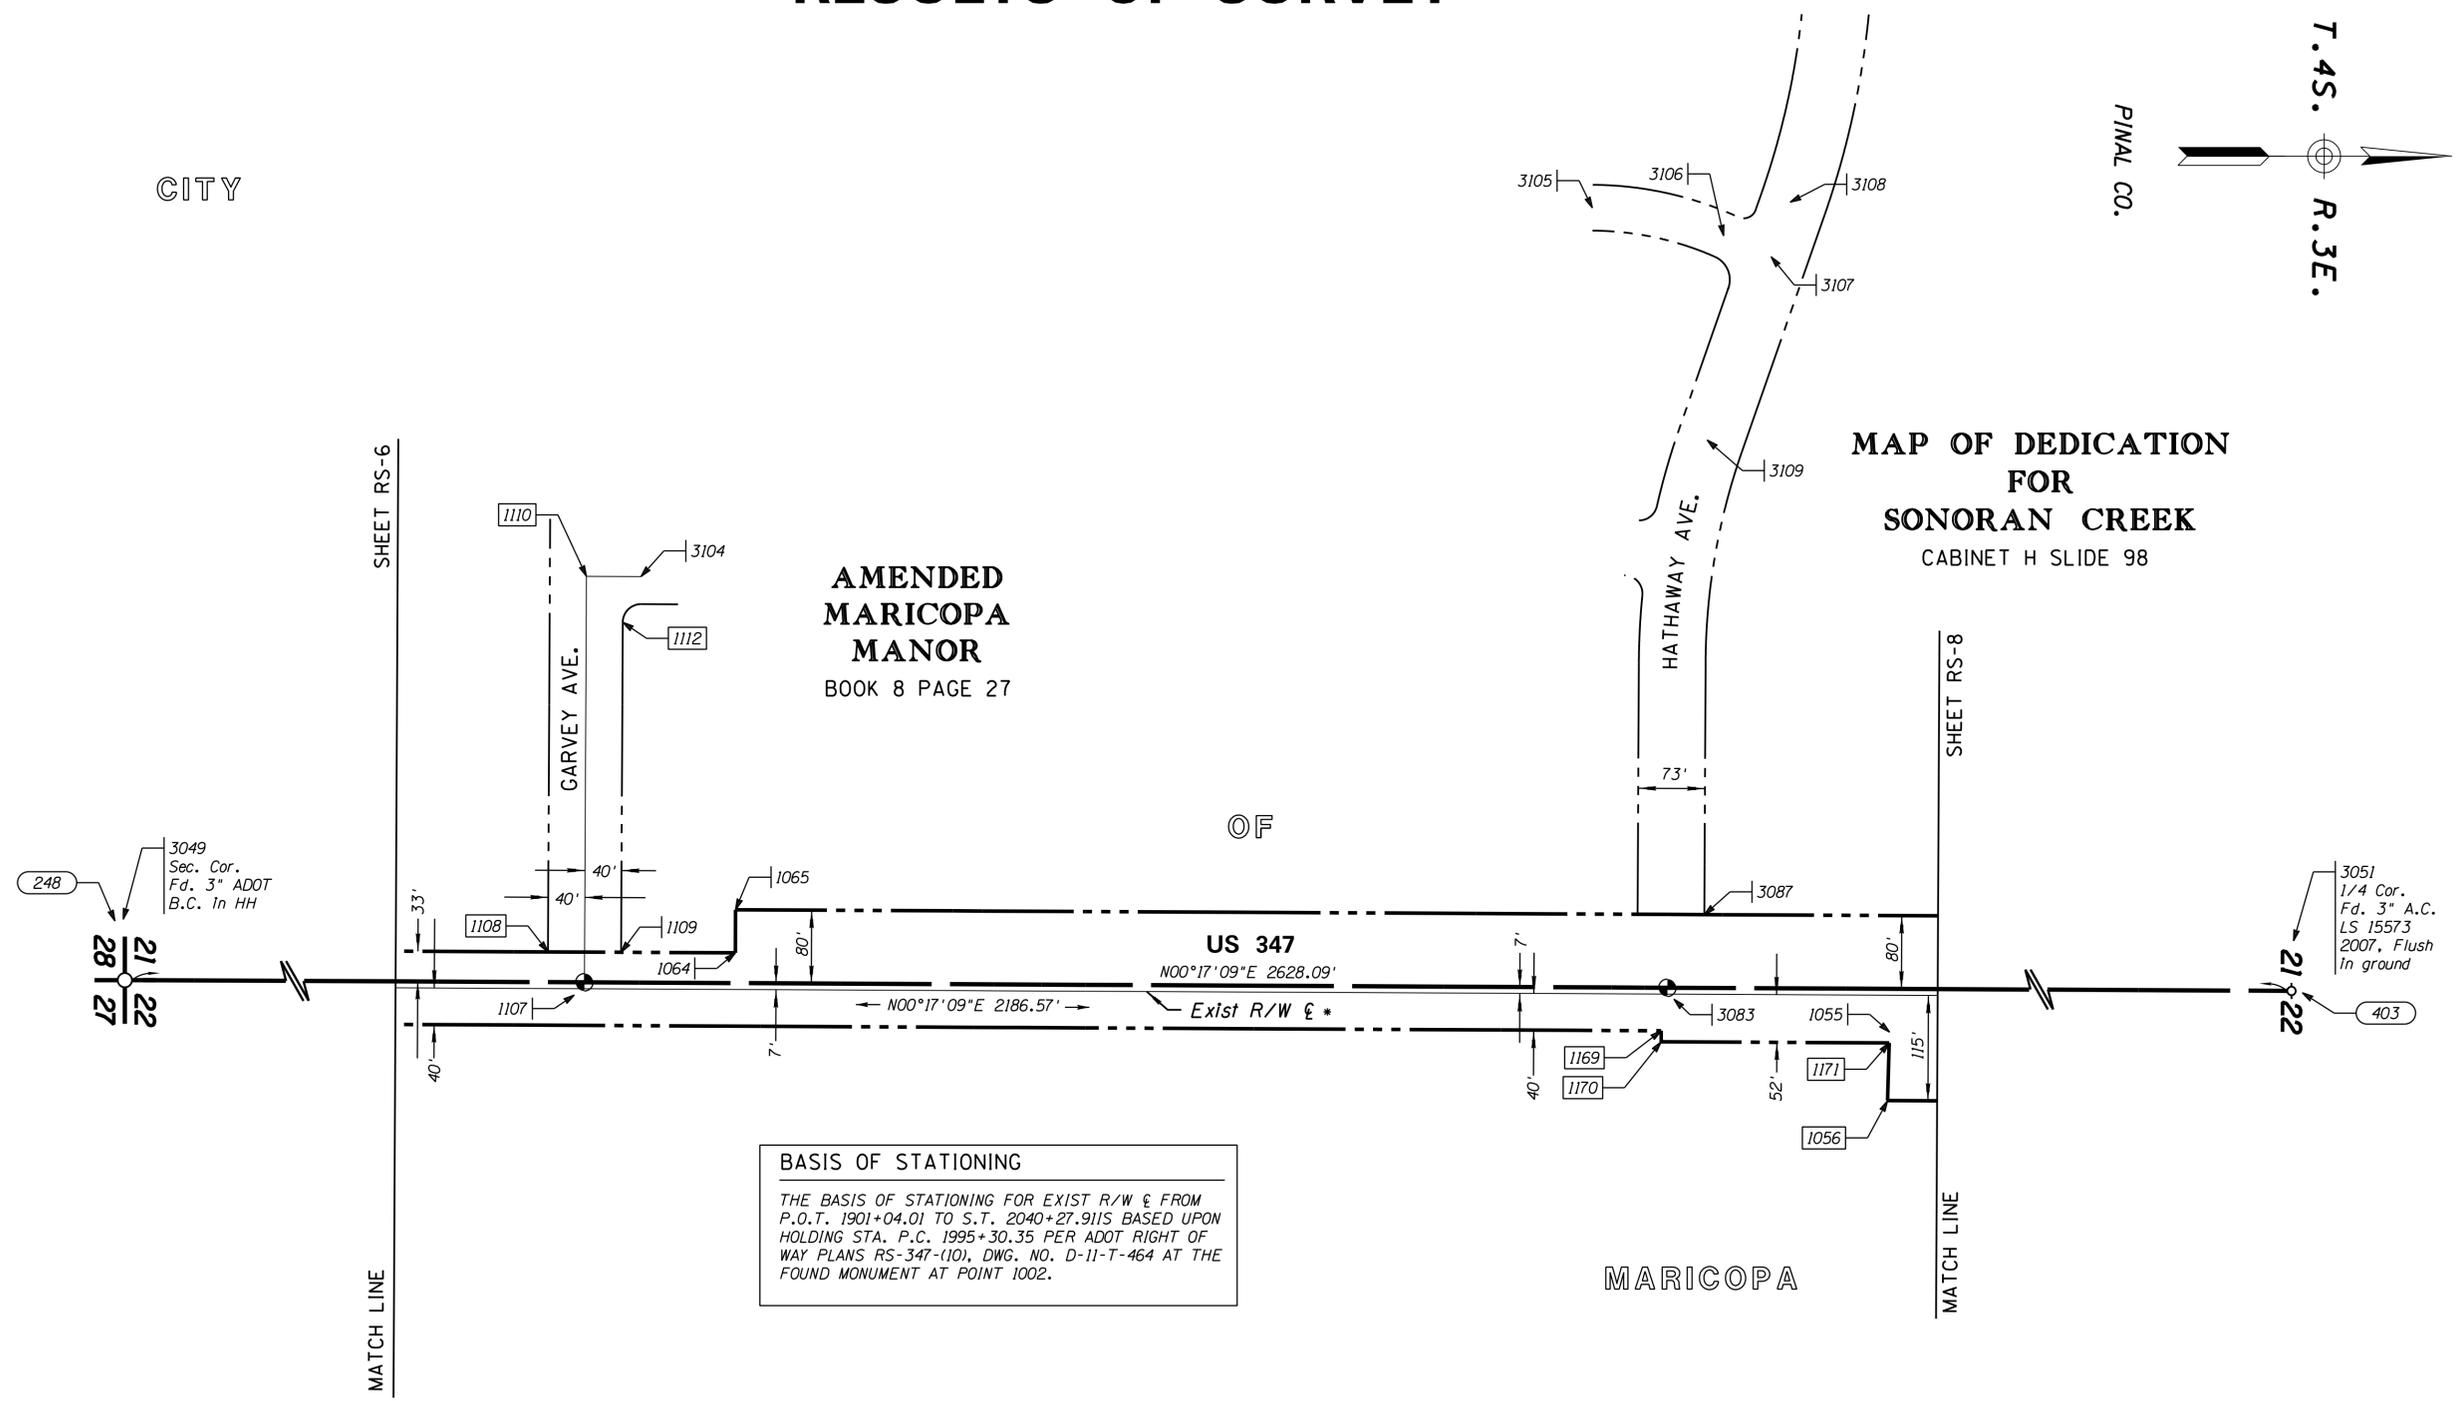

**BASIS OF STATIONING**  
THE BASIS OF STATIONING FOR EXIST R/W  $\xi$  FROM P.O.T. 1901+04.01 TO S.T. 2040+27.9115 BASED UPON HOLDING STA. P.C. 1995+30.35 PER ADOT RIGHT OF WAY PLANS RS-347-(10), DWG. NO. D-11-T-464 AT THE FOUND MONUMENT AT POINT 1002.

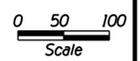

**LEGEND**

- 302 Set Monument
  - 300 Found Monument
  - 301 Calculated position
  - Existing ADOT R/W monument
- \* EXIST R/W  $\xi$  IS LABELED ON RIGHT OF WAY PLANS RS-347-(10), DWG. NO. D-11-T-464 AS CONSTR  $\xi$ .

Point Numbers Shown on R/W Project 347 PN 174 HX192 01R Results of Survey


CHANGE ORDER REVISIONS				DRAWING NO.	ARIZONA DEPARTMENT OF TRANSPORTATION INFRASTRUCTURE DELIVERY AND OPERATIONS DIVISION RIGHT OF WAY PLANS SECTION	
C.O. NO.	DATE	BY	DESCRIPTION OF REVISIONS	D-11-T-497	Professional Land Surveyor AZ No. 19817	
				SURVEY	JULY 2015	Digitally signed by Jim Crume
				DRAWN/DATE	B.CRUME/JULY 2015	Date: 2016.02.18
				ADOT REVIEW	KEN RICHMOND	15:01:06 -0700'
				<b>RITOCH-POWELL &amp; Associates</b> 602.263.1177 www.rtochpowell.com		(Expires 6-30-17) <b>ELECTRONIC SEAL</b> http://www.btr.state.az.us/
						Certified Federal Surveyor No. 1293 (Expires 10-2-17) http://www.cfdcs.org/roster.asp
				ROUTE NO.:	S.R. 347	HIGHWAY NAME: <b>MARICOPA ROAD</b> FEDERAL AID NO.: <b>347-A(204)A</b> PROJECT NO.: <b>347 PN 172 H7007</b>
				LOCATION:	MARICOPA UNION PACIFIC RAILROAD CROSSING	SHEET RS-7

# RESULTS OF SURVEY

CITY


**FINAL PLAT  
FOR  
SONORAN CREEK**  
DOCUMENT 2013-058465

**ACACIA CROSSINGS PARCEL 5**  
CABINET D SLIDE 109

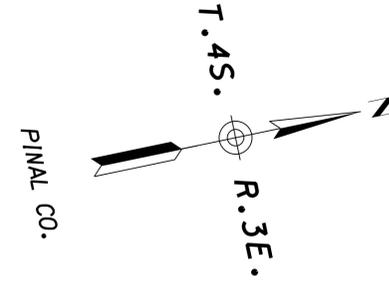


PINAL CO.

SHEET RS-7

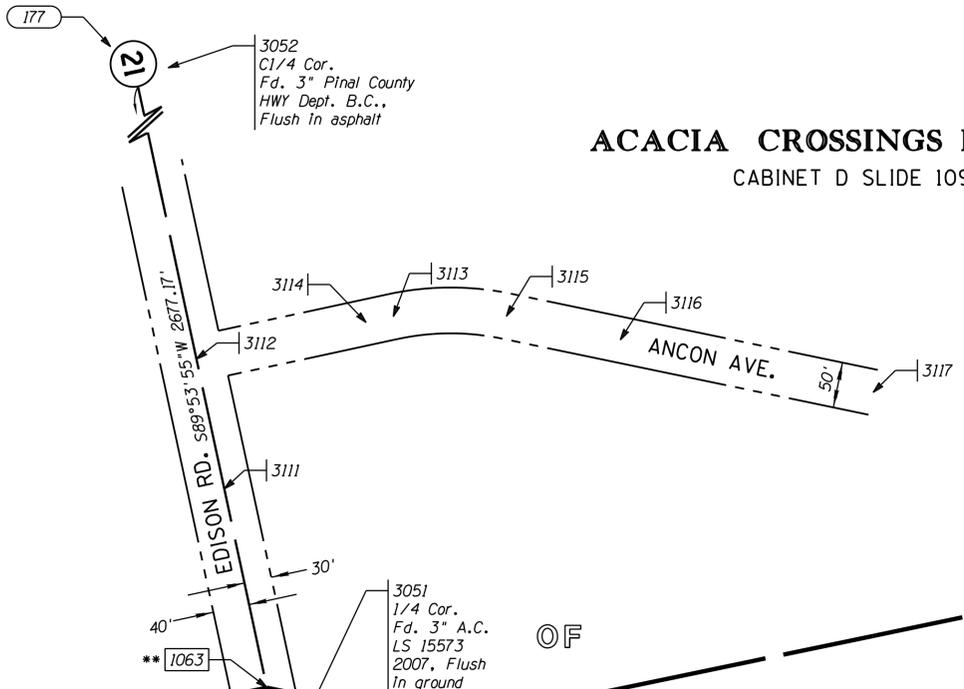

**FINAL PLAT  
FOR  
VILLAGES AT RANCHO EL DORADO**  
CABINET D SLIDE 144

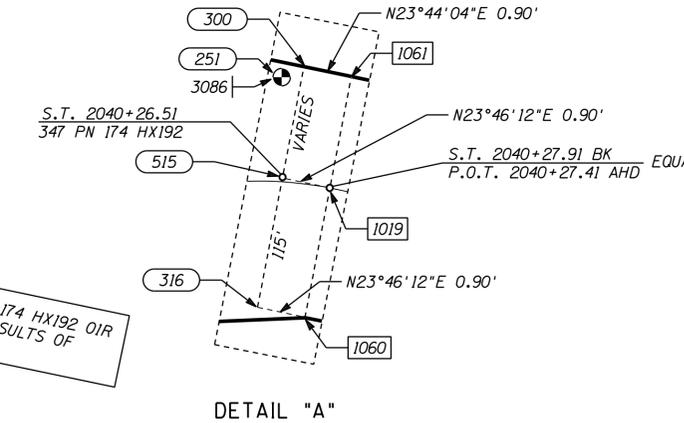

SEE ADJACENT R/W PROJECT 347 PN 174 HX192 OIR SURVEY (CASA BLANCA ROAD INTERSECTION) RESULTS OF

**BASIS OF STATIONING**

THE BASIS OF STATIONING FOR EXIST R/W & FROM P.O.T. 1901+04.01 TO S.T. 2040+27.91 IS BASED UPON HOLDING STA. P.C. 1995+30.35 PER ADOT RIGHT OF WAY PLANS RS-347-(10), DWG. NO. D-11-T-464 AT THE FOUND MONUMENT AT POINT 1002.

⑤  
EXIST R/W & CURVE DATA  
PI 2033+69.24 ← 1014  
TOTAL CURVE  
Δ=23°29'03" RT  
T=675.54'  
L=1334.21'

SPIRAL  
a=1.25  
Δ=01°36'00"  
L=160.00'  
SPI = ← 1020

MAIN CURVE  
Δ=20°17'03" RT  
D=02°00'00"  
L=1014.21'  
R=2864.79' ← 1017

SPIRAL  
a=1.25  
Δ=01°36'00"  
L=160.00'  
SPI = ← 1021

**LEGEND**

302 Set Monument

300 Found Monument

301 Calculated position


Existing ADOT R/W monument

\* EXIST R/W & IS LABELED ON RIGHT OF WAY PLANS RS-347-(10), DWG. NO. D-11-T-464 AS CONSTR &.

\*\* CONTROL POINT IS ON MID SECTION LINE.

248 Point Numbers Shown on R/W Project 347 PN 174 HX192 OIR Results of Survey

MARICOPA

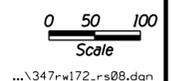

CHANGE ORDER REVISIONS				DRAWING NO.	ARIZONA DEPARTMENT OF TRANSPORTATION INFRASTRUCTURE DELIVERY AND OPERATIONS DIVISION RIGHT OF WAY PLANS SECTION	
C.O. NO.	DATE	BY	DESCRIPTION OF REVISIONS	D-11-T-497	Professional Land Surveyor AZ No. 19817	
				SURVEY	JULY 2015	Digitally signed by Jim Crume
				DRAWN/DATE	B.CRUME/JULY 2015	Date: 2016.02.18
				ADOT REVIEW	KEN RICHMOND	15:01:51 -07'00'
				HIGHWAY NAME: MARICOPA ROAD		(Expires 6-30-17)
				FEDERAL AID NO.: 347-A(204)A		ELECTRONIC SEAL
				PROJECT NO.: 347 PN 172 H7007		Certified Federal Surveyor No. 1293
				ROUTE NO.: S.R. 347		(Expires 10-2-17)
				LOCATION: MARICOPA UNION PACIFIC RAILROAD CROSSING		http://www.sfdcs.org/roster.asp
						SHEET RS-8

# RESULTS OF SURVEY

## GENERAL NOTES

THREE P&M JOB NO. 3830 CONTROL STATIONS WERE USED TO ESTABLISH THE CONTROL BASELINE FOR THIS SURVEY AND THEY ARE AS FOLLOWS:

Z 284 NAD 83(2007) 33°03'39.14755"(N) 112°03'19.10463"(W)  
Grid Coordinates N 749706.94989 E 657525.66990  
Ground Coordinates (Pt. 104) N 749826.90300 E 657630.87400

KIM-LEL NAD 83(2007) 33°03'09.78314"(N) 112°01'54.14040"(W)  
Grid Coordinates N 746730.56011 E 664752.96953  
Ground Coordinates (Pt. 111) N 746850.03699 E 664859.33000

HC 171.5 NAD 83(2007) 33°01'43.63030"(N) 112°02'51.33429"(W)  
Grid Coordinates N 738029.41030 E 659874.41010  
Ground Coordinates (Pt. 112) N 738147.49500 E 659979.99000

THE FOLLOWING PARAMETERS WERE SET FOR THE BASIS OF THIS SURVEY:

SYSTEM: UNITED STATES STATE PLANE 1983  
ZONE: ARIZONA CENTRAL 0202  
DATUM: NORTH AMERICAN 1983 (CONUS) EQUIVALENT TO WGS-84  
GEOID MODEL: GEOID03 (CONTINENTAL US)

UNITS = INTERNATIONAL FEET (1 FOOT = 0.3048 METERS EXACTLY)

DIRECT SATELLITE MEASUREMENTS WERE MADE ON EACH POINT ON THE NORTH AMERICAN DATUM OF 1983 WITH AUTOMATIC TRANSLATIONS MADE TO THE STATE PLANE GRID SYSTEM.

A GRID ADJUSTMENT FACTOR OF 1.00016 AND SCALE ORIGIN VALUES OF N=0.00, E=0.00, AS OBTAINED FROM ADOT (P&M JOB NO. 3830) WERE USED FOR THE TRANSLATION TO THE SURFACE. GRID COORDINATE "X" GAF = SURFACE/ GROUND COORDINATE.

ALL BEARINGS ARE GRID BEARINGS, DISTANCES ARE GROUND DISTANCES AND COORDINATES ARE GROUND COORDINATES.

THE EXISTING ADOT R/W SHOWN ON THIS RESULTS OF SURVEY WAS BASED ON AN OBSERVATION AND EVALUATION OF PHYSICAL CORROBORATING EVIDENCE IN THE FIELD AND A REVIEW AND ANALYSIS OF EXISTING R/W PLANS, MAPS AND R/W TITLE DOCUMENTS AVAILABLE AT THE TIME THE SURVEY WAS PREPARED; AND MAY NOT REFLECT PRIOR OR PENDING ADOT DISPOSALS OR ACQUISITIONS THAT WERE NOT SHOWN ON SAID PLANS AND DOCUMENTS AT THE TIME THE SURVEY WAS PREPARED.

THIS RESULTS OF SURVEY IS ON FILE IN THE FILE ROOM OF THE RIGHT OF WAY PLANS SECTION OF THE ARIZONA DEPARTMENT OF TRANSPORTATION, 205 SOUTH 17TH AVE, MD 612E, PHOENIX, AZ 85007. (602) 712-7270 SEE ADOT R/W FILE COPY FOR MOST CURRENT ADDITIONS OR REVISIONS.

FOR ADDITIONAL INFORMATION ON SECTION CORNER DESCRIPTIONS, SEE CORNER RECOVERY SHEETS IN THE ADOT R/W PLANS SECTION RECORDS.

EXIST R/W LINE					
THE FOLLOWING LIST OF POINTS REPRESENTS THE EXISTING RIGHT OF WAY LINE AS DETERMINED BY AN ANALYSIS OF MONUMENTATION FOUND DURING THE COURSE OF THIS SURVEY AND THE EXISTING DOCUMENTATION LISTED HEREIN.					
LEFT SIDE			RIGHT SIDE		
PT.	STATION	OFFSET	PT.	STATION	OFFSET
*1025	1927+35.71	50.00 LT	1026	1927+33.19	105.00 RT
*1027	1940+50.00	50.00 LT	1022	1942+00.00	105.00 RT
1024	1940+50.00	85.00 LT	1023	1942+00.00	115.00 RT
1029	1953+67.41	85.00 LT	1028	1953+65.08	115.00 RT
1032	1969+03.73	85.00 LT	1030	1953+65.41	90.00 RT
1035	1969+03.73	75.00 LT	1031	1969+03.73	90.00 RT
1009	Radius Pt.	---	1009	Radius Pt.	---
1036	1975+15.15	75.00 LT	1034	1971+50.00	90.00 RT
1039	1975+15.15	50.00 LT	1033	1971+50.00	75.00 RT
1040	1976+65.00	50.00 LT	1009	Radius Pt.	---
1011	Radius Pt.	---	1154	1973+43.65	75.00 RT
1043	1980+56.10	50.00 LT	1009	Radius Pt.	---
1011	Radius Pt.	---	1037	1975+15.15	75.00 RT
1046	1982+99.99	50.00 LT	1038	1975+15.15	50.00 RT
1048	1995+30.36	50.00 LT	1041	1976+65.00	50.00 RT
1074	1997+22.94	78.56 LT	1011	Radius Pt.	---
1168	1997+49.95	87.48 LT	1044	1980+39.11	50.00 RT
1073	1997+70.91	80.09 LT	1011	Radius Pt.	---
EQUA	1999+72.65BK	---	1045	1982+99.99	50.00 RT
1072	2000+46.86	45.88 LT	1047	1995+30.36	50.00 RT
1070	2000+46.90	50.00 LT	1012	Radius Pt.	---
1054	2000+65.12	50.00 LT	1093	1997+63.13	50.00 RT
1013	Radius Pt.	---	1094	1997+52.34	18.65 RT
1078	2004+71.15	50.00 LT	EQUA	1999+72.65BK	---
1079	2004+64.29	40.00 LT	1077	1999+67.78AHD	---
1013	Radius Pt.	---	1071	2000+45.93	54.11 RT
1051	2005+07.13	40.00 LT	1071	2000+45.96	50.00 RT
1088	2005+85.36	40.00 LT	1053	2000+65.12	50.00 RT
*1089	2005+85.36	33.00 LT	1013	Radius Pt.	---
*1069	2007+18.45	33.00 LT	1155	2002+39.30	50.00 RT
*1167	2007+48.45	33.00 LT	1013	Radius Pt.	---
1066	2007+81.45	40.00 LT	1052	2003+58.14	50.00 RT
1064	2012+93.75	40.00 LT	1076	2003+76.97	127.51 RT
1065	2012+93.75	87.00 LT	1157	2004+12.24	49.37 RT
1063	2033+50.53	113.55 LT	1075	2004+89.00	42.27 RT
1062	2035+41.03	148.24 LT	1068	2007+18.71	40.23 RT
1061	2040+27.91	83.50 LT	1166	2007+48.71	40.00 RT
			1067	2007+81.71	40.00 RT
			1169	2023+07.09	40.00 RT
			1170	2023+07.09	52.00 RT
			1171	2025+56.68	52.00 RT
			1056	2025+55.14	115.00 RT
			1057	2026+93.70	115.00 RT
			1058	2028+53.70	115.00 RT
			1017	Radius Pt.	---
			1059	2038+67.91	115.00 RT
			1060	2040+27.91	115.00 RT

ALL STATIONS AND OFFSETS ARE FROM EXISTING R/W CENTERLINE UNLESS OTHERWISE NOTED.

\* STATION IS FROM EXISTING R/W CENTERLINE; OFFSET IS FROM SECTION LINE.

PUBLIC INFORMATION USED IN PREPARATION OF SURVEY					
PINAL COUNTY RECORDER'S OFFICE					
SEC.	TWP.	RNG.	BOOK	PAGE/DOCKET	DESCRIPTION
21	4S	3E	8	27	AMENDED MARICOPA MANOR
21	4S	3E	---	2013-058465	SONORAN CREEK
21	4S	3E	D	109	ACACIA CROSSINGS PARCEL 5
22	4S	3E	D	144	VILLAGES AT RANCHO EL DORANDO
22	4S	3E	7	22	RESULTS OF SURVEY
27	4S	3E	E	137	SENITA UNIT 1
27	4S	3E	4	41	MARICOPA TOWNSITE
27	4S	3E	E	86	DESERT CEDARS
28	4S	3E	3	10	TOWNSITE OF MARICOPA
28	4S	3E	9	7	AMENDED PLAT OF ESTRELLA PARK
28	4S	3E	E	88	ALTERRA NORTH
33	4S	3E	E	89	ALTERRA SOUTH
34	4S	3E	---	2014-053174	MARICOPA AQUATIC CENTER & REGIONAL PARK
34	4S	3E	E	196	PALO BREA
28	4S	3E	---	2014-061683	RESULTS OF SURVEY
26-27	4S	3E	7	35	RESULTS OF SURVEY
28	4S	3E	---	2014-057814	RESULTS OF SURVEY
21	4S	3E	---	2010-045658	RESULTS OF SURVEY
27	4S	3E	---	UNRECORDED	PREMIER ENGINEERING RECORD OF SURVEY JOB NO. 2015003
27-28	4S	3E	---	---	UPRR STRIP MAP 704-11-3 (V-12-11)
ADOT RIGHT OF WAY PLANS AND RECORD DRAWINGS					
PROJECT NO.	DWG NO.	ADOT TRACS NO.	DESCRIPTION	DATE	
RS-347-(10)	D-11-T-464	347 PN 000 H2778 02R	JCT SR 84-MARICOPA	1992	
---	D-11-T-479	347 PN 174 HX192 01R	CASA BLANCA ROAD INT.	2006	
S-347-A-502	---	347 PN 174 HX176 01C	RECORD DRAWING	2008	
STP-347-A(206)A	---	347 PN 168 H8108 01C	RECORD DRAWING	2012	
GLO & BLM PLATS					
PLAT NO.	DESCRIPTION	DATE			
1519	T. 4S. R. 3E. DEPENDENT RESURVEY	1940			

DUAL GROUND COORDINATES FOR ADJACENT PROJECT					
347 PN 172 H7007 GAF 1.00016 (2007 EPOCH)			347 PN 174 HX192 01R GAF 1.00016 (1992 EPOCH)		
PT.	NORTHING	EASTING	PT.	NORTHING	EASTING
3049	748765.99251	659857.89512	248	748765.89779	659858.01681
3051	751394.05357	659871.00417	403	751393.95885	659871.12586
3052	751389.31087	657193.83913	177	751389.21615	657193.96082
3053	754036.22453	659884.47745	213	754036.12981	659884.59914
3054	754040.48896	662520.02400	402	754040.39424	662520.14569
3086	752037.09366	660073.72853	251	752037.03537	660073.80961
			515	752003.74886	660150.01095
			316	751957.39625	660255.25560
			300	752037.40561	660073.59251

SECTIONAL CORNERS			SECTIONAL CORNERS		
PT.	NORTHING	EASTING	PT.	NORTHING	EASTING
400	743499.18274	657232.21308	3035	746137.15483	659865.18209
401	746128.19104	657224.80700	3045	746046.24616	662519.96440
402	748751.67039	662518.21408	3046	746119.23051	654585.38809
403	746126.80000	662519.91229	3049	748765.99251	659857.89512
3002	738245.35130	659881.63614	3050	748756.77744	657217.40211
3003	740870.06408	662513.88743	3051	751394.05357	659871.00417
3004	740869.03999	657239.77602	3052	751389.31087	657193.83913
3007	740876.18061	659877.25231	3053	754036.22453	659884.47745
3013	743503.77055	662521.60930	3054	754040.48896	662520.02400
3021	743507.86114	659872.06881	3057	743490.42921	654592.62122

EXISTING ADOT R/W MONUMENTATION					
PT.	NORTHING	EASTING	DESCRIPTION	STATION	OFFSET
1000	745771.96016	659668.58766	Fd. 3" ADOT BC in HH	1976+65.00	0.00 RT
1001	746386.97853	659532.95118	Fd. 3" ADOT BC in HH	1982+99.99	0.00 RT
1002	747617.33562	659538.58785	Fd. 3" ADOT BC in HH	1995+30.35	0.00 RT
1003	748031.44221	659672.77523	Fd. 3" ADOT BC in HH	1999+72.66	0.00 RT
1004	748110.54103	659729.50191	Fd. 3" ADOT BC in HH	2000+65.12	0.00 RT
1005	748524.35913	659863.68992	Fd. 3" ADOT BC in HH	2005+07.13	0.00 LT
1036	745604.44297	659664.34352	Fd. ADOT A1	1975+15.15	75.00 LT
1107	749146.01088	659859.79070	Fd. 3" ADOT BC in HH	2011+28.75	7.00 LT
3040	745330.91736	659758.74730	Fd. 3" ADOT AC in Concrete	1972+09.24	74.88 LT
3049	748765.99251	659857.89512	Fd. 3" ADOT BC in HH	2007+48.73	7.00 LT
3083	750330.88406	659865.78123	Fd. 3" ADOT BC in HH	2023+13.64	6.92 LT
3085	750869.98308	659876.75772	Fd. 3" ADOT BC in HH	2028+52.79	0.10 LT
3086	752037.09366	660073.72853	Fd. 3" ADOT AC	2040+27.91	83.10 LT

ALL STATIONS AND OFFSETS ARE FROM EXISTING R/W CENTERLINE UNLESS OTHERWISE NOTED.

CHANGE ORDER REVISIONS				DRAWING NO.	D-11-T-497	ARIZONA DEPARTMENT OF TRANSPORTATION	Professional Land
C.O. NO.	DATE	BY	DESCRIPTION OF REVISIONS	SURVEY	JULY 2015	INFRASTRUCTURE DELIVERY AND OPERATIONS DIVISION	Surveyor AZ No. 19817
				DRAWN/DATE	B.CRUME/JULY 2015	RIGHT OF WAY PLANS SECTION	Digitally signed by Jim
				ADOT REVIEW	KEN RICHMOND	HIGHWAY NAME:	Crume
						MARICOPA ROAD	Date: 2016.02.18
						FEDERAL AID NO.:	15:02:56-07'00"
						347-A(204)A	(Expires 6-30-17)
						PROJECT NO.:	ELECTRONIC SEAL
						347 PN 172 H7007	http://www.blr.state.az.us/
							Certified Federal
							Surveyor No. 1293
							(Expires 10-2-17)
							http://www.sfdcs.org/roster.asp
				ROUTE NO.:	S.R. 347	LOCATION:	SHEET RS-9
						MARICOPA UNION PACIFIC RAILROAD CROSSING	

# RESULTS OF SURVEY

MISCELLANEOUS MONUMENTATION			
PT.	NORTHING	EASTING	DESCRIPTION
1096	746924.67608	659465.41382	FD 1/2" REBAR PLASTIC CAP STAMPED LS 17258
1097	746923.50175	659265.96403	FD 1/2" REBAR NO TAG
1098	746923.32512	659235.96455	FD 60D NAIL NO TAG
1099	746921.67840	658955.26890	FD 60D NAIL NO TAG
1100	746921.42913	658940.49243	FD 60D NAIL NO TAG
1101	746919.23155	658540.70694	FD 1/2" REBAR NO TAG
1102	746979.22825	658539.96910	FD MON 1" SO IRON BAR
1105	748564.45485	658568.40440	FD 1/2" REBAR PLASTIC CAP STAMPED RLS 21782
1115	748813.91162	661173.31021	FD 1/2" REBAR NO TAG
1126	748013.78827	661155.76226	FD 2" AC STAMPED HANSEN RLS 37512 FLUSH
1127	747840.85970	661154.84733	FD 2" AC STAMPED HANSEN RLS 37512 FLUSH
1150	748188.41586	660672.34481	FD RM 2" AC STAMPED 8FT OS HANSEN RLS 37512
1151	744231.28796	665001.20317	FD RM 2" AC STAMPED 8FT OS HANSEN RLS 37512
3008	742176.13929	659824.56955	FD PK NAIL NO TAG
3009	742122.33171	659688.40884	FD CITY OF MARICOPA BC FLUSH
3014	743507.44119	660170.42230	FD 1/2" REBAR PLASTIC CAP STAMPED RLS 27239
3015	743502.08335	660182.70178	FD 1/2" REBAR PLASTIC CAP STAMPED RLS 27239
3017	743602.20099	660228.34532	FD 5/8" REBAR NO TAG DOWN 0.70
3018	743595.98079	659771.22838	FD CITY OF MARICOPA BC FLUSH
3019	743602.17415	659646.38626	FD CITY OF MARICOPA BC FLUSH
3020	743608.39653	659530.68762	FD CITY OF MARICOPA BC FLUSH
3022	743597.30754	659884.85018	FD PK NAIL NO TAG
3025	744985.65850	660090.99743	FD CITY OF MARICOPA BC FLUSH
3026	745022.85780	659979.06328	FD 1/2" REBAR PLASTIC CAP STAMPED RLS 18214
3029	745303.84521	659917.40425	FD 1/2" REBAR PLASTIC CAP STAMPED RLS 18214
3031	745304.78633	659917.47215	FD 1/2" REBAR PLASTIC CAP STAMPED LS 38001
3034	746073.05833	659915.30404	FD 1/2" REBAR PLASTIC CAP STAMPED RLS 18214
3042	745119.73988	659461.74714	FD CITY OF MARICOPA BC FLUSH
3043	744990.60925	659783.34171	FD PK NAIL NO TAG
3044	744991.67273	659868.13839	FD PK NAIL NO TAG
3061	748910.81108	662451.24339	FD CITY OF MARICOPA BC FLUSH
3062	749186.81712	662472.53607	FD CITY OF MARICOPA BC FLUSH
3063	749222.26967	662478.18354	FD CITY OF MARICOPA BC FLUSH
3064	748752.03588	662450.32507	FD CITY OF MARICOPA BC IN HH
3073	748741.00667	658835.50767	FD 1/2" REBAR PLASTIC CAP STAMPED RLS 21782
3074	748742.33889	658568.09831	FD 1/2" REBAR PLASTIC CAP STAMPED RLS 21782
3075	748772.36688	658538.19922	FD 1/2" REBAR BENT NO TAG SHOT POE
3076	747386.89380	659591.86994	FD 1/2" REBAR PLASTIC CAP STAMPED RLS 13179
3084	750709.97313	659874.64961	FD BC IN HH STAMPED 2010 PLS 19817
3095	746952.49823	659095.43592	FD CITY OF MARICOPA BC FLUSH

MISCELLANEOUS MONUMENTATION			
PT.	NORTHING	EASTING	DESCRIPTION
3100	748325.70981	658894.79398	FD 1/2" REBAR PLASTIC CAP STAMPED RLS 21782
3101	748567.64488	659072.04896	FD 1/2" REBAR PLASTIC CAP STAMPED 5713
3103	748211.00094	659560.50636	FD 1/2" REBAR NO TAG BENT SHOT POE
3104	749207.80463	659417.00922	FD PK NAIL W/ TAG ILLEGIBLE
3105	750248.84436	659014.50965	FD PK NAIL W/ SHINER
3106	750392.47219	659045.07440	FD PK NAIL W/ SHINER
3107	750444.34762	659067.87415	FD 60D NAIL W/ PNK FLAGGING
3108	750465.18525	659008.37547	FD 1/2" REBAR CAP DAMAGED
3109	750374.42611	659267.94932	FD PK NAIL W/ SHINER
3110	749769.64712	657599.06419	FD RR CL TRACK NORTH
3111	751393.58738	659569.53057	FD 1/2" IRON ROD NO TAG
3112	751393.25498	659424.51936	FD 3" PINAL COUNTY HWY DEPT BC FLUSH
3113	751613.50037	659424.12699	FD 3" PINAL COUNTY HWY DEPT BC FLUSH
3114	751583.20844	659424.19106	FD 3" PINAL COUNTY HWY DEPT BC FLUSH
3115	751734.72615	659449.45125	FD 3" PINAL COUNTY HWY DEPT BC FLUSH
3116	751851.19787	659500.66445	FD 3" PINAL COUNTY HWY DEPT BC FLUSH
3117	752109.79782	659614.33233	FD 3" PINAL COUNTY HWY DEPT BC FLUSH
3125	748576.63163	660734.67875	FD 3/4" IRON BAR NO TAG
3126	748434.73499	660933.65858	FD 1/2" REBAR PLASTIC CAP STAMPED LS 37936
3127	748435.44899	660883.63657	FD 1/2" REBAR NO TAG BENT SHOT POE
3128	748375.90492	660833.11746	FD 1/2" REBAR PLASTIC TAG STAMPED LS 17278
3129	748376.15808	660833.07728	FD 1" IRON PIPE NO TAG
3130	748376.32887	660783.30241	FD 1/2" REBAR NO TAG
3131	748376.63733	660783.34879	FD 1" IRON PIPE NO TAG
3132	748376.69944	660733.25154	FD 1/2" REBAR NO TAG
3133	748236.57114	660732.29569	FD 1/2" REBAR NO TAG BENT SHOT POE
3134	747767.34539	661154.23928	FD 2" AC STAMPED RLS 37512 HANSEN
3135	747595.34306	661153.54834	FD 2" AC STAMPED RLS 37512 HANSEN
3137	748015.16930	660913.01340	FD 5/8" REBAR NO TAG BENT SHOT POE
3139	748073.78555	661156.38163	FD 2" AC STAMPED RLS 37512 HANSEN
3140	748216.33621	660732.76378	FD 2" AC STAMPED RLS 37512 HANSEN
3141	748145.22919	660732.47504	FD 2" AC STAMPED RLS 37512 HANSEN
3142	748075.85908	660828.81835	FD 2" AC STAMPED RLS 37512 HANSEN
3143	748104.74158	660685.97478	FD 2" AC STAMPED RLS 37512 HANSEN
3144	747991.08648	660604.28743	FD 2" AC STAMPED RLS 37512 HANSEN
3145	748026.17189	660555.49910	FD 2" AC STAMPED RLS 37512 HANSEN
3148	748261.61107	660673.48932	FD 1/2" REBAR NO TAG
3149	748325.99525	660673.55020	FD 60D NAIL IN 1" IRON PIPE NO TAG
3150	748327.27165	660582.48153	FD 1/2" REBAR NO TAG
3151	748359.71158	660536.13403	FD 1/2" REBAR PLASTIC TAG STAMPED LS 17278

CALCULATED POINTS		
PT.	NORTHING	EASTING
1007	740876.08781	659917.25174
1008	745044.84555	659867.79153
1009	745027.85216	658435.50234
1010	745636.30140	659732.24080
1011	746380.40940	660965.32612
1012	747614.05450	660254.78034
1013	748527.93156	659147.49883
1014	751386.43621	659877.96626
1015	750710.90437	659874.59664
1016	750870.88245	659876.88392
1017	750776.60971	662740.12134
1018	751857.65478	660087.13106
1019	752004.67095	660150.25366
1020	750817.57371	659875.12872
1021	751907.04908	660107.25833
1024	742190.30684	659816.65321
1025	740876.04524	659827.25248
1027	742190.40188	659824.66365
1029	743507.62758	659801.02387
1030	743507.70062	659976.03532
1031	745045.91328	659957.78520
1032	745043.83714	659782.79752
1035	745043.95577	659792.79681
1037	745668.15983	659800.13808
1038	745657.54035	659777.50565
1039	745615.06245	659686.97595
1040	745750.72121	659623.32281
1041	745793.19912	659713.85251
1043	746135.92606	659503.23583
1044	746136.27040	659604.66516
1046	746387.20783	659482.95171
1047	747617.10655	659588.58733
1048	747617.56468	659488.58838
1051	748524.55865	659823.69042
1052	748365.94674	659896.38023
1053	748081.40179	659770.13323
1054	748139.68028	659688.87058
1056	750571.77431	659988.90407
1057	750710.33074	659989.59521
1058	750867.09810	659991.82164
1059	751814.25885	660193.62891
1060	751958.31835	660255.49831
1061	752038.32794	660073.83471
1062	751579.16823	659871.94813
1063	751393.91185	659791.00247
1066	748798.87812	659825.05875
1068	748735.73860	659904.97917
1069	748735.87745	659824.97847
1070	748124.87852	659678.25533
1071	748065.83726	659758.97094
1072	748122.44811	659681.57796
1073	747879.94871	659504.19629
1074	747828.70929	659489.55570
1075	748504.95506	659905.61888
1076	748371.30670	659976.53910
1077	748063.40945	659762.29002
1078	748491.16267	659812.68338
1079	748484.14333	659822.27956

CALCULATED POINTS		
PT.	NORTHING	EASTING
1080	748444.19742	659858.78712
1081	745017.63555	659868.11437
1082	748765.95483	659864.89502
1083	743507.83959	659886.02733
1084	745355.26227	659864.10860
1085	746064.18619	659531.47080
1086	747845.79085	659539.63448
1087	748296.06290	659862.55115
1088	748602.79241	659824.08065
1089	748602.78609	659825.34739
1093	747829.67880	659826.59158
1094	747829.85296	659591.44985
1095	746984.79650	659485.68946
1103	746955.08958	659535.55389
1104	746949.22990	658540.33805
1106	748502.46149	658568.46557
1108	749106.17598	659826.59158
1110	749148.22100	659416.71201
1112	749187.97110	659466.91091
1113	748797.66813	659478.34844
1114	748734.67274	659479.77950
1116	748791.91191	661173.19955
1117	748703.82334	661189.41363
1118	748728.98450	661159.54623
1119	748593.22074	661158.82793
1120	748573.22095	661158.72212
1121	748432.53292	661157.97776
1122	748372.53314	661157.66031
1123	748232.28806	661156.91830
1124	748212.28814	661156.81249
1125	748073.78746	661156.07971
1128	747767.18812	661154.45755
1129	747592.14123	661153.53140
1130	747570.28134	661183.41617
1133	747992.92932	660605.61193
1134	748028.35375	660557.18301
1135	748762.91260	658975.37617
1136	748116.05635	659859.69670
1143	746136.09814	659553.92500
1144	748179.36168	659773.15166
1148	748495.27716	659862.95402
1149	747540.48283	661168.25830
1153	744312.00002	665060.24183
1154	745500.57842	659866.84943
1155	748244.48216	659859.34072
1156	738245.41795	659921.63609
1157	748423.01676	659905.84601
1158	748731.26436	660736.06397
1159	748596.62697	660735.12046
1160	748436.69498	660733.99970
1161	748731.58737	660676.06476
1162	748596.59051	660675.11874
1163	748576.59097	660674.97858
1164	748264.06326	660672.78847
1165	747488.82442	661182.98519
1166	748765.73948	659904.89601
1167	748765.87735	659824.89532
1168	747860.13027	659489.69965
1169	750324.09592	659912.66769
1170	750324.03606	659924.66755
1171	750573.62101	659925.91250

MISCELLANEOUS R/W MONUMENTATION					
PT.	NORTHING	EASTING	DESCRIPTION	STATION	OFFSET
1022	742342.55038	660004.86029	FD 5/8" REBAR PLASTIC CAP STAMPED RLS 27239	1942+00.00	105.00 RT
1023	742342.66901	660014.85959	FD 5/8" REBAR PLASTIC CAP STAMPED RLS 27239	1942+00.00	115.00 RT
1026	740875.84421	660022.26202	FD 5/8" REBAR PLASTIC CAP STAMPED RLS 27239	1927+33.19	105.00 RT
1028	743507.66202	660001.03754	FD 5/8" REBAR PLASTIC CAP STAMPED RLS 27239	1953+65.08	115.00 RT
1033	745303.34330	659917.50411	FD 1/2" REBAR PLASTIC CAP STAMPED RLS 18214	1971+50.00	75.00 RT
1034	745306.08471	659932.25147	FD 1/2" REBAR PLASTIC CAP STAMPED RLS 18214	1971+50.00	90.00 RT
1045	746386.74				