

## Arizona Department of Transportation

# Intermodal Transportation Division Roadway Engineering Group

## MEMORANDUM

To: All Users of the Roadway Construction Standard	Date: 18 April 06
Drawings	
• /	
From: Mary Viparina MAV	Subject: C-Standards Update
Assistant State Engineer	
Roadway Engineering Group	

The October 2004 Roadway Construction Standard Drawings have been revised and updated, and are available for download on the Roadway Design web site at the following address: http://www.azdot.gov/highways/rdwyeng/roadwaydesign/viewable\_drawings.asp

The attached spreadsheet summarizes the changes made to the previous drawings. The changes of note are more fully described below:

- C-02.20 & C-02.30: Revised cut and fill slope dimensions;
- C-05.30, Shts 3 & 4 of 7: Modified PLAN and PERSPECTIVE views to clarify ramp location;
- C-05.30, Sht 7 of 7: Added a PLAN and SECTION views for a brick detectable warning strip;
- C-10.76: Modified SECTION views to depict "F" shape; and
- C-11.10: Re-issued the drawings in four sheets. Sheet 4 shows the clamp designed to enhance the bicycle ridability of the cattle guard.

Design personnel should implement the updated drawings and incorporate them into their project plans. For projects at or near completion, where the inclusion of all new standard drawings is not practical, the 1A Sheet must accurately reflect the correct revision dates for the design. Construction personnel should review the drawing revisions for possible implementation on construction projects.

Please distribute this memorandum to all users within your Group, Section, or District, and arrange for printing of the updated Standard Drawings for those without computer access. Copies of the complete set of Roadway Construction Standard Drawings (either 8-1/2" x 11" or 11" x 17") may be obtained from Engineering Records located at 1655 West Jackson, Room 175, Phoenix, AZ 85007-3217 or by telephoning 602-712-8216.

The updated Construction Standards Index (1A Sheet) and Barrier Summary Sheets are also available online at the address shown above.

Please direct questions regarding this memorandum or the updated standards to Kenneth Cooper, Roadway Standards Engineer at 602-712-8674.

#### MAV/KRC/krc

c: Roadway Engineering Group
Traffic Engineering Group
Valley Project Management Group
Environmental and Enhancement Group
Districts (10)
Statewide Project Management Group
FHWA
Contracts and Specifications Section
Construction Group
Bridge Group

Regional Traffic Engineers (4)
Materials Group
Local Government Section
Engineering Consultant Section
District Permits Office (9)
Engineering Records
Maintenance Group
Dan Lance
Sam Maroufkhani
Doug Forstie

STANDARD DRAWING	REVISION DESCRIPTION
C-02.10	Added "Rural" to title
C-02.20	Modified slope criteria – slopes and range. Modified drawing title.
C-02.30	Modified drawing title, slopes, and ranges. Added a note regarding proper standard application.
C-04.10, Sheet 2 of 2	Revised SECTION B-B and POST SLEEVE DETAIL by subduing graphics for post and w-beam guardrail. Revised note at outlet in SECTION B-B to correct references. General Note 4 revised by replacing "in lieu" with "instead."
C-05.12, Sheet 2 of 3	Removed Type 'G' Curb & Gutter from note.
C-05.30, Sheet 1 of 7	Modified General Note 2. Defined elevation of "Top of Ramp Curb" in SECTION BB. Revised text orientation.
C-05.30, Sheet 2 of 7	Modified General Note 2. Revised text orientation in SECTION AA.
C-05.30, Sheet 3 of 7	Modified General Note 3. Modified ramp location in PLAN and PERSPECTIVE views. Revised text orientation in SECTION AA.
C-05.30, Sheet 4 of 7	Modified ramp location in PLAN and PERSPECTIVE views.
C-05.30, Sheet 5 of 7	Modified General Note 3.
C-05.30, Sheet 7 of 7	Added PLAN and SECTION views of brick option Detectable Warning Strip (DWS). Modified PLAN view of non-brick DWS. Added General Note 1. Re-labeled section and detail views.
C-05.50	Revised General Note 6. Rearranged drawings on sheet. Modified SECTION AA. Revised Std Dwg reference in SECTION CC. Re-labeled "PLAN VIEW OF SECTION CC".
C-07.02	Revised General Notes 3 & 4 to correct Std Dwg reference from C-07.05 to C-07.04. Revised drawing titles.
C-10.51	Changed "PLAN VIEW" to "PLAN". Removed slope designation from sidewalk in SECTION views. Changed length of vertical taper from 12½" to 1'-0". Revised text orientation. Added "WITHOUT GUARDRAIL" to title of ELEVATION view of departure vertical taper.
C-10.52	Removed "D" reference and substituted "may" for "can" in General Note 5.
C-10.75, Sheet 1 of 2	Changed "PLAN VIEW" to "PLAN". Removed slope designation from sidewalk in SECTION views. Revised curb-height designation in SECTION A-A from "H" to "h".
C-10.75, Sheet 2 of 2	Changed "PLAN VIEW" to "PLAN". Removed dimensions at right side of PLAN view. Revised text orientation.
C-10.76	Changed "PLAN VIEW" to "PLAN". Revised SECTION view graphics to depict Type 'F' barrier.
C-10.77	Modified PLAN view to correct style and proportion of concrete half barrier and transitions. Modified references to other Std Dwgs.
C-11.10 Sheets 1 through 4 of 4	Re-issued Standard Drawing.
C-15.20, Sheet 1 of 3	Revised sheet number references.
C-15.91 & C-15.92, Sheet 2 of 2	Modified welding notations for ANSI conformance.
C-18.10, Sheet 2 of 3	Modified SECTION views to improve clarity.

From: Terry Otterness

**Sent:** Tuesday, April 25, 2006 11:13 AM

To: Chris Cooper; Urso Penalosa; Said Asad; Tim Wilson; Paul O'Brien; Joseph

Warren; Baljeet Chawla; Vincent Li; Steve Mishler; Alfredo Zapata; Ken Brown; Robert Fortune; Kenneth Cooper; Jeff Beimer; LeRoy Brady; Susan Tellez; Robert Miller; Larry Maucher; George Wallace; Jim Delton; John Lawson; Steve Jimenez; John Carr; John Dickson; Greg H. Gentsch; Roger Hopt; George Chin; Chuck Gillick; Reza Karimvand; Daniel MacDonald; John

Melanson; Lev Derzhavets; Oliver Antony; Pat Mahoney; Rod Collins; William Lyons; Bill Harmon; Dallas Hammit; David Sikes; John Harper; John Hauskins; Michael Kondelis; Paul Patane; Perry Powell; Richard Powers;

Ron Casper

Cc: Mary Viparina; Sam Maroufkhani; Dan Lance; Doug Forstie; Sam Elters
Subject: Construction Std. Drawings- Slope Design Standard Revisions- C-02.20 & C-

02.30

Please forward this e-mail notification to all roadway design personnel utilizing the subject Standard Drawings.

Please refer to the updated Construction Standard Drawings (Rev.date 4/06) that were issued today under separate e-mail notification. The maximum fill slope rates for Std. C-02.20 Rural Undivided and Fringe-Urban Highways and Std. C-02.30 Miscellaneous Roadways have been revised from 1 1/2:1 to 2:1. Also, the maximum cut slope rates for these two standards have been revised from 1:1 to 2:1. No slope changes have been made to Std. C-02.10 Rural Divided Highways. These revisions have been coordinated with the Materials Group Geotechnical Design.


The revisions to the slopes reflect what has been the norm for most projects. The 2:1 fill slopes provide a more stable embankment and provide an improved slope rate to establish vegetation and erosion control. The flatter 2:1 cut slope rates will also provide the same advantages. When in rock cuts, Geotechnical Design will continue to provide the maximum slope that can be used by the designer. Also, when cuts are in the higher ranges and there may be a significant project cost involved, Geotechnical Design will provide the designer the maximum slope that can be used to reduce the excavation required. The design process for establishing slope design for a project has not changed. The standard slopes simply provide the initial design slopes and the designer is to adjust the slopes for the project needs considering safety, material type, project costs, slope stablilization and other needs.

Thank you for your attention to these revisions. Please forward this e-mail to all users within your Groups and Districts. Contact your Roadway Group representative for any questions regarding these revisions.


Terry H. Otterness, P.E. Staff Engineer
Roadway Design Section
PH 602-712-4285
FAX 602-712-3075
totterness@azdot.gov

STANDARD DRAWING	REVISION DESCRIPTION
C-02.10	Added "Rural" to title
C-02.20	Modified slope criteria – slopes and range. Modified drawing title.
C-02.30	Modified drawing title, slopes, and ranges. Added a note regarding proper standard application.
C-04.10, Sheet 2 of 2	Revised SECTION B-B and POST SLEEVE DETAIL by subduing graphics for post and w-beam guardrail. Revised note at outlet in SECTION B-B to correct references. General Note 4 revised by replacing "in lieu" with "instead."
C-05.12, Sheet 2 of 3	Removed Type 'G' Curb & Gutter from note.
C-05.30, Sheet 1 of 7	Modified General Note 2. Defined elevation of "Top of Ramp Curb" in SECTION BB. Revised text orientation.
C-05.30, Sheet 2 of 7	Modified General Note 2. Revised text orientation in SECTION AA.
C-05.30, Sheet 3 of 7	Modified General Note 3. Modified ramp location in PLAN and PERSPECTIVE views. Revised text orientation in SECTION AA.
C-05.30, Sheet 4 of 7	Modified ramp location in PLAN and PERSPECTIVE views.
C-05.30, Sheet 5 of 7	Modified General Note 3.
C-05.30, Sheet 7 of 7	Added PLAN and SECTION views of brick option Detectable Warning Strip (DWS). Modified PLAN view of non-brick DWS. Added General Note 1. Re-labeled section and detail views.
C-05.50	Revised General Note 6. Rearranged drawings on sheet. Modified SECTION AA. Revised Std Dwg reference in SECTION CC. Re-labeled "PLAN VIEW OF SECTION CC".
C-07.02	Revised General Notes 3 & 4 to correct Std Dwg reference from C-07.05 to C-07.04. Revised drawing titles.
C-10.51	Changed "PLAN VIEW" to "PLAN". Removed slope designation from sidewalk in SECTION views. Changed length of vertical taper from 12½" to 1'-0". Revised text orientation. Added "WITHOUT GUARDRAIL" to title of ELEVATION view of departure vertical taper.
C-10.52	Removed "D" reference and substituted "may" for "can" in General Note 5.
C-10.75, Sheet 1 of 2	Changed "PLAN VIEW" to "PLAN". Removed slope designation from sidewalk in SECTION views. Revised curb-height designation in SECTION A-A from "H" to "h".
C-10.75, Sheet 2 of 2	Changed "PLAN VIEW" to "PLAN". Removed dimensions at right side of PLAN view. Revised text orientation.
C-10.76	Changed "PLAN VIEW" to "PLAN". Revised SECTION view graphics to depict Type 'F' barrier.
C-10.77	Modified PLAN view to correct style and proportion of concrete half barrier and transitions. Modified references to other Std Dwgs.
C-11.10 Sheets 1 through 4 of 4	Re-issued Standard Drawing.
C-15.20, Sheet 1 of 3	Revised sheet number references.
C-15.91 & C-15.92, Sheet 2 of 2	Modified welding notations for ANSI conformance.
C-18.10, Sheet 2 of 3	Modified SECTION views to improve clarity.


NO	DESCRIPTION OF REVISIONS	MADE BY	DATE
(1)	MODIFIED TITLE	RLF	4/06
2			
3			
4			

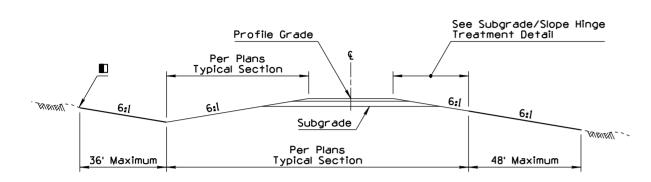


#### MINIMUM SLOPES

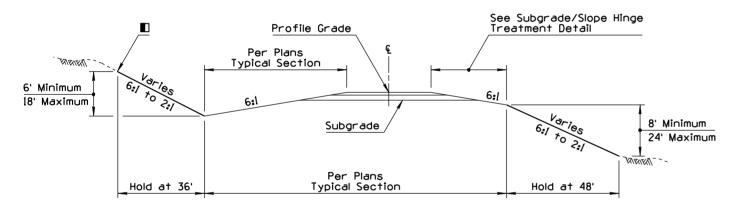


#### INTERMEDIATE SLOPES

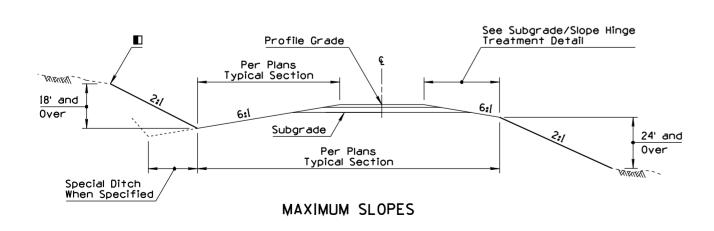

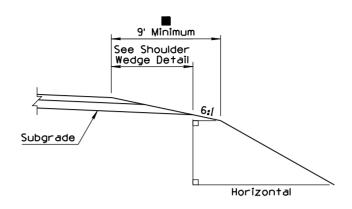


# SUBGRADE/SLOPE HINGE TREATMENT DETAIL

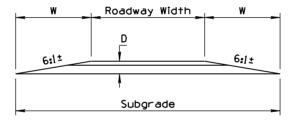

W = D x Slope (6:1)
D = Str Sct Depth (Ft) Excluding ACFC
Subgrade = 2 x W + Roadway Width

#### SHOULDER WEDGE DETAIL

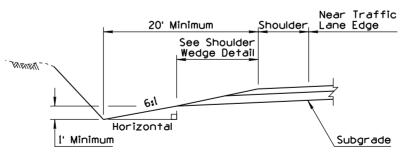


MINIMUM DITCH CONDITIONS DETAIL

#### GENERAL NOTES

- Roadway width, cut ditch width, cross slope, and pavement structure section will be shown on project plans.
- Payement structure slope is nominal. Actual slope is controlled by (D). See Shoulder Wedge Detail.
- Slopes beyond the pavement structure, such as embankment and cut slopes, are relative to horizontal.
- 4. For slope controls within interchange areas, see project plans.
- 5. When median slopes intersect, see project plans for controls.
- These slopes are intended to be used with new or reconstructed roadways.

#### NOTE TO DESIGNERS


The 9' minimum is required when guardrail is utilized on the project. Treatment shall be uniform throughout the project length. The 9' requirement may be waived under special conditions where guardrail is not utilized.

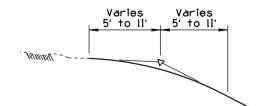


#### SLOPE ROUNDING DETAIL

Except in solid rock, or as directed by the Engineer, the intersection of roadway cut slopes with the ground surfaces shall be rounded.


For cuts up to 6', use 5' semi-tangents for slope rounding. For each additional foot of cut add I' to semi-tangent to 11' maximum.

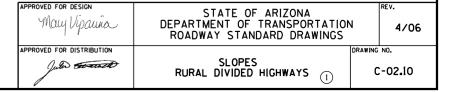


NO	DESCRIPTION OF REVISIONS	MADE BY	DATE
(1)	REVISED TITLE	RLF	4/06
2	MODIFIED SLOPE CRITERIA	RLF	4/06
3			
4			

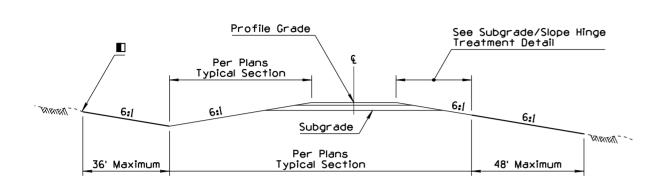


#### MINIMUM SLOPES

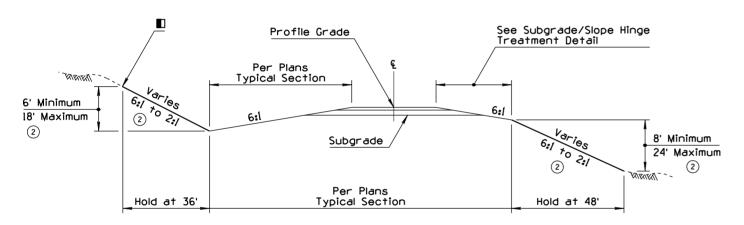


#### INTERMEDIATE SLOPES

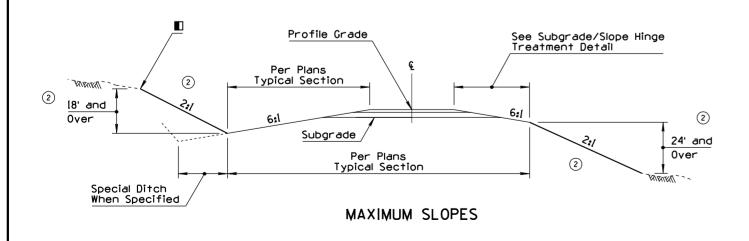

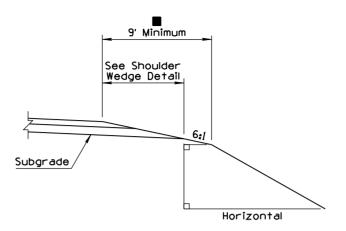


SUBGRADE/SLOPE HINGE TREATMENT DETAIL

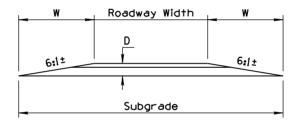

W = D x Slope (6:1)
D = Str Sct Depth (Ft) Excluding ACFC
Subgrade = 2 x W + Roadway Width

#### SHOULDER WEDGE DETAIL

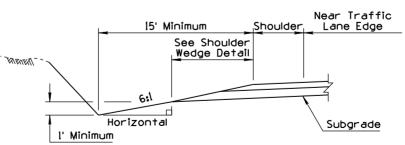


#### MINIMUM DITCH CONDITIONS DETAIL

#### GENERAL NOTES

- Roadway width, cut ditch width, cross slope, and pavement structure section will be shown on project plans.
- Pavement structure slope is nominal. Actual slope is controlled by (D). See Shoulder Wedge Detail.
- Slopes beyond the pavement structure, such as embankment and cut slopes, are relative to horizontal.
- When median slopes intersect, see project plans for controls.
- These slopes are intended to be used with new or reconstructed roadways.

#### NOTE TO DESIGNERS

The 9' minimum is required when guardrail is utilized on the project. Treatment shall be uniform throughout the project length. The 9' requirement may be waived under special conditions where guardrail is not utilized.

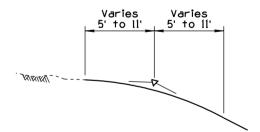


#### SLOPE ROUNDING DETAIL

Except in solid rock, or as directed by the Engineer, the intersection of roadway cut slopes with the ground surfaces shall be rounded.


For cuts up to 6', use 5' semi-tangents for slope rounding. For each additional foot of cut add 1' to semi-tangent to 11' maximum.

May Vipauña	STATE OF ARIZONA DEPARTMENT OF TRANSPORTATION ROADWAY STANDARD DRAWINGS	4/06
APPROVED FOR DISTRIBUTION  July Grand	SLOPES (1) RURAL UNDIVIDED AND FRINGE-URBAN HIGHWAYS	C-02.20


NO	DESCRIPTION OF REVISIONS	MADE BY	DATE
	MODIFIED TITLE	RLF	4/06
2	MODIFIED SLOPE CRITERIA	RLF	4/06
3	ADDED USAGE NOTE	RLF	4/06
$\mathbf{A}$			

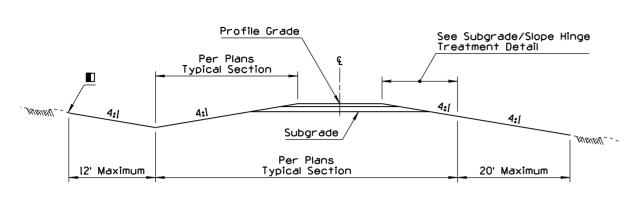


#### MINIMUM SLOPES

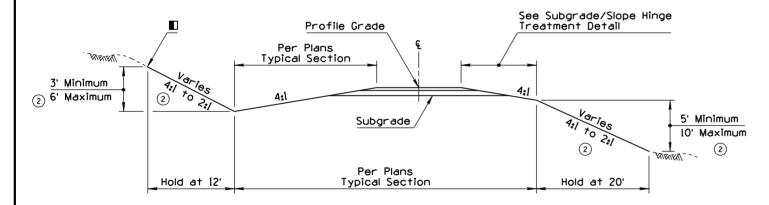


INTERMEDIATE SLOPES

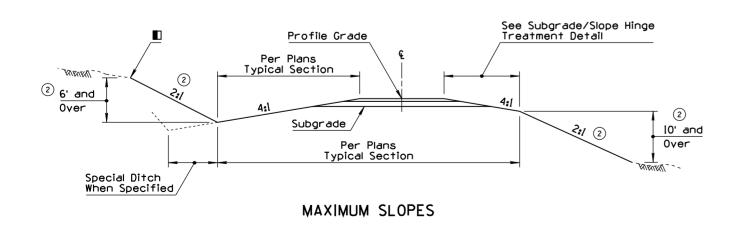

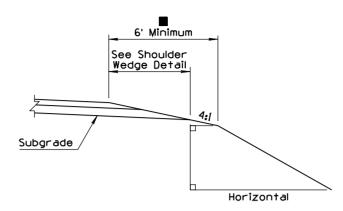


SUBGRADE/SLOPE HINGE TREATMENT DETAIL

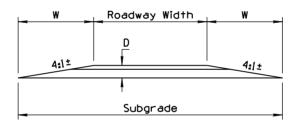

W = D x Slope (4:1)
D = Str Sct Depth (Ft) Excluding ACFC
Subgrade = 2 x W + Roadway Width

#### SHOULDER WEDGE DETAIL

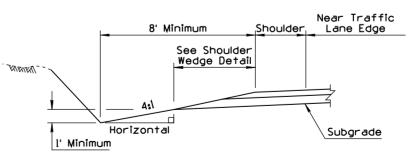


#### MINIMUM DITCH CONDITIONS DETAIL

#### GENERAL NOTES

- Roadway width, cut ditch width, cross slope, and pavement structure section will be shown on project plans.
- Pavement structure slope is nominal. Actual slope is controlled by (D). See Shoulder Wedge Detail.
- Slopes beyond the pavement structure, such as embankment and cut slopes, are relative to horizontal.

#### NOTE TO DESIGNERS

- 3 USE OF THIS STANDARD IS LIMITED. SEE ROADWAY DESIGN GUIDELINES, SECTION 306.2.
- The 6' minimum is required when guardrail is utilized on the project. Treatment shall be uniform throughout the project length. The 6' requirement may be waived under special conditions where quardrail is not utilized.

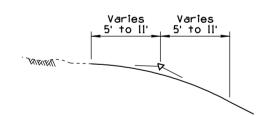

#### SLOPE ROUNDING DETAIL


Except in solid rock, or as directed by the Engineer, the intersection of roadway cut slopes with the ground surfaces shall be rounded.

For cuts up to 6', use 5' semi-tangents for slope rounding. For each additional foot of cut add l' to semi-tangent to 11' maximum.

PROVED FOR DISTRIBUTION  SLOPES MISCELLANEOUS ROADWAYS  DRAWING NO.  C-02.30	May Vipauna	STATE OF ARIZONA DEPARTMENT OF TRANSPORTATION ROADWAY STANDARD DRAWINGS	N 4/06
		SLOPES (1)	


NO DESCRIPTION OF REVISIONS MADE BY DATE  1 NEW STANDARD DRAWING RLF 7/05  2 REVISED NOTE REFERENCE RLF 4/06  3 SUBDUED POST / W-BEAM GRAPHICS RLF 4/06  4	
9'-6" (Typ)  B Normal or 2' Widened Shoulder Line  Embankment Curb (Typ)  Flow  Flow	GENERAL NOTES  1. Location may be adjusted to accommodate guardrail post layout.  2. All concrete shall be Class B. Embankment curb concrete shall be in accordance with the Std
Post 1 Post 3  Guardrail Post (Typ)	<ul> <li>Specs.</li> <li>Where rock is encountered the outlet may be omitted, as approved by the Engineer.</li> <li>When outlet is used, the wire mesh shall extend through the joint into the outlet instead of bending into the key.</li> <li>Spillway invert slope shall be uniformly downward from A to B. See Section B-B.</li> </ul>
Guardrail Post With Sleeve (Typ) 3 Required See 'Leaveout' Detail  6'  6'  6'  Symmetrical About & 8'' Minimum  (Typ)    1//2'' Minimum   1//2'' Minimum   1//2'' Minimum   1//2'' Minimum   1//2'' Minimum	6. See Std Dwg C-04.30 for spillway length.  7. All posts within the inlet shall have a "leaveout" measuring a minimum of 1½" in front and ½" at each side, to the full depth of the concrete. The "leaveout" behind Posts 1 & 3 shall end at the toe of the curb. The "leaveout" behind Post 2 shall measure 8" minimum. After guardrail installation, the "leaveout" shall be filled with a one-sack grout mix or alternate material as approved by the Engineer.  • Length may be 4'-6" or 5'-0".
SECTION A-A  SECTION A-A  Security  Post & Sleeve  "LEAVEOUT" DETAIL  Guardrail Post  Guardrail Post	Indicates Inlet
3 5% x9½" Hex HD Bolt ASTM 325 & Nut Install Nut On Traffic Sid  SPILLWAY SECTION  6*x8* Post Sleeve ●	<u>e</u>
Normal or 2' Widened Roadway Width  A    1'-0"	
POST SLEEVE DETAIL  Spillway  See General Notes 3 & 4  6x6-WI.4/WI.4  Wire Mesh in Apron  APPROVED FOR DESIGN  May Wood	STATE OF ARIZONA
SECTION B-B  SECTI	ROADWAY STANDARD DRAWINGS    DRAWING NO.

NO DESCRIPTION OF REVISIONS MADE BY DATE  1) REISSUED STANDARD DRAWING RLF 7/05  2) REVISED NOTE RLF 4/06  3 4		_
Roadway Width	Roadway Width	<ul> <li>Curb Height Varies 0" to 7" Maximum in Depressed Curb Area Beyond the End of Barrier. See Plans for Curb Height.</li> <li>Curb &amp; Gutter Type B, C, C-1, D, D-1, D-2 or D-3</li> </ul>
S. 7. 7. 7. 7. 7. 7. 7. 7. 7. 7. 7. 7. 7.	Gore Area  Area  Area  Area  Area  Area  Area  Area	Varies - See Plans  G Joint Std Dwg C-07.01 Sheet 2 of 2  A  Radius
PERSPECTIVE	PERSPECTIVE	Radius See Plans Gutter Line
Top of Curb  15' Transition  6'  SECTION B-B	15' Transition  Top of Cur  Top of Cur	TYPE 4 - CURB & GUTTER TRANSITION  2½"  Radius Point  Varies 2' to 4'
Dimensions May Vary Type D, D-1, D-2 or D-3 Std Dwg C-05.I0  B  Gutter Line  Dimensions May Vary Type D, D-1, D-2 or D-3 Std Dwg C-05.I0	Gore Area  Gutter Line  Gutter Line  Gutter Lip	1 R  4 R  7
Curb & Gutter Type B or C Std Dwg C-05.10  TYPE 2 - CURB & GUTTER TRANSITION  PLAN	TYPE 3 - CURB & GUTTER TRANSITION AT PAVED GORE PLAN	APPROVED FOR DESIGN  May Vipaura  DEPARTMENT OF TRANSPORTATION  ROADWAY STANDARD DRAWINGS  API  CURB & GUTTER TRANSITIONS  C-05.12  Sheet 2 of 3

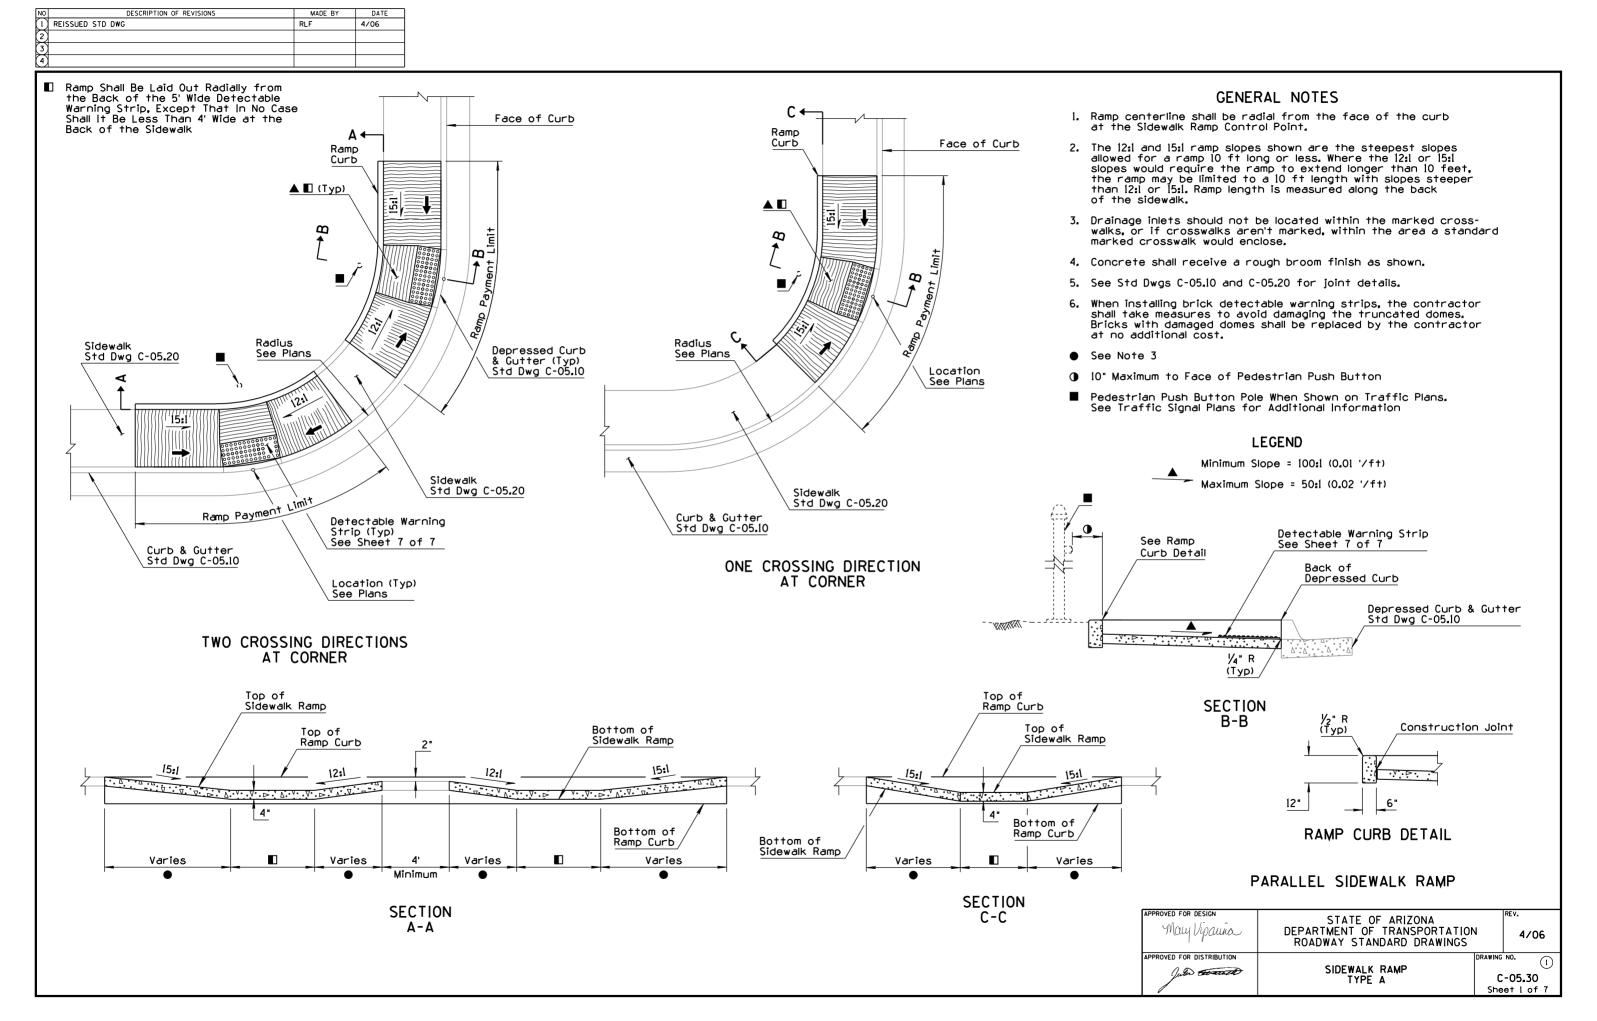

NO   DESCRIPTION OF REVISIONS   MADE BY   DATE	
Sidewalk Std Dwg C-05.20 Std Dwg C-05.10  2.  Radius See Plans  Depressed Curb & Gutter (Typ) Std Dwg C-05.10  Redius See Plans  Redius See Plans  Location See Plans  Location See Plans	GENERAL NOTES  Ramp centerline shall be radial from the face of the curb at the sidewalk ramp control point.  The I5:1 ramp slope shown is the steepest slope allowed for a ramp 10 ft long or less. Where the I5:1 slope would require the ramp to extend longer than 10 feet, the ramp may be limited to a 10 ft length with slope steeper than 15:1. Ramp length is measured along the back of the sidewalk.  Orainage inlets should not be located within the marked crosswalks, or if crosswalks aren't marked, within the area a standard marked crosswalk would enclose.  Concrete shall receive a rough broom finish as shown. The side slope wings do not receive a broom finish.  The Engineer may approve replacing the side slope wing with a curb at a location where access to the side of a ramp run is blocked by a pole, utility box, other obstruction, or by a non-accessible surface such as a dirt planter strip.  See Std Dwgs C-05.10 and C-05.20 for joint details.  When installing brick detectable warning strips, the contractor shall take measures to avoid damaging the truncated domes. Bricks with damaged domes shall be replaced by the contractor at no additional cost.  Pedestrian Push Button Pole When Shown on Traffic Plans. See Iraffic Signal Plans for Additional Information  LEGEND  Minimum Slope = 100:1 (0.01 '/ft)
Detectable Warning Strip (Typ) See Sheet 7 of 7  Location (Typ) See Plans  ONE CROSSING DIRECTION AT CORNER  ONE CROSSING DIRECTION AT CORNER	Maximum Slope = 50:1 (0.02 '/ft)  Detectable Warning Strip See Sheet 7 of 7  Back of Depressed Curb (Minimum)  Depressed Curb & Gutter Std Dwg C-05:10
Top Back of Sidewalk Ramp  Top of Sidewalk Ramp  10:1  Varies 5' Chord Varies Varies 5' Chord Varies	SECTION B-B
SECTION A-A	PERPENDICULAR CURB RAMP  STATE OF ARIZONA  DEPARTMENT OF TRANSPORTATION ROADWAY STANDARD DRAWINGS  APPROVED FOR DISTRIBUTION SIDEWALK RAMP TYPE B  C-05.30 Sheet 2 of 7

N0	DESCRIPTION OF REVISIONS	MADE BY	DATE
	REISSUED STD DWG	RLF	4/06
2			
(3)			
(4)			

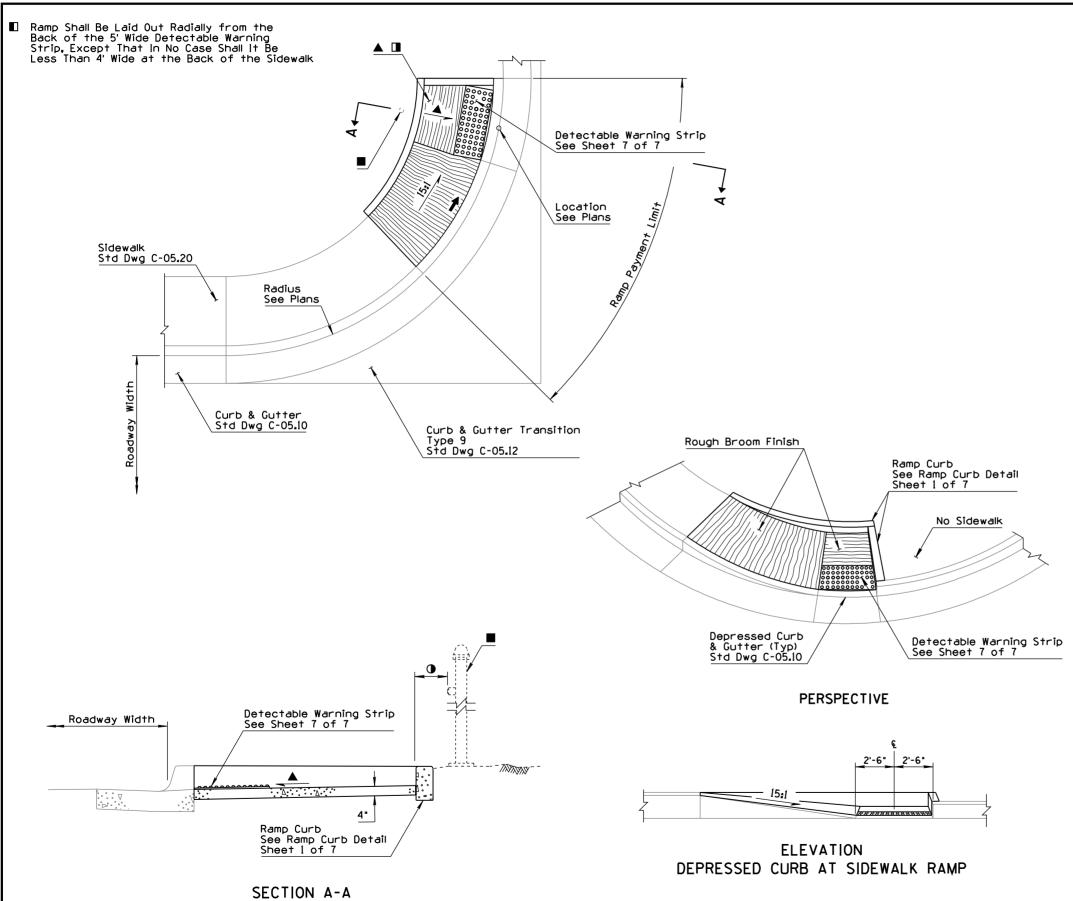

#### GENERAL NOTES


- 1. For use where sidewalk is not continuous.
- 2. Ramp centerline shall be radial from the face of the curb at the Sidewalk Ramp Control Point.
- 3. The 15:1 ramp slope shown is the steepest slope allowed for a ramp 10 ft long or less. Where the 15:1 slope would require the ramp to extend longer than 10 feet, the ramp may be limited to a 10 ft length with slope steeper than 15:1. Ramp length is measured along the back of the sidewalk.
- 4. The top of the Ramp Curb along the back of the Sidewalk Ramp shall match the elevation of the adjacent back of sidewalk and run parallel to the Sidewalk Ramp. The Ramp Curb along the side of the Sidewalk Ramp shall match the elevation at the back of the Curb & Gutter and the back of Ramp Curb.
- Drainage inlets should not be located within the marked crosswalks, or if crosswalks aren't marked, within the area a standard marked crosswalk would enclose.
- 6. Concrete shall receive a rough broom finish as shown.
- 7. See Std Dwgs C-05.10 and C-05.20 for joint details.
- 8. When installing brick detectable warning strips, the contractor shall take measures to avoid damaging the truncated domes. Bricks with damaged domes shall be replaced by the contractor at no additional cost.
- Pedestrian Push Button Pole When Shown on Traffic Plans. See Traffic Signal Plans for Additional Information
- 10" Maximum to Face of Pedestrian Push Button

#### LEGEND


Minimum Slope = 100:1 (0.01 '/ft)

Maximum Slope = 50:1 (0.02 '/ft)

#### SIDEWALK RAMP AT SIDEWALK TERMINUS

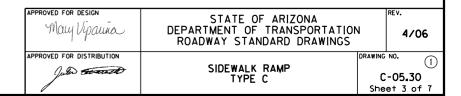

NO DESCRIPTION OF REVISIONS MADE BY DATE  I) REISSUED STANDARD DRAWING RLF 4/06		
(2) (3) (4)		
Ramp Shall Be Laid Out Radially from the Back of the 5' Wide Detectable Warning		GENERAL NOTES
Strip, Except That In No Case Shall It Be Less Than 4' Wide at the Back of the Sidewalk		l. For use where sidewalk is not continuous.
	TT Court & Courter	<ol> <li>Ramp centerline shall be radial from the face of the curb at the Sidewalk Ramp Control Point.</li> </ol>
Detectable Warning Strip See Sheet 7 of 7	Curb & Gutter Type D When Shown on Plans See Std Dwg C-05.10	3. The top of the Ramp Curb along the back of the Sidewalk Ramp shall match the elevation of the adjacent back of sidewalk and run parallel to the Sidewalk Ramp. The Ramp Curb along the side of the Sidewalk Ramp shall match the elevation at the back of the Curb & Gutter and the back of Ramp Curb.
	DOOGOOO Location See Plans	<ol> <li>Drainage inlets should not be located within marked crosswalks, or if crosswalks aren't marked, within the area a standard marked crosswalk would enclose.</li> </ol>
	// Tee Plans / S	5. Concrete shall receive a rough broom finish as shown.
Dadi		Rough Broom Finish 6. See Std Dwgs C-05.10 and C-05.20 for joint details.
Radius See Plans	Depressed Curb & Gutter (Typ) Std Dwg C-05,10	Ramp Curb See Ramp Curb Detail Sheet 1 of 7  When installing brick detectable warning strips, the contractor shall take measures to aviod damaging the truncated domes. Bricks with damaged domes shall be replaced by the contractor at no additional cost.
Sidewalk Std Dwg C-05.20	Barrier Transition	Pedestrian Push Button Post When Shown on Traffic Plans. See Traffic Signal Plans for Additional Information
	Std Dwg C-10.76	10" Maximum to Face of Pedestrian Push Button
\ \ \ \ \ \ \ \ \ \ \ \ \ \ \ \ \ \ \		LEGEND
	Detectable Warning Strip See Sheet 7 of 7	Minimum Slope = 100:1 (0.01 '/ft)
		Maximum Slope = 50:1 (0.02 '/ft)
	PERSPECTI	IVE 24-
Barrier Transition  Barrier Transition  Std Dwg C-10.76	rrier Gutter Transition d Dwg C-10.76	Barrier Transition
		Std Dwg C-10.76  Detectable Warning Strip Sheet 7 of 7
Roadway PL AN		Sheet 7 of 7
<b> </b>		Contraction of the Contraction o
	<b>■</b> 4==	$\begin{array}{cccccccccccccccccccccccccccccccccccc$
6		Sidewalk Ramp
5' Chord	Roadway Width	
		DETAIL
······································	ν. Δ Δ	SIDEWALK DAMB AT SIDEWALK TERMINIS
	Ramp Curb	SIDEWALK RAMP AT SIDEWALK TERMINUS SIDEWALK BEHIND BARRIER
CECTION D D	See Ramp Curb Detail Sheet 1 of 7	APPROVED FOR DESIGN STATE OF ARIZONA REV.
SECTION B-B		May Vipaura DEPARTMENT OF TRANSPORTATION 4/06 ROADWAY STANDARD DRAWINGS
	SECTION A-A	APPROVED FOR DISTRIBUTION  SIDEWALK RAMP TYPE D  C-05.30 Sheet 4 of 7

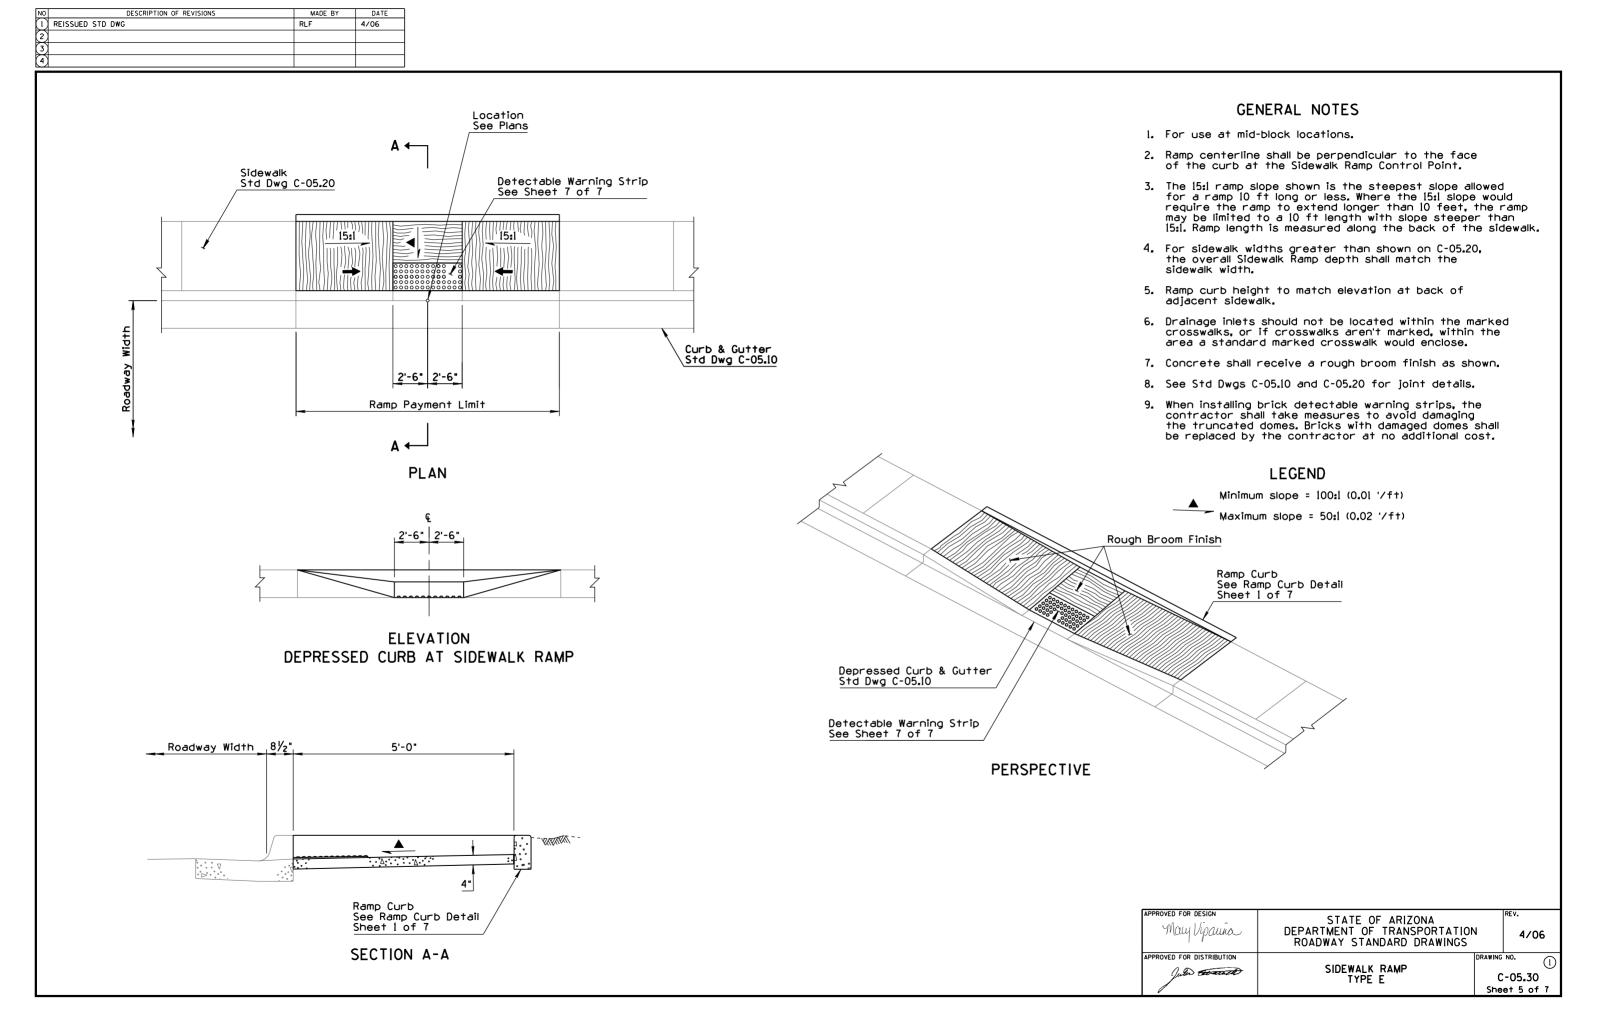


DESCRIPTION OF REVISIONS		DATE			
1) ADDED PLAN & SECTION FOR BRICK OPTION 2) REVISED TITLE	RLF 4/0				
3)	INET 170	00			
4)					
	21.01			21.01	
-	2'-0"	-		2'-0"	
					GENERAL NO
					1. Or ain shall be placed in
					l. Drain shall be placed in l with coarse aggregate ( securely tied in a long-l
000	0000	$\neg$	4	000000000	securely tied in a long-l
	0 0 0 0 0 0 0 0				
	000/				LEGEND
© © © © © © © © © © © © © ©	0 0 0)				
					● "/ <sub>6</sub> " Minimum (Typ) (0.65"
					$lacktriangle$ 1 $rac{1}{8}$ " to 2 $rac{3}{8}$ " (Typ) (1.6" to
					$\blacksquare$ $\frac{7}{8}$ " to $1\frac{3}{8}$ " (Typ) (0.9" to
				\ \ \\ \	■ 50% to 65% of ■
				Sobasta Sign	
_				0,0/	
9 2			• -		
<u>σ</u>		1 4	மி		
					<del>▼</del> +
	لــ	6			
		0			
	000 000	0			
	\@@@@	<b>◎</b>			
	/           	0	.		
	00000	<b>o</b>	A	/	

#### DETECTABLE WARNING STRIP


000000

#### PLAN

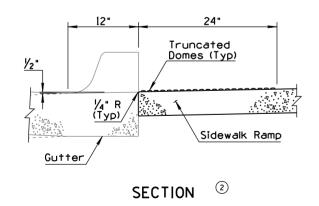

# DETECTABLE WARNING STRIP BRICK OPTION

1 **PLAN** 

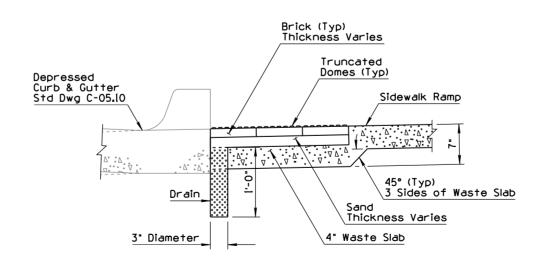


### **SECTION**




#### NOTES


n low corner and filled e (AASHTO N43 Size 7) g-life geotextile sack.

- Minimum ADA Actual)
- to 2.4" ADA Actual)
- to 1.4" ADA Actual)

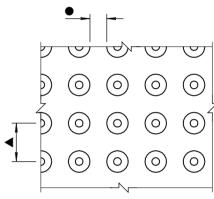

TEXTURE PATTERN DETAIL

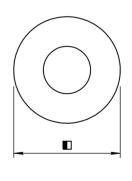

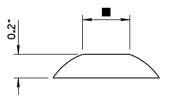

PLAN


ELEVATION <sup>②</sup>

# TRUNCATED DOME DETAIL


2


May Vipauña	STATE OF ARIZONA DEPARTMENT OF TRANSPORTATION ROADWAY STANDARD DRAWINGS	N	4/06
APPROVED FOR DISTRIBUTION  July was	SIDEWALK RAMP DETECTABLE WARNING STRIP	1 -	05.30 eet 7 of 7


N0	DESCRIPTION OF REVISIONS	MADE BY	DATE
(1)	MODIFIED GUTTER DEPRESSION VALUE & ADDED NOTE	RLF	9/04
2	MODIFIED REFERENCE	RLF	4/06
3	REVISED NOTE	RLF	4/06
(4)	MODIFIED SECTION A-A	RLF	4/06

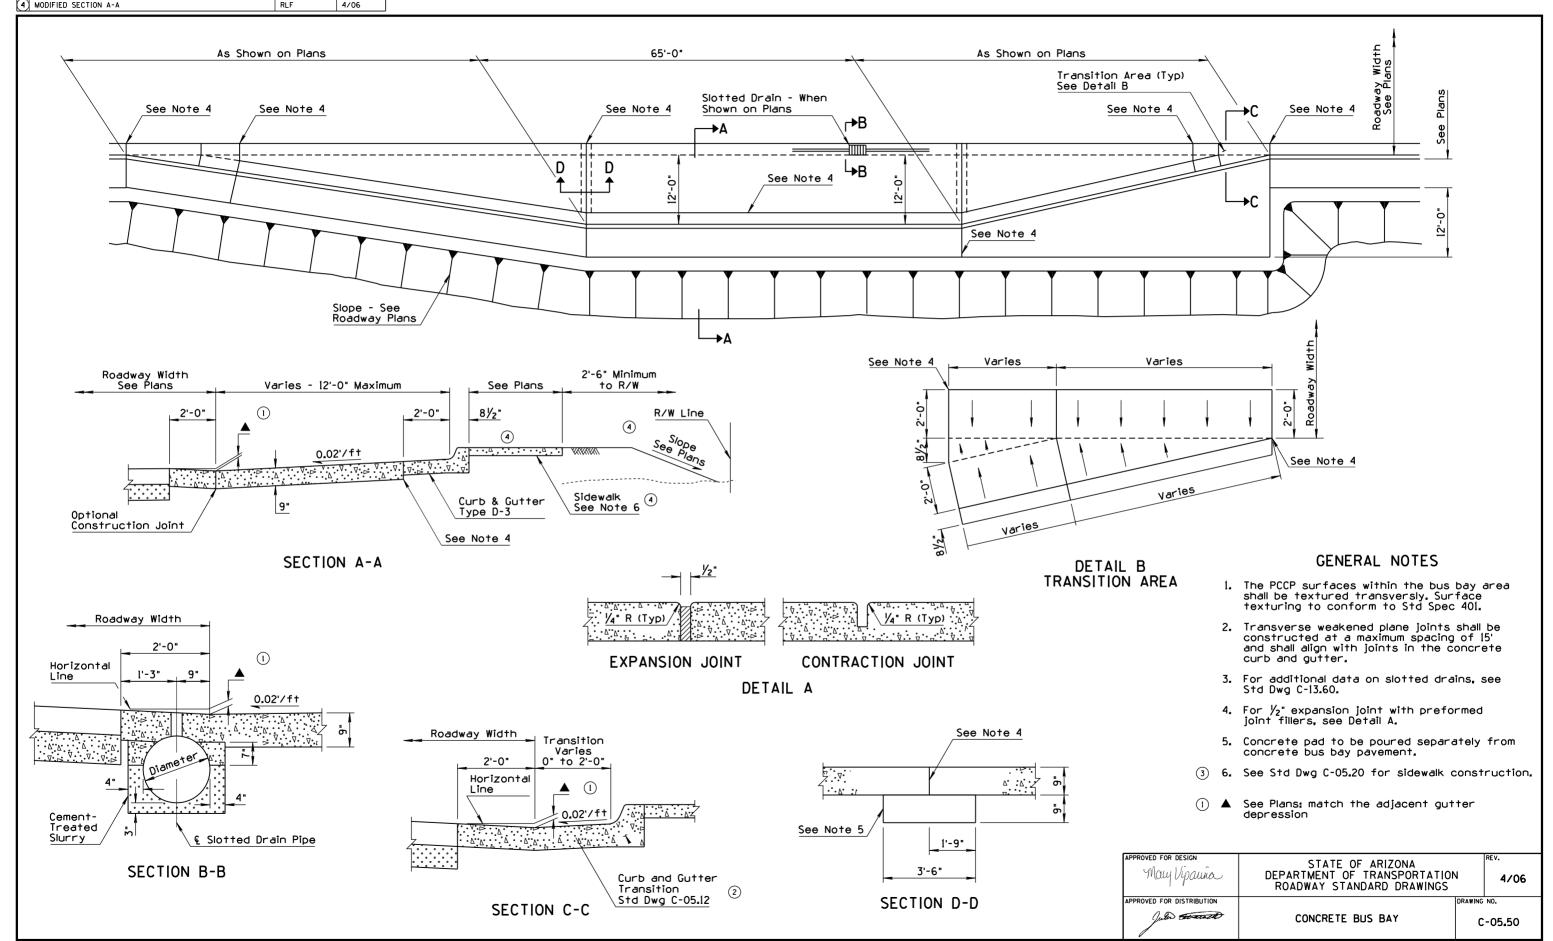

NO	DESCRIPTION OF REVISIONS	MADE BY	DATE
	MODIFIED TABLE MEASUREMENT FORMAT	RLF	9/04
2	CHANGED REFERENCE TO C-07.04	RLF	4/06
(3)	REVISED TITLE	RLF	4/06
4			

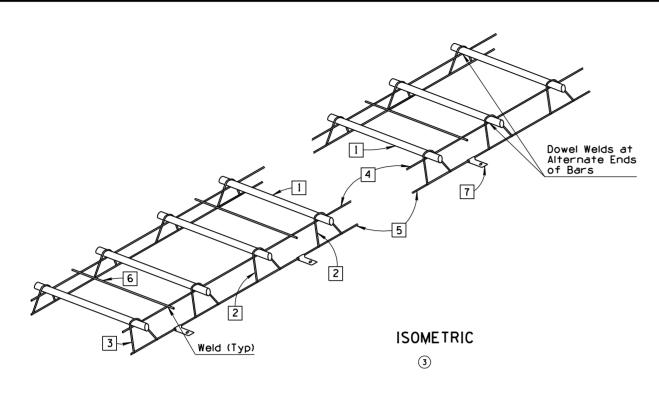


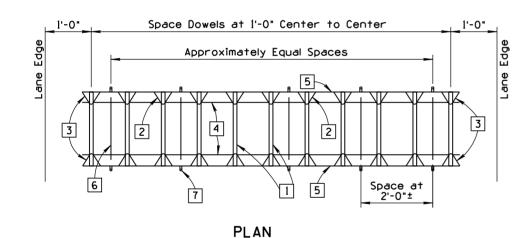

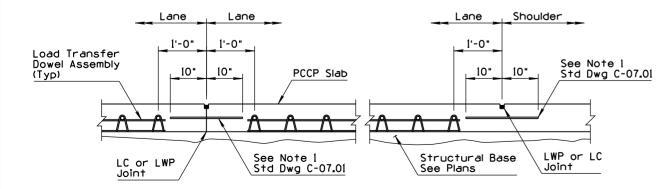


(3)


PLACEMENT AND EDGE CLEARANCE DETAIL 3

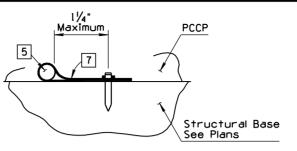

#### ANCHOR STRAP DETAIL

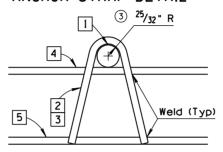

#### END AND INTERMEDIATE LEG DETAIL

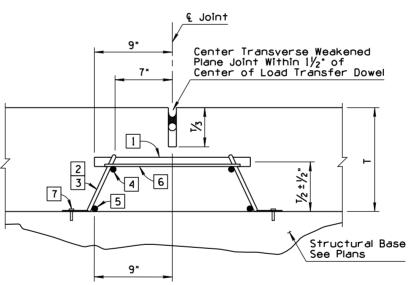

TRANSVERSE WEAKENED-PLANE JOINT WITH LOAD TRANSFER DOWEL ASSEMBLY

DIMENSION TABLE

Lane Width (Ft)

12 14 16

(Ft-In)) 10-4 12-4 14-4

#### GENERAL NOTES


- Load transfer dowel assemblies shall be used with non-skewed PCCP joints.
- 2. Load transfer dowel assemblies are to be placed at each transverse weakened plane joint on the traveled lanes as shown on the plans.
- ② 3. See Std Dwgs C-07.01 through C-07.04 for additional information.
- ② 4. See plans or Std Dwgs C-07.03 through C-07.04 for transverse joint spacing.
  - See plans for payement thickness less than 12" or greater than 14".

Load transfer dowel assembly shall be assembled from the following materials: (See Quantity Table)


- Dowel bars  $1\frac{1}{2}$ " diameter x 1'-6" plain round bars with coating. See Special Provisions.
- Intermediate legs 2 gauge or W-5.5 wire.
- 3 End legs 2 gauge or W-5.5 wire.
- Upper space bar 2 gauge or W-5.5 wire  $\times$  (See Dimension Table)
- 5 Lower space bar 2 gauge or W-5.5 wire  $\times$  (See Dimension Table)
- | 6 | Tie bars W-1.5 wire x 16".
- Anchor strap 1"x3" steel strap, 0.079 thick. Place with a  $1\frac{1}{2}$ " minimum length steel nail for LCB, 4" minimum length steel nail for ACB or AB, 0.145 diameter ASTM A227 Class 1 with  $\frac{1}{4}$ " head or washer.


May Vipauña	STATE OF ARIZONA DEPARTMENT OF TRANSPORTATION ROADWAY STANDARD DRAWINGS		4/06
APPROVED FOR DISTRIBUTION  July Grand	LOAD TRANSFER DOWEL ASSEMBLY	DRAWING	NO. -07₄02

NO DESCRIPTION OF REVISIONS MADE BY DATE  1 MODIFIED SECTION VIEWS: REMOVED SLOPE DESIGNATION RLF 4/06  2 WAS 12½° - IS NOW 1' & ADDED WITHOUT GUARDRAIL TO TITLE RLF 4/06  3 MODIFIED TITLE RLF 4/06  4		
New Curb Behind Sidewalk Match Bridge Curb  New Curb Behind Sidewalk Slope to Match Bridge Sidewalk Sidewalk Cross Slope = 0.010'/ft (Toward the Barrier)  Back Edge of Sidewalk Std Dwg C-05.20  Slotted Drain See Plans  Lip of Cutter	# 6 Rebars    10"   Construction   Joint   Catch Basin   Std Dwg C-15.30    # 6 Rebars   12" Center to Center   1'-6"   6"    # 5 Rebar (Typ)	GENERAL NOTES  1. Concrete shall be Class S, f'c=4000 PSI.  2. Rebar shall conform to Std Spec 1003.  3. Rebar shall have 2" minimum clear cover unless otherwise noted.  4. See drainage sheets for slotted drain and catch basin details.  5. Departure termination may be substituted for Std Dwg C-10.76 barrier transition under departure conditions.  6. See Std Dwg C-05.20 for sidewalk construction.  7. All bend dimensions for rebar are out-to-out of rebars.
PLAN  Traffic  See Dowel Installation and Construction Joint Detail Std Dwg C-10.70 Sheet 3 of 3  Cutter Line & Transition Std Dwg C-10.76  A Top of Sidewalk  Varies - See Plans	# 5 Rebars  12" Center to Center  1½" Clear of Side Walls	Varies Match Adjoining Gutter Depression  B Joint when Adjacent to PCCP Std Dwg C-07.01  BARRIER GUTTER DETAIL
ELEVATION  Top of Curb Std Dwg C-05.10  ELEVATION DEPARTURE TERMINATION WITHOUT GUARDRAIL	SECTION A-A	NVED FOR DESIGN  STATE OF ARIZONA  DEPARTMENT OF TRANSPORTATION ROADWAY STANDARD DRAWINGS  VED FOR DISTRIBUTION  CONCRETE HALF BARRIER 32' TYPE 'F' WITH SIDEWALK  REV.  4/06  CONCRETE HALF BARRIER CC-10.51

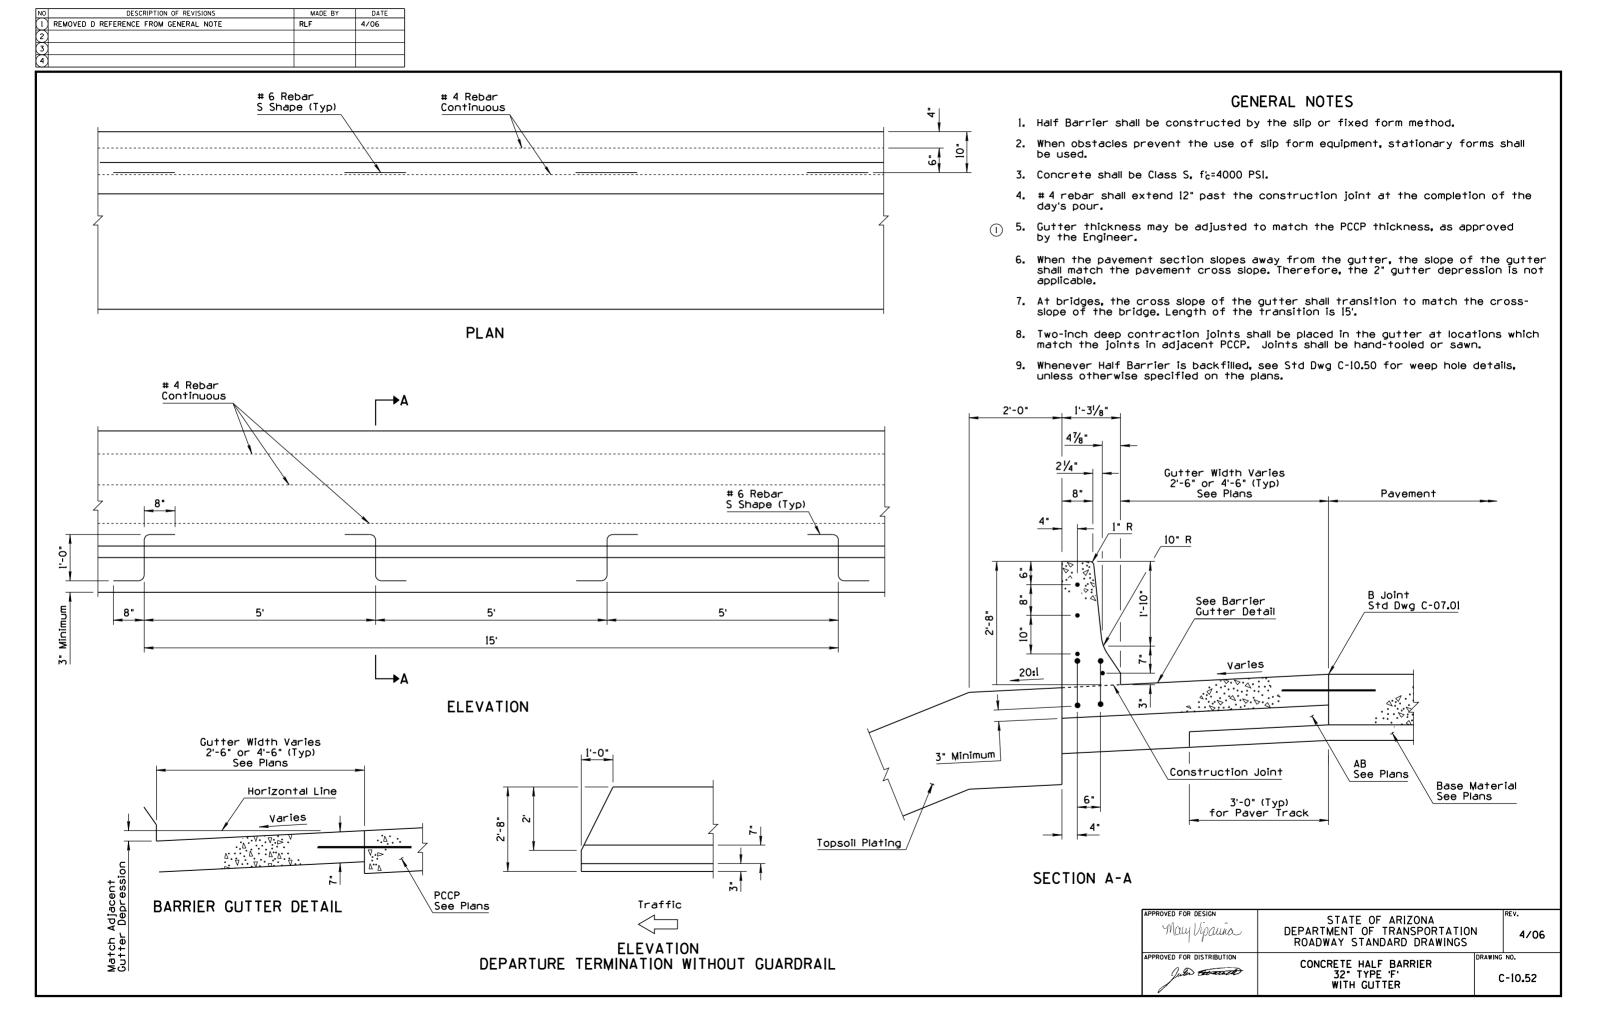


Standard Stock  Standard Stan	NO DESCRIPTION OF REVISIONS MADE BY DATE  1) REVISED SECTION VIEW GRAPHICS RLF 4/06  2 REVISED 'H' HEIGHT DESIGNATION TO 'h' RLF 4/06  3 4		
and quiter and concrete letter farm.  Gotter Line  Gotter	(Toward the Curb)	Sidewalk Slope and Width Sidewalk Cross Slope = 0.010'/ft in 5', Std Dwg C-05.20  2. All  Concrete Curb  Slope to Match in 5', Std Dwg C-05.20  2. All  3. All  Other concrete Curb	concrete shall be Class S, f'c=4000 PSI.  rebar shall conform to Std Spec 1003.  rebar shall have 2" minimum clear cover unless therwise noted.  de drainage sheets for slotted drain and catch isin details.
PLAN  Concrete  Her Concrete		Gutter Line  Gutter Line  20'-0"  6. See Trusting in which is a second and a second a second and	be Std Dwg C-05.20 for sidewalk construction.  bend dimensions for rebar are out-to-out rebars.  co-inch deep contraction joints shall be placed the gutter at locations which match the joints adjacent PCCP and at approximate 15' centers nen adjacent to AC pavement. Joints shall be ther hand tooled or sawn.
BARRIER GUTTER DETAIL  Varies From  1-3/s  Varies From  1-4' to 3-6'  1-5'  1-5'  Varies From  1-4' to 3-6'  1-5	Varies Match Adjoining Gutter Depression  Horizontal Line  7. PCCP See Plans  B Joint	PLAN  Concrete Half Barrier  Top of Sidewalk  Transition Top of Sidewalk in 10'-0"  See Construction Joint Detail Std Dwg C-10.71 Sheet 2 of 2  #6 Rebar	1'-05%" to 101/4"  Varies to 1'-8"  1'-71/2"  1" R
3" Clear of Bottom and ROADWAY STANDARD DRAWINGS	BARRIER GUTTER DETAIL  103%" 1'-31/8" 2'-0" Sidewalk (Typ)  21/2" 22/2" 2	Varies From I'-4" to 3'-6  Varies From I'-4" to 3'-6  Varies To Mi to 3'-6  Varies to 7'  # 5 Rebar (Typ)  APPROVED FOR DESIGN	See Barrier Gutter Detail  # 6 Rebars 12 Center to Center 3 Clear of Bottom and Side Walls When Cast Against Earth  ECTION C-C  ANSITION TO VERTICAL TYPE CURB

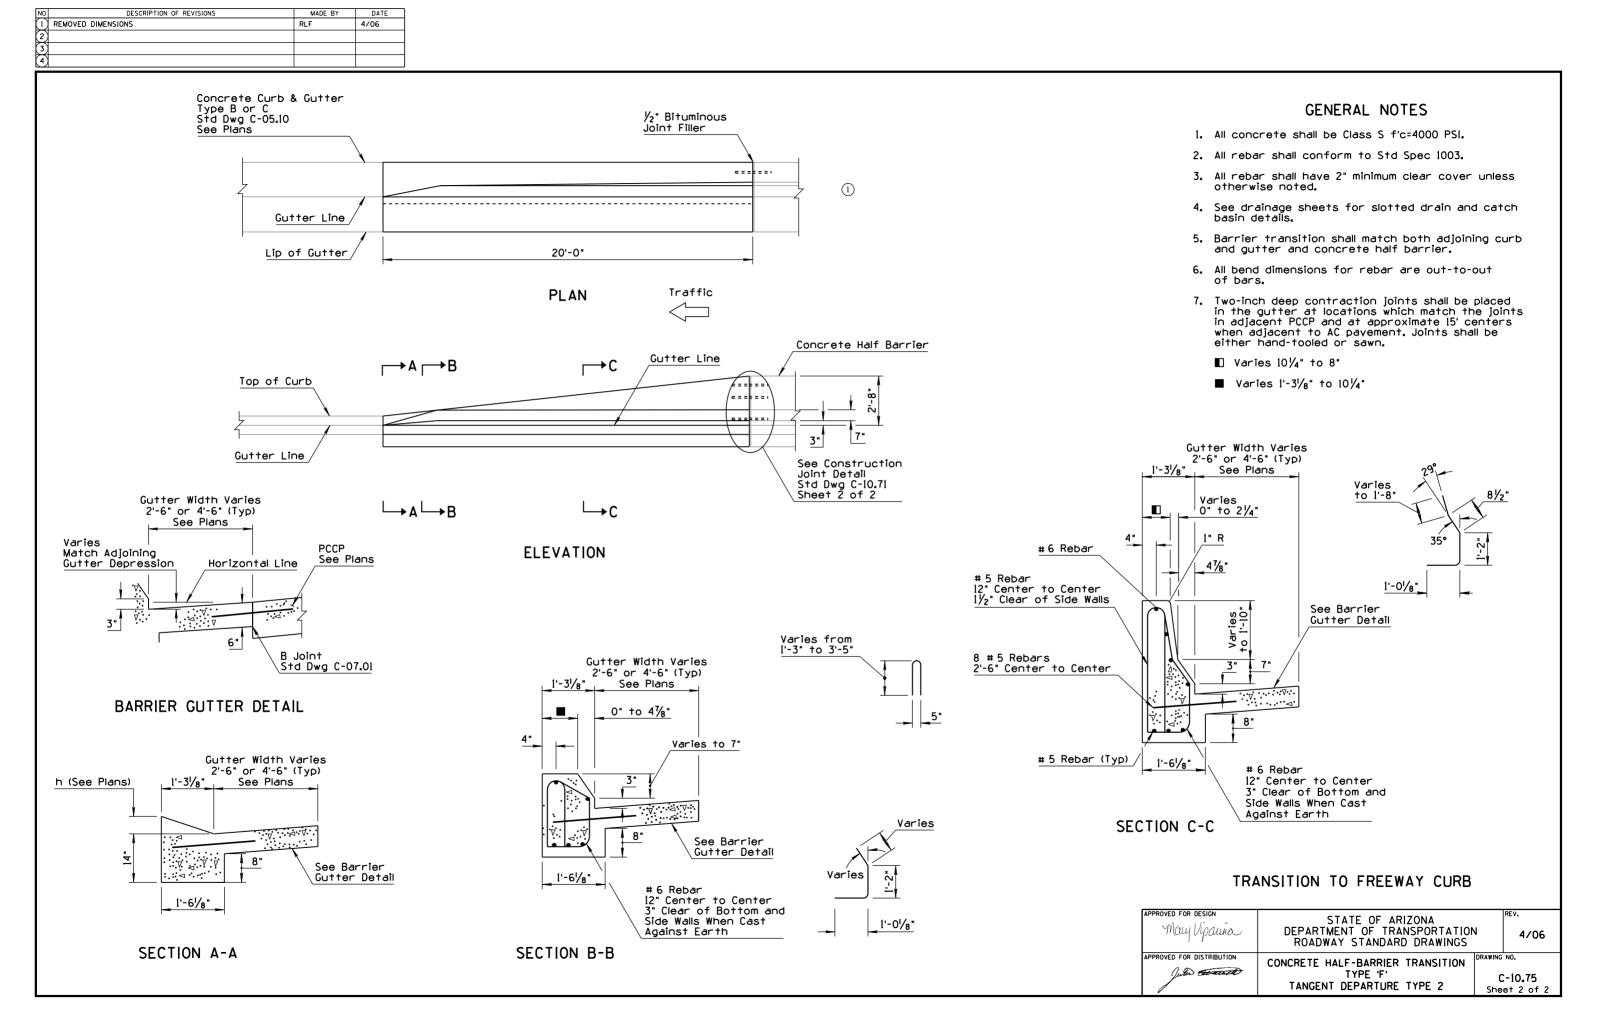

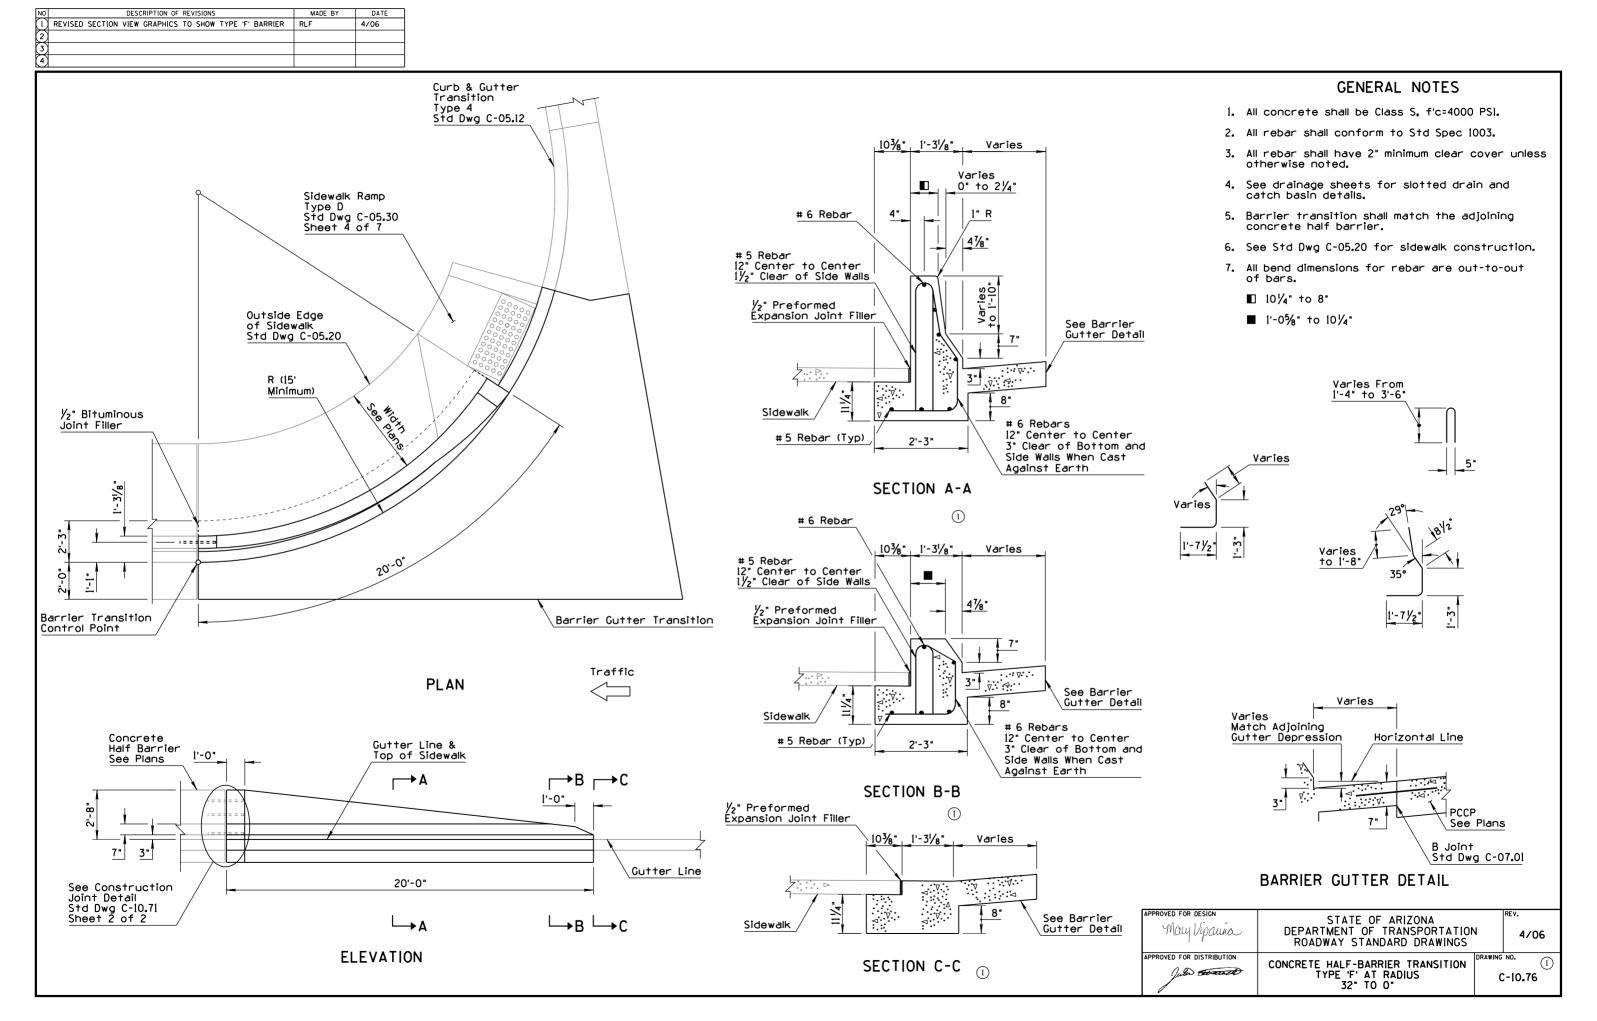

NO DESCRIPTION OF REVISIONS MADE BY DATE  1 RENAMED STD DWG FROM C-10,06 AND REVISED TITLE RLF 9/04  2 MODIFIED REFERENCE RLF 4/06  3 4		
		GENERAL NOTES
		<ol> <li>See plans and barrier summary sheets for location and type of guardrail and end treatments. Timber post Installation shown.</li> </ol>
Gutter Width Varies	Gutter Width Varies 2'-6" or 4'-6" (Typ) See Plans	2. See Std Dwgs C-05.10, 05.12, 10.01 and 10.02 for dimensions and details not shown.
	ent Width PCC Pavemen:	3. Type B guardrail installation shown. For Type A guardrail installation, use Type D-1 Curb and Gutter instead of the Type D-2 Curb and Gutter shown.
Hinge Point  Curb & Gutter 2½" x 5" Lip Curb See Std Dwg C-10.30 2 Sheet 1 of 2		4. See plans for type and location of drainage facilities.
Slope  See Std Dwg C-10.30  Sheet 1 of 2	Slope  O.01 '/ft  O.01 '/ft	5. Bituminous joint filler (½") shall be placed when the curb & gutter or concrete widening abuts slotted drains, catch basins, dados, barrier, etc. Scored joints, 2" in depth, shall be placed to match adjacent joints in PCCP or at 15' intervals when adjacent to AC or continuously reinforced concrete pavement.
Subgrade	Optional Construction Joint	◑ To Top of W-Beam Guardrail
Optional Construction Joint	Type B, C or Ci Variable Width Gutter Depress See Std Dwg C-	Gutter ssion Varies
SECTION A-A	SECTION B-B	
② 		
Concrete Barrier Transition, Type 2 Std Dwg C-10.75 Sheet 2 of 2		Length Varies See Appropriate End Treatment Detail
	Curb & Gutter Transition	→ B Guardrail
Curb & Gutter Transition, Type 5 Std Dwg C-05.12	② Concrete Half-	Guardrail End Terminal See Plans Detail
Concrete Half Barrier	Concrete Half- Barrier Transition Std Dwg C-10.74  Hinge Point	
Curb & Gutter Type B, C or C1 Std Dwg C-05.10		
		2'
Lip of Gutter	Guardrail Transition Thrie-beam to Concrete Half Barrier Std Dwg C-10.30  Curb & Gutter Type B, C or C1 Variable-Width ( Std Dwg C-05.10	Curb & Gutter Type B, C or Cl Std Dwg C-05.10  Gutter Flowline
	\\\\\\\\\\\\\\\\\\\\\\\\\\\\\\\\\\\\\\	<u>Garter Flowline</u>
Edge of Traffic Lane Concrete Gutter	Payment Limit Variable-Width See Appropriate End Tr	ts for Gutter
Curb 8 S†d Dw	Gutter g C-10.30	<del></del>
Sheet	of 2  PLAN  Traffic	
		APPROVED FOR DESIGN C.T.A.T.E. O.E. A.D.I.Z.O.N.A. REV.
		May Vipaura DEPARTMENT OF TRANSPORTATION ROADWAY STANDARD DRAWINGS 4/06
		APPROVED FOR DISTRIBUTION  CONCRETE HALF-BARRIER TRANSITION  END TERMINAL  C-10.77  CURB AND GUTTER  C-10.77

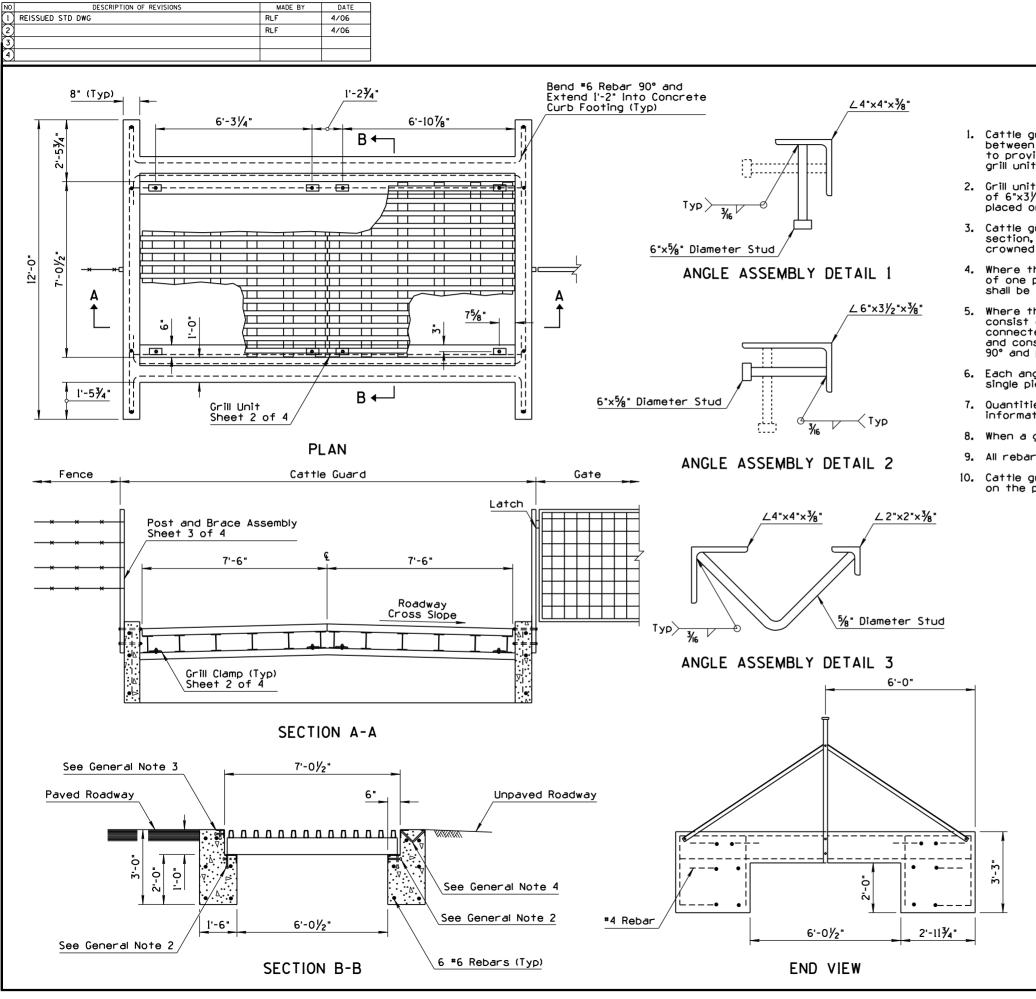



#### **GENERAL NOTES**


- 1. Cattle guard shall include two (2) clamps per Sheet 4 at each gap between two (2) grill units, one at each end. Clamps shall be adjusted to provide a  $\frac{1}{4}$ -inch, plus or minus  $\frac{1}{16}$ -inch gap between adjacent grill units.
- 2. Grill units shall be set on an angle iron assembly consisting of one piece of  $6"x3\frac{1}{2}"x\frac{3}{8}"$  angle iron and studs with a head. The studs shall be placed on 1'-0" alternate centers. See Angle Assembly Detail 2.
- 3. Cattle guard shall be sloped to conform to the roadway grade and cross-section, except that where an odd number of grill units is specified in a crowned roadway, the center grill unit shall have a level cross slope.
- 4. Where the adjacent roadway is paved, an angle iron assembly shall consist of one piece of 4"x4"x%" angle iron and studs with a head. The studs shall be placed on 1'-0" alternate centers. See Angle Assembly Detail 1.
- 5. Where the adjacent roadway is unpaved, an angle iron assembly shall consist of one  $4"x4"x\frac{3}{8}"$  angle iron, one  $2"x2"x\frac{3}{8}"$  angle iron, and connected with studs. The assembly shall be crowned at the centerline and constructed with a bevel cut and welded. The studs shall be bent 90° and placed on 1'-0" centers. See Angle Assembly Detail 3.
- Each angle iron and angle iron assembly shall be fabricated to form a single piece for the full length of the cattle guard.
- Quantities shown for concrete and rebar are approximations for informational purposes only.
- 8. When a gate is to be installed, it shall be called out on the plans.
- 9. All rebar shall have a minimum cover of 3", or as shown on the plans.
- Cattle guard beams shall be HS-20 loading unless otherwise shown on the plans.

UNIT TABLE				
Roadway Width (ft)		Concrete (Cu Yd)	Rebar (Lbs)	
12	2	5.8	175	
16	3	8.0	240	
20	4	10.3	310	
28	5	12.5	375	
34	6	14.7	445	
36	6	14.7	445	
38	7	16.9	510	
40	7	16.9	510	


May Vipauña	STATE OF ARIZONA DEPARTMENT OF TRANSPORTATION ROADWAY STANDARD DRAWINGS	4/06
APPROVED FOR DISTRIBUTION  Julio Connection	ROADWAY CATTLE GUARD	C-11.10

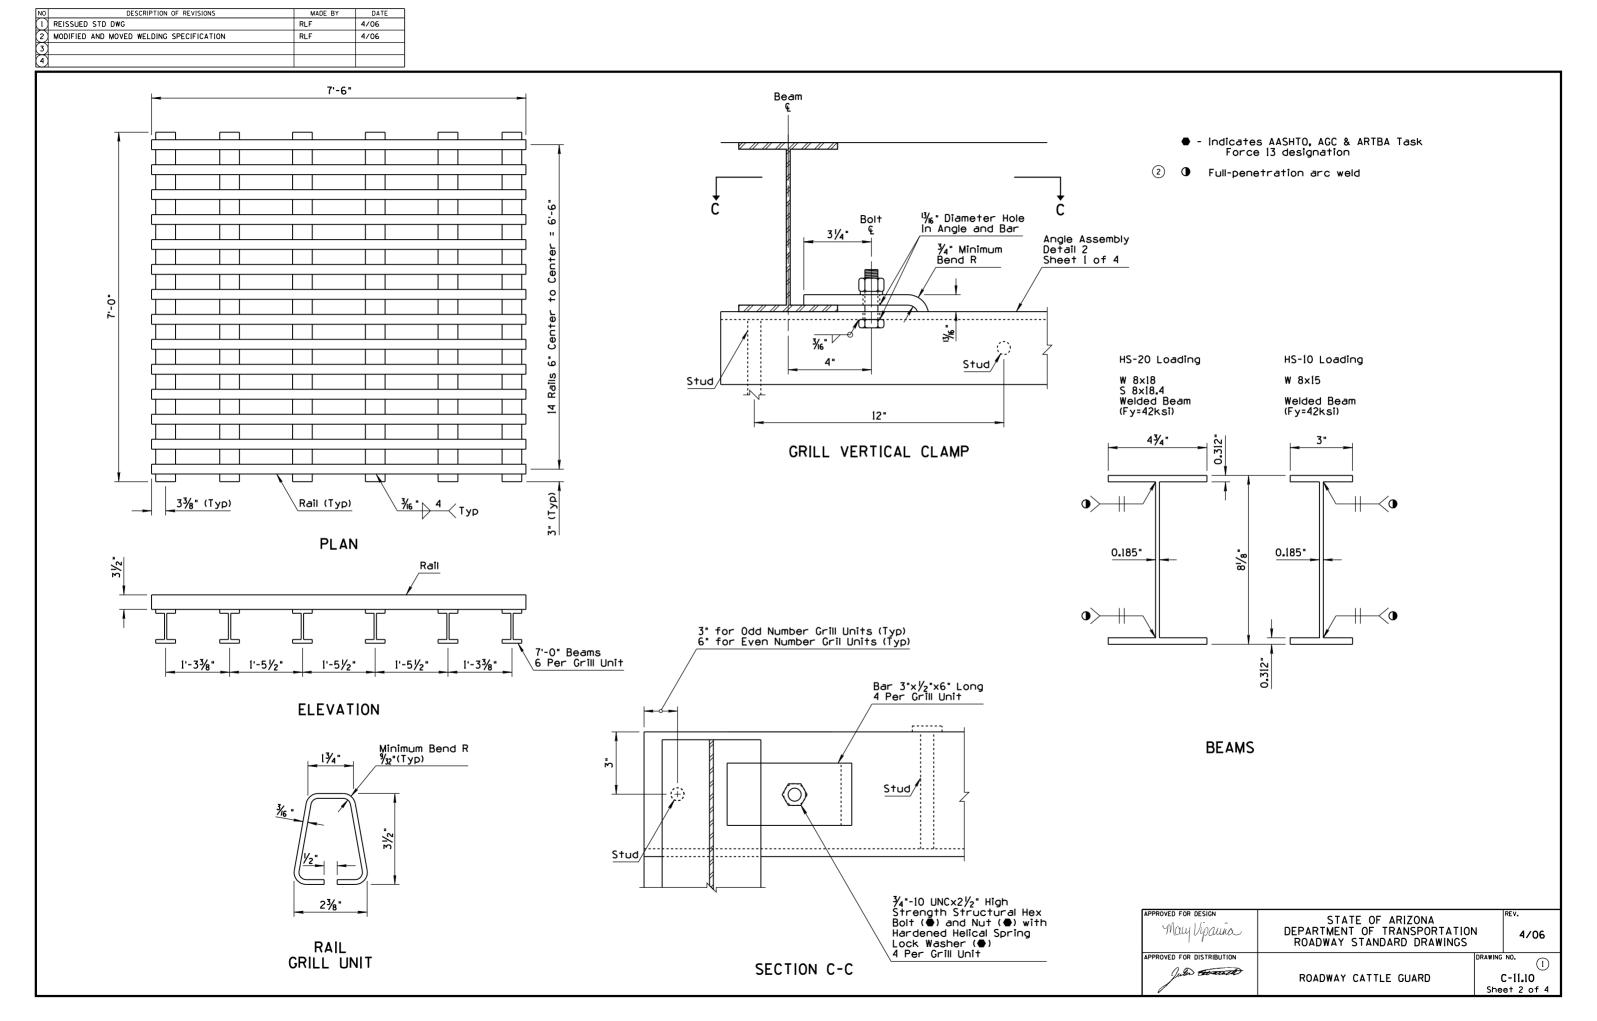

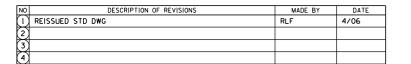


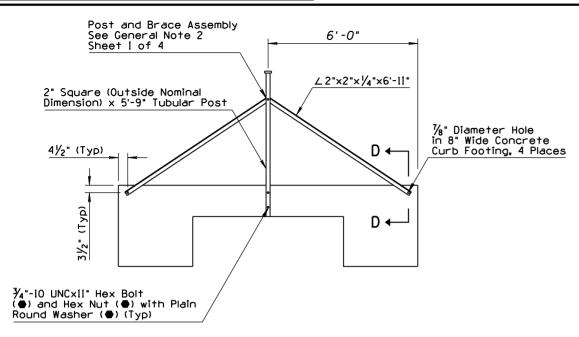

#### END VIEW

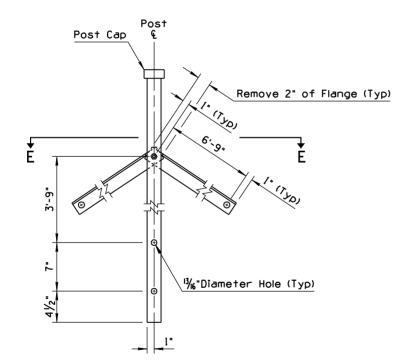


POST AND BRACE ASSEMBLY

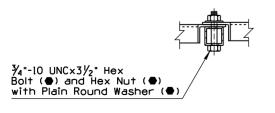


SECTION E-E

#### GENERAL NOTES

- Material for shoulder transition shall be placed to the finished roadway elevation for the entire length of the transition. When the roadway is paved, aggregate subbase or AB shall be used. When the roadway is unpaved, a material equivalent to the existing roadway shall be used.
- On steeper grades, the post shall be installed plumb to align with adjacent fencing. The brace assembly may be modified as necessary to support the post.
- Indicates AASHTO, AGC & ARTBA Task Force 13 designation

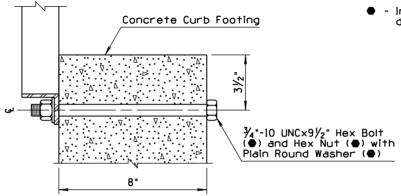



SECTION D-D

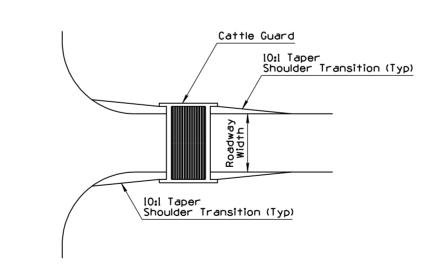

SHOULDER TRANSITION AT CATTLE GUARDS

AP	May Vipauña	STATE OF ARIZONA DEPARTMENT OF TRANSPORTATION ROADWAY STANDARD DRAWINGS	4/06
AP	PROVED FOR DISTRIBUTION	DRAWIN	G NO. (1)
	Julio toward	ROADWAY CATTLE GUARD	C-11.10 eet 3 of 4

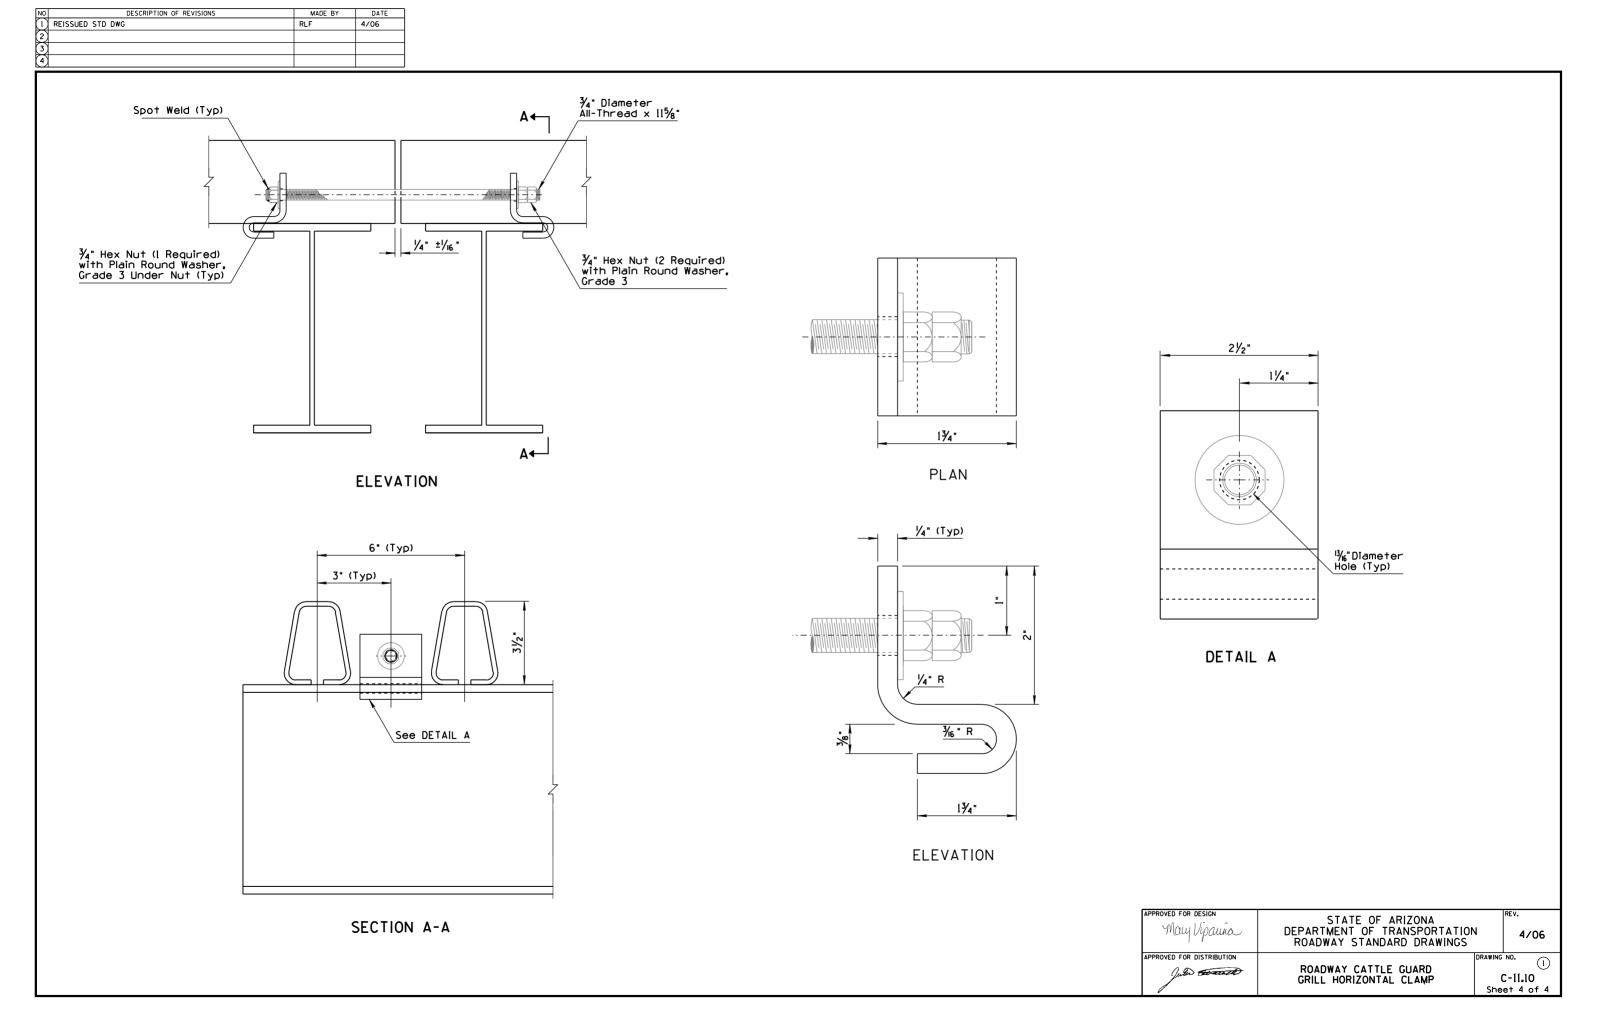

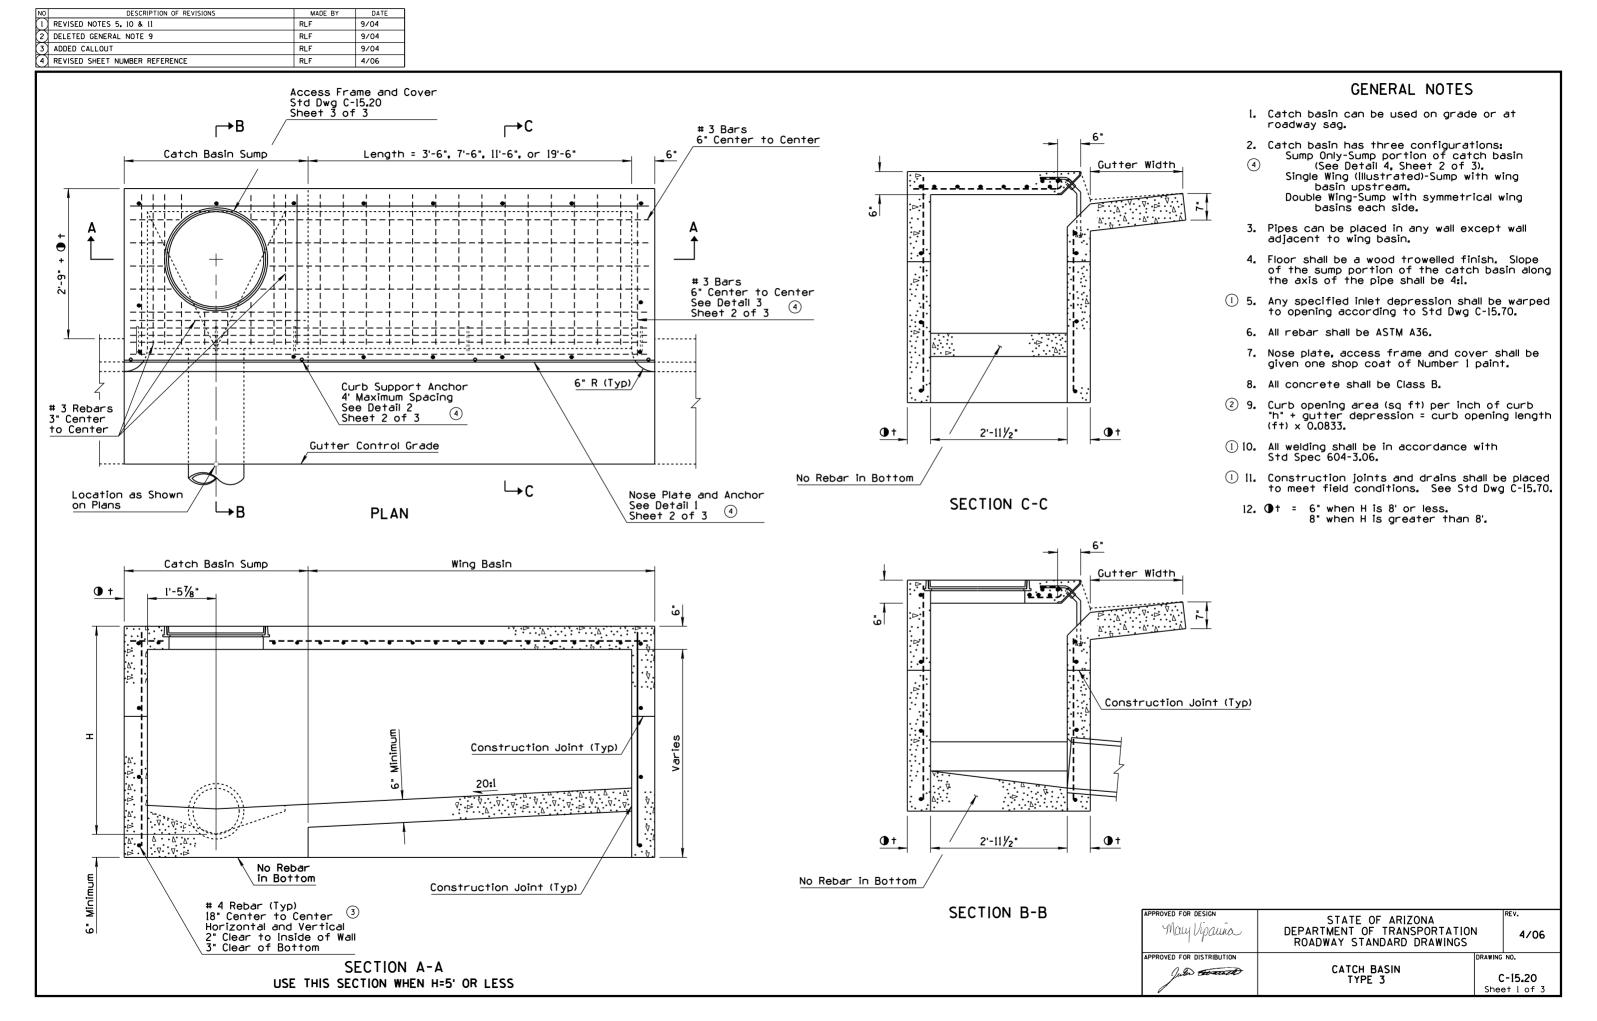

NO	DESCRIPTION OF REVISIONS	MADE BY	DATE
	REVISED CONCRETE ANCHOR STUD LENGTH	RLF	9/04
2	REARRANGED GENERAL NOTES	RLF	9/04
3	REVISED WELD SIZE NOTATIONS ON DRAWING	RLF	4/06
$\overline{A}$			

12"

∢

3%"x6" Concrete Anchor Studs

(Typ)

24"


⟨Тур

Horizontal Line

Type C - 251/16"

Type B - 251/8"

₽∫

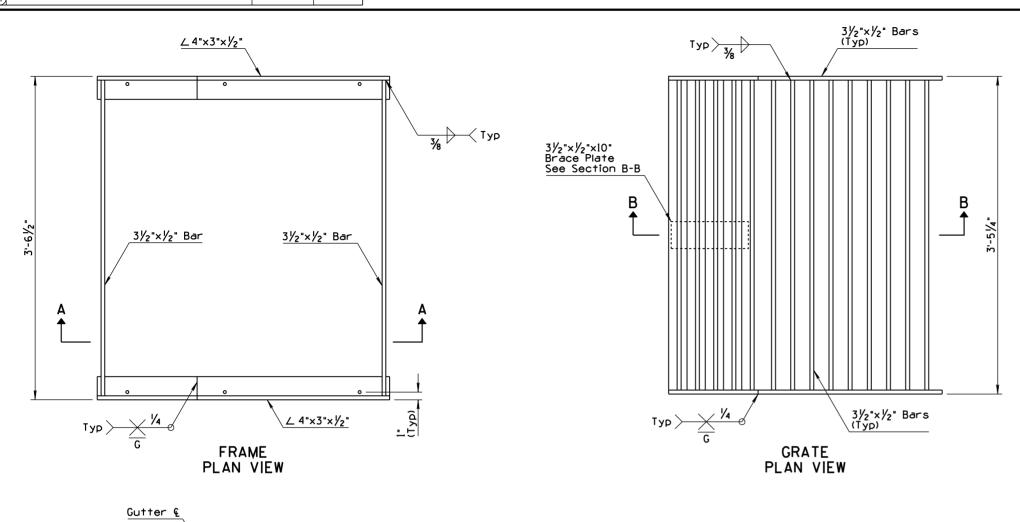




- All structural steel shall be in accordance with ASTM A36.
- 2. All welding shall be in accordance with Std Spec 604-3.06.
- The completed grate assembly (frame & grate) shall be given two shop coats of Number 1 paint.

#### NOTE TO DESIGNERS

Grate design is not suitable for locations subject to bicycle traffic.

GRATE AND FRAME DIMENSIONS								
	Curb Height		Catch	Basin Frame	Catch	Basin Grate		
Туре	(IU)	(Ft-In)	A (In)	A	C (In)	∢		
В	6	2-6	13 <sup>15</sup> / <sub>16</sub>	26°-57'-40"	121/16	26°-57'-40"		
С	3	2-6	13%	15°-37'-45"	11 1/8	15°-37'-45"		

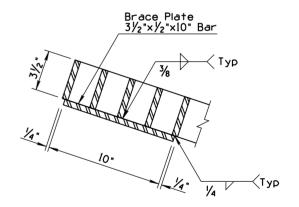


BRACE PLATE DETAIL


SECTION A-A SECTION B-B


May Vipauña	STATE OF ARIZONA DEPARTMENT OF TRANSPORTATION ROADWAY STANDARD DRAWINGS	4/06
APPROVED FOR DISTRIBUTION	C	RAWING NO.
Julio toward	FREEWAY CATCH BASIN DETAILS	C-15.91 Sheet 2 of 2

NO	DESCRIPTION OF REVISIONS	MADE BY	DATE
	REISSUED STANDARD DRAWING	RLF	9/04
2	DELETED GENERAL NOTE	RLF	4/06
(3)	REVISED WELD SIZE NOTATIONS ON DRAWING	RLF	4/06
4			

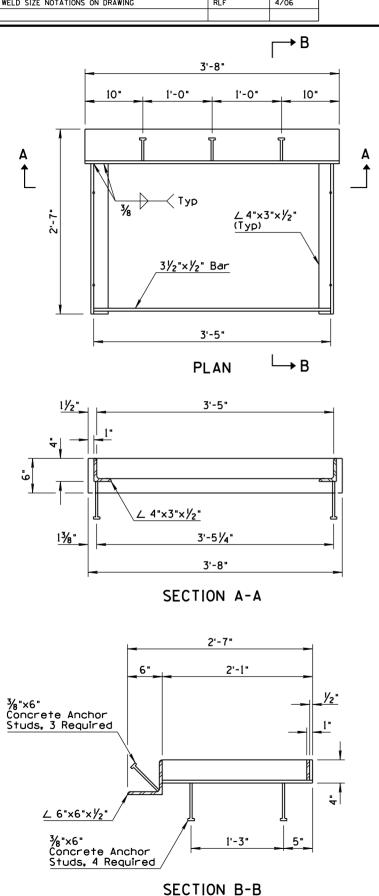


FRAME

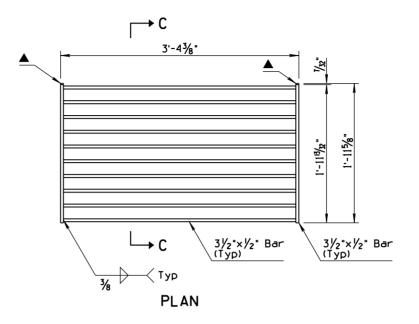

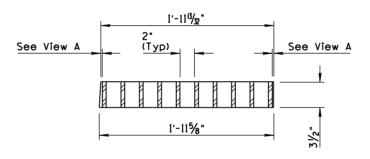

SECTION C-C GRATE

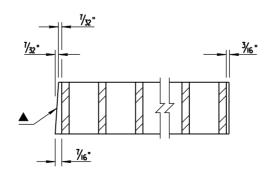

View A

#### GENERAL NOTES

- 1. All welding shall be in accordance with Std Spec 604-3.06.
- 2. Grate opening for grate shown is 4.75 Sq Ft.

▲ Beveled side of grate toward barrier

(2)

#### NOTE TO DESIGNERS

Grate design shown is not suitable for locations subject to bicycle traffic. Use \$td Dwg C-15.50 grate with \$td Dwg C-15.92 frame (Sheet 2 of 2) for locations with bicycle traffic.

