



STATE OF ARIZONA
 DEPARTMENT OF TRANSPORTATION
 INFRASTRUCTURE DELIVERY AND OPERATIONS DIVISION

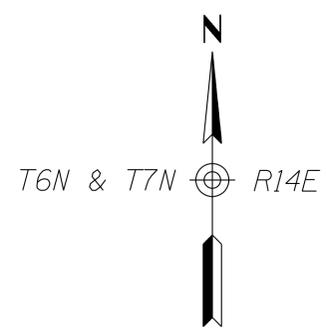

PROJECT PLANS
STATE HIGHWAY
GLOBE-YOUNG-JCT SR 260 HWY
SR 288

ROCKFALL MITIGATION
 MP 288.80 to MP 289.50

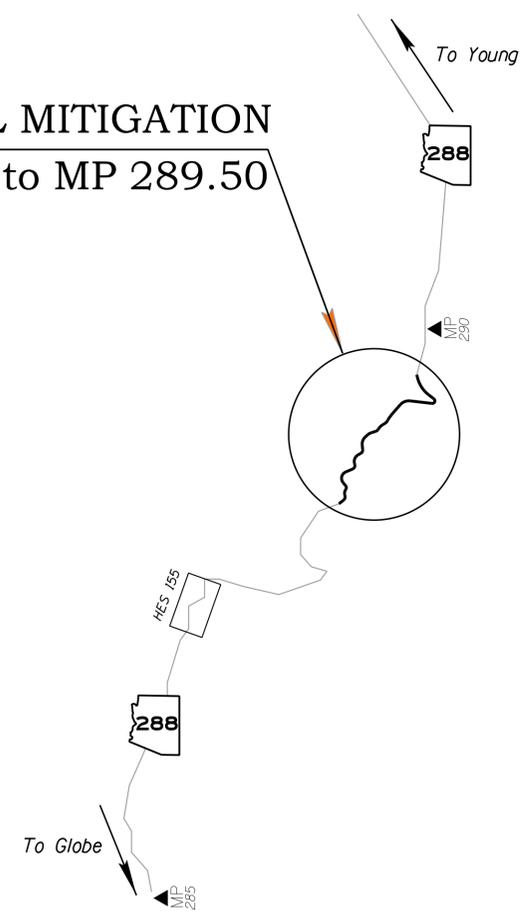

Constructed by:

 Construction Company

 Completion Date
Red-Lines by:

 Construction Administrator Name & Company

 Completion Date
Record Drawing by:

 Record Drawing Designer Name & Company

 Completion Date

CROSS-SECTIONS
SOUTH OF YOUNG
 PROJECT NO. 288 GI 288 H8617 01C
 FEDERAL AID NO. STP-288-A(201)T










ARIZONA DEPARTMENT OF TRANSPORTATION
 INFRASTRUCTURE DELIVERY AND OPERATIONS DIVISION
 DALLAS HAMMIT, P.E., STATE ENGINEER

Record DWG DATA	REC DWG DATE	OF
--------------------	--------------	----

REVISIONS- LOCATION- FINISHED PLANS- SURVEY NO. DATE- LOCATION- FINISHED PLANS- SURVEY NO. DATE- LOCATION- FINISHED PLANS- SURVEY NO. DATE-

F.H.W.A. REGION	STATE	PROJECT NO.	SHEET NO.	TOTAL SHEETS	Record Drawing
9	ARIZ.	288-A(20)1T	2	14	

288 GI 288

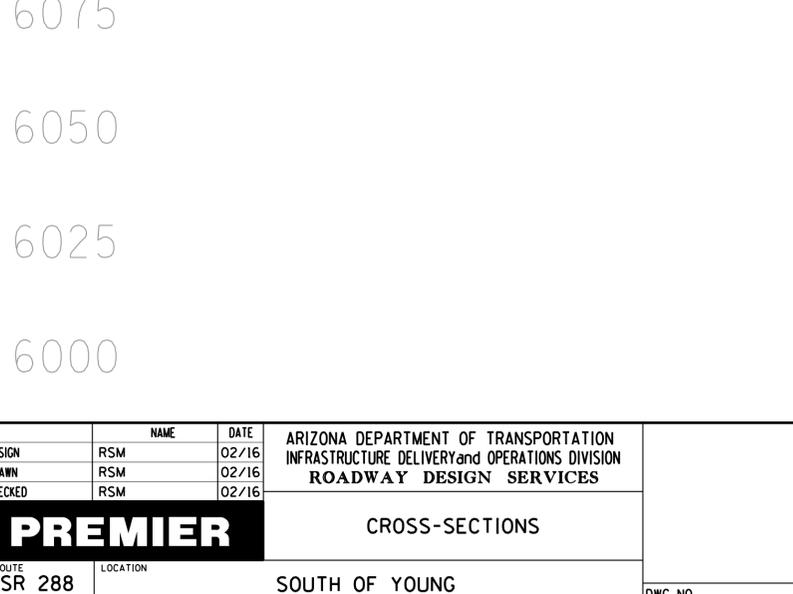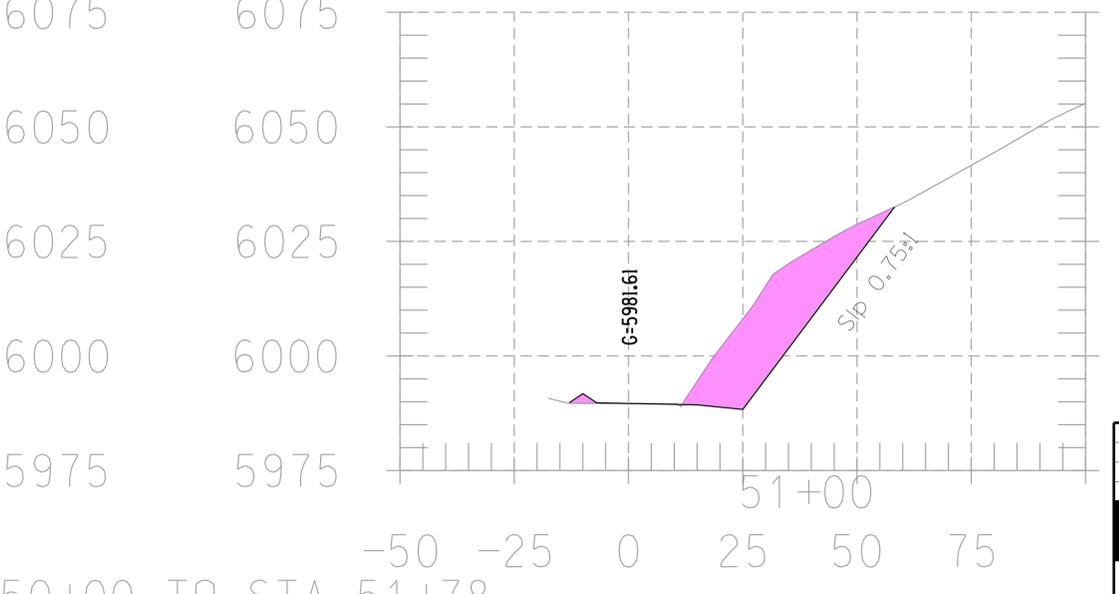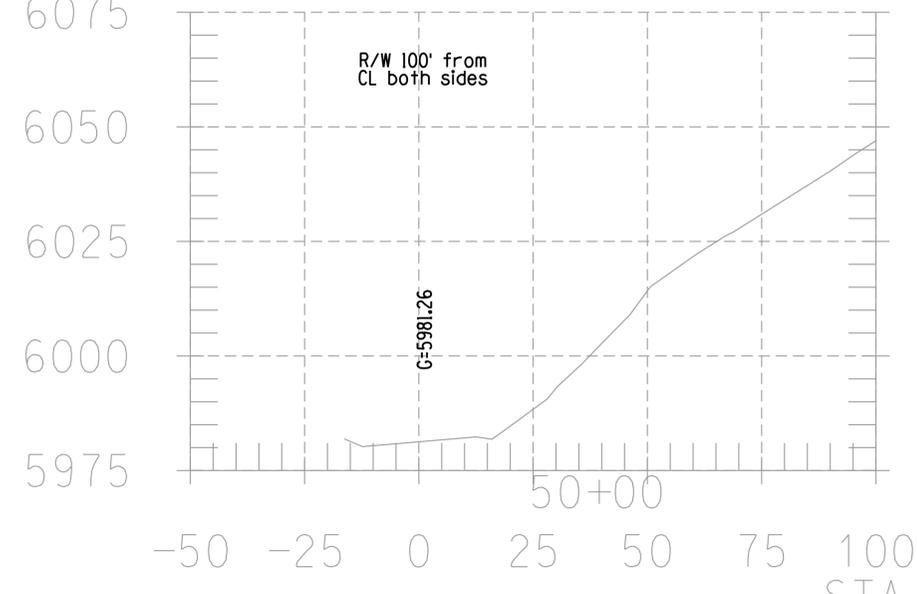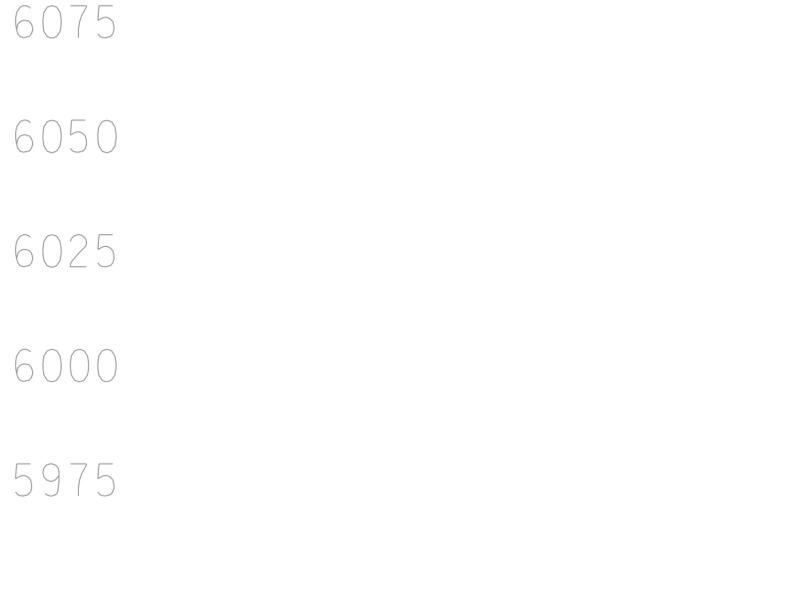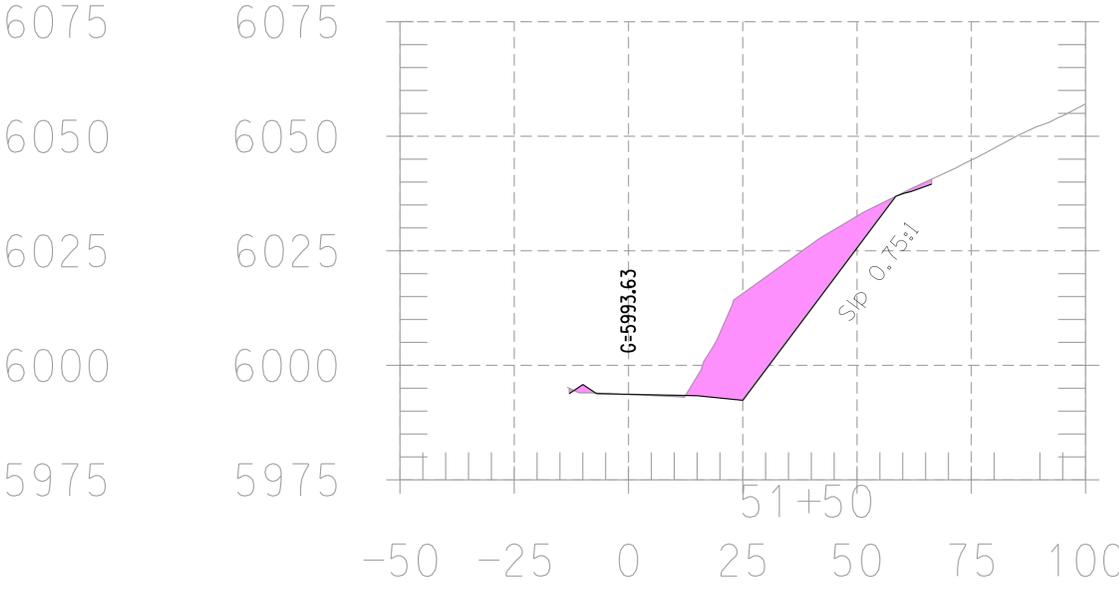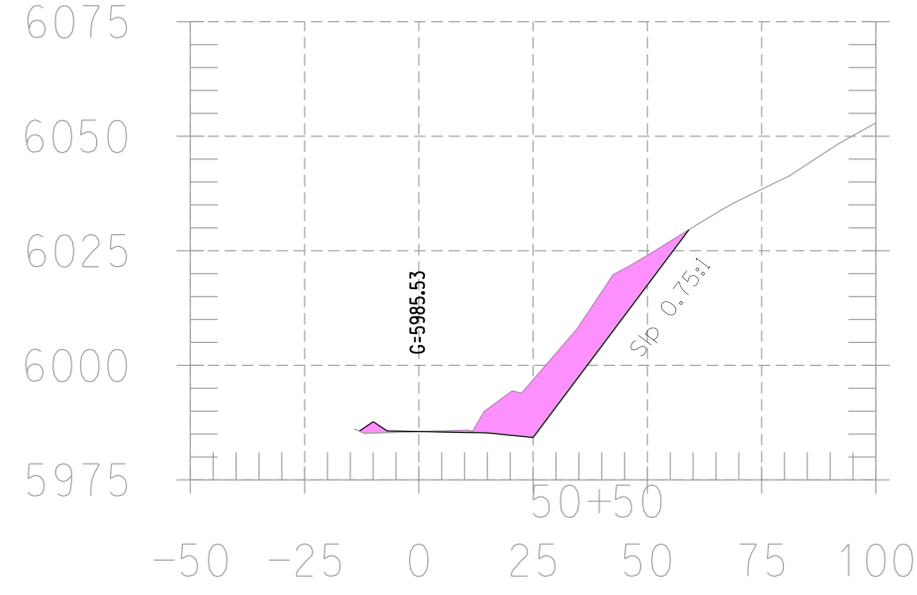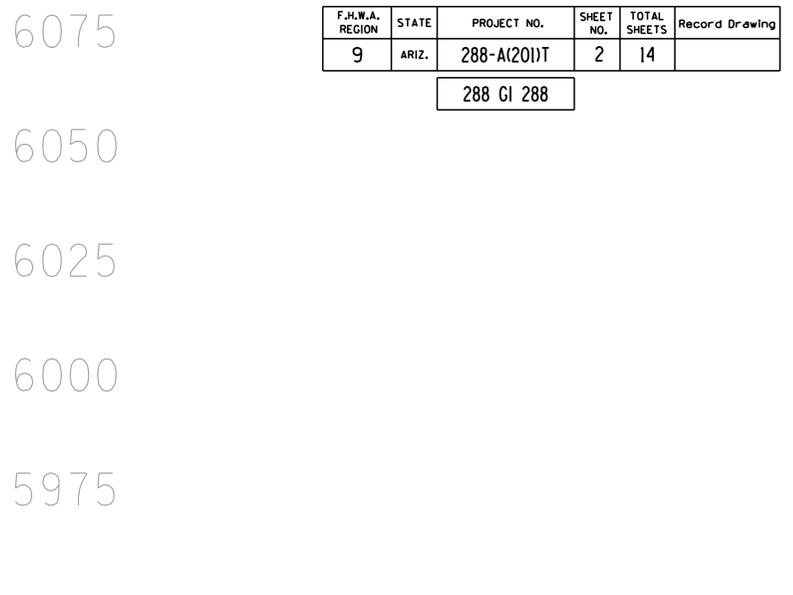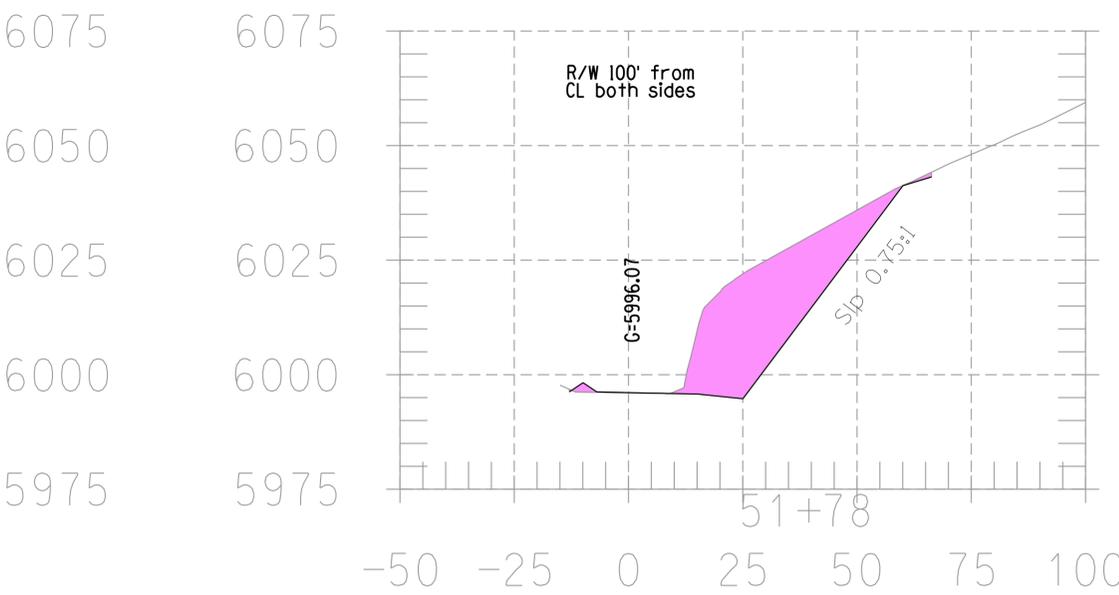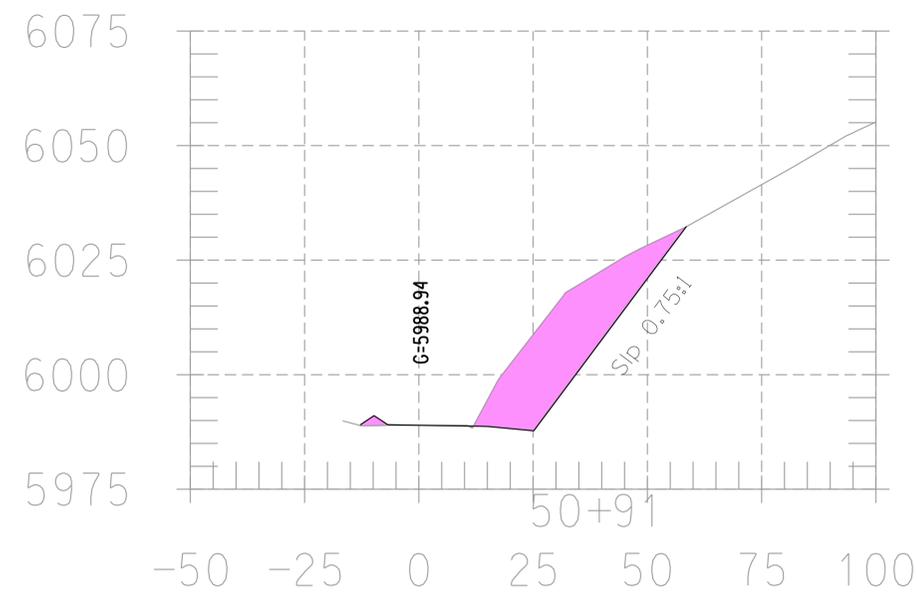



STA. 50+00 TO STA. 51+78

DESIGN	RSM	DATE	02/16	ARIZONA DEPARTMENT OF TRANSPORTATION INFRASTRUCTURE DELIVERY and OPERATIONS DIVISION ROADWAY DESIGN SERVICES
DRAWN	RSM	DATE	02/16	
CHECKED	RSM	DATE	02/16	
PREMIER			CROSS-SECTIONS	
ROUTE	SR 288	LOCATION	SOUTH OF YOUNG	
TRACS NO.	H8617 OIC		288-A(20)1T	DWG NO. <u> </u> OF <u> </u>

F.H.W.A. REGION	STATE	PROJECT NO.	SHEET NO.	TOTAL SHEETS	Record Drawing
9	ARIZ.	288-A(20)T	3	14	

288 GI 288

SURVEY NO. FINISHED PLANS- REVISIONS- LOCATION- DATE- FINISHED PLANS- REVISIONS- LOCATION- DATE- FINISHED PLANS- REVISIONS- LOCATION- DATE-

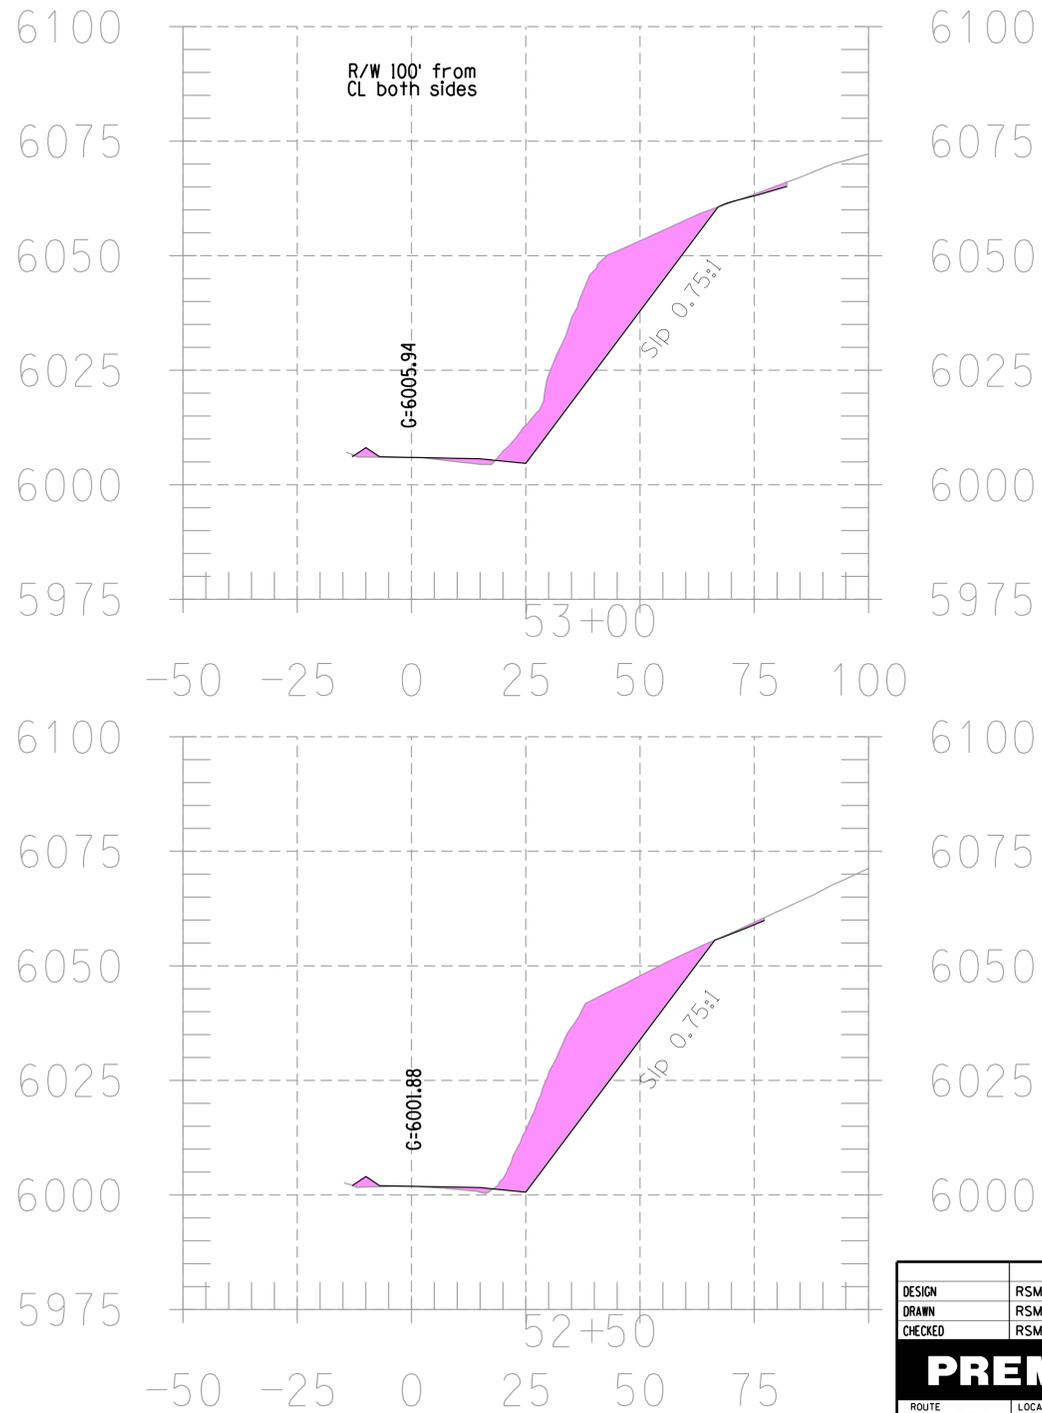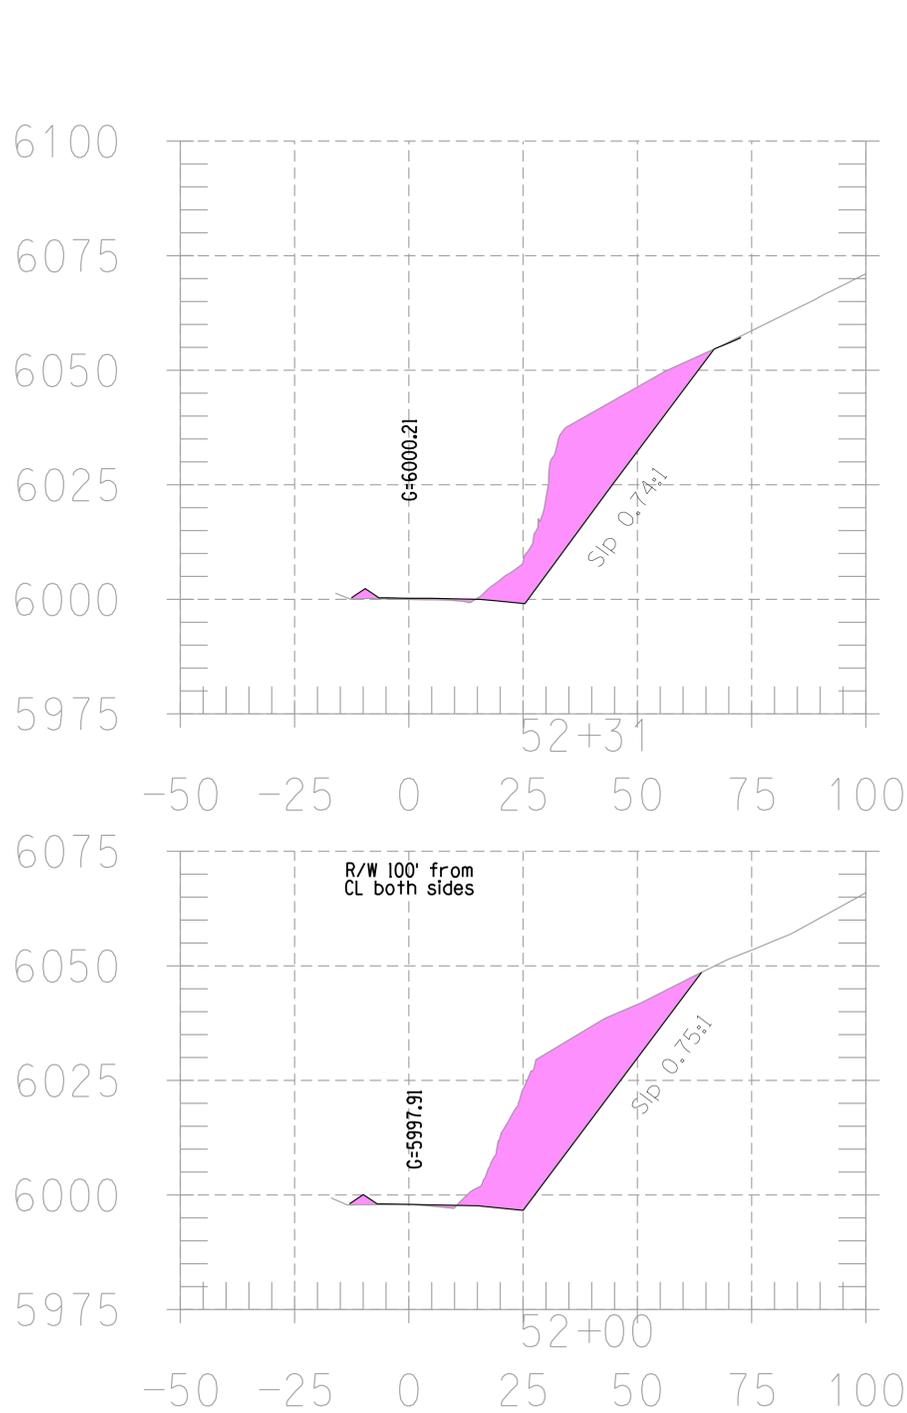






STA. 52+00 TO STA. 53+00

DESIGN	RSM	DATE	02/16	ARIZONA DEPARTMENT OF TRANSPORTATION INFRASTRUCTURE DELIVERY and OPERATIONS DIVISION ROADWAY DESIGN SERVICES
DRAWN	RSM	DATE	02/16	
CHECKED	RSM	DATE	02/16	
PREMIER			CROSS-SECTIONS	
ROUTE	SR 288	LOCATION	SOUTH OF YOUNG	
TRACS NO.	H8617 01C		288-A(20)T	DWG NO. <u> </u> OF <u> </u>

REVISIONS- LOCATION- DATE- SURVEY NO. FINISHED PLANS- DATE- LOCATION- REVISIONS- FINISHED PLANS- SURVEY NO.

F.H.W.A. REGION	STATE	PROJECT NO.	SHEET NO.	TOTAL SHEETS	Record Drawing
9	ARIZ.	288-A(20)T	4	14	

288 GI 288

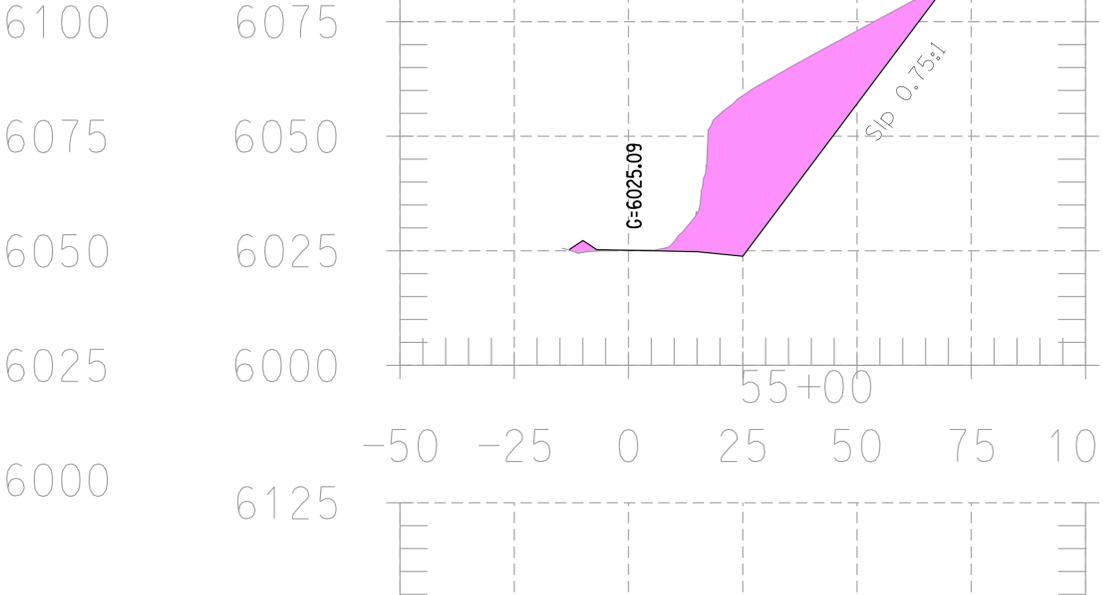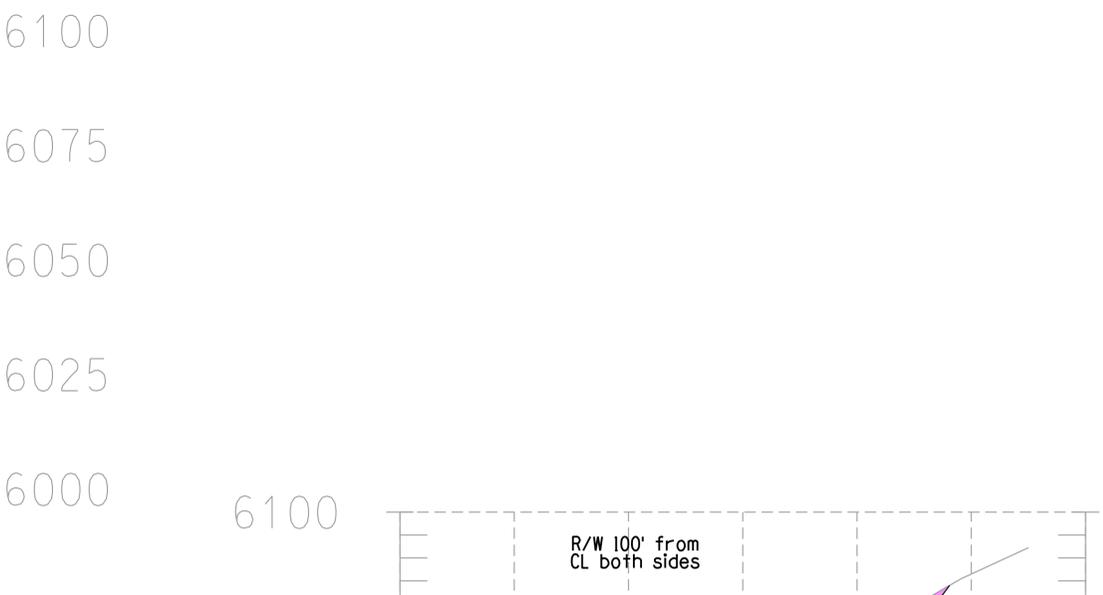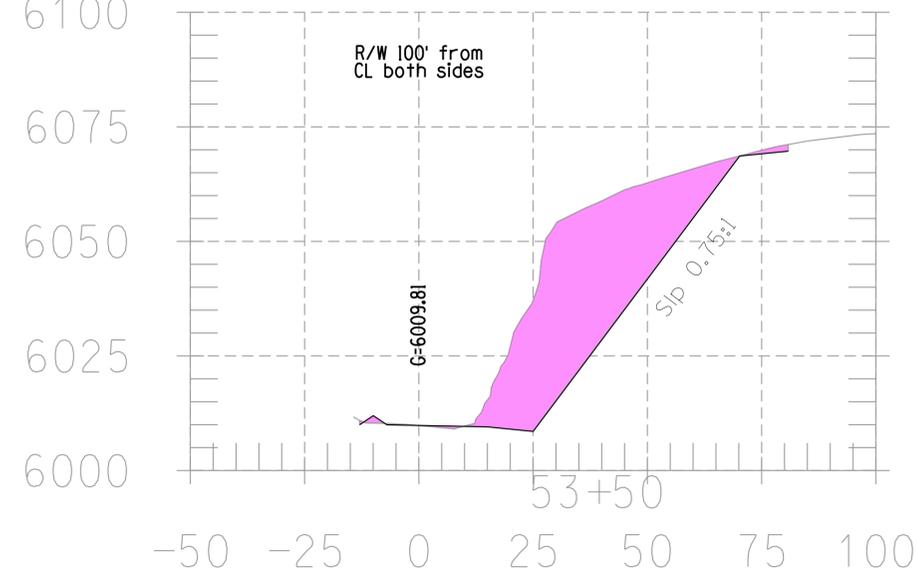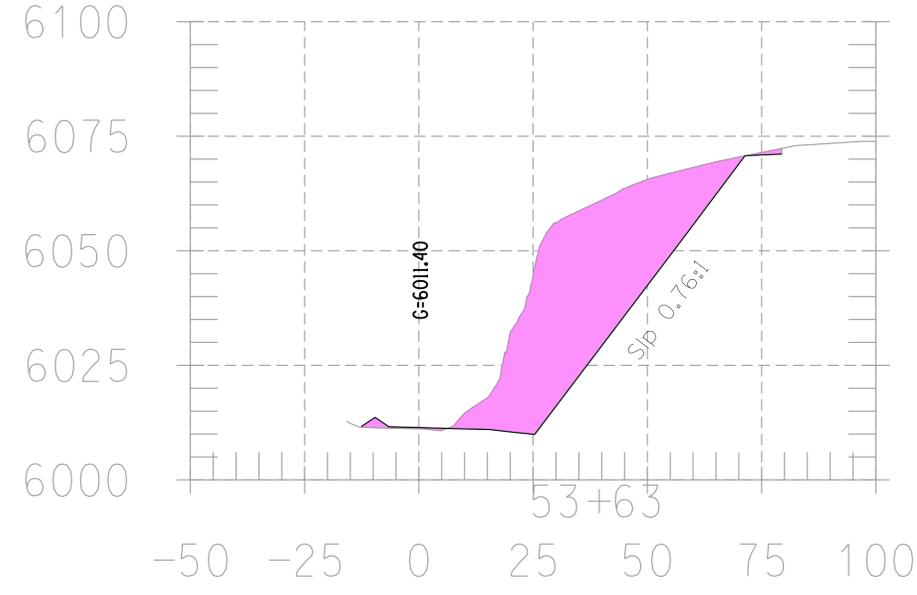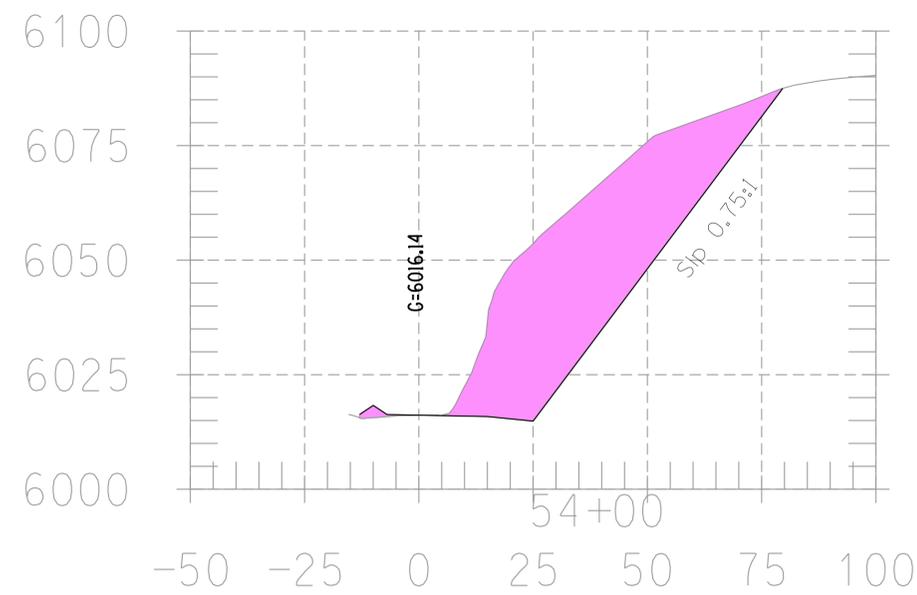



STA. 53+50 TO STA. 55+00

DESIGN	RSM	DATE	02/16	ARIZONA DEPARTMENT OF TRANSPORTATION INFRASTRUCTURE DELIVERY and OPERATIONS DIVISION ROADWAY DESIGN SERVICES
DRAWN	RSM	DATE	02/16	
CHECKED	RSM	DATE	02/16	
PREMIER			CROSS-SECTIONS	
ROUTE	SR 288	LOCATION	SOUTH OF YOUNG	
TRACS NO.	H8617 OIC		288-A(20)T	DWG NO. <u> </u> OF <u> </u>

F.H.W.A. REGION	STATE	PROJECT NO.	SHEET NO.	TOTAL SHEETS	Record Drawing
9	ARIZ.	288-A(20)T	5	14	

288 GI 288

SURVEY NO. FINISHED PLANS- REVISIONS- LOCATION- DATE- SURVEY NO. FINISHED PLANS- REVISIONS- LOCATION- DATE- SURVEY NO. FINISHED PLANS- REVISIONS- LOCATION- DATE-


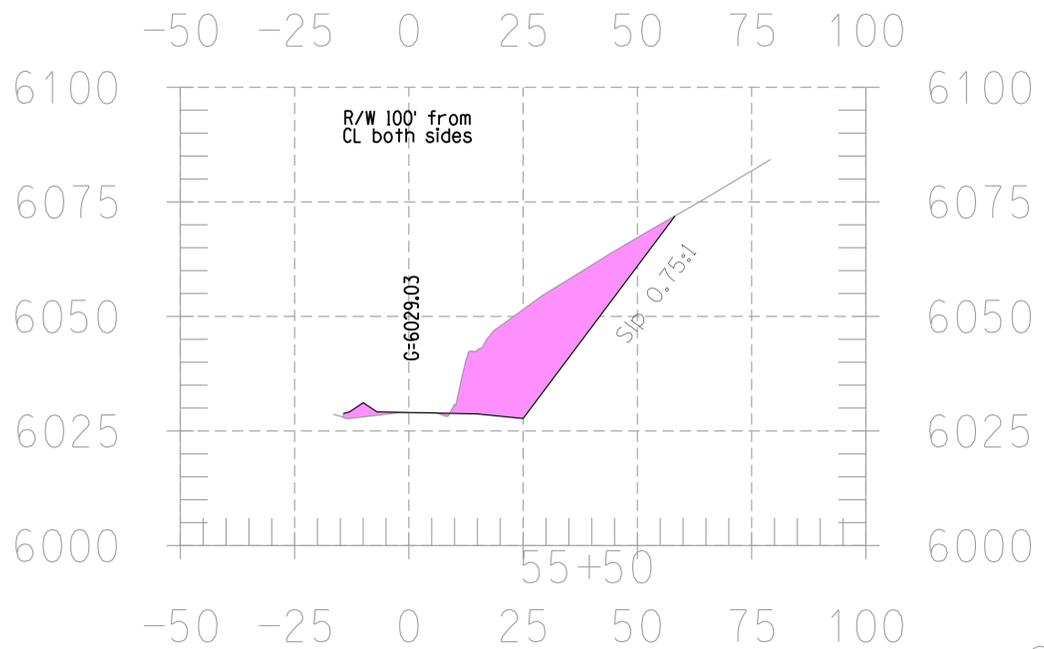
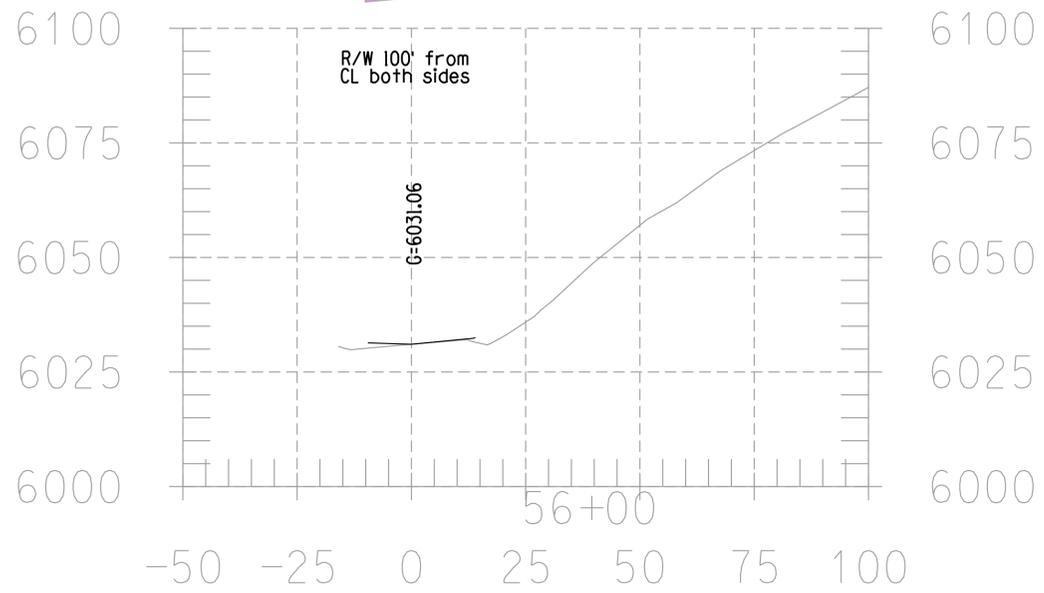


STA. 55+50 TO STA. 56+00

DESIGN	RSM	DATE	02/16	ARIZONA DEPARTMENT OF TRANSPORTATION INFRASTRUCTURE DELIVERY and OPERATIONS DIVISION ROADWAY DESIGN SERVICES
DRAWN	RSM	DATE	02/16	
CHECKED	RSM	DATE	02/16	
PREMIER			CROSS-SECTIONS	
ROUTE	SR 288	LOCATION	SOUTH OF YOUNG	
TRACS NO.	H8617 OIC		288-A(20)T	DWG NO. _____ OF _____

F.H.W.A. REGION	STATE	PROJECT NO.	SHEET NO.	TOTAL SHEETS	Record Drawing
9	ARIZ.	288-A(20)T	6	14	

288 CI 288

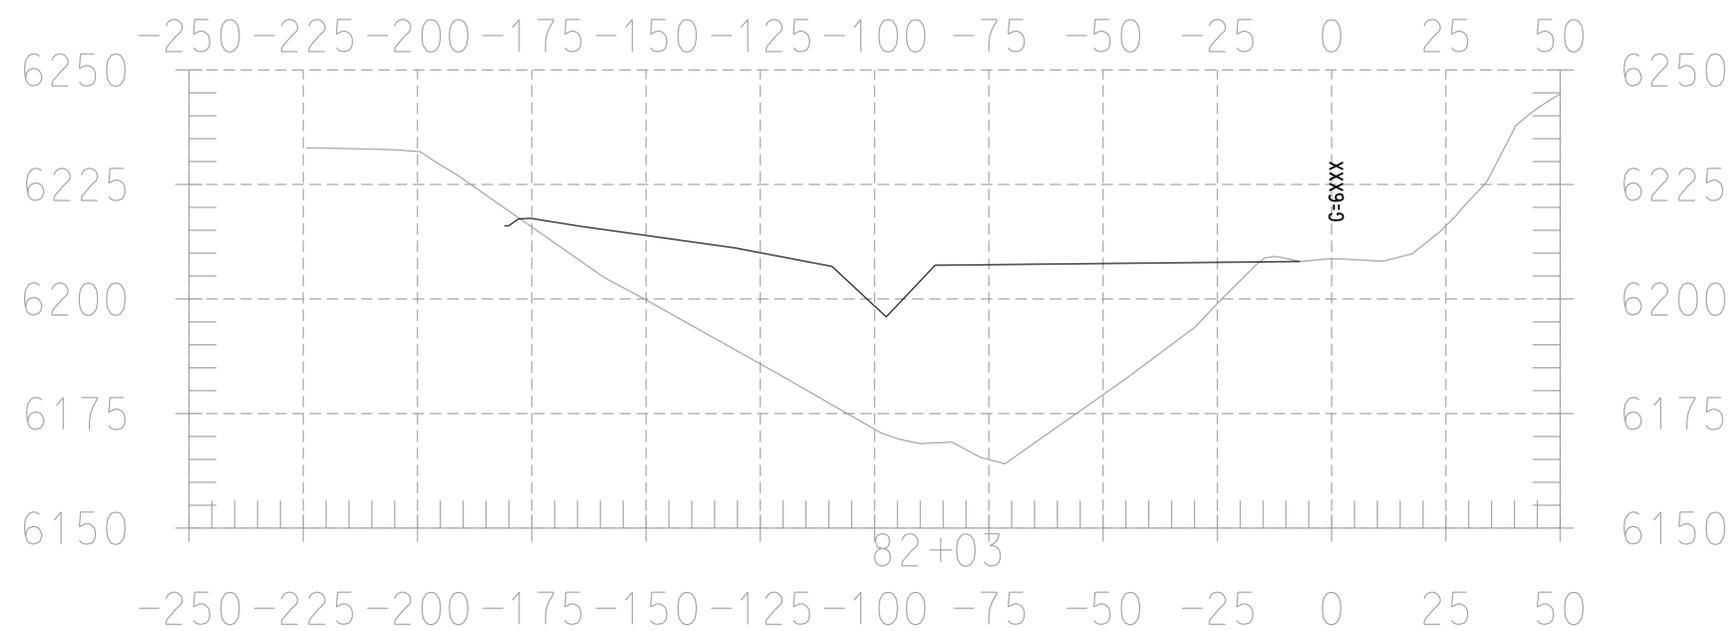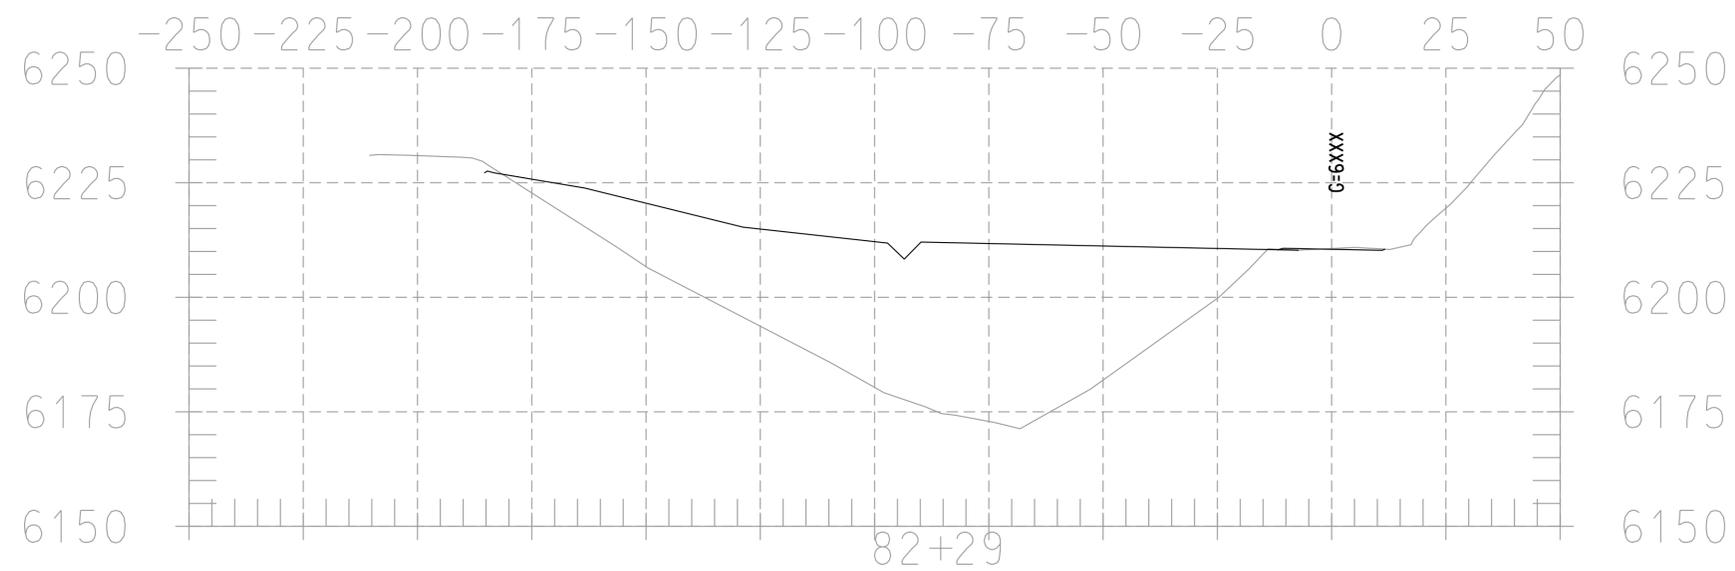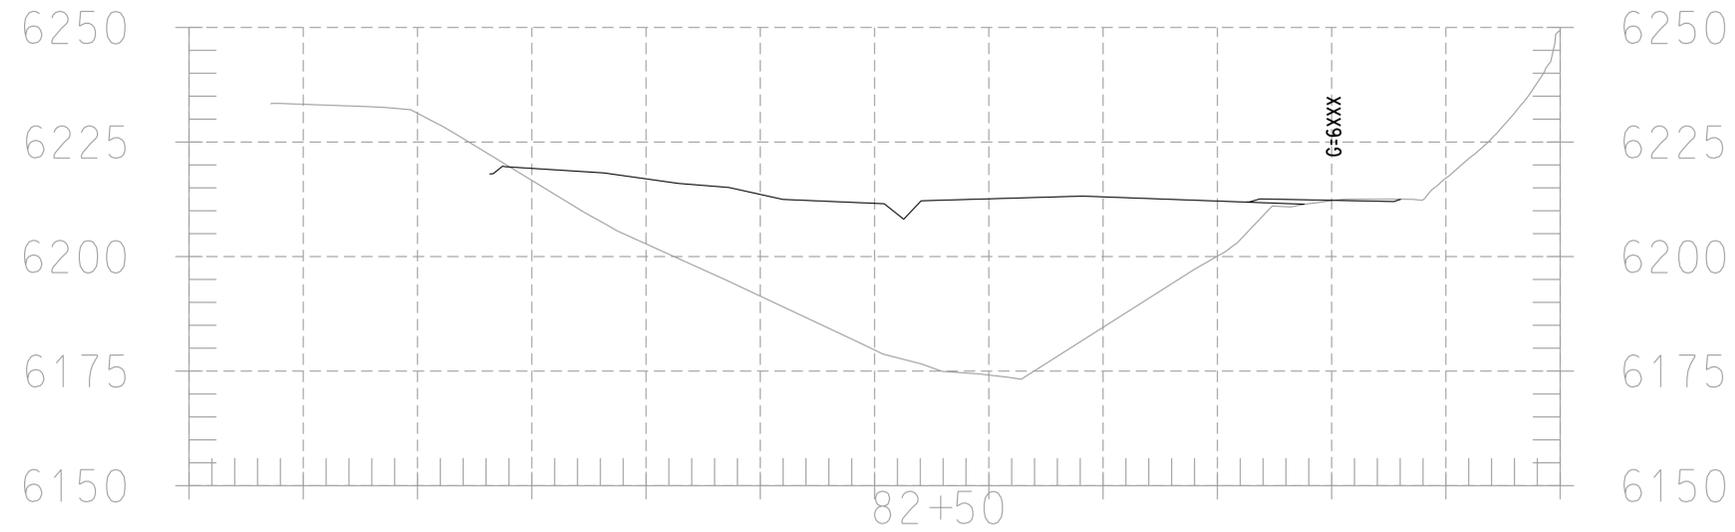




STA. 82+03 TO STA. 82+50

DESIGN	RSM	DATE	02/16	ARIZONA DEPARTMENT OF TRANSPORTATION INFRASTRUCTURE DELIVERY and OPERATIONS DIVISION ROADWAY DESIGN SERVICES
DRAWN	RSM	DATE	02/16	
CHECKED	RM	DATE	02/16	
PREMIER			CROSS-SECTIONS	
ROUTE	SR 288	LOCATION	SOUTH OF YOUNG	
TRACS NO.	H8617 01C		288-A(20)T	DWG NO. <u> </u> OF <u> </u>

SURVEY NO. FINISHED PLANS REVISIONS LOCATION DATE SURVEY NO. FINISHED PLANS REVISIONS LOCATION DATE SURVEY NO. FINISHED PLANS REVISIONS LOCATION DATE

F.H.W.A. REGION	STATE	PROJECT NO.	SHEET NO.	TOTAL SHEETS	Record Drawing
9	ARIZ.	288-A(20)T	7	14	

288 CI 288

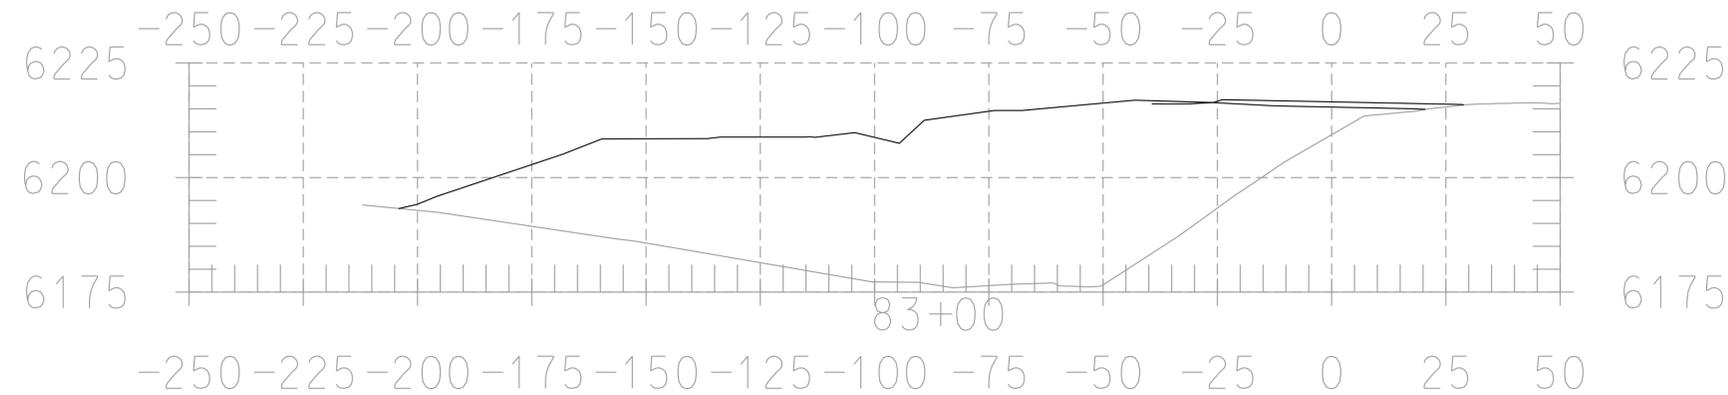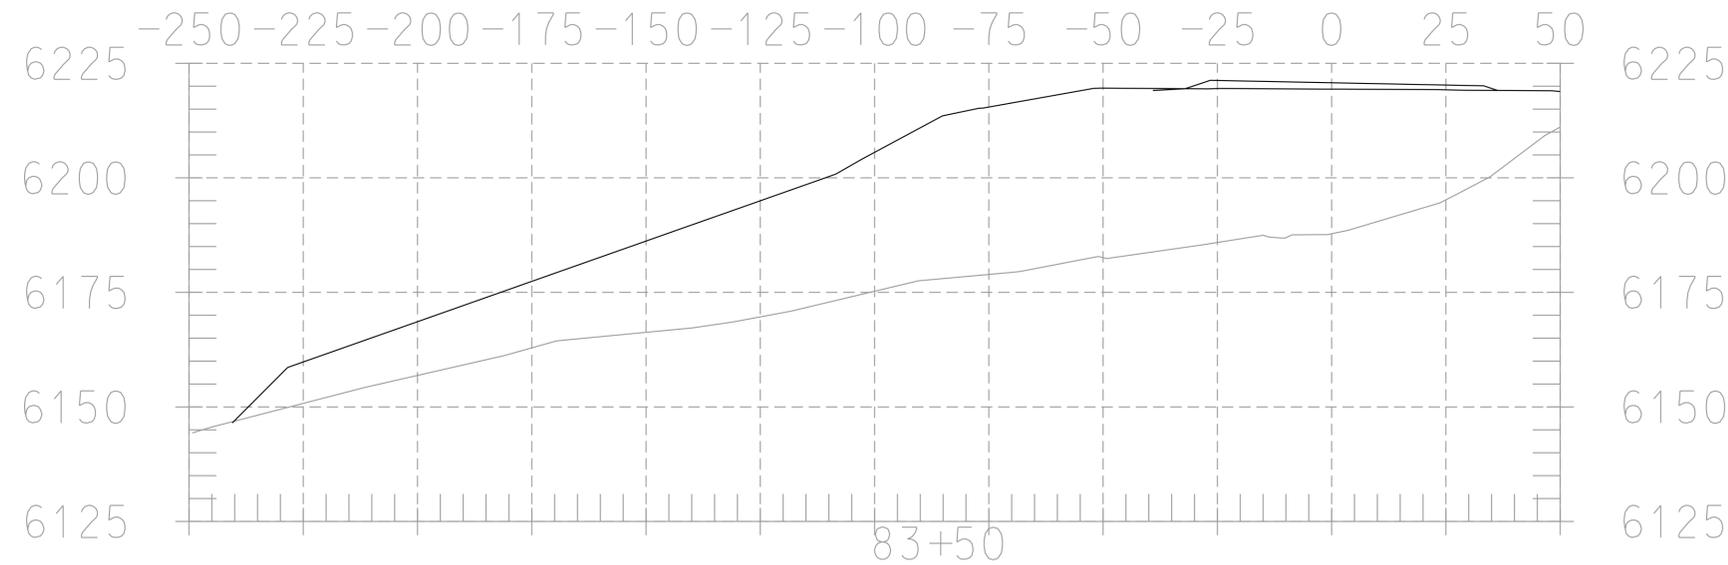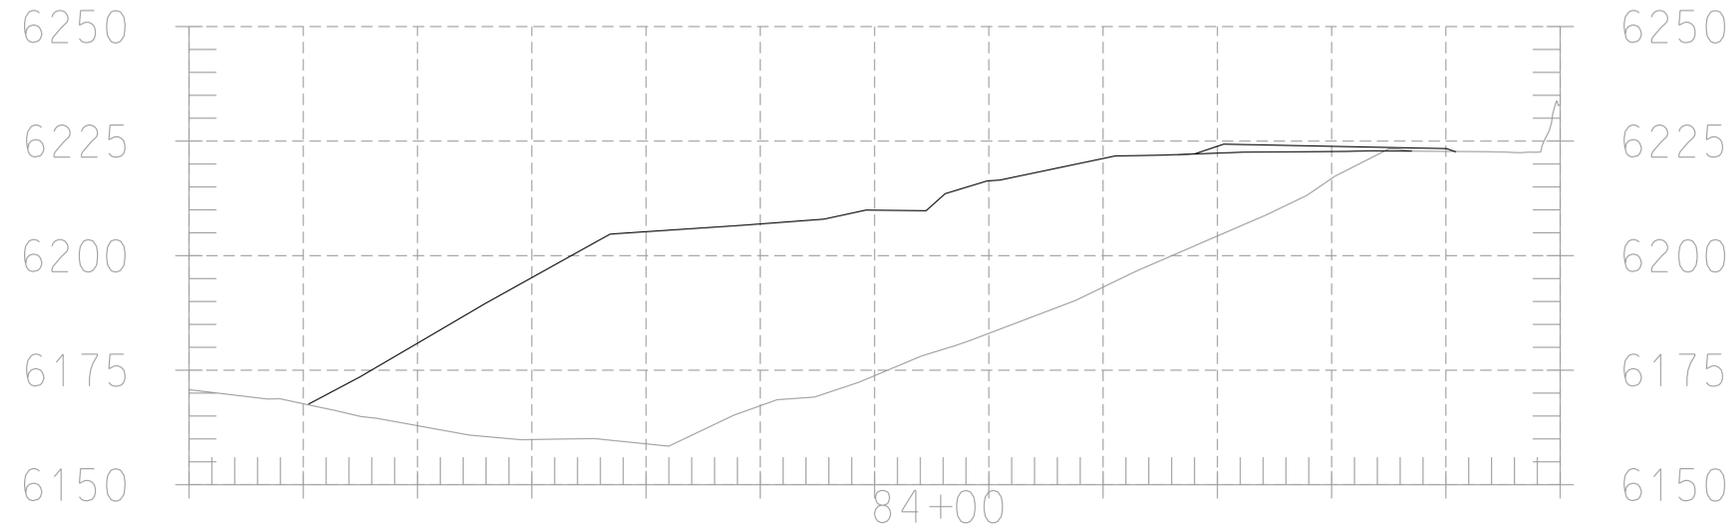




STA. 83+00 TO STA. 84+00

DESIGN	RSM	DATE	02/16	ARIZONA DEPARTMENT OF TRANSPORTATION INFRASTRUCTURE DELIVERY and OPERATIONS DIVISION ROADWAY DESIGN SERVICES
DRAWN	RSM	DATE	02/16	
CHECKED	RM	DATE	02/16	
PREMIER			CROSS-SECTIONS	
ROUTE	SR 288	LOCATION	SOUTH OF YOUNG	
TRACS NO.	H8617 01C		288-A(20)T	DWG NO. <u> </u> OF <u> </u>

SURVEY NO. FINISHED PLANS REVISIONS LOCATION DATE SURVEY NO. FINISHED PLANS REVISIONS LOCATION DATE SURVEY NO. FINISHED PLANS REVISIONS LOCATION DATE

F.H.W.A. REGION	STATE	PROJECT NO.	SHEET NO.	TOTAL SHEETS	Record Drawing
9	ARIZ.	288-A(20)T	8	14	

288 CI 288

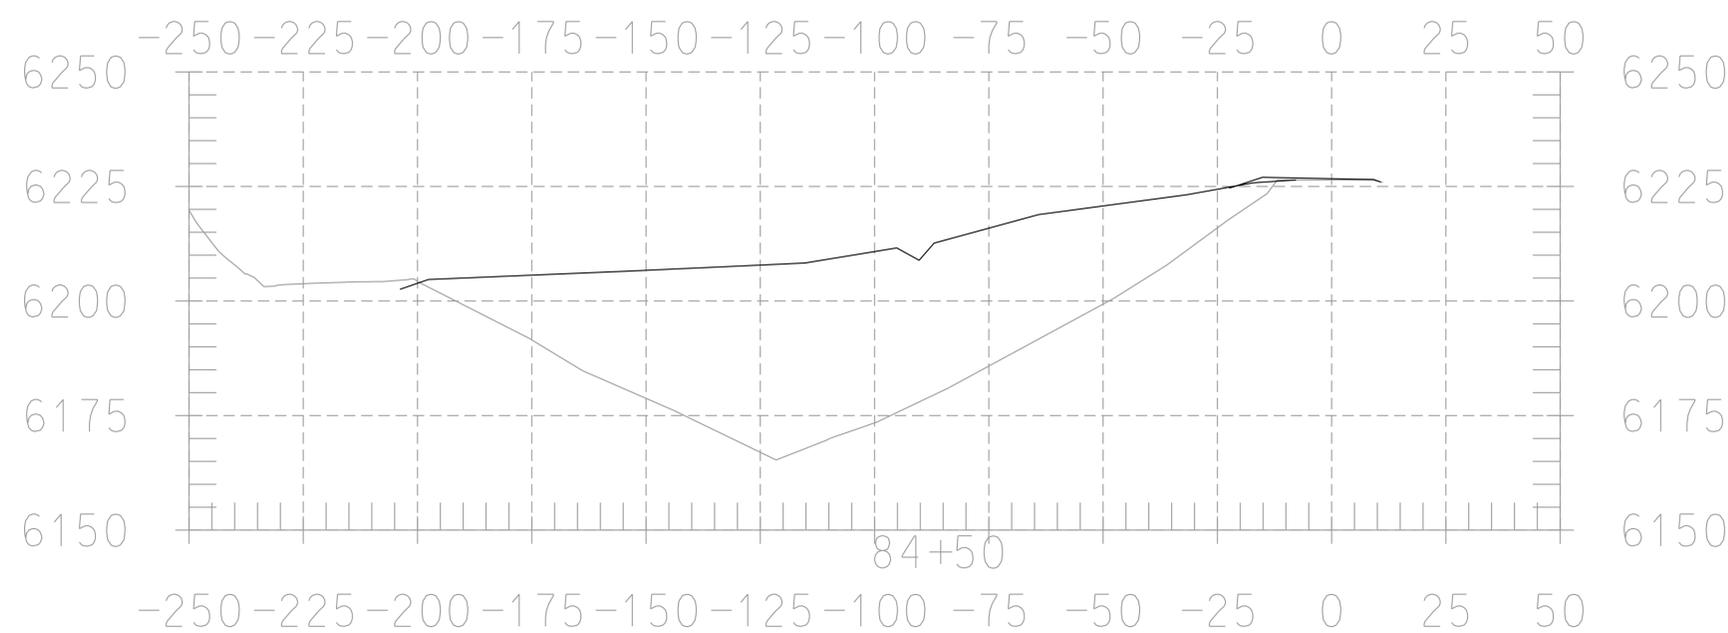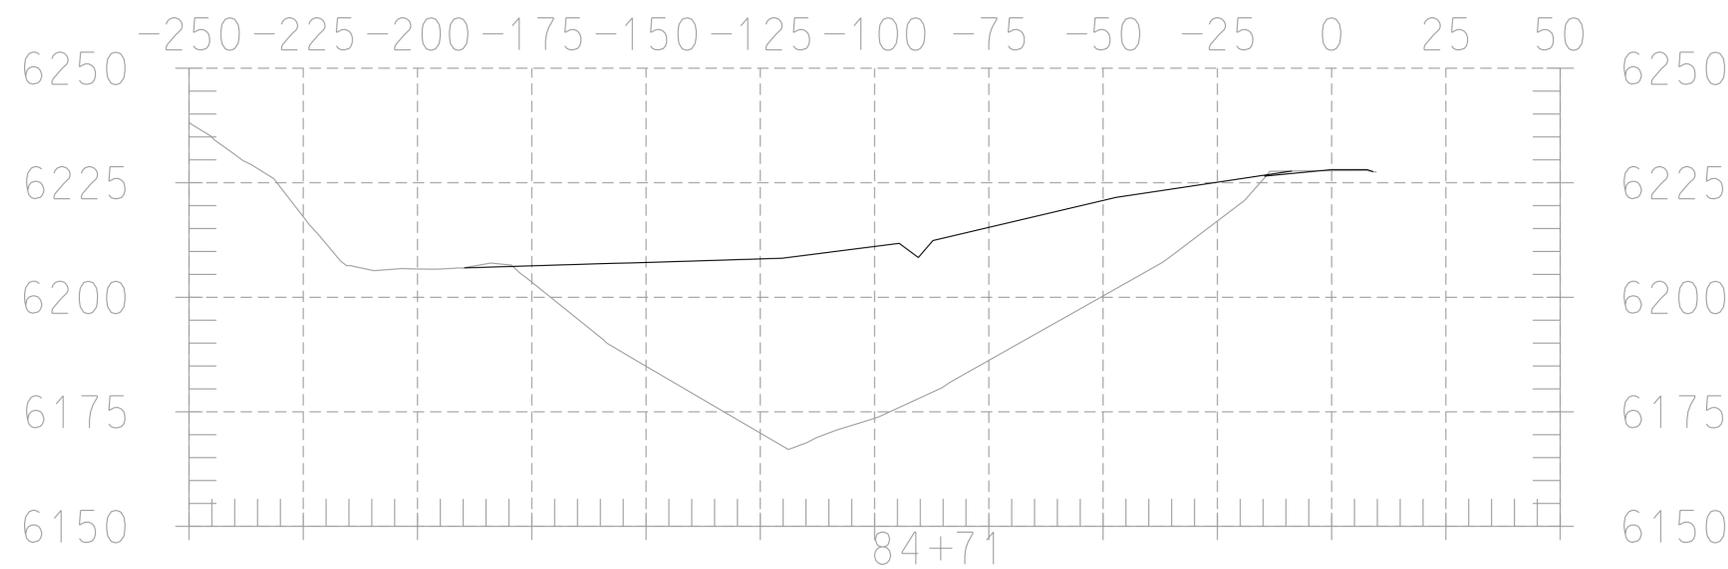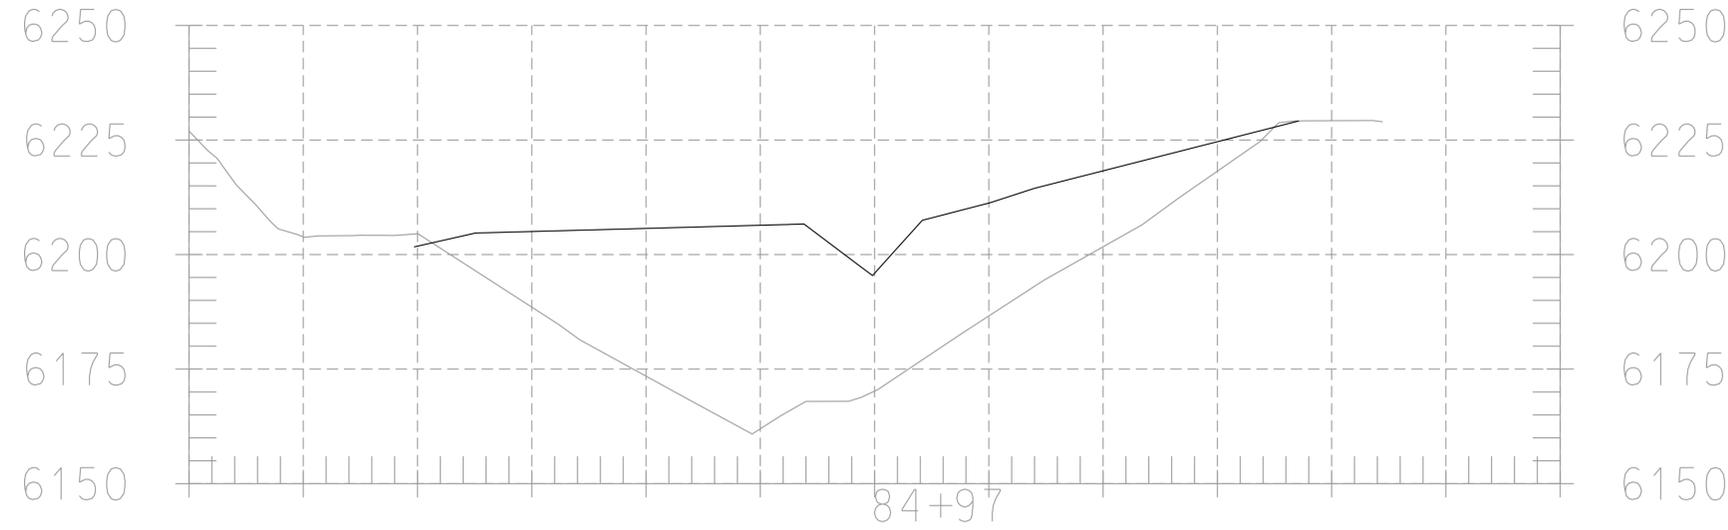



STA. 84+50 TO STA. 84+97

DESIGN	RSM	DATE	02/16	ARIZONA DEPARTMENT OF TRANSPORTATION INFRASTRUCTURE DELIVERY and OPERATIONS DIVISION ROADWAY DESIGN SERVICES
DRAWN	RSM	DATE	02/16	
CHECKED	RM	DATE	02/16	
PREMIER			CROSS-SECTIONS	
ROUTE	SR 288	LOCATION	SOUTH OF YOUNG	
TRACS NO.	H8617 01C		288-A(20)T	DWG NO. <u> OF </u>

SURVEY NO. FINISHED PLANS REVISIONS LOCATION DATE SURVEY NO. FINISHED PLANS REVISIONS LOCATION DATE

F.H.W.A. REGION	STATE	PROJECT NO.	SHEET NO.	TOTAL SHEETS	Record Drawing
9	ARIZ.	288-A(20)T	9	14	

288 CI 288

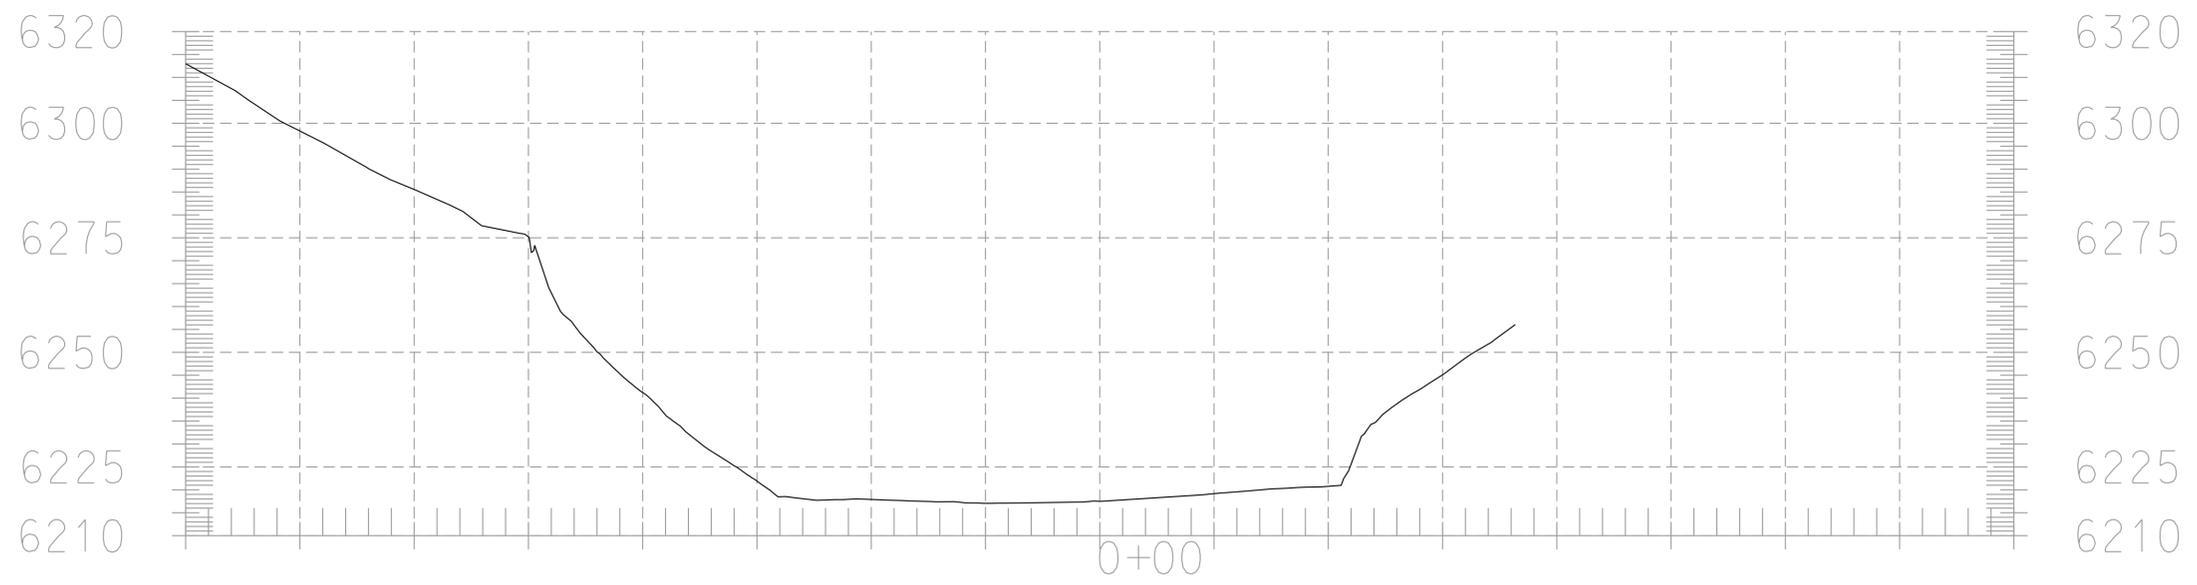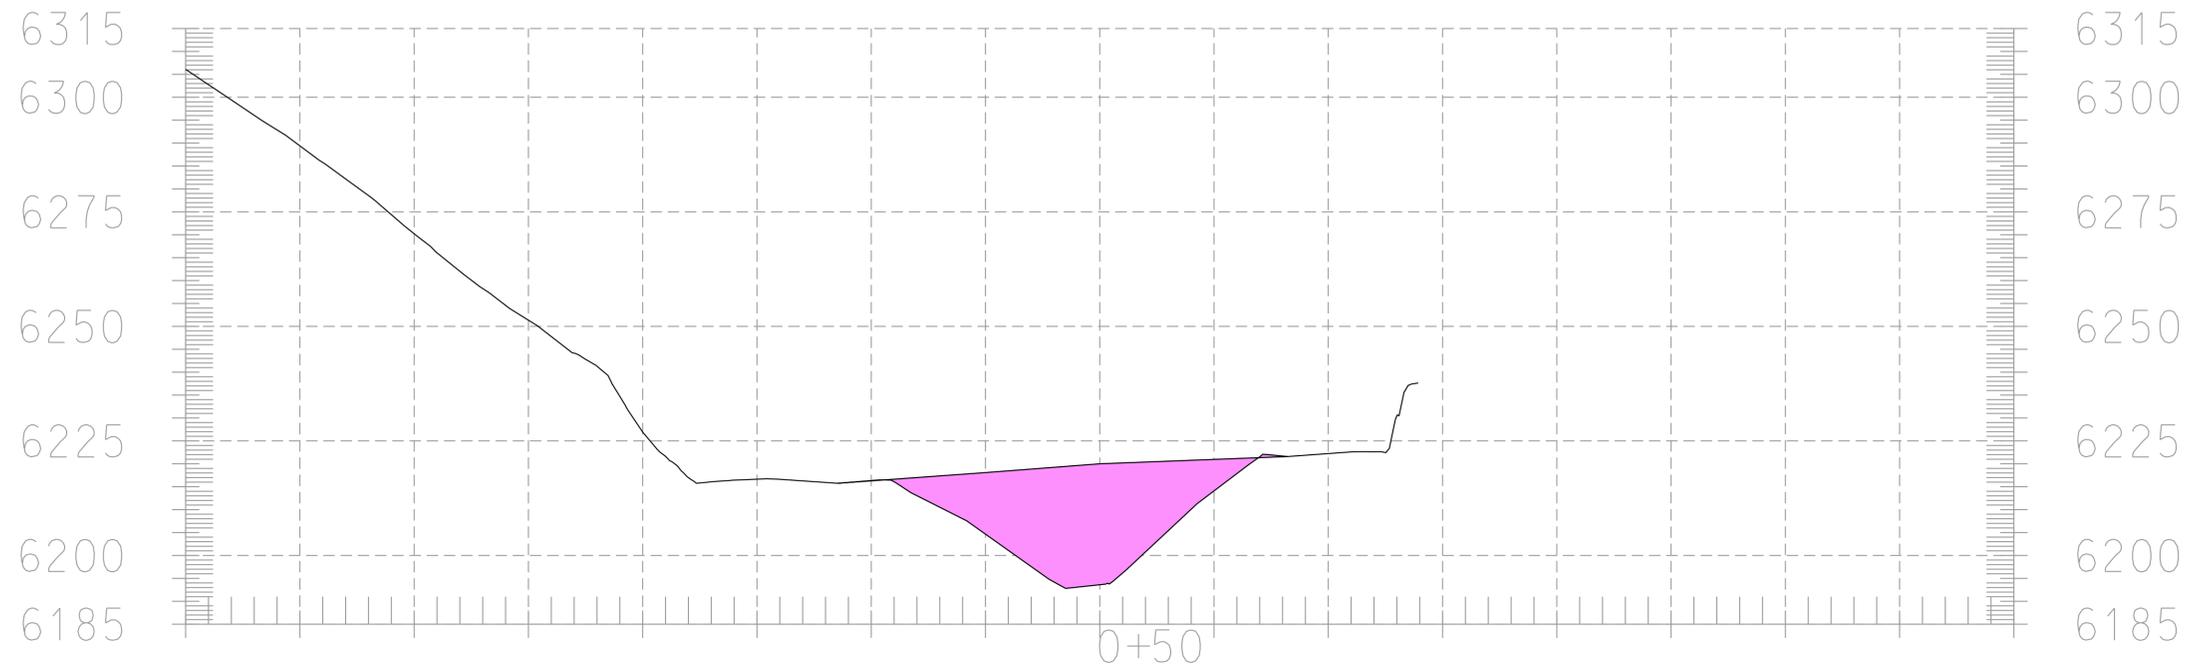



STA. 0+00 TO STA. 0+50

DESIGN	RSM	DATE	02/16	ARIZONA DEPARTMENT OF TRANSPORTATION INFRASTRUCTURE DELIVERY and OPERATIONS DIVISION ROADWAY DESIGN SERVICES
DRAWN	RSM	DATE	02/16	
CHECKED	RM	DATE	02/16	
PREMIER			CROSS-SECTIONS	
ROUTE	SR 288	LOCATION	SOUTH OF YOUNG	
TRACS NO.	H8617 01C		288-A(20)T	DWG NO. <u> </u> OF <u> </u>

SURVEY NO. FINISHED PLANS- REVISIONS- LOCATION- DATE-
 SURVEY NO. FINISHED PLANS- REVISIONS- LOCATION- DATE-
 SURVEY NO. FINISHED PLANS- REVISIONS- LOCATION- DATE-

F.H.W.A. REGION	STATE	PROJECT NO.	SHEET NO.	TOTAL SHEETS	Record Drawing
9	ARIZ.	288-A(20)T	10	14	

288 CI 288

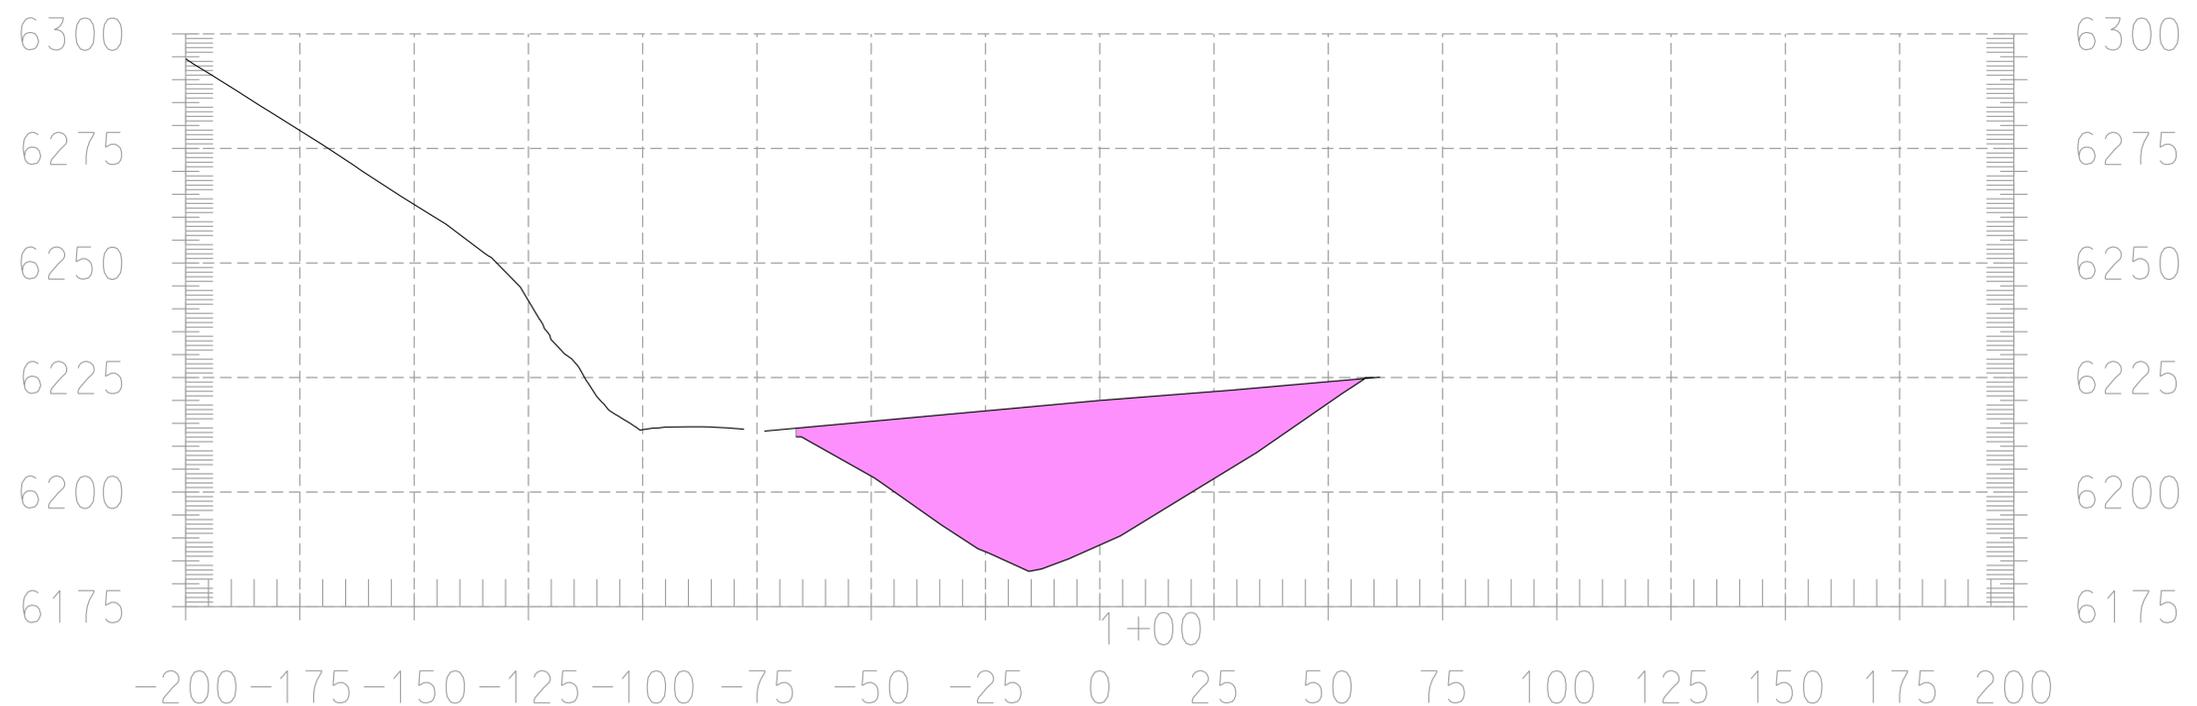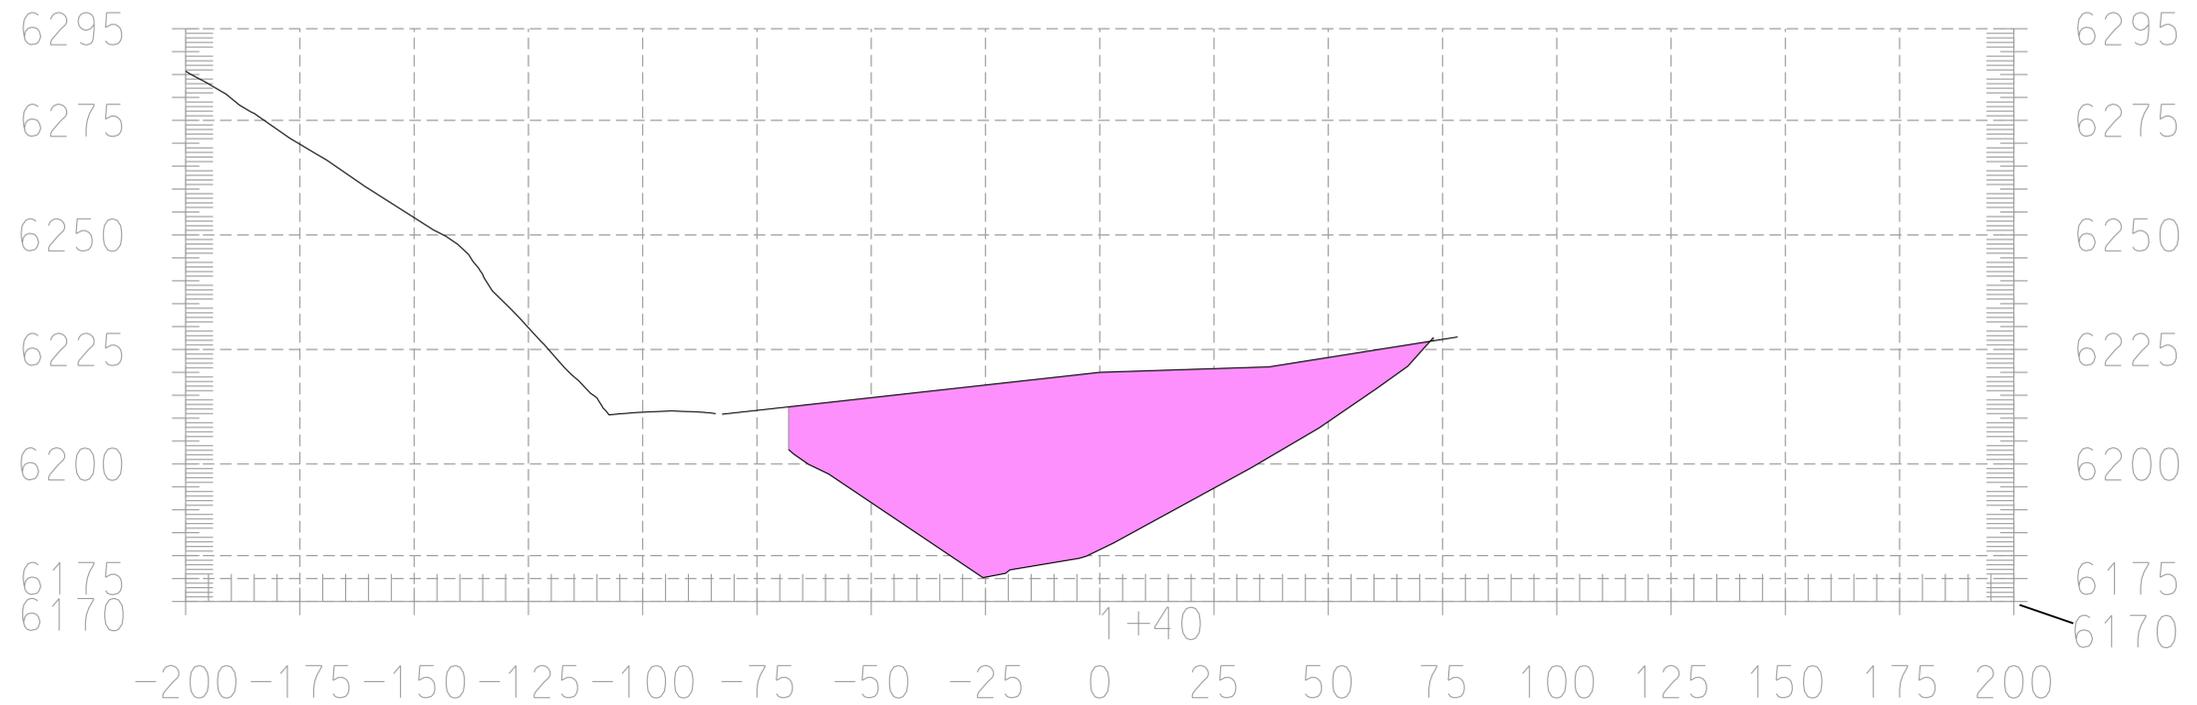


STA. 1+00 TO STA. 1+40

DESIGN	RSM	DATE	02/16	ARIZONA DEPARTMENT OF TRANSPORTATION INFRASTRUCTURE DELIVERY and OPERATIONS DIVISION ROADWAY DESIGN SERVICES
DRAWN	RSM	DATE	02/16	
CHECKED	RM	DATE	02/16	
PREMIER			CROSS-SECTIONS	
ROUTE	SR 288	LOCATION	SOUTH OF YOUNG	
TRACS NO.	H8617 01C		288-A(20)T	DWG NO. <u> </u> OF <u> </u>


SURVEY NO. FINISHED PLANS- REVISIONS- LOCATION- DATE- SURVEY NO. FINISHED PLANS- REVISIONS- LOCATION- DATE-

F.H.W.A. REGION	STATE	PROJECT NO.	SHEET NO.	TOTAL SHEETS	Record Drawing
9	ARIZ.	288-A(20)T	11	14	

288 CI 288

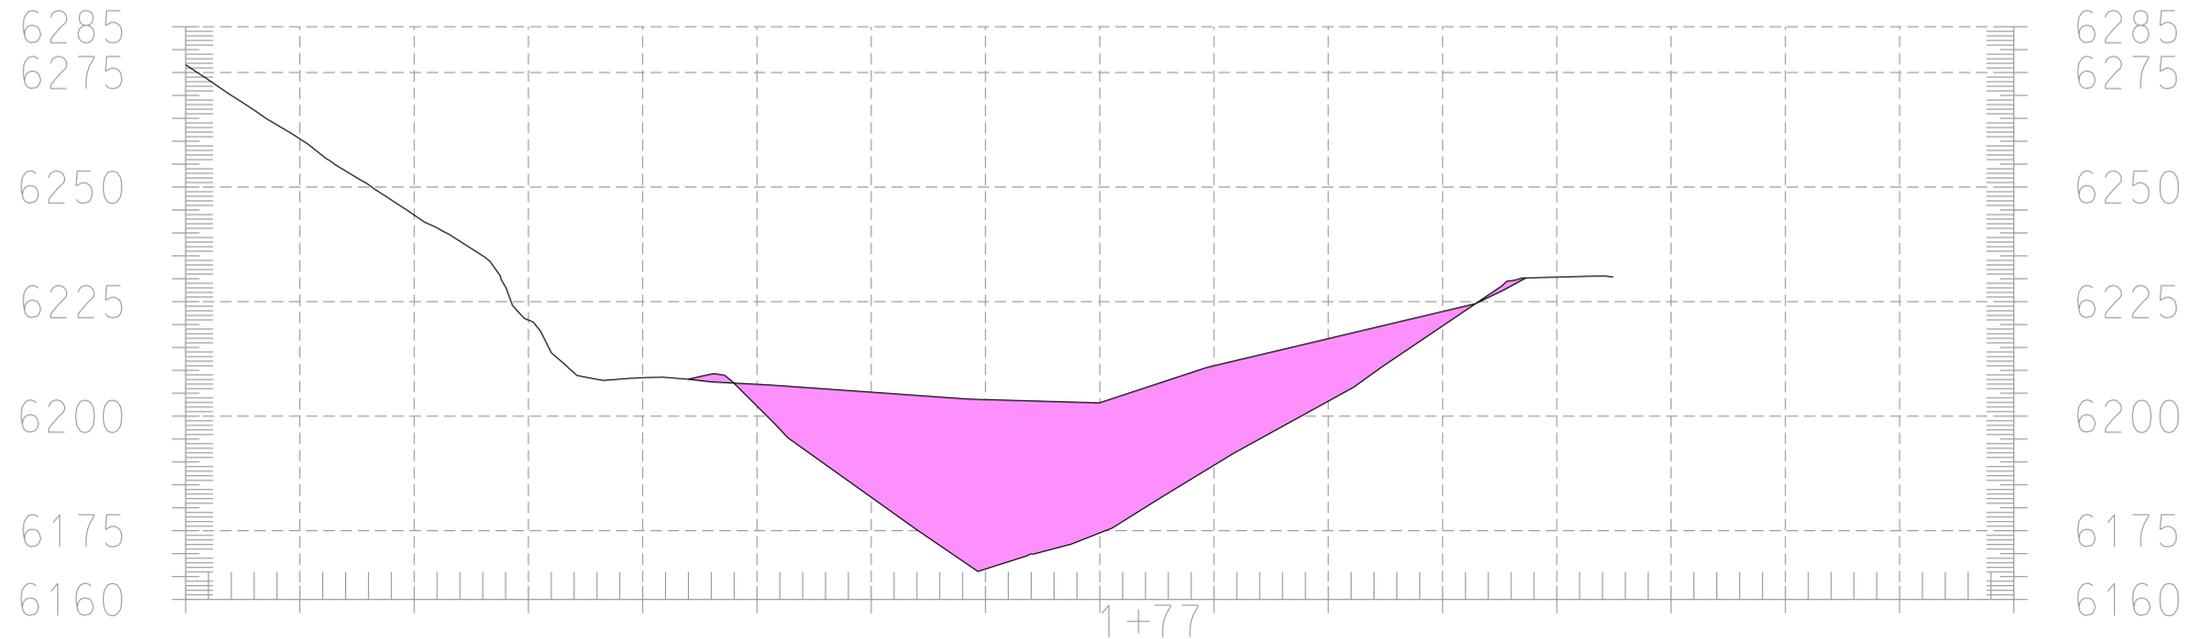

-200 -175 -150 -125 -100 -75 -50 -25 0 25 50 75 100 125 150 175 200

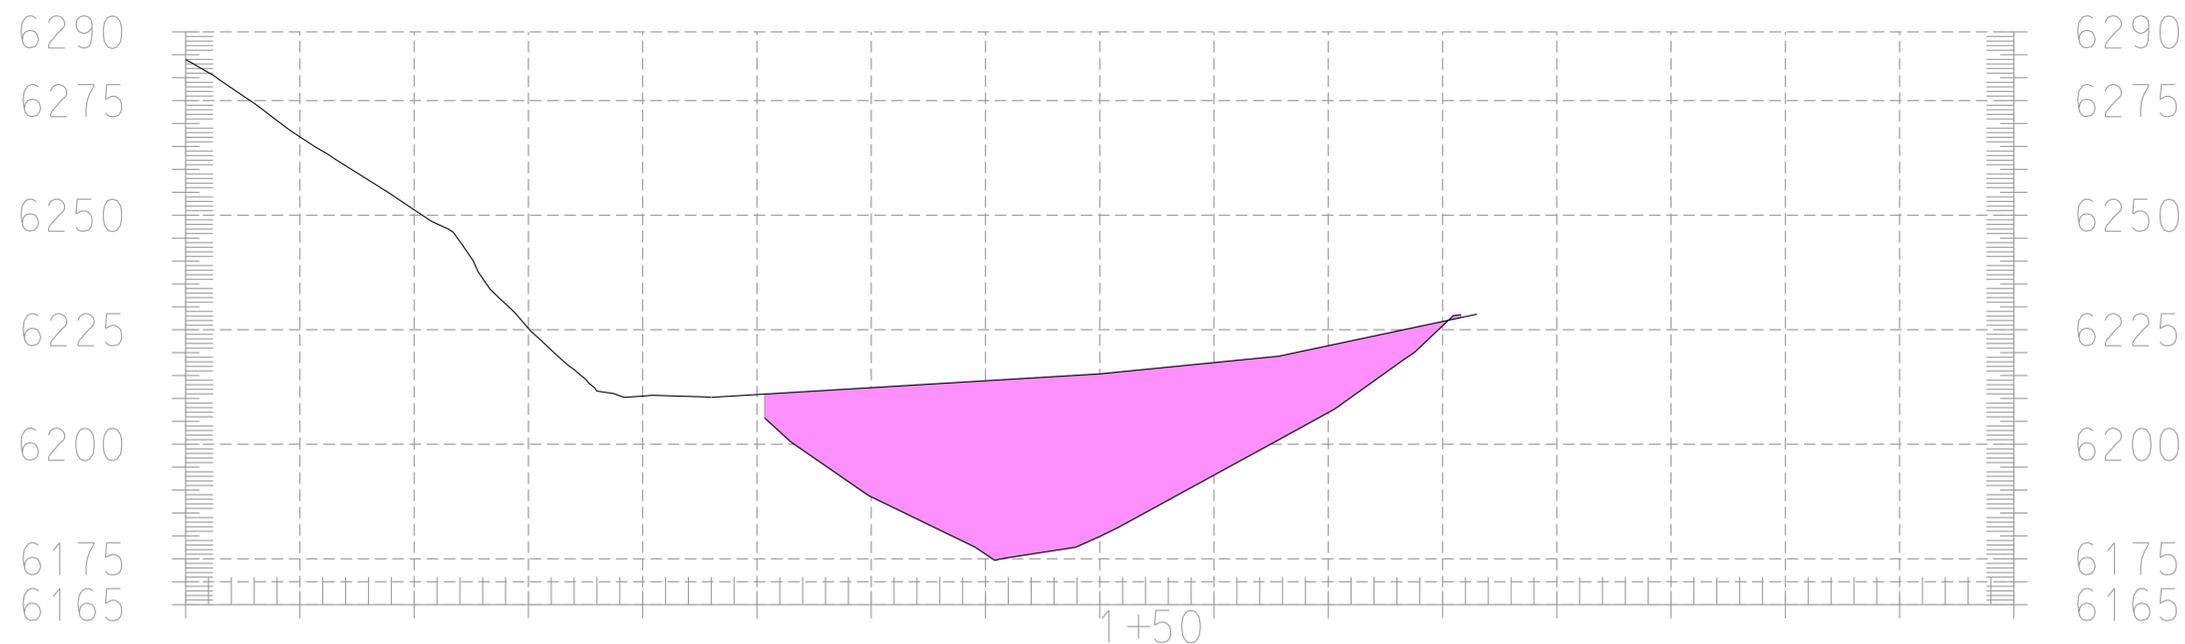

-200 -175 -150 -125 -100 -75 -50 -25 0 25 50 75 100 125 150 175 200



STA. 1+50 TO STA. 1+77

DESIGN	RSM	DATE	02/16	ARIZONA DEPARTMENT OF TRANSPORTATION INFRASTRUCTURE DELIVERY and OPERATIONS DIVISION ROADWAY DESIGN SERVICES
DRAWN	RSM	DATE	02/16	
CHECKED	RM	DATE	02/16	
PREMIER			CROSS-SECTIONS	
ROUTE	SR 288	LOCATION	SOUTH OF YOUNG	
TRACS NO.	H8617 01C		288-A(20)T	DWG NO. <u> </u> OF <u> </u>

DATE- LOCATION- REVISIONS- FINISHED PLANS- SURVEY NO. DATE- LOCATION- REVISIONS- FINISHED PLANS- SURVEY NO.

F.H.W.A. REGION	STATE	PROJECT NO.	SHEET NO.	TOTAL SHEETS	Record Drawing
9	ARIZ.	288-A(20)T	12	14	

288 CI 288

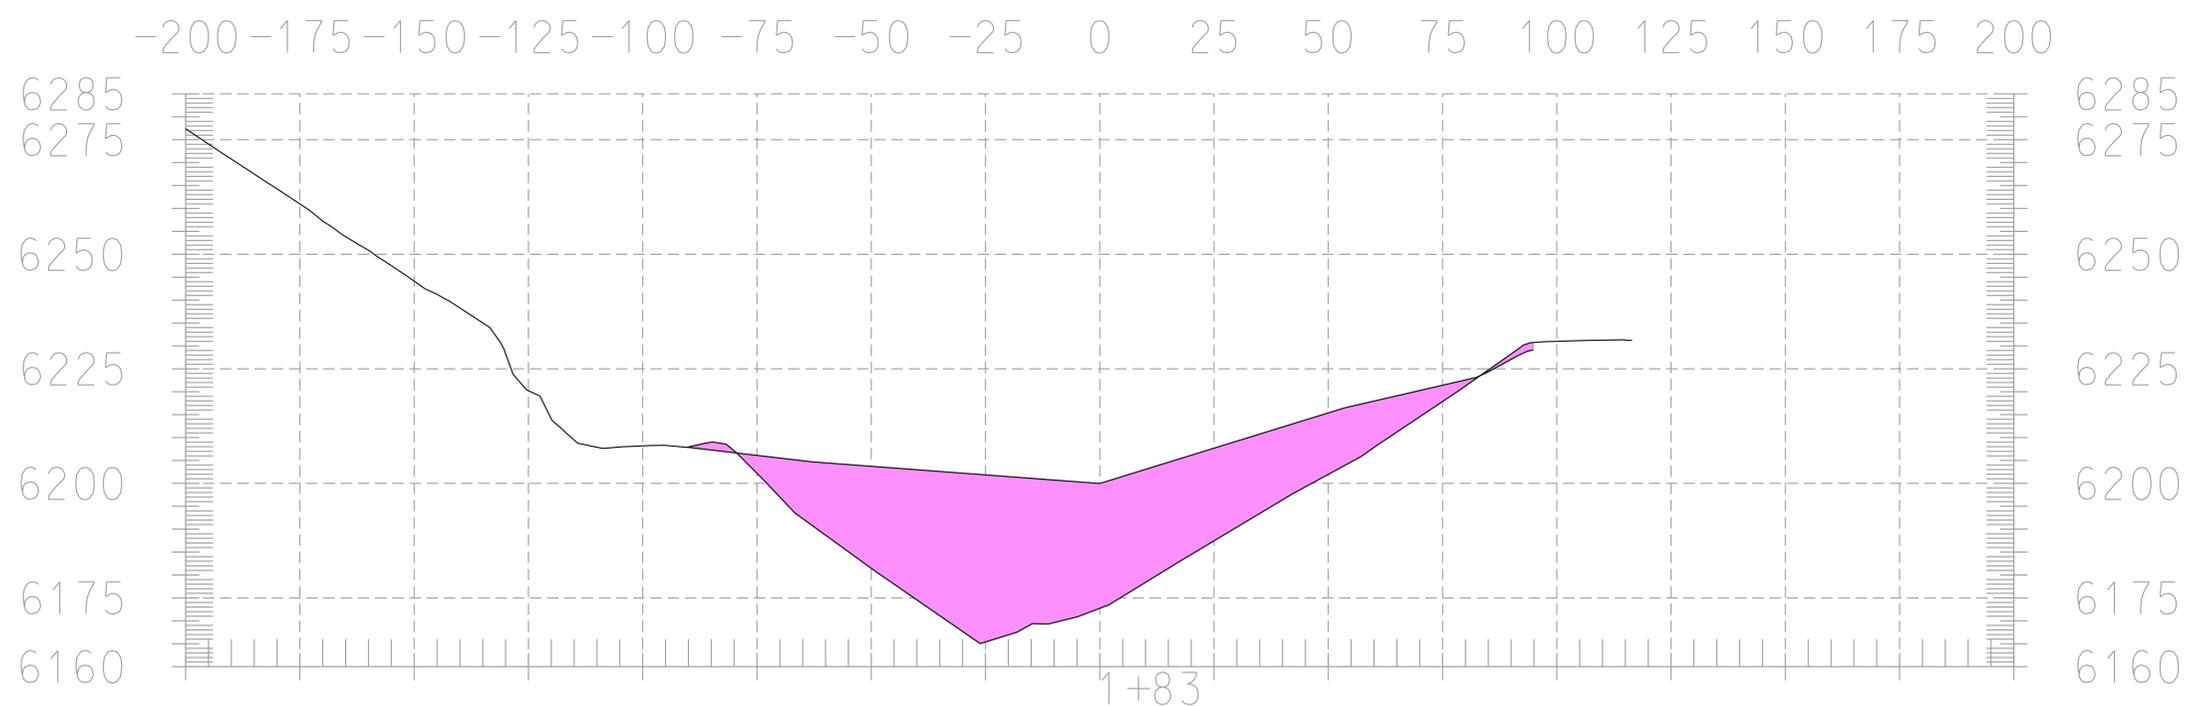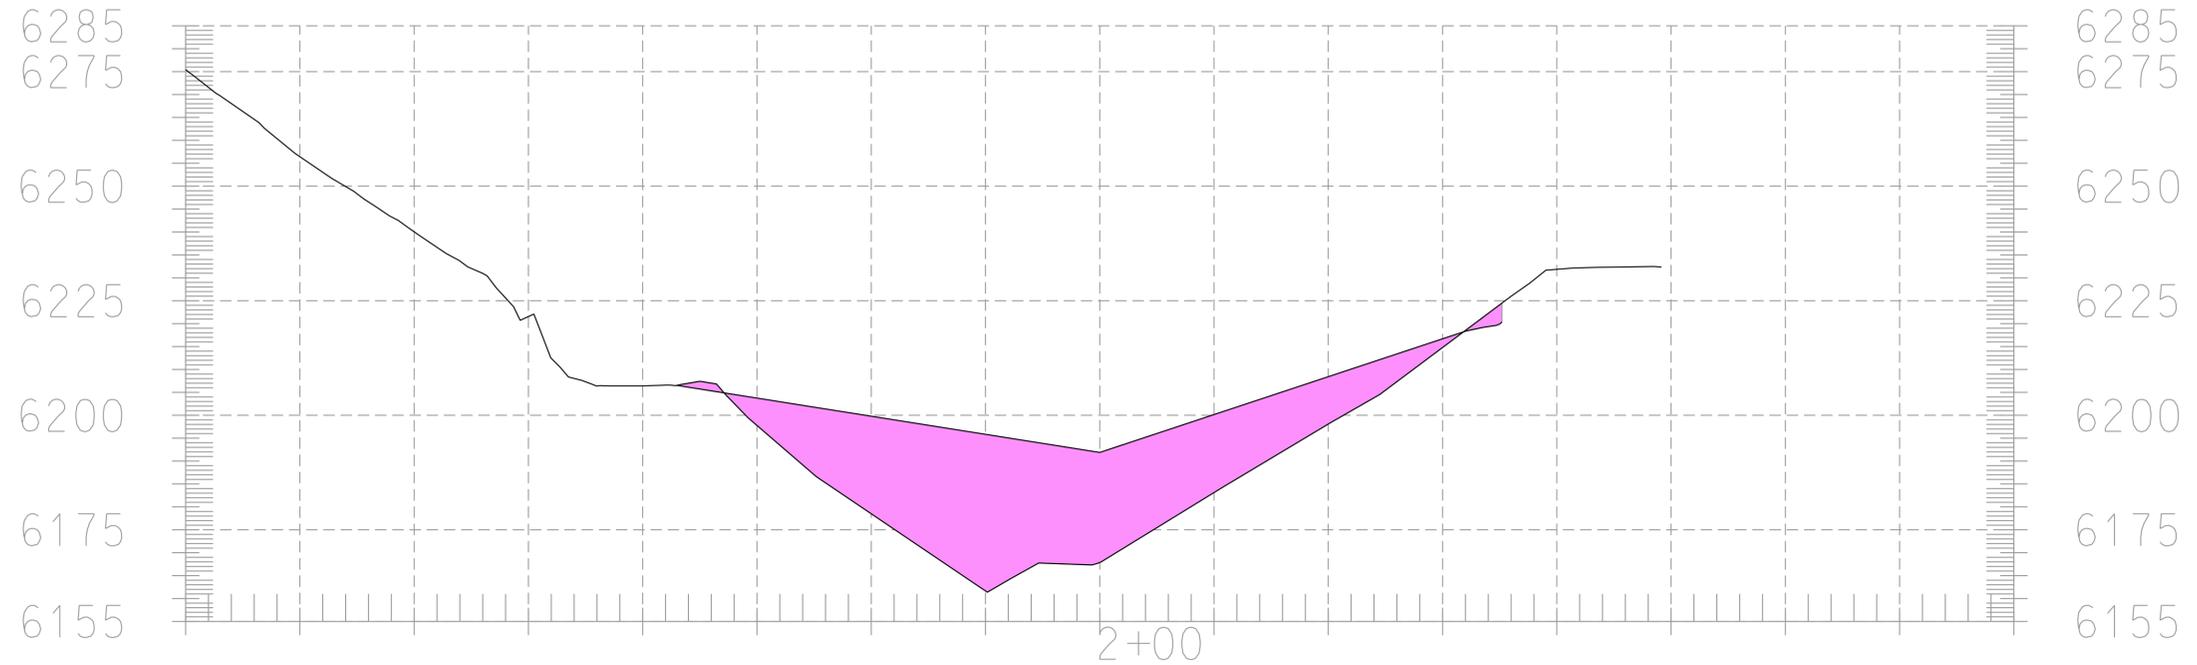



6175 STA. 1+83 TO STA. 2+00

DESIGN	RSM	DATE	02/16	ARIZONA DEPARTMENT OF TRANSPORTATION INFRASTRUCTURE DELIVERY and OPERATIONS DIVISION ROADWAY DESIGN SERVICES
DRAWN	RSM	DATE	02/16	
CHECKED	RM	DATE	02/16	
PREMIER			CROSS-SECTIONS	
ROUTE	SR 288	LOCATION	SOUTH OF YOUNG	
TRACS NO.	H8617 OIC		288-A(20)T	DWG NO. <u> </u> OF <u> </u>

SURVEY NO. FINISHED PLANS- REVISIONS- LOCATION- DATE- SURVEY NO. FINISHED PLANS- REVISIONS- LOCATION- DATE- SURVEY NO. FINISHED PLANS- REVISIONS- LOCATION- DATE-

F.H.W.A. REGION	STATE	PROJECT NO.	SHEET NO.	TOTAL SHEETS	Record Drawing
9	ARIZ.	288-A(20)T	13	14	

288 CI 288

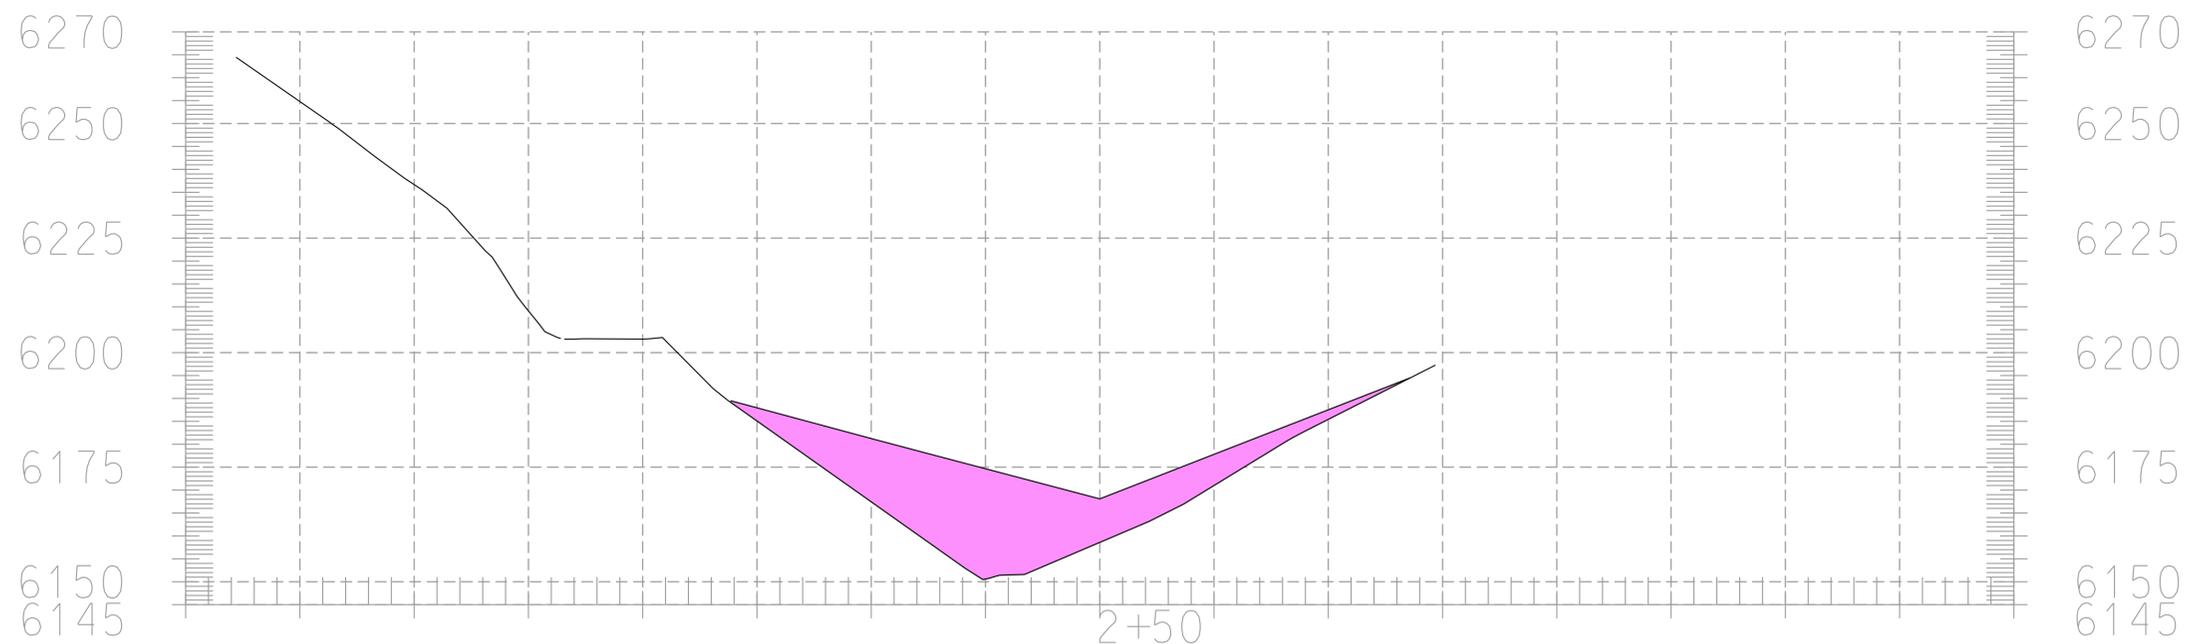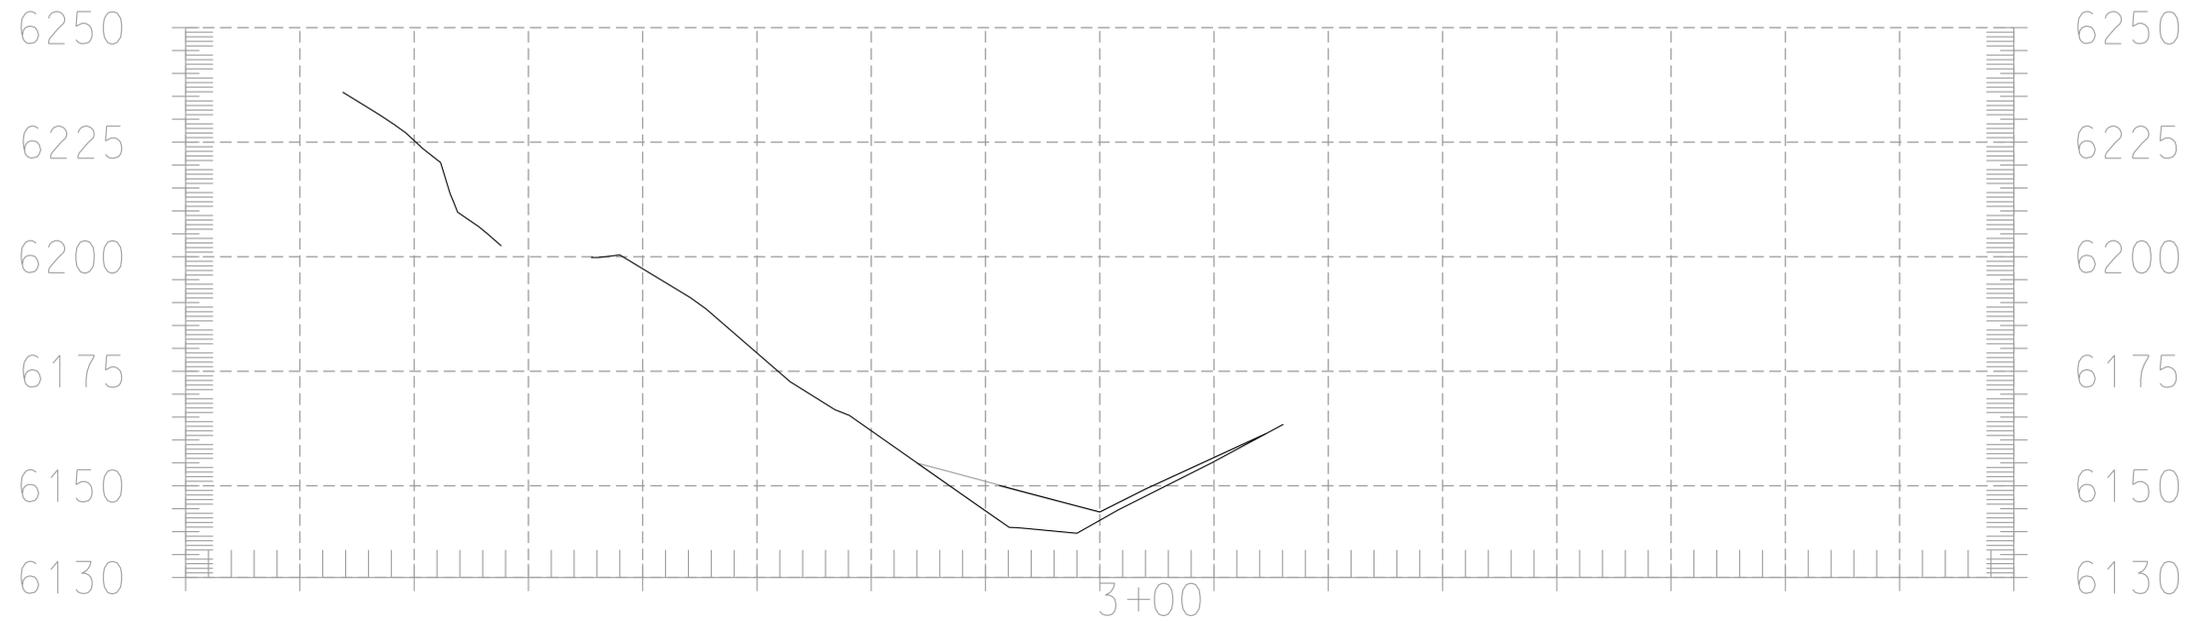

STA. 2+50 TO STA. 3+00


DESIGN	RSM	DATE	02/16	ARIZONA DEPARTMENT OF TRANSPORTATION INFRASTRUCTURE DELIVERY and OPERATIONS DIVISION ROADWAY DESIGN SERVICES
DRAWN	RSM	DATE	02/16	
CHECKED	RM	DATE	02/16	
PREMIER			CROSS-SECTIONS	
ROUTE	SR 288	LOCATION	SOUTH OF YOUNG	
TRACS NO.	H8617 01C		288-A(20)T	DWG NO. <u> </u> OF <u> </u>

SURVEY NO. FINISHED PLANS- REVISIONS- LOCATION- DATE- SURVEY NO. FINISHED PLANS- REVISIONS- LOCATION- DATE-

F.H.W.A. REGION	STATE	PROJECT NO.	SHEET NO.	TOTAL SHEETS	Record Drawing
9	ARIZ.	288-A(20)T	14	14	

288 CI 288

SURVEY NO. | FINISHED PLANS | REVISIONS | LOCATION | DATE | SURVEY NO. | FINISHED PLANS | REVISIONS | LOCATION | DATE

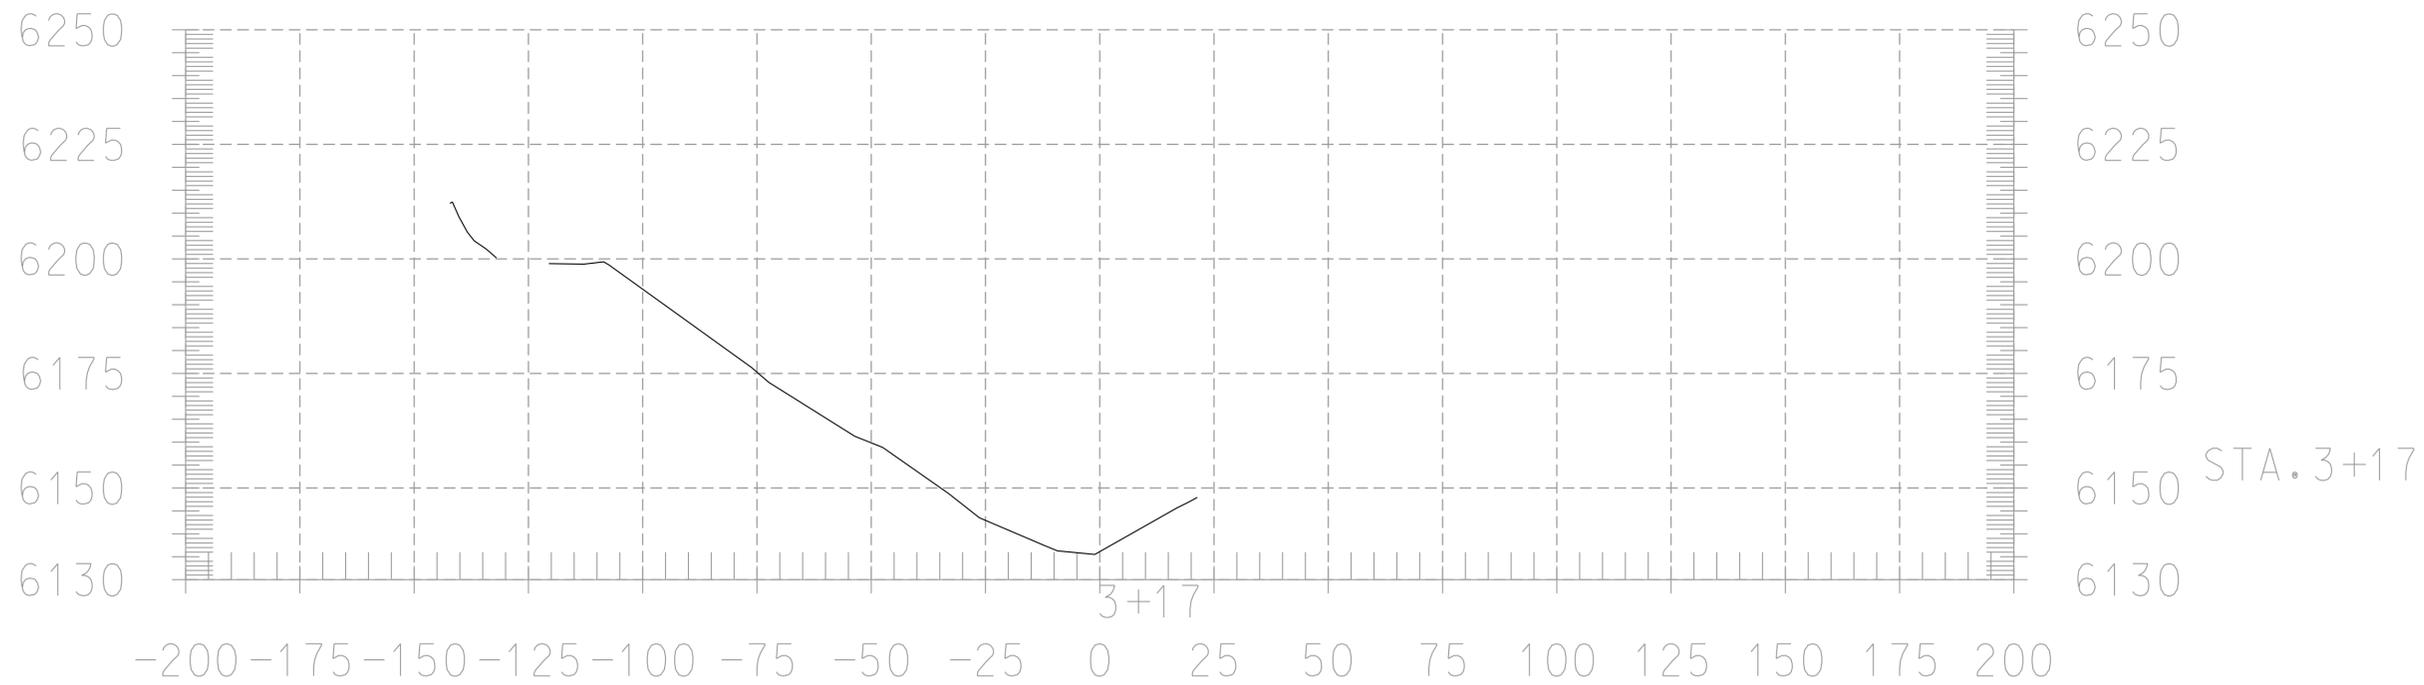

DESIGN	RSM	02/16	ARIZONA DEPARTMENT OF TRANSPORTATION INFRASTRUCTURE DELIVERY and OPERATIONS DIVISION ROADWAY DESIGN SERVICES
DRAWN	RSM	02/16	
CHECKED	RM	02/16	
PREMIER			CROSS-SECTIONS
ROUTE	SR 288	LOCATION	SOUTH OF YOUNG
TRACS NO. H8617 01C			288-A(20)T
			DWG NO. <u> </u> OF <u> </u>