Click here for I-10 Index

OWNERSHIP RECORD

ITEM	OWNER	ADDRESS	DESCRIPTION	AREA
1150	TONY & HOPE ESCANDON	BOX 37, PICACHO, ARIZ.	LOTS 11,12,13, BLK 5, PICACHO HOMESITES & PT of SW¼ Sec. 23	
1149	L.C. VANNERSON; TONY & HOPE ESCANDON	BOX 37, PICACHO, ARIZ.	LOTS 1 to 10, & 14 to 24, BLOCK 5, PICACHO HOMESITES	
1147	LUCIEN C. VANNERSON	BOX 647, COOLIDGE, ARIZ.	LOTS 2, 3, 7, 9, BLOCK 4, PICACHO HOMESITES	
1148	JACOB E. & FLORENCE M. WALTERS	BOX 35, PICACHO, ARIZ.	LOT 6, BLOCK 4, PICACHO, HOMESITES	
1151	EDDIE C. & LEONOR F. MARTAN	BOX 44, PICACHO, ARIZ.	LOT 4 & 5, BLOCK 4, PICACHO HOMESITES, EXCEPT NORTHEASTERLY 12' OF LOT 4	
1152	RICHARD F. & MILDRED R. SHEFFERLY	3450 NO. 1ST AVE., TUCSON, ARIZ.	LOT 3 & NORTHWESTERLY 12' OF LOT 4, BLOCK 4, PICACHO HOMESITES	
1150	TONY & HOPE ESCANDON	BOX 37, PICACHO, ARIZ.	LOT 2, BLOCK 4, PICACHO HOMESITES	
1150	TONY & HOPE ESCANDON	BOX 37, PICACHO, ARIZ.	LOT 5 & 6, BLOCK 2, PICACHO HOMESITES	
1149	L.C. VANNERSON; TONY & HOPE ESCANDON	BOX 37, PICACHO, ARIZ.	LOTS 8 to 12, BLOCK 1, PICACHO HOMESITES	
1147	LUCIEN C. VANNERSON	BOX 647, COOLIDGE, ARIZ.	LOTS 2 to 7, BLOCK 1, PICACHO HOMESITES	
1153	GEORGE A. BIDEAUX, ½ INT. HERBERT F. KRUCKER, ½ INT.	67 NO. CHURCH ST., TUCSON, ARIZ.	SW¼ NE¼ Sec. 22, T.8S., R.8E.	
1154	EDDIE C. & LEONOR F. MARTAN	BOX 44, PICACHO, ARIZ.	NW¼ NE¼ Sec. 22, T.8S., R.8E., EXCEPT THAT PART WITHIN PICACHO VILLAGE SUBDIVISION	
1155	ARTHUR THOMASSON E ESTATE OF W.A. THOMASSON	BOX 57, PICACHO, ARIZ.	NW¼ Sec. 22, T.8S., R.8 E.	
1156	ELLEN M. LYNNE	BOX 282, ELOY, ARIZ.	LOTS 16 to 24, BLOCK 17; LOTS 1 to 6 BLOCK 19, PICACHO CITY	
1157	CLAUDE & EILEENE HENSON, ¾ INT. ALBERT & FRANCIS TIBSHRAERTY, ¼ INT.	CHANDLER, ARIZ.	LOTS 1 to 26, BLOCK 13; LOTS 1 to 24, BLOCK 14; LOTS 1 to 24, BLOCK 15; LOTS 16 to 24, BLOCK 16; LOTS 1 to 18, BLOCK 20; LOTS 1 to 20, BLOCK 21; LOTS 1 to 18, BLOCK 22; LOTS 9,11 to 16, BLOCK 23, PICACHO CITY	
1158	TRUSTEES OF SOUTHERN BAPTIST CHURCH OF PICACHO	PICACHO, ARIZ.	LOT 6, BLOCK 7, PICACHO HOMESITES	
SAME	498	Southern Pacific R.R.	NW¼ Sec. 15.	
SAME	499	Lena Van Meter	NW¼ Sec. 15.	

OWNERSHIP RECORD

ITEM	OWNER	DESCRIPTION	AREA (Ac)	Date of Recording
A-326	P.K. BRYCE S/S	PART OF NW¼, SEC. 23, T. 8S., R. 8E.	0.43	7/14/61
A-327	SHERMAN B. J.J. WRIGHT	PART OF SW¼, SEC. 23, T. 8S., R. 8E.		2/13/62
A-328	HARRY E. & R.A. OSBORNE	PART OF SW¼, SEC. 23, T. 8S., R. 8E.	0.379	5/24/62
A-329	PHILLIP S. & DORIS RUSSO	PART OF SW¼, SEC. 23, T. 8S., R. 8E.		4/1/64
A-330	TONY & HOPE ESCANDON	PART OF SW¼, SEC. 23, T. 8S., R. 8E.		2/6/62
A-314	STATE OF ARIZONA	SE¼, SEC. 23, T. 8S., R. 8E.		8/10/59
II-1A-1	ROBETTA GIBSON, a widow	PART OF SW¼ SEC. 23, T. 8S., R. 8E.	DAMAGES only	
11-002	E. & B. SKOUBIS etal	PT. SW¼ Sec. 23 T. 8S. R. 8E.	54.05 ±	6-26-63
11-003	HOLMES ENTERPRISES INC.	" " " " " " "	6.75 ±	4-29-64

I certify that these R/W plans have been compared with the AS-BUILT plans of project I-10-4(17) and that the STATE of ARIZONA has good and sufficient title to the R/W as shown. 11-7-66

John M. Bowman

DO NOT REVISE OR ALTER

OWNERSHIP RECORD

ITEM	OWNER	ADDRESS	DESCRIPTION	AREA
1129	STATE OF ARIZONA	PHOENIX, ARIZ.,	SE¼ Sec. 23, T.8S., R.8E.	
1130	A.P. & SADIE MCKEITE	BOX 336, PICACHO, ARIZ.	PT. OF SW¼ Sec. 23, T.8S., R.8E. (ASSESSOR'S TRACT #1)	
1131	OTIS GILES, MELVEL C. & MARTHA GILES	BOX 368, PICACHO, ARIZ.	PT. OF SW¼ Sec. 23 T.8S.,R.8E. (ASSESSOR'S TRACTS # 2&3)	
1132	TONY & HOPE ESCANDON	BOX 37, PICACHO, ARIZ.	PT OF SW¼ Sec. 23, T.8S., R.8E. (ASSESSOR'S TRACT #4)	
1133	GENERAL PETROLEUM CO.	612 So. FLOWER ST., LOS ANGELES, CALIF.	PT OF SW¼ Sec. 23, T.8S., R.8E. (ASSESSOR'S TRACT #4-2)	
1134	GEORGE & OLGA HALL	BOX 41, PICACHO, ARIZ.	PT OF SW¼ Sec. 23, T.8S., R.8E. (ASSESSOR'S TRACT #5)	
1135	E.D. & VIOLA PEARSON	BOX 89, PICACHO, ARIZ.	PT OF SW¼ Sec. 23, T.8S., R.8E. (ASSESSOR'S TRACT #6)	
1136	A.P. & SADIE MCKEITE	BOX 336, PICACHO, ARIZ.	PT OF SW¼ Sec. 23, T.8S., R.8E. (ASSESSOR'S TRACT #11)	
1136	LEO BLOCK, TOM & EDNA FULBRIGHT	FLORENCE, ARIZ.	PT. OF SW¼ Sec. 23, T.8S., R.8E. (ASSESSOR'S TRACTS #8&9)	
1137	SOLOMON C. MENDOZA	PICACHO, ARIZ.	PT. OF SW¼ Sec. 23, T.8S., R.8E. (ASSESSOR'S TRACT #10)	
1138	SAM S. & VESTA E. STRINGER	BOX 255, ELOY, ARIZ.	PT. OF SW¼ Sec. 23 T.8S.,R.8E. (ASSESSOR'S TRACT #12)	
1139	MAUD B. DEBEROFF AND/OR VERL MILLER	BOX 278, GILA BEND, ARIZ.	PT. OF SW¼ Sec. 23, T.8S., R.8E. (ASSESSOR'S TRACT #12)	
1140	JESSIE W. WOLF	PICACHO, ARIZ.	PT OF SW¼ Sec. 23 T.8S., R.8E. (ASSESSOR'S TRACT #14)	
1141	P.K. BRYCE	PICACHO, ARIZ.	PT. OF SW¼ Sec. 23, T.8S., R.8E. (ASSESSOR'S TRACT #15)	
1142	SHERMAN & BETTY JEAN WRIGHT	PICACHO, ARIZ.	PT. OF SW¼ Sec. 23, T.8S., R.8E. (ASSESSOR'S TRACTS #15 & 16)	
1143	J.P. & SARAH P. REED	PICACHO, ARIZ.	PT. OF SW¼ Sec. 23, T.8S., R.8E. (ASSESSOR'S TRACTS #16 & 18 & No. 3/8 of ASSESSOR'S TRACT #17, EXCEPT THE SOUTH 70' THEREOF)	
1144	P.K. BRYCE	BOX 21, PICACHO, ARIZ.	DAVIS TRACT IN NW¼ Sec. 23, T.8S., R.8E.	
1145	LUCIEN C. VANNERSON & TONY & HOPE ESCANDON	BOX 647, COOLIDGE, ARIZ.	LOTS 15,16,17,18, 20, 21, 23 to 30, & WEST 50' OF LOT 19, BLOCK 6, PICACHO HOMESITES	
1146	ARTHUR EDWIN & VIRGINIA H. NICHOLSON	PICACHO, ARIZ.	LOT 13, BLOCK 6, PICACHO HOMESITES	
1148	JACOB E. & FLORENCE M. WALTERS	BOX 35, PICACHO, ARIZ.	LOT 22 & E. TRIANGLE OF LOT 19, BLOCK 6, PICACHO HOMESITES	
1149	L.C. VANNERSON, TONY & HOPE ESCANDON	BOX 37, PICACHO, ARIZ.	LOTS 1 to 12, & LOT 14, BLOCK 6, PICACHO HOMESITES	
1147	PICACHO WATER SYS. INC.	PICACHO, ARIZ.	LOT 13, BLOCK 6, PICACHO HOMESITES	

RESOLUTION OF ESTABLISHMENT 2009-08-A-013 PER DOC. 2009-028967 RECORDED 3/23/09 P.C.R. PLAN MAINT.: HUBBARD ENG. (J. ZAVALZA) JAN 2011

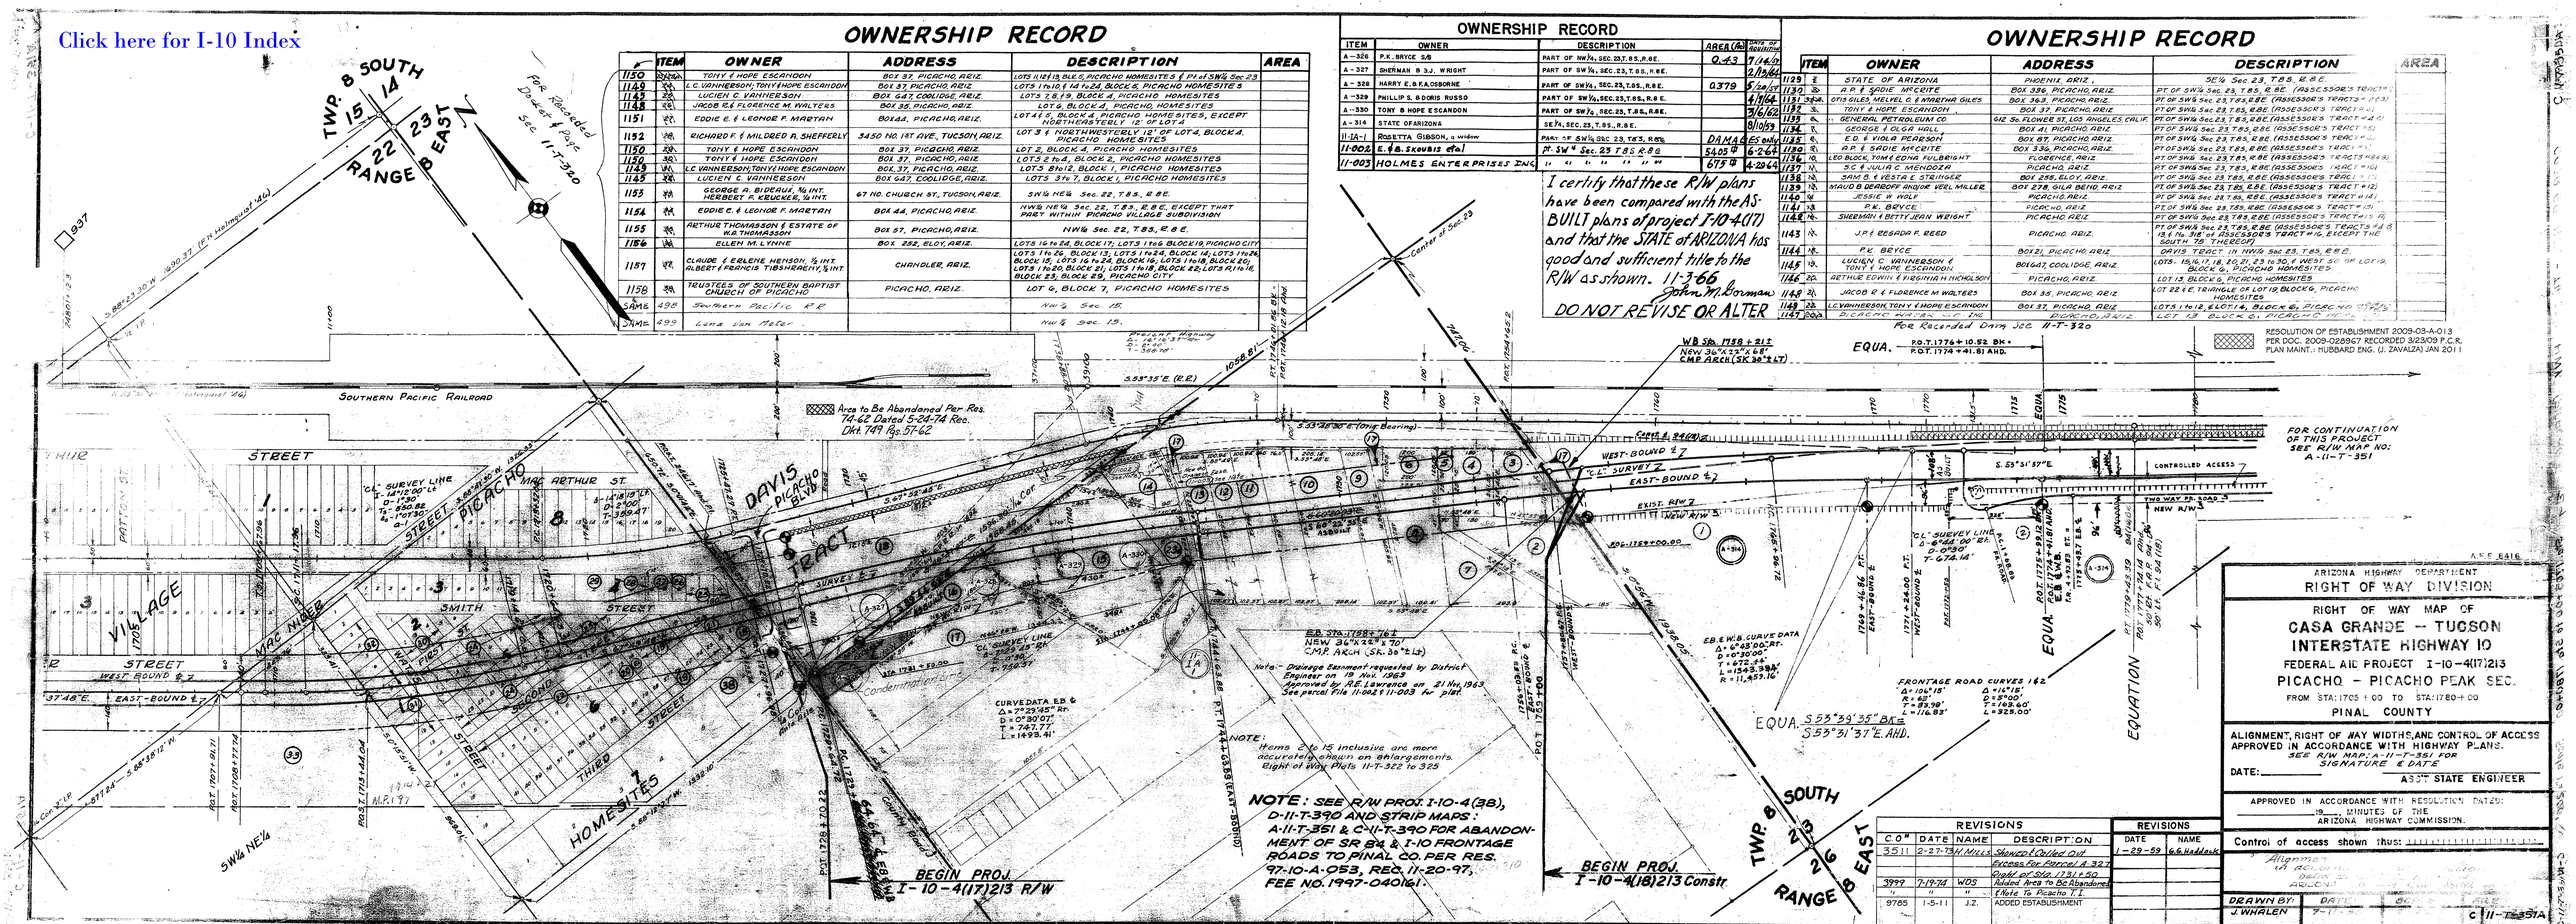
TWP. 8 SOUTH
RANGE 8 EAST
14
15
22
23
N
Center of Sec. 23
