Click here for I-10 Index

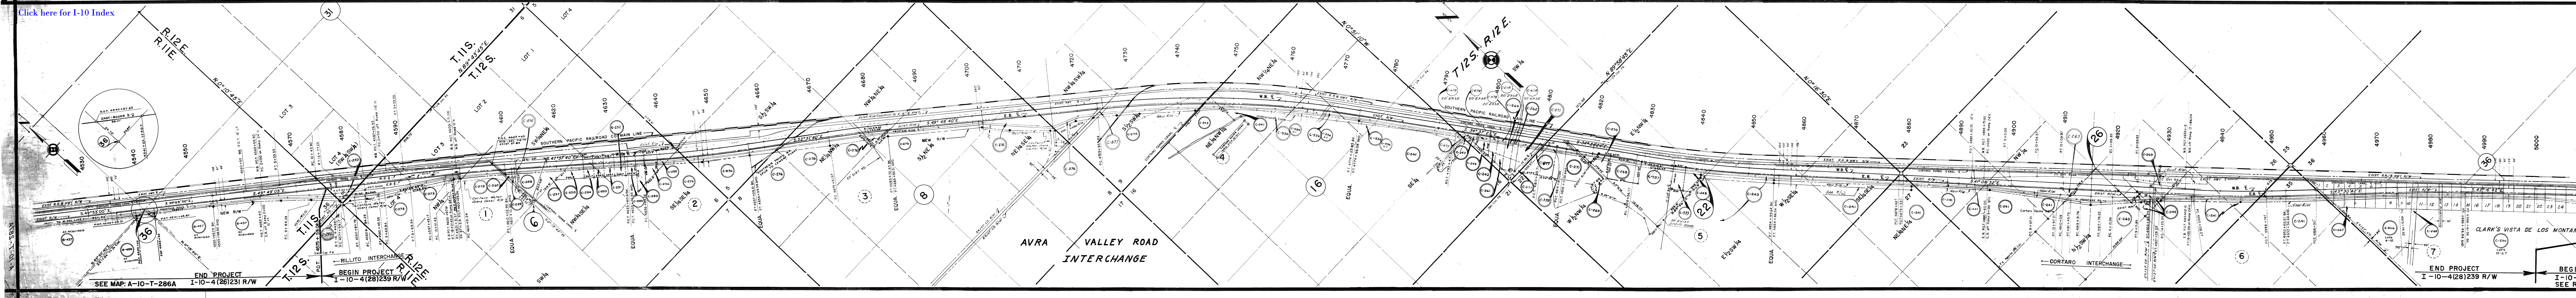

o——— CURVE DATA ———o	1	2	3	4	5	6	7
Δ	02° 11' 25" rt.	5° 00' 00"	02° 49' 50" rt.	15° 11' 15"	06° 34' 28" lt.	04° 21' 50" lt.	03° 14' 00" rt.
D	0.2512497°	0.2487626°	0.2512497°	0.3018016°	0.2487625°	0.2487625°	0.2512497°
R	22,804.32'	23,032.32'	22,804.32'	18,984.59'	23,032.32'	23,032.32'	22,804.32'
T	435.65'	1,005.61'	560.65'	2,530.98'	1,322.99'	877.24'	643.62'
L	871.75'	2,009.95'	1,121.06'	5,032.28'	2,642.98'	1,754.24'	1,286.90'

OWNERSHIP RECORD

ITEM	OWNER	DESCRIPTION	ACREAGE TAKEN	ACREAGE REMAINING	DATE PROPERTY ACQUIRED
C-241	PHOENIX TITLE & TRUST CO. (Trust No. RH-26895)	PT OF NE¼NW¼, PT. SE¼, SEC. 16, PT. OF SE¼SE¼, SEC. 22, PT. OF NE¼NE¼, SEC. 27, PT. OF NW¼, & PT. OF S½SE¼, SEC. 26, PT. OF NE¼NE¼, SEC. 35, T. 12 S.-R. 12 E.			
C-242	MELVIN CHARLES KIRKLAND & ROSE KIRKLAND, H/W	PT. OF SW¼SW¼, SEC. 15, T. 12 S.-R. 12 E.	.38	1.03	8-17-62
C-243	LYMAN F. CURTIS & BLANCHE G. CURTIS, H/W	PT. OF E½ SW¼, PT. OF W½ SE¼, SEC. 22, T. 12 S.-R. 12 E.	4.70		
C-244	MADESTA C. CONKLIN, & SELBY O. CONKLIN, H/W	PT. OF SW¼SW¼, SEC. 15; PT. NW¼ SE¼ SEC. 26 T12S R12E	2.137	2.368	
C-245	ARIZONA LAND TITLE & TRUST CO. (AN ARIZ. CORP.) TR. NO. 6040-T	PT. OF E½NW¼, & PT. OF PT SW¼ NE¼ SEC. 22, T. 12 S.-R 12 S.	1.24	2.51	
C-247	SAMUEL Q. HARDY & RUTH HARDY, H/W	PT. SW¼ SEC. 15; T. 12 S.-R. 12 E.	.51	.11	
C-248	TUNG DONG, & WAI-MAN DONG, H/W	PT. E½ NW¼, SEC. 22, T. 12 S.-R. 12 E.	1.52	4.41	10-2-62
C-249	W. A. & ROSELMA CROCKETT, H/W	PT. OF NE¼NW¼, SEC. 16, T. 12 S.-R. 12 E.	1.17	10.77	
C-250	PETER R. BRADY, & BERTHA E. BRADY, H/W	PT. OF NW¼ SE¼, & PT. OF NE¼SE¼, SEC. 6, T. 12 S.-R. 12 E.	1.69	3.96	
C-251	PETER BRADY JR. & ELVIRA BRADY, H/W	PT. OF N½SE¼, SEC. 6, T. 12 S.-R. 12 E.	.53	.78	
C-252	ELVIRA PEYRON BRADY, S/SP	PT. OF NE¼SE¼, SEC. 6, T. 12 S.-R. 12 E.	.53	.78	
C-253	MARIA PETRA ALTAMIRANO, S/SP	PT. OF NW¼SE¼; PT. OF NE¼SE¼, SEC. 6, T. 12 S.-R. 12 E.	.53	.78	
C-254	CONRAD GREMMLER, & INEZ GREMMLER, H/W	PT. NW¼ SE¼; PT NE¼ SE¼ SEC. 6 T12S R12E	.53	.78	
C-255	GEORGE BIDEAUX, & JEANETTE BIDEAUX, H/W & RALPH W. BILBY, (WIDOWER)	PT. OF NE¼ SE¼, SEC. 6, T. 12 S.-R. 12 E.	.49	.18	
C-256	M. ELIAS, & TRINIDAD ELIAS, H/W	PT. OF NE¼SE¼, SEC. 6, T. 12 S.-R. 12 E.	.66	1.39	
C-257	GEORGE L. GIBBON, S/P	PT. OF SW¼ NE¼, SEC. 6, T. 12 S.-R. 12 E.	1.15	3.10	
C-258	THOMAS & MARY LEMME, H/W	PT. OF SW¼NE¼, SEC. 6, T. 12 S.-R. 12 E.	1.24	3.55	
C-259	ALUCE DELONE SMITH	PT. OF SW¼ NE¼, SEC. 6, T. 12 S-R. 12 E.	.15	.08	
C-260	MOLLIE WEISSBERGER & HELEN SCHNEIDER, S/SP	PT. OF SW¼NE¼, SEC. 6, T. 12 S.-R. 12 E.	.66	.78	
C-261	GARLAND E. PHILLIPS & TRESSIE PHILLIPS, H/W	PT. OF SW¼SW¼, SEC. 15, T. 12 S.-R. 12 E.	.38	1.37	
C-262	CICERO EUGENE BURREL, RUBY BURREL, H/W	PT. OF SW¼ SW¼, SEC. 15, T. 12 S.-R. 12 E.	.25	1.24	
C-263	CORTARO COTTON & CATTLE CO.	PT. OF N½ SW¼; PT SE¼NW¼ SEC. 26 T12S R12E	6.82	39.95	
C-264	W. LEE JOHNSON, S/W & ELLEN VELLONE FLOYD, S/W	PT. OF SW¼ SW¼, SEC. 15, T. 12 S.-R. 12 E.	.38	1.66	
C-265	CORTARO WATER USERS ASS'N. (A CORP.)	ALL CANALS, DITCHES, IRRIG. STRUCT. & WELL SITES. PT. W½ NW¼ SEC. 22 T12S R12E	.18	.74	
C-266	HARRY M. & PHEBE PREVO, H/W	LOTS 4 THRU 25, CLARK'S VISTA DE LOS MONTAÑAS SUB. (EXC. 100' EL PASO N. G. R/W)	12.17	19.97	
C-267	RICHARD R. HUGHES & NANCY H. HUGHES, H/W	LOTS 2 & 3, CLARK'S VISTA DE LOS MONTAÑAS SUB.	.82	.66	
C-268	EL PASO NATURAL GAS CO. (A TEXAS CORP.)	100' R/W THRU LOTS 10 & 11, CLARKS VISTA DE LOS MONTAÑAS & NW¼ SEC. 36, T. 12 S.-R. 12 E.	.25	.53	
C-269	TUCSON GAS, ELECT. LIGHT & PWR. CO. (AN ARIZ. CORP.)	PT. OF NW¼ SE¼, SEC. 26, T. 12 S.-R. 12 E.	.17	NONE	
C-270	MORTIMER BENISCH, & MARIAN LORANE BENISCH, H/W	PT. OF E½NW¼, SEC. 22, T. 12 S.-R. 12 E.	0.68	6.24	
C-271	WESTERN HILLS INVEST. CO. (A CORP.) & MORRIS K. & PATRICIA UDALL, H/W	PT. OF SW¼ SW¼, SEC. 15, & PT. OF W½ NW¼, SEC. 22, T. 12 S.-R. 12 E.	1.93	10.22	
C-273	APEX FARMS INC. (A CORP.)	PT. OF NW¼, SEC. 6, T. 12 S.-R. 12 E.	12.19	254.82	
C-550	PAYCOL FARMS & CALYCO FARMS (AN ARIZ. CORP.)	PT. LOT 4, SEC. 31, T. 11 S.-R. 12 E.	2.60	NONE	
C-276	ARIZONA PORTLAND CEMENT CO. (AN ARIZ. CORP.) RILLITO PLANT	PT. OF SE¼SE¼, SEC. 6 - PT. OF S½ SW¼ SEC. 5. - PT. OF NE¼ SE¼; PT S½ NE¼; PT. OF NW¼ NE¼; PT. NE¼ NW¼ ALL OF SEC. 8 T12S R12E	30.79	178.71	

ITEM	OWNER	DESCRIPTION	ACREAGE TAKEN	ACREAGE REMAINING	DATE PROPERTY ACQUIRED
C-536	State of Arizona	NE¼ Sec. 16 T. 12 S. R. 12 E.	7.07	152.93	
C-496	LEIGH J. GARHARTT EST.	PT. SW¼ NE¼ SEC. 6 T. 12 S. R 12 E.	.032	.257	
C-536 L-1	ST. LAND GR. L'SE., GEORGINE E. AUST	NE¼, SEC. 16, T. 12 S.-R. 12 E.			
C-537	MAVERICK DEVELOPEMENT CO.	PT. OF E½ NW¼, SEC. 22, T. 12 S.-R. 12 E.	1.62	4.79	
C-538	PHOENIX TITLE & TRUST CO. TR. NO. 26821	PT. OF W½ NW¼, SEC. 22, T. 12 S.-R. 12 E.	.47	4.18	
C-539	PHOENIX TITLE & TRUST CO. TR. NO. 26862	PT. OF E½ NW¼, SEC. 22, " " " ".	.53	1.61	
C-275	AMERICA SMELTING & REFINING CO.	PT. S½SW¼ SEC. 9 T12S R12E.	6.27	42.50	
C-276	ARIZ. PORTLAND CEMENT CO. (AN ARIZ. CORP.)	PT. OF NW¼ SW¼ SEC. 9 T12S R12E	5.21	2.93	
		ALL NW¼NW¼ SEC. 8 T12S R12E			
C-677	PIMA COUNTY	THE W. 75' & S. 75' OF PT. W½ SW¼ SEC. 15 T. 12S R12E. THE N 75' OF PT. W½ NW¼ SEC. 22 T12S. R12E	0.80	4.80	
C-678	Western Hills Invest. Co. (A Corp. & Morris K. & Patricia Udall H/W)	20' Ease. Across Item Nos C-242; C-244; C-261; C-262 & C-264. All a Pt. of SW¼SW¼ Sec. 15, T12S. R12E. No Acreage Taken.	None		
C-241	Albert S. Oshrin & Gloria Oshrin, H/W Harry Oshrin & Emma G. Oshrin, Known as Cortaro Cotton & Cattle Co.	Pt. NE¼NW¼ Sec. 16 T12S. R12E.	.54	.940	
		Pt. SE¼ Sec. 16 T12S. R12E.	4.17	143.61	
		Pt. SE¼SE¼ Sec. 22 T12S. R12E.	4.09	10.84	
		Pt. NE¼NE¼ Sec. 27 T12S. R12E.	.99	38.41	
		Pt. NW¼ Sec. 26 T12S. R12E.	9.72	47.83	
		Pt. S½ SE¼ Sec. 26 T12S. R12E.	5.13	31.18	
		Pt. NE¼NE¼ Sec. 35 T12S. R12E.	3.16	29.37	
C-677	PIMA COUNTY	66' RD. R/W AVRA VALLEY RD. PT. OF W½ SW¼ SEC. 9 T12S R12E.			
D-286	First Natl. Bank Of Kansas City (Trustee)	NE¼NE¼NE¼NE¼ Sec. 1 T. 12 S. R. 11 E.	483 SQ. FT.	~~2.49~~	

MAP REVISIONS

DATE	REVISED BY	DESCRIPTION
7-17-61	E. L. ROGERS	ADDED ITEM NO. C-496
9-28-61	L. Draper	Revised Acreages For Items C-243, C-245, C-270 & C-276. Added Item D-286.
11-13-61	ROGERS	calculated acreage & revised ownership block for Item C-244.
11-30-61	ROGERS	[illegible]
12-7-61	ROGERS	[illegible] 4842+55.
12-11-61	G. Cox	Revised State of Arizona Land to show only NE¼ Sec. 16
12-15-61	G.G.H.	REVISED R/W MAP AT STA; 4820+00, 4895+00 & 4925+00 TO SHOW SMALL TRACTS ARE EXIST. R/W PREVIOUSLY ACQUIRED.
1-25-62	P. Julian	Revised R/W south side of Hwy. & also Canal R/W in Sec. 36, 31, 6.
2-1-62	F.G. BUDD	Revised canal & figured bearings & distances in Sec. 36
2-13-62	F.G. BUDD	Showed Frontage Road & Access Control - S. side Hwy.
6-29-62	Jungers, J.H.	Showed Areas for Item No. C-241 & Revised Exist. R/W & Access at Sta 4930
12-11-62	Rogers	Revised R/W item C-276 Sta. 13+ AVRA Valley Rd. changed acreage.
3-11-63	GROFF	Revised Item C-241 & C-263 Changed Owners

Note: - THIS DRAWING SUPERSEDED.
See Drawing ~~D-10T-587~~ D-10-T-287

ARIZONA HIGHWAY DEPARTMENT
RIGHT OF WAY DIVISION

RIGHT OF WAY MAP OF
CASA GRANDE — TUCSON HWY.
INTERSTATE HWY. 10
RILLITO to CORTARO SECTION
FEDERAL AID PROJECT I-10-4(24)239

FROM STATION TO STATION

PIMA COUNTY

ALIGNMENT AND RIGHT OF WAY WIDTHS APPROVED IN ACCORDANCE WITH HIGHWAY PLANS.

DATE: 7-

ASSISTANT STATE ENGINEER

APPROVED IN ACCORDANCE WITH RESOLUTION DATED: JULY 3 1962, MINUTES OF THE ARIZONA HIGHWAY COMMISSION.

DRAWN BY	T. MEEGAN
DATE	7-14-61
SCALE	1" = 500'
CHECKED BY	E.R.
A.F.E. NO.	Y8431
DRAWING NUMBER	A-10-T-287A

SUPERSEDED