Click here for I-10 Index

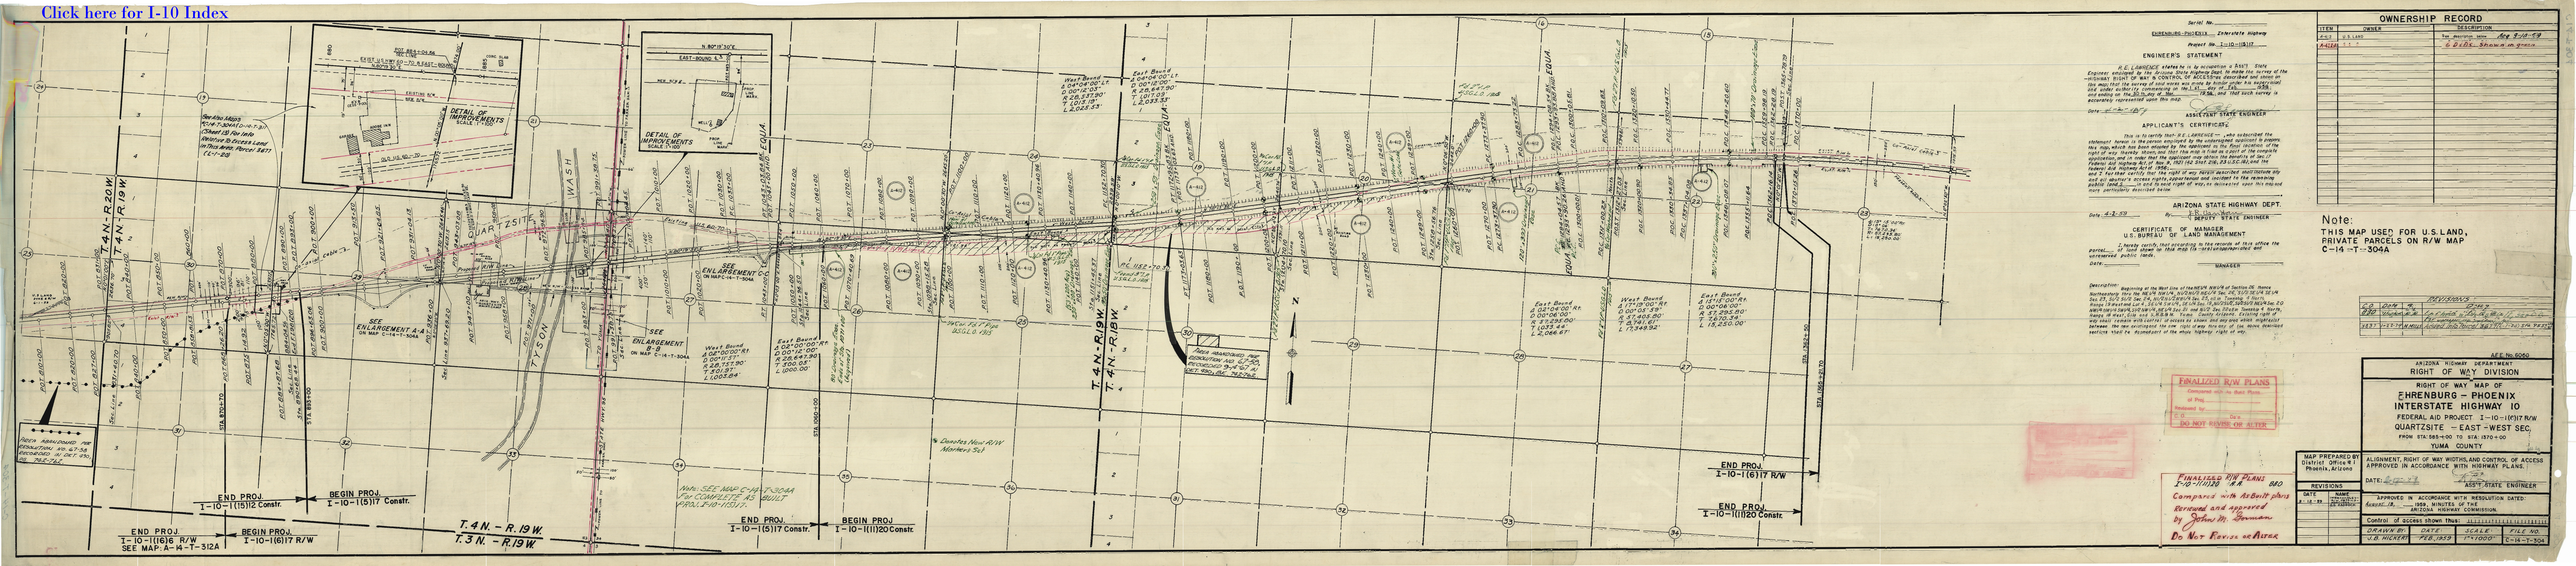

OWNERSHIP RECORD

ITEM	OWNER	DESCRIPTION
A-1	U.S. LAND	See 3-10-59
A-412	" "	6 Lots Shown in Green

Note:
THIS MAP USED FOR U.S. LAND, PRIVATE PARCELS ON R/W MAP C-14-T-304A

C.O.	DATE 4-30-59	PREVIOUS
840		1-10-I(6)17 A.B.
3337	WEST PHASE ADDED SOUTHBOUND	1-10-I(6)17 A.B. 3337

S.F. No. 6060

ARIZONA HIGHWAY DEPARTMENT
RIGHT OF WAY DIVISION

RIGHT OF WAY MAP OF
EHRENBURG – PHOENIX
INTERSTATE HIGHWAY 10
FEDERAL AID PROJECT I-10-I(6)17 R/W
QUARTZSITE – EAST – WEST SEC.
FROM STA 580+00 TO STA 1370+00
YUMA COUNTY

MAP PREPARED BY District Office #1 Phoenix, Arizona

ALIGNMENT, RIGHT OF WAY WIDTHS, AND CONTROL OF ACCESS APPROVED IN ACCORDANCE WITH HIGHWAY PLANS.

DATE: 4-30-59 [signature] STATE ENGINEER

REVISIONS

DATE	NAME
A. 4-30-59	[signature]

APPROVED IN ACCORDANCE WITH RESOLUTION DATED: AUGUST 18, 1958, MINUTES OF THE ARIZONA HIGHWAY COMMISSION.

Control of access shown thus: [signature]

DRAWN BY	DATE	SCALE	FILE NO.
J.D. HICKEY	FEB. 1959	1"=1000'	C-14-T-304