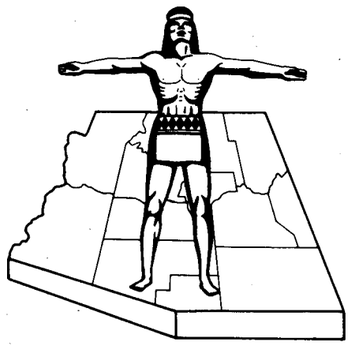

STATE OF ARIZONA
STATE HIGHWAY DEPARTMENT

RIGHT OF WAY PLAN OF THE
EHRENBERG — PHOENIX
STATE HIGHWAY
PROJECT NO. I-10-2(12)91
MARICOPA
COUNTY

FINALIZED

FED. ROAD DIV. NO.	STATE	PROJECT NO.	SHEET NO.	TOTAL SHEETS
7	ARIZ.	I-10-2(12)91	1	32

RIGHT OF WAY MAP NO. D-7-T-689

ALIGNMENT, RIGHT OF WAY, AND CONTROL OF ACCESS APPROVED IN ACCORDANCE WITH HIGHWAY PLANS.
SHEET 1 THRU 24
DATE 3/24/66
ASSISTANT STATE ENGINEER

APPROVED IN ACCORDANCE WITH RESOLUTION DATED: 23 March 1966, MINUTES OF THE ARIZONA HIGHWAY COMMISSION RES. NO. 66-22

A.F.E. NO. 10A30

4770	2-11-77	R.M.M.	Finalized

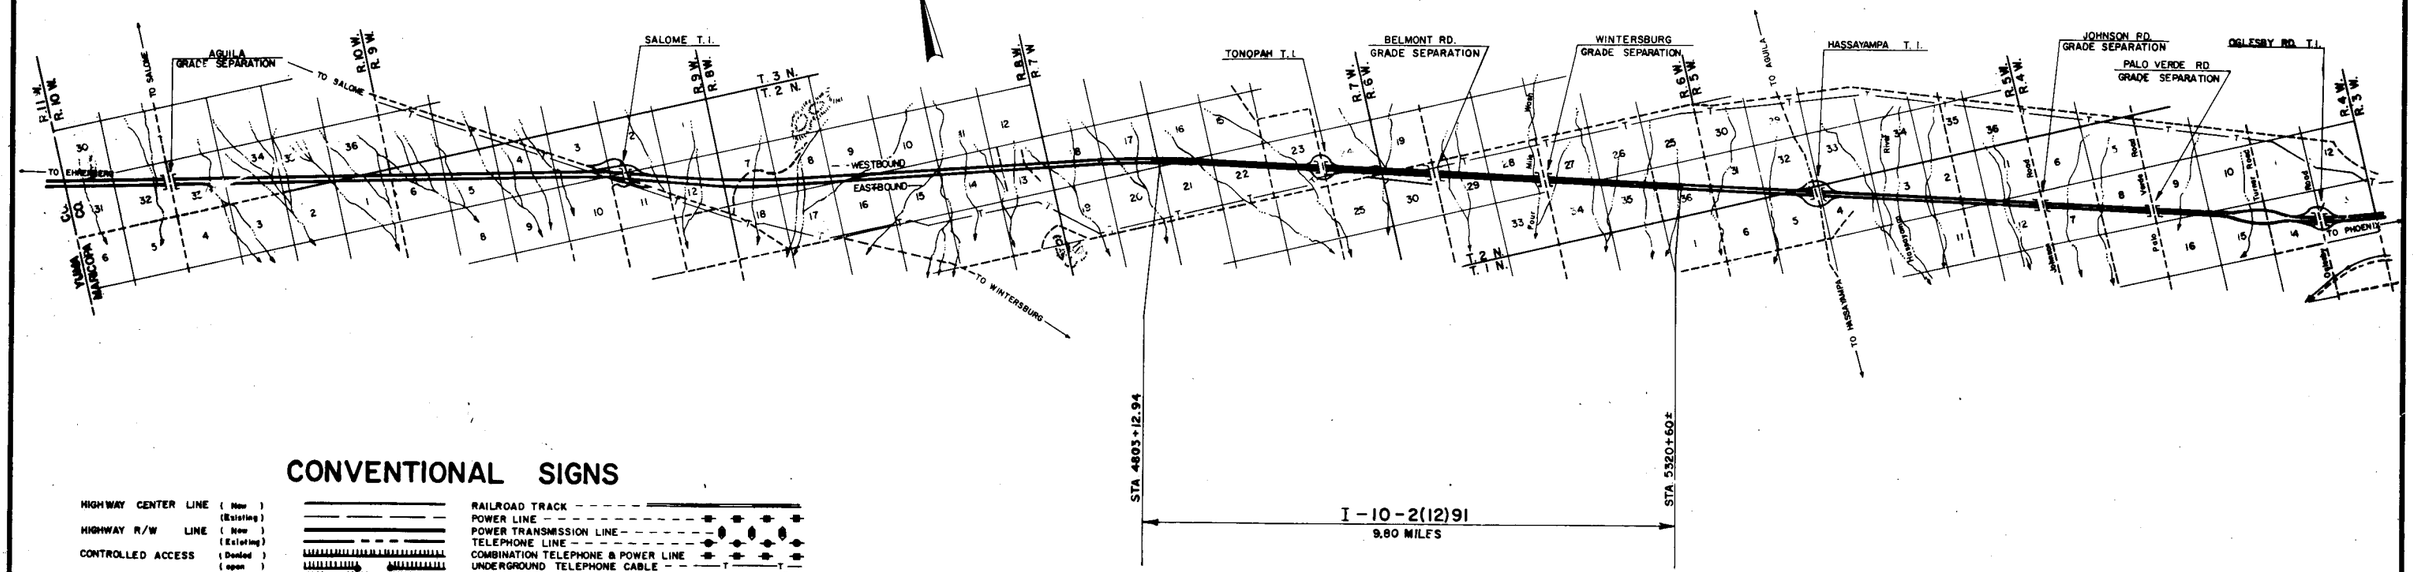

CONVENTIONAL SIGNS

HIGHWAY CENTER LINE (New) (Existing)
HIGHWAY R/W LINE (New) (Existing)
CONTROLLED ACCESS (Denied) (open) (Existing)
R.R. R/W COMMON to HIGHWAY R/W (Existing)
R.R. R/W LINE
TOWNSHIP and RANGE LINE
SECTION LINE
1/4 LINE or MID. SEC. LINE
1/16 LINE
PROPERTY LINE (not part of a Subdivision)
SUBDIVISION or LOT LINE
ORIGINAL LOT LINE
STATE and NATIONAL BOUNDARIES
COUNTY LINE
CITY LIMITS
LAND GRANTS BOUNDARIES
FOREST, NATIONAL MONUMENTS, MILITARY BASES and INDIAN RESERVATION
SURVEY MEANDER LINE
NEW R/W CONTROL POINT
EXISTING R/W CONTROL POINTS
EXISTING R/W MARKER
PARCEL NUMBER (7-001)

RAILROAD TRACK
POWER LINE
POWER TRANSMISSION LINE
TELEPHONE LINE
COMBINATION TELEPHONE & POWER LINE
UNDERGROUND TELEPHONE CABLE
WATER LINE
GAS LINE
SEWER LINE
STORM DRAIN
(Show size of line in alternate spaces)
CHAIN LINK FENCE
BARBED WIRE FENCE (call out type)
STREET LIGHT (on ext. arm)
WATER METER
WATER VALVE
FIRE HYDRANT
GAS METER
GAS VALVE
DOWN GUY
MANHOLE (existing)
ROAD (existing)
PROPERTY ANCHOR BARS
PROPERTY LIMITS ARROWS
TRAFFIC FLOW ARROWS
CANAL, CHANNEL or DITCH
BRIDGE
BOX CULVERTS
CATTLE GUARD
RIVER

Click here for I-10 Index

REDUCED SIZE
DO NOT SCALE

ARIZONA HIGHWAY COMMISSION
APPROVED FOR RIGHT-OF-WAY ACQUISITION
STATE HIGHWAY ENGINEER
DEPUTY STATE ENGINEER — DATE 2-17-66

DEPARTMENT OF COMMERCE
BUREAU OF PUBLIC ROADS
APPROVED:
DIVISION ENGINEER — DATE

EHRENBERG - PHOENIX HWY.
TONOPAH - EAST & WEST SEC.
MARICOPA COUNTY

Click here for I-10 Index

REVISIONS			
C.O.No	Date	By	Description
1106	3-21-67	R.L.R.	Added Parcel 7-161-A
1599	6-15-67	JWolley	Rev. Total Area & Remain - 7-165 & 7-168
2277	4-68	KFO	Revise Total Tract No. from 31 to 32
2548	8-13-70	D.G.M.	Completed Acquisition Record
4770	2-11-77	R.M.M.	Finalized

REVISIONS			
C.O. No.	DATE	BY	DESCRIPTION
1142	5-25-66	Hawes	Deleted 7-175 Revised 7-169 to include 7-175 Take
1175	6-28-66	D.G.M.	Deleted 7-178, Revised 7-176 To Include 7-178 Take
			Changed Ownership Of 7-162, 7-184 & 7-193-LI
1191	7-6-66	Layton	Corrected Areas of 7-169
1175	7-20-66	D.G.M.	Revised Areas Parcels 7-167, 7-168, 7-170, 7-171, 7-164
1221	8-2-66	D.G.M.	Deleted Parcel 7-172

PROJECT NO.	I-10-2(12)91
DRAWING NO.	D-7-T-689
SHEET NO.	2 of 32
DRAWN BY	J. Kratochvil
DATE COMP.	2-11-66
SCALE	

Hayes & Dashney Engineers, Inc.
CONSULTANT

CHECKED BY: John Thompson

HARD COPY

OWNERSHIP RECORD — ACQUISITION RECORD

PARCEL NUMBER	OWNER	DESCRIPTION	TOTAL AREA	AREA GROSS INCLUDING EXISTING R/W	REQUIRED NET EXCLUDING EXISTING R/W	EASEMENT AREA	REMAINDER LEFT	REMAINDER RIGHT	SHEET NUMBER	COMMISSION APPROVAL	TYPE & DATE OF INSTRUMENT	RECORDED DATE	RECORDED BOOK	RECORDED PAGE
7-161	U.S.A.	N½ Sec. 21, T.2N. R.7W.	480Ac.		497.7Ac.	2.9Ac.	101.2Ac.	326.3Ac.	6,7&8	2-15-67	Amd & Supl R/W Grant 1-13-67	2-27-67	6454	596-9
7-162	Frank B. Salisbury	N½ Sec. 22, T.2N. R.7W.	320Ac.		478Ac.	0.3Ac.	228.9Ac.	43.0Ac.	8,9&10	1-4-67	W.D. D.&O. 12-19-46	2-1-67	6419	343-6
7-163	Gerrit W. & Jennie Veurink, et ux	SE¼ Sec. 22, T.2N. R.7W. Ex. SE¼ SE¼	~~120 Ac.~~ ~~160 Ac.~~	2.0Ac.	1.9Ac.			~~118.0 Ac.~~ ~~160 Ac.~~	10	11-20-67	W.D. 11-2-67	12-8-67	6870	112-3
7-164	Ralph W. Elsner, et al	NW¼ Sec. 23, T.2N. R.7W.	160Ac.	2.4Ac.	2.3Ac.	2,225.5 Sq.Ft.	~~137.5 Ac.~~ ~~155.2 Ac.~~		10&11	2-15-67	W.D. 12-19-66 D&O 12-13-66	3-27-67	6495	365-70
7-165	James R. Carter, Jr., et al	N½ SW¼ Sec. 23, T.2N. R.7W.	80Ac.		19.2Ac.	0.3Ac.	8.7Ac.	51.8Ac.	10&11	10-28-66	W.D. D&O 9-20-66	11-22-66	6317	30-33
7-166	Transamerica Title Ins. Co. as Trustee	Pt. W½ SE¼ Sec. 23, T.2N. R.7W.	75Ac.		10.0Ac.	0.8Ac.	18.3Ac.	45.9Ac.	11&26	12-13-66	W.D. 11-29-66 D&O. 2-20-67	1-18-67 3-13-67	6398 6478	52-53 627-0
7-167	Murray Friedlander, et ux	E½ SE¼ Sec. 23, T.2N. R.7W.	80Ac.	33.2Ac	~~37.2 Ac~~ ~~33.3 Ac~~	0.2Ac.	16.5Ac.	~~30.1 Ac~~ 30.0 Ac.	11,12&26	10-28-66	W.D. D&O 9-15-66	11-22-66	6317	651-4
7-168	Gerrit W. Veurink et ux	N½ SW¼ Sec. 24, T.2N. R.7W.	~~150 Ac.~~ ~~160 Ac.~~	16.1Ac	15.1 Ac ~~16.1 Ac~~	0.2Ac.	133.7 Ac. ~~149.1 Ac~~		12,13&26	11-20-67	W.D. D&O 11-2-67	12-8-67	6870	112-5
7-169	Davis Beauchamp et ux	Pt. N½ Sec. 25 & Pt. SW¼ Sec. 24, T.2N. R.7W	~~304.3 Ac.~~ ~~339.5 Ac.~~	~~39.2 Ac~~ ~~33.3 Ac~~	~~35.9 Ac~~ ~~33.5 Ac~~	0.8Ac.	T.9 ~~7.4 Ac.~~	~~265.8 Ac.~~ ~~299.2 Ac.~~	12,13&26	10-14-66	W.D. D&O 9-28-66	11-10-66	6302	654-7
7-170	Davis Beauchamp et ux	S½ SW¼ Sec. 24, T.2N. R.7W.	2 Ac.	2.0Ac	~~1.9 Ac~~ ~~2.0 Ac~~				12&26	12-13-66	WD 10-26-66	1-23-67	6404	678
7-173	Davis Beauchamp et ux	S½ SW¼ Sec. 24, T.2N. R.7W.	5.1Ac.		0.1Ac.			5.0Ac.	12,13&26	10-14-66	W.D. 9-28-66	11-10-66	6302	658-9
Deleted 8-2-66 Co. 1221 7-172	~~Gladys Williams & Jack E. Nelson~~	~~S½ SW¼ Sec. 24, T.2N. R.7W.~~	~~1.0Ac.~~		~~276 Sq.Ft.~~			~~1.0Ac.~~	~~12~~					
7-171	Caroline Alma Reed W/H	S½ SW¼ Sec. 24, T.2N. R.7W.	2.0Ac.	1.0Ac	0.7 Ac ~~0.8 Ac~~			1.0Ac.	12&26	11-4-69	F.O.C. 12-27-71	1-31-72	9210	780-3
* Included in parcel 7-169 * ~~7-175~~	~~Davis Beauchamp~~	~~NE¼ NE¼ Sec. 25, T.2N. R.7W.~~	40Ac.	Deleted	~~5-25-66~~			95.1Ac.	~~12~~					
7-176	Melvin Taylor et ux.	Lot 4, Sec. 19, W½ NW¼ Sec. 29, NE¼ Sec. 30, T.2N. R.6W.	~~396.4 Ac.~~ ~~456.4 Ac.~~	2.4Ac.	35.1Ac. ~~40 Ac.~~	4.3 Ac.	~~193.3 Ac.~~ 230.7 Ac.	104.9Ac.	14,15,16&25	9-30-68	F.O.C. 11-12-68	4-8-69	7553	749-53
*** Included in Parcel 7-176 *** ~~7-178~~	~~Melvin R. Taylor et ux~~	~~W½ NW¼ Sec. 29 & NE¼ Sec. 30 T.2N. R.6W.~~	~~240Ac.~~	Deleted C.O. No. 1178	~~34.1Ac.~~		~~101.0Ac.~~	~~104.9Ac.~~						
7-179	Robt. & Ruby Hamilton H/W et al	E½ NW¼ Sec. 29, T.2N. R.6W.	80Ac.		9.7Ac.	0.6Ac.	54.9Ac.	14.8Ac.	16&17	11-22-66	W.D. D.&O. 11-11-66	12-15-66	6351	282-5
7-180	Jewell Turner et ux et al	NE¼ Sec. 29 T.2N. R.6W.	320Ac.		12.7Ac.	1.7Ac.	301.9Ac.	3.7Ac.	17&18	2-28-67	W.D. D&O 1-18-67	5-29-67	6586	69-72
7-181	Transamerica Title Ins. Co. as Trustee	N½ SE¼ Sec. 29, T.2N. R.6W.	80Ac.		8.7Ac.		73.0Ac.	0.9Ac.	17&18	12-13-66	WD. 11-18-66	1-12-67	6390	291-2
7-182	Alan N. Schreiner et al	NW¼ SW¼ Sec. 28, T.2N. R.6W.	40Ac.		9.7Ac.		8.0Ac.	22.3Ac.	18	9-2-66	W.D. 8-10-66	9-29-66	6240	58-59
7-183	Betty R. Reynolds	E½ SW¼ Sec. 28, T.2N. R.6W.	80Ac.		9.7Ac.	0.5Ac.	18.4Ac.	51.4Ac.	18&19	8-19-66	W.D. D&O 8-5-66	9-29-66	6240	55-57
7-184	A.D.R. Development Co. et al	SE¼ Sec. 28 T.2N. R.6W.	160Ac.		21.9Ac.	2.3Ac.	65.6Ac.	70.2Ac.	19&20	6-26-70	F.O.C. 1-25-71	2-26-71	8552	301-5
7-186	George S. Rodgers et ux	SW¼ SW¼ & W½ SE¼ SW¼ Sec. 27, T.2N. R.6W.	60Ac.		16.2Ac.	1.2Ac.	18.6Ac.	24.0Ac.	20	10-14-66	W.D. D&O 9-21-66	11-9-66	6299	89-92
7-187	Jane Evans Deering W/H et al	N½ SW¼ & E½ SE¼ SW¼ Sec. 27, T.2N. R.6W.	100Ac.		6.2Ac.		90.5Ac.	3.3Ac.	20&21	10-14-66	W.D. 10-3-66	11-9-66	6299	93-94
7-189	Forney E. Kennedy et al	W½ SE¼ Sec. 27, T.2N. R.6W.	80Ac.	7.4Ac.	6.7Ac.		71.9Ac.	0.7Ac.	21	3-26-71	F.O.C. 5-27-71	6-23-71	8777	217-9
7-191	Russell Sanford Keller et ux	SE¼ SE¼ Sec. 27, T.2N. R.6W.	40Ac.	0.4Ac.	0.2Ac.	** 0.4Ac.	39.2Ac.		21	10-14-66	W.D. D&O 9-30-66	11-15-66	6307	370-3
7-190	First Nat. Bank of Ariz. Trustee	W½ NE¼ Sec. 34, T.2N. R.6W.	80Ac.		2.3Ac.			77.7Ac.	21	10-14-66	W.D. 9-23-66	11-15-66	6307	368-9
7-192	Louis Allan Fulton et al	E½ NE¼ Sec. 34, T.2N. R.6W.	80Ac.		9.4Ac.	0.5Ac.	2.5Ac.	67.6Ac.	21	12-13-66	W.D. D&O 10-10-66	1-16-67	6394	41-46
7-193	State of Arizona	Sec. 35, T.2N. R.6W.	640Ac.		38.7Ac.	1.27 Ac.	116.0Ac.	484.0Ac.	21,22&25	6-7-68	Amd. 7-15-68 R/W Grant 7-1-68	8-6-68 Not Recorded	7210	732-4
7-188	William H. Shafer et al	NW¼ NW¼ Sec. 34 T.2N. R.6W.	160Ac.		0.1Ac.			159.9Ac.	20	5-2-67	W.D. 10-11-66	5-23-67	6578	499-501
7-185	Joe V. Adair et ux	NE¼ NE¼ Sec. 33, T.2N. R.6W.	160Ac.		0.1Ac.			159.9Ac.	20	10-14-66	W.D. 9-23-66	11-15-66	6307	367
7-193-LI	Phoenix Title & Trust Co. Trustee G.L. 3130	E½ NE¼ Sec. 35, T.2N. R.6W. W½ NE¼ & NW¼ Sec. 35, T.2N. R.6W.	80Ac. 560Ac.						23		See Parcel No. 7-193			
7-161-A	U.S.A.	E½ Sect. 36, T2N R6W	640Ac.		19.5Ac.	6.4	296.7Ac.	323.8Ac.	23&24	4-5-68	Amd & Supl R/W Grant 2-20-68	5-10-68	7089	976-9

FINALIZED

** Includes 0.1 Ac. of Roadway Easement

REDUCED SIZE DO NOT SCALE

EHRENBERG - PHOENIX HWY.
TONOPAH - EAST & WEST SEC.
MARICOPA COUNTY

Click here for I-10 Index

REVISIONS			
C.O.No.	Date	By	Description
2548	8-13-70	D&M	Completed Aguaviva Reard.
3415	11-6-72	D&M	Added Parcel 7-184-1-A, Revised Areas Par: 7-184-1
3597	6-8-73	PMcM	Add. Parcels 7-167-1, 7-168-1, 7-171-B, 7-173-1-A.
"	"	"	Added Excess R/W Note to Parcel 7-171-B
3684	10-1-73	W.D.S.	Revised Nat Par. 7-171-B to Access Control
"	"	"	Deleted Par. 7-173-1-A & 7-168-1.
3784	12-26-73	WDS	Revised Owner Par. 7-167-1 & 7-171-B, Added 7-167-1-LI
4770	2-11-77	R.M.M.	Finalized

REVISIONS			
C.O.No.	DATE	BY	DESCRIPTION
2277	4-69	N.I.D.	New Sheet Add'l R/W. Added Suffix
			Parcels Nos. as listed
2356	8-28-69	A.W.B.	Revised Ease. & Perm. Ltr. on Par. 7-162-A
2406	9-12-69	J. Nez	Added Sec. No. 27 to Par. 7-187-A.
2417	10-31-69	J. Nez	Added Comp. date 5-5-69 to Title Block.
2487	12-11-69	E.U.T.	Added Par. 7-162-1.
2514	1-21-70	M.C.	Revised Area for Ease & Par. 162-1
2569	4-9-70	R.J.T.	Par. 7-162-1, Removed Gross Area, Revised Ease Area

PROJECT NO.	I-10-2(12)91
DRAWING NO.	D-7-T-689
SHEET NO.	3 of 32
DRAWN BY	Joan Kratochvil
DATE COMP.	5-5-69
SCALE	
CONSULTANT	Hayes & Dashney Engineers, Inc.

CHECKED BY. Dennis Li Gendlo

HARD COPY

OWNERSHIP RECORD — ACQUISITION RECORD

PARCEL NUMBER	OWNER	DESCRIPTION	TOTAL AREA	AREA REQUIRED GROSS INCLUDING EXISTING R/W	AREA REQUIRED NET EXCLUDING EXISTING R/W	EASEMENT AREA	REMAINDER LEFT	REMAINDER RIGHT	SHEET NUMBER	COMMISSION APPROVAL	TYPE & DATE OF INSTRUMENT	RECORDED DATE	RECORDED BOOK	RECORDED PAGE
7-161-B	U.S.A. (B.L.M.)	Pt. N½ Section 21, T.2N. R.7W.	430.3Ac.			2.3Ac.	99.5Ac.	325.7Ac.	7&8	4-24-70	Grant 4-1-70	Not Recorded		
7-162-1	Minnesota Title Co., Arizona Corp. Trust #112	Pt. W. Phx. Estates Unit III Sec. 22. T.2N.R.7W.	11,857,032.0			93,000 ☐	9,890,952.8 ☐	1,873,080.8 ☐	8, 9 & 10	5-22-70	D.f.D.E. 5-6-70	6-18-70	8183	13-14
7-164-A	Ralph W. Elsner, et ol	Pt. NW¼ Section 23, T.2N. R.7W.	157.5Ac.	0.1 Ac.		0.4 Ac.	157.1 Ac.		10	2-27-70	D.f.D. 10-27-69	4-13-70	8086	459-62
7-165-A	James R. Carter Jr. et al	Pt. N½ SW¼ Section 23, T.2N. R.7W.	80.8Ac.	0.3 Ac.		0.8 Ac.	8.3 Ac.	51.4 Ac.	10	3-19-69	D.f.D. 8-21-69	11-28-69	7889	440-1
7-166-1	John F. Davis, s/s	Pt. W½ SE¼ Section 23, T.2N. R.7W.	65.0Ac.	0.8 Ac.		3.5 Ac.	15.8 Ac.	44.9 Ac.	11	12-19-69	D.f.D. 11-28-69	2-6-70	7990	950-1
7-167-A	Jeane Friedlander, a widow	Pt. E½ SE¼ Section 23, T.2N. R.7W.	46.8Ac.	0.5 Ac.	0.3 Ac.		16.3 Ac.	30.0 Ac.	12 & 26	11-4-69	W.D. 8-26-69	1-13-70	7952	987-8
7-168-A	Gerrit W. Veurink, et ux	Pt. N½ SW¼ Section 24. T.2N. R.7W.	133.9 Ac.	0.4 Ac.	0.2 Ac.	0.3 Ac.	133.2 Ac.		12 & 26	11-4-69	W.D. D.f.D. 9-17-69	1-13-70	7952	989-91
7-169-A	Davis Beauchamp, et ux.	Pt. S½ SW¼ Section 24, T.2N. R.7W.	264.5Ac.	0.8 Ac.		0.8 Ac.	7.9 Ac.	255.0 Ac.	13 & 26	11-4-69	D.f.D. 9-8-69	1-13-70	7952	977-8
7-171-A	Caroline Alma Reed, W/H	Pt. S½ SW¼ Section 24, T.2N. R.7W.	1.0 Ac.		0.1 Ac.		0.9 Ac.		12 & 26	11-4-69	F.O.C. 12-27-71	1-31-72	9210	780-3
7-173-1	Gladys Williams & Jack E. Nelson	Pt. S½ SW¼ Section 24, T.2N. R.7W.	1.0 Ac.	4915 F.	1655 F.		0.9 Ac.		12 & 26	11-4-69	W.D. 9-19-69	1-13-70	7952	995-6
7-174-1	Vivian P. Rybaczyk, s/s	Pt. SE¼ Section 24, T.2N. R.7W.	156.6Ac.	1.5 Ac.		1.8 Ac.	124.4 Ac.	8.9 Ac.	13 & 14	11-4-69	D.f.D. 9-26-69	1-13-70	7952	979-80
7-176-A	Melvin Taylor et ux	Pt. W½ NW¼ Sect. 29 & Pt. NE¼ Sect. 30, T.2N. R.6W.	359.9 Ac.	6.5 Ac.	2.2 Ac.		249.5 Ac.	103.9 Ac.	16 & 25	12-19-69	W.D. 9-26-69	1-22-70	7967	197-8
7-180-A	Jewell Turner et ux	Pt. NE¼ Section 29, T.2N. R.6W.	307.3 Ac.	1.7 Ac.		1.1 Ac.	301.4 Ac.	3.1 Ac.	17	11-4-69	D.f.D. 8-6-69	1-13-70	7952	993-4
7-183-A	Betty R. Reynolds	Pt. E½ SW¼ Section 28, T.2N. R.6W.	70.3 Ac.	0.5 Ac.		0.6 Ac.		50.8 Ac.	19	11-4-69	D.f.D. 9-18-69	1-13-70	7952	985-6
7-184-1	William Sarina, et ux et al	Pt. SE¼ Section 28, T.2N. R.6W.	138.1 Ac.	3.2 Ac.	0.9 Ac.	~~2.2 Ac.~~ 2.0 Ac.	~~68 Ac.~~ 65.0 Ac.	67.9 Ac.	19 & 20	10-6-72	F.O.C. 2-26-73	3-29-73	10066	1096-1100
7-185-A	Joe V. Adair et ux	Pt. NE¼ NE¼ Section 33, T.2N. R.6W.	159.9 Ac.		850 S.F.			159.8 Ac.	20	9-19-69	W.D. 8-11-69	11-28-69	7889	442
7-186-1	Senoma J. Smith, s/s	Pt. S½ SW¼ Section 27, T.2N. R.6W.	43.8 Ac.	1.9 Ac.	0.7 Ac.	0.6 Ac.	18.0 Ac.	23.3 Ac.	20	8-22-69	W.D. D.f.D. 8-8-69	11-22-69	7836	922-5
7-187-A	Jane Evans Deering W/H et al	Pt. SW¼ Section 27, T.2N. R.6W.	93.8 Ac.		0.4 Ac.		90.1 Ac.	3.3 Ac.	20	3-19-69	W.D. 8-7-69	11-28-69	7889	443-5
7-188-A	William H. Shafer et al	Pt. NW¼ NW¼ Section 34, T.2N. R.6W.	159.9 Ac.		850 S.F.			159.8 Ac.	20	12-4-69	W.D. 3-13-69 W.D. 10-15-69	2-6-70	7990	344-3 942-3
7-191-A	Russell Sanford Keller et ux	Pt. SE¼ SE¼ Section 27, T.2N. R.6W.	39.6Ac.	0.4 Ac.		0.4 Ac.	38.8 Ac.		21	11-4-69	W.D. 9-19-69	1-13-70	7952	981-2
7-192-A	Louis Allen Fulton et al	Pt. E½ NE¼ Section 34, T.2N. R.6W.	70.6 Ac.	0.5 Ac.		1.1 Ac.	2.3 Ac.	66.7 Ac.	21	11-4-69	D.f.D. 8-22-69	1-13-70	7952	983-4
7-181-A	Transamerica Title Ins. Co. as Trustee et. ux	Pt. N½ SE¼ Section 29. T.2N. R.6W.	733 Ac.			0.2 Ac.	0.3 Ac.	72.8 Ac.	17	4-24-70	F.O.C. 11-6-70	12-16-70	8445	15-17
7-193-A	State of Arizona (SLD)	Pt. Sec. 35 T.2N. R.6W.	601.3 Ac.	1.3 Ac.		0.2 Ac.	116.0 Ac.	483.8 Ac.	22	9-19-69	R/W Grant 10-30-69	Not Recorded		
7-193-A-LI	Transamerica Title Ins. Co. Gr. Lease 3130	Pt. Sec. 35 T.2N. R.6W.	601.3 Ac.						22		See Parcel No. 7-193-A			
7-184-1-A	William Sarina, et ux	Pt. SE¼ Section 28, T.2N., R.6W.	132.9 Ac.			0.2 Ac.	64.8 Ac.	67.9 Ac.	19 & 20	5-9-75	Ease. 2-8-75	6-12-75	11199	1351 1332
7-167-1	Charles D. Friedlander, et ux	Pt. of E½ SE¼ Sec. 23, T.2N. R.7W.		Access Control Only					12	4-5-74	Q.C.D. 1-14-74	5-7-74	10642	204
~~7-168-1~~	~~Firle J. Wiltins, et al~~	~~Pt. N½ SW¼ Sec. 24, T.2N. R.7W.~~		~~Access Control Only~~		Deleted 10-1-73			~~12~~					
7-171-B	Jack D. Lowe, s/s	Pt. S½ SW¼ Sec. 24, T.2N. R.7W.	~~Cor~~	Access Control Only	~~Cor~~				12	5-10-74	Q.C.D. 1-23-74	6-12-74	10694	1396
~~7-173-1-A~~	~~Gladys Williams, et al~~	~~Pt. S½ SW¼ Sec. 24, T.2N. R.7W.~~		~~Access Control Only~~		Deleted 8-23-73			~~12~~					
7-167-1-LI	Standard Oil Company of Cal., a lessee	Pt. E½ SE¼ Sec. 23, T.2N., R.7W.		Access Control Only					12	4-5-74	Part. Rel. of Lease 1-29-74	5-7-74	10642	205-6

FINALIZED

REDUCED SIZE DO NOT SCALE

EHRENBERG - PHOENIX HWY.
TONOPAH - EAST & WEST SEC.
MARICOPA COUNTY

CURVE DATA					
CURVE	SIMPLE CURVE A	D	R	L	T
Ⓐ Ⓑ & Ⓒ	3°23'59" Rt.	0°10'00"	34,377.48'	2,039.83'	1,020.22'

REVISIONS				PROJECT NO.	I-10-2(12)91
C.O. No.	DATE	BY	DESCRIPTION	DRAWING NO.	D-T-T-689
2277	4-5-68	A.H.D.	Added New R/W & New O.E.s; Showed Excess D.E.	SHEET NO.	4 of 32
2356	8-28-68	A.W.B.	Cut back Drain. Ease. Lt. 4857±.	DRAWN BY	J. Kratochvil
2417	9/16/69	R.L.R.	Revised D.E. Lt. 4786+00 & Added "End Const. Proj. I-10-2(10)81"	DATE COMP.	2-11-66
2487	12-18-69	E.U.T.	Added West Phx. Estates Unit III Subdivision & Revised Drain. Ease. Lt. 4900±.	SCALE	1" = 1000'
4770	2-11-77	R.N.M.	Finalized	CONSULTANT	Hayes & Dashney Engineers, Inc.

FINALIZED

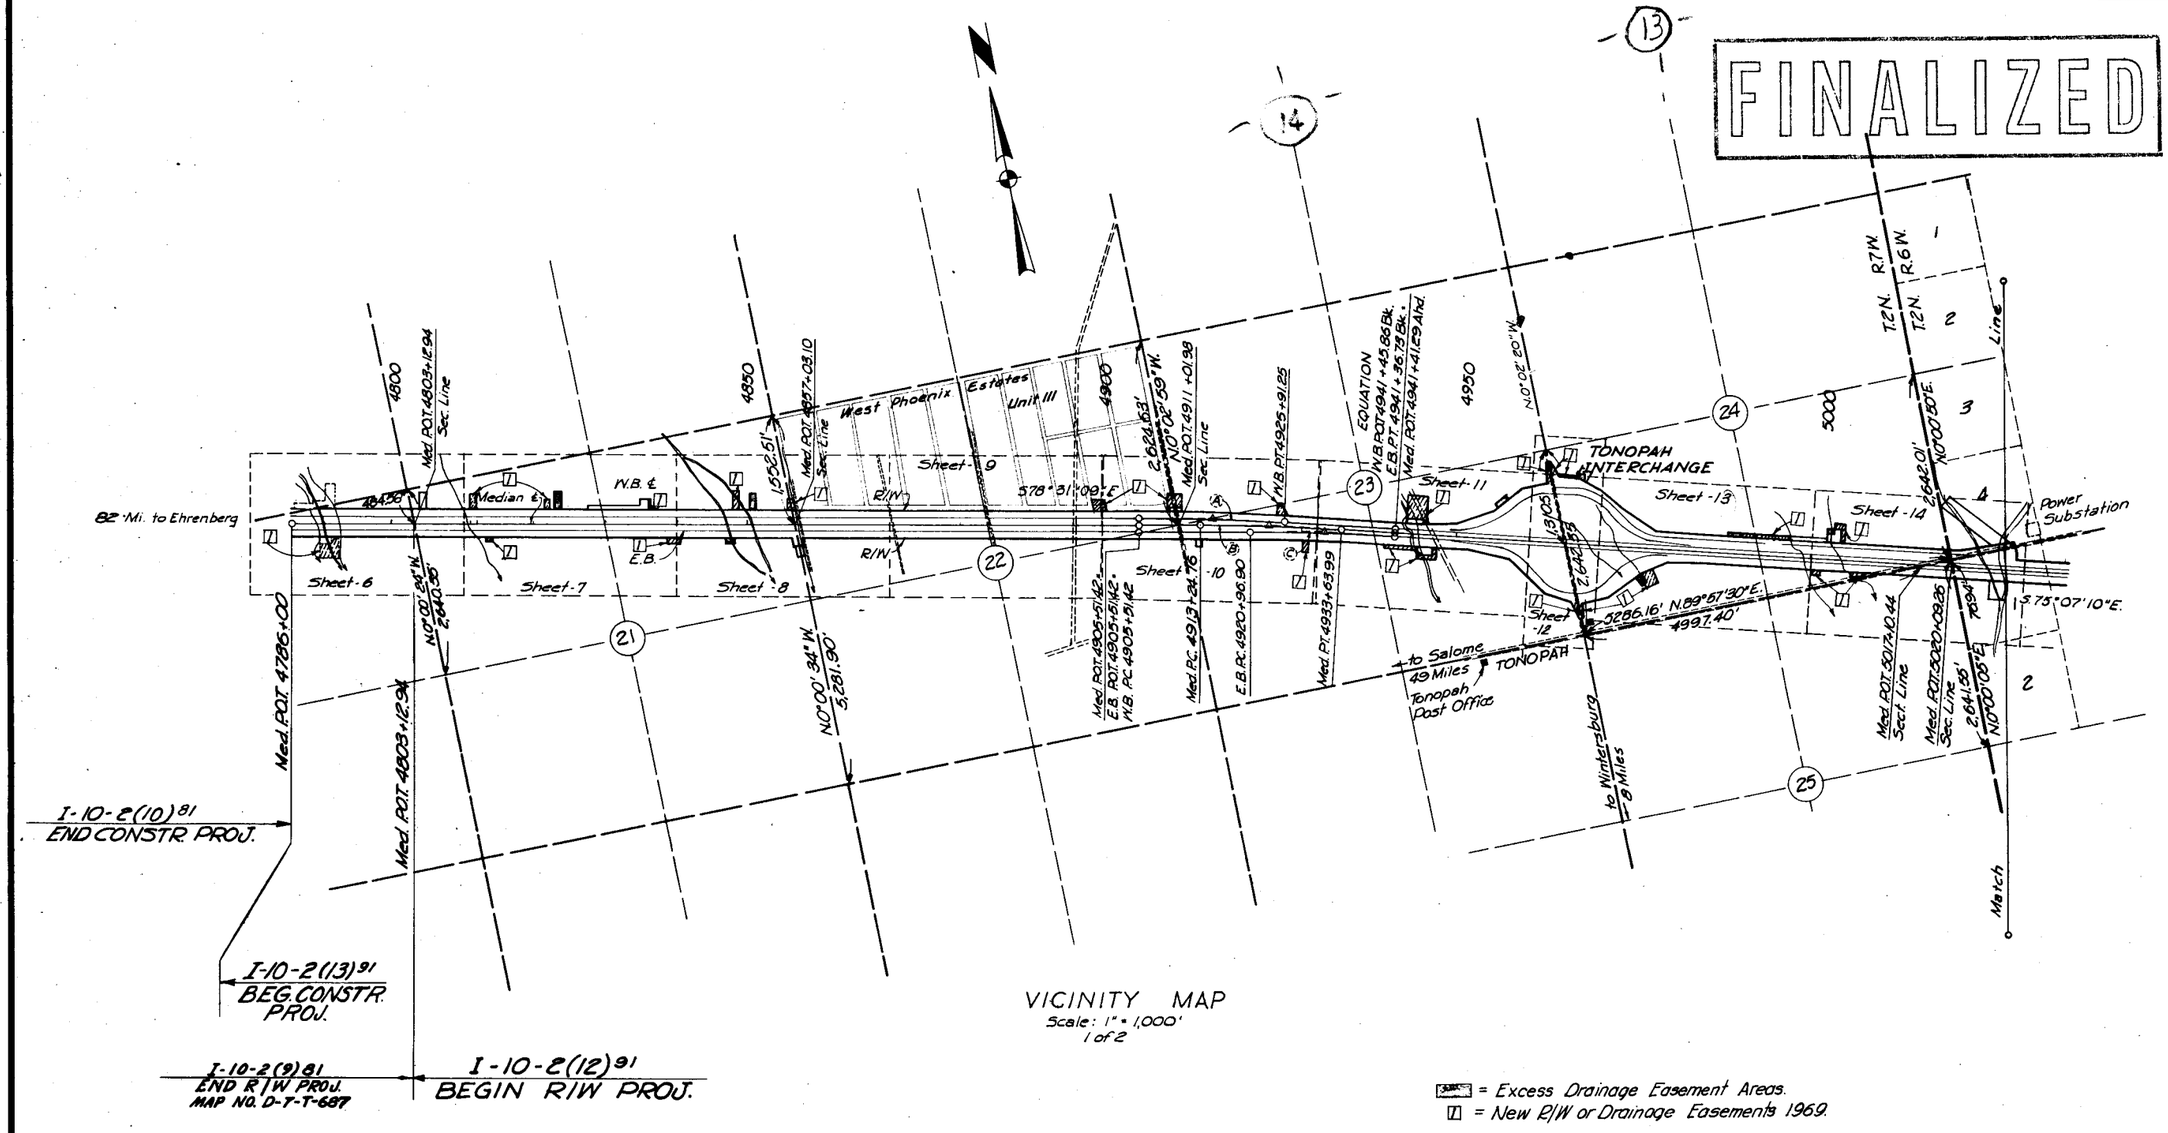

VICINITY MAP
Scale: 1" = 1,000'
1 of 2

= Excess Drainage Easement Areas.
= New R/W or Drainage Easements 1969.

REDUCED SIZE DO NOT SCALE

Click here for I-10 Index

HARD COPY 6319 M-10 CHECKED BY

EHRENBERG - PHOENIX HWY.
TONOPAH - EAST & WEST SEC.
MARICOPA COUNTY

Click here for I-10 Index

REVISIONS			
C.O. No.	DATE	BY	DESCRIPTION
1806	3-21-67	R.L.R.	Added Sheet 23 & Changed R/W Project Ending to Sta 5320+60 P.C.
2217	9-69	H.T.D.	Added New R/W & New D.E.'s; Excess D.E.s.
2417	9/1968	R.L.R.	Added Beg. Const. Proj. I-10-2(16)101
3525	3-23-73	W.O.S.	Added New Drain. Ease. (1973) and Note
4770	2-11-77	R.M.M.	Finalized

PROJECT NO.	I-10-2(12)91
DRAWING NO.	D-7-T-689
SHEET NO.	5 of 32
DRAWN BY	J. Kratochvil
DATE COMP.	2-11-66
SCALE	1" = 1,000'
CONSULTANT	Hayes & Dashney Engineers, Inc.

FINALIZED

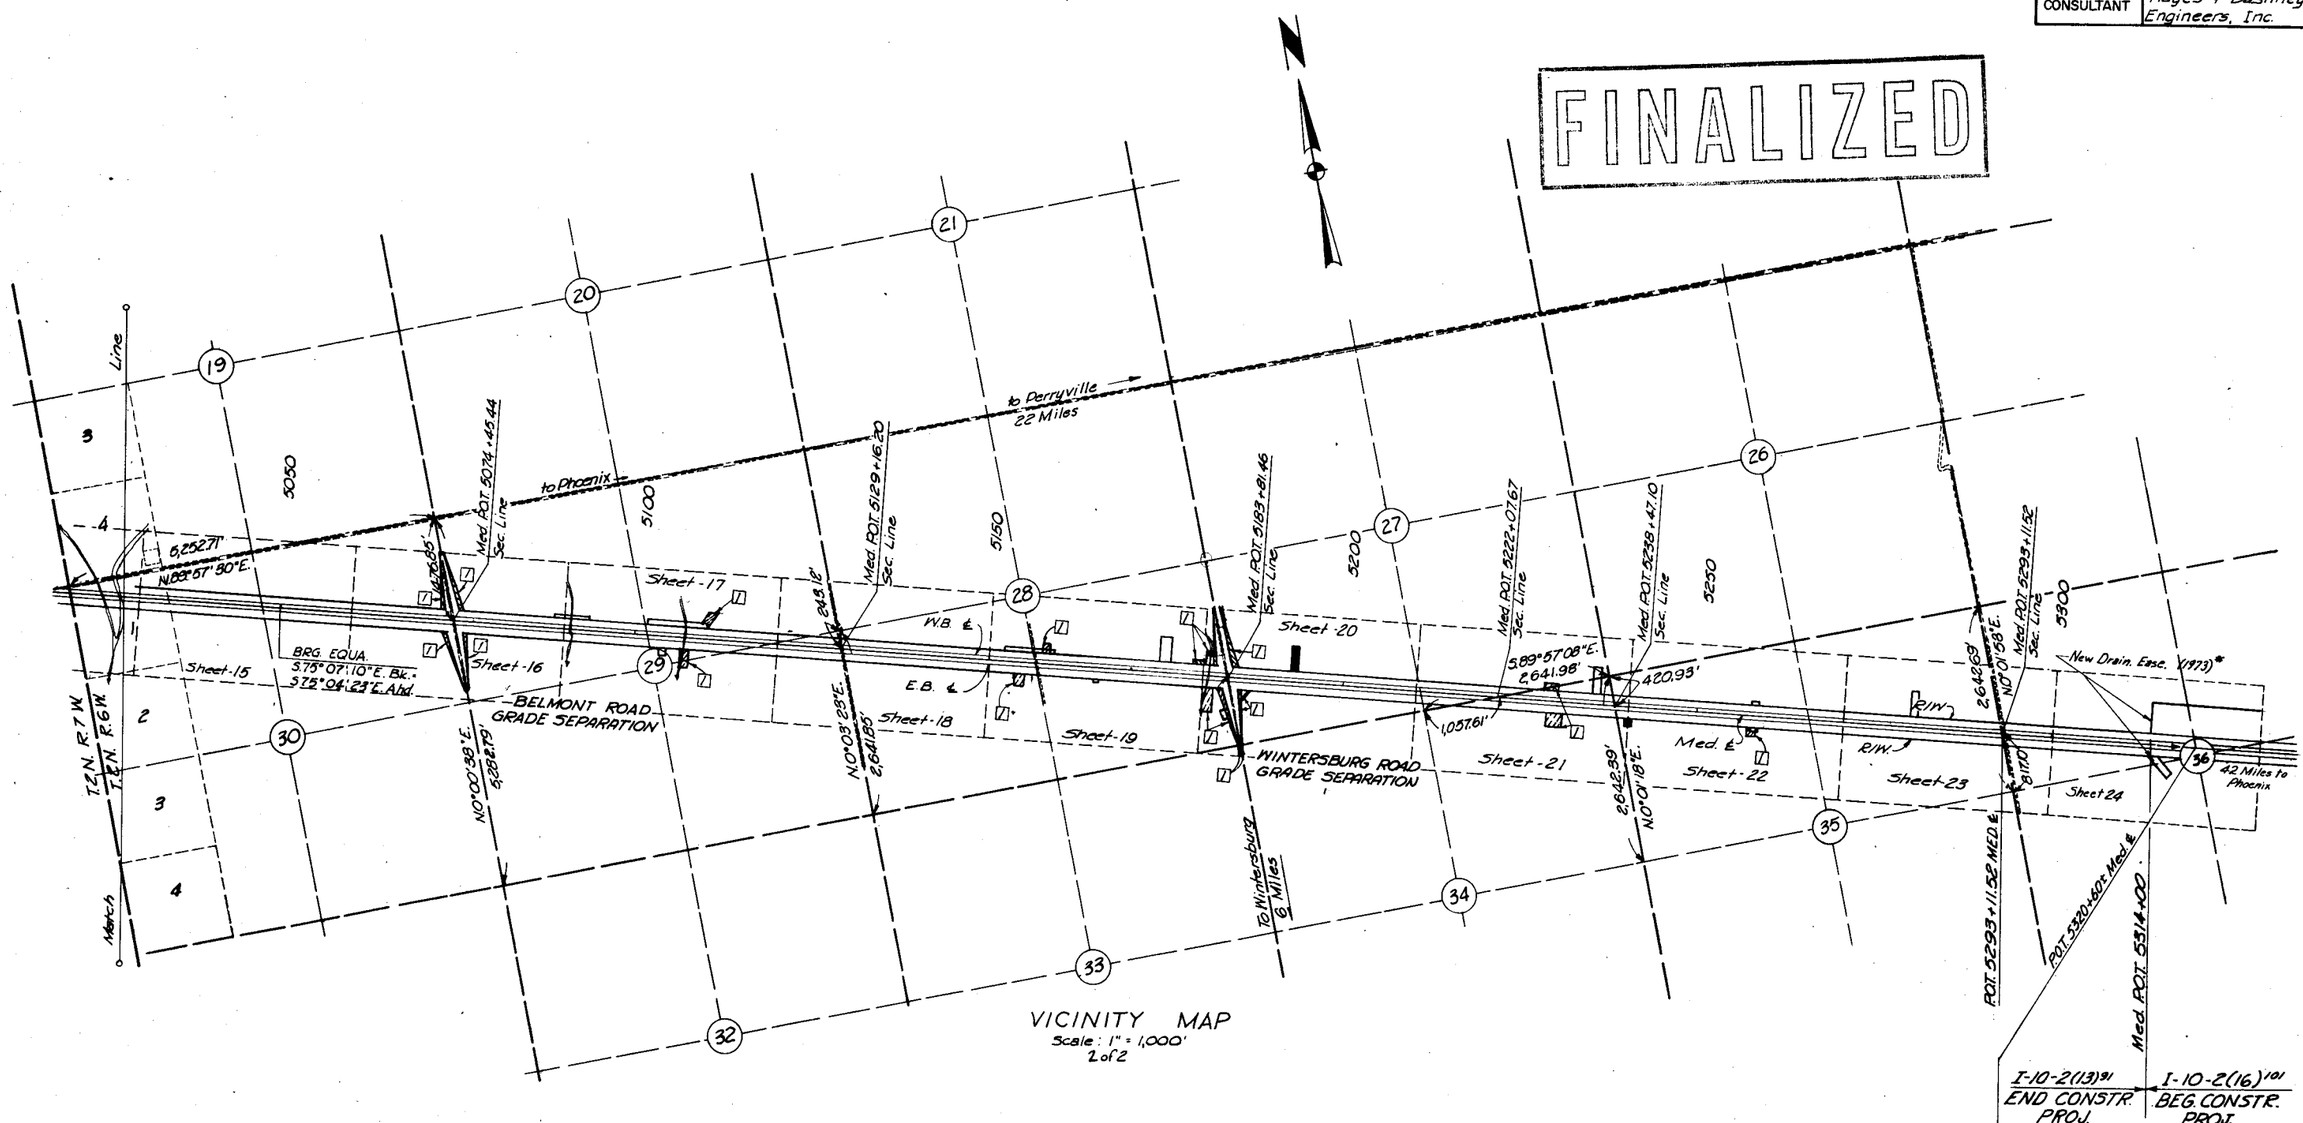

VICINITY MAP
Scale: 1" = 1,000'
2 of 2

▨ = Excess Drainage Easement Areas.
▯ = New R/W or Drainage Easements 1969
* NOTE: New Drain. Ease. (1973) To Be Acquired Under R/W Project I-10-2(15)

I-10-2(13)91 END CONSTR. PROJ. — I-10-2(16)101 BEG. CONSTR. PROJ.

I-10-2(12)91 END R/W PROJ. — I-10-2(15)101 BEGIN R/W PROJ.

REDUCED SIZE DO NOT SCALE

HARD COPY 6319 M-11 CHECKED BY: John Stringer

EHRENBERG - PHOENIX HWY.
TONOPAH - EAST & WEST SEC.
MARICOPA COUNTY

Click here for I-10 Index

REVISIONS			
C.O. No.	DATE	BY	DESCRIPTION
2227	7-16-69	H & D.	Revised D. Ease., box culv., pipe culv., Stds.
2417	10-27-69	J. Nez	Changed Drain. Ease. Lt. Sta. 4786+00 and Rt. 4789+25
"	"	"	to be New Drain. Ease - 1969 & Added note "May
			under R/W Proj. I-10-2(12)91" Clarified
			R/W & Const. Proj. Boundaries.
4770	2-11-77	R.M.M.	Finalized

PROJECT NO.	I-10-2(12)91
DRAWING NO.	D-7-T-689
SHEET NO.	6 of 32
DRAWN BY	J. Kratochvil
DATE COMP.	2-11-66
SCALE	1" = 100'
CONSULTANT	Hayes & Dashney Engineers, Inc.

CHECKED BY _____ 63/9 M.10 _____ HARD COPY

FINALIZED

T 2 N R 7 W

S.E. 1/4 S.E. 1/4

S.W. 1/4 S.E. 1/4

S.W. 1/4 S.W. 1/4

N.W. 1/4 N.E. 1/4

N.E. 1/4 N.E. 1/4

N.W. 1/4 N.W. 1/4

7-161

New #2 Gate, Std. C-12.01

W.B. Sta. 4789+42.00 to 4790+07.83
New 6-10'x5'x64'-6" Box Culv.
Std. C1-10-6 & CW-1
New Outlet Apron Rt.

50'x250' Drain. Ease.

450' Lt. W.B. 4790+25

Exist. Drainage Easement 1966

450' Lt. W.B. 4791+50

100' Lt. W.B. 4791+50

200' Lt. W.B. 4790+25

4788+50

4786+00

4785

4790

4795

4800

New 5 Wire Fence
Std. C-12.01 & C-12.02

Approx. Sec. Line

Fd. Sec. Cor.
2" I.P. & Brass Cap
U.S.G.L.O. 1914

16

17

20

21

484.56'

New Drainage Easement 1966

4804+00

4805+00

250'

250'

W.B. Sta. 4804+05
New 2-36"x112' Pipe Culv.
Skew 25° Lt.

New R/W 1966

Slope Limits

Exist. R/W

W.B. Constr. ℄

Median ℄ Survey ℄

S.78° 31' 09" E.

E.B. Constr. ℄

BEARING EQUATION: S.78° 33' 59" E. Bk. = S.78° 31' 09" E. Ahd.

200'
100'
100'
200'

W.B. Sta. 4800+90
New 2-36"x150' Pipe Culv.
Skew 30° Lt.

E.B. Sta. 4805+00
New 2-36"x102' Pipe Culv.
Skew 25° Lt.

E.B. Sta. 4802+00
New 2-36"x120' Pipe Culv.
Skew 30° Lt.

2640.35'

N.0°00'24"W.

Fd. 1/4 Cor.
1" I.P. & Brass Cap
U.S.G.L.O. 1914

Match Line

New #2 Gate, Std. C-12.01

100'

4789+250

1966 Exist. Drainage Easement

4791+000

100'

300'

4792+250

E.B. Sta. 4789+42.00 to 4790+07.83
New 6-10'x5'x53'-0" Box Culv.
Std. C1-10-6 & CW-1
New Outlet Apron Rt.

E.B. & W.B. STA. 4786+00
END CONST. PROJ. I-10-2(10)81

BEG. CONST. PROJ. I-10-2(13)91

Approx. 1/16 Line

New 300'x300' Drainage Easement, 1969
To be Acqd. Under R/W Proj. I-10-2(9)91

Sect. Line ℄
MED. P.O.T. 4803+12.94
END R/W PROJ. I-10-2(9)81

BEG. R/W PROJ. I-10-2(12)91

REDUCED SIZE DO NOT SCALE

EHRENBERG - PHOENIX HWY
TONOPAH - EAST & WEST SEC.
MARICOPA COUNTY

REVISIONS			
C.O No.	DATE	BY	DESCRIPTION
2277	4-69	H.&D.	Rev. Drain. Easmts, culverts, stds. Added Parcel 7-161-B
2545	3-1970	DW.B.	Made Revisions Per Constr. Plans
4770	2-11-77	R.M.M.	Finalized

PROJECT NO.	I-10-2(12)91
DRAWING NO.	D-7-T-689
SHEET NO.	7 of 32
DRAWN BY	J. Kratochvil
DATE COMP.	2-11-66
SCALE	1" = 100'
CONSULTANT	Hayes & Dashney Engineers, Inc.

CHECKED BY: John Spurgeon

HARD COPY 6319 M10

FINALIZED

Sec. 16 / Sec. 21 Approx. Sec. Line

T2N R7W

7-161

7-161-B

N.W. 1/4 N.E. 1/4

N.E. 1/4 N.W. 1/4

S.W. 1/4 N.W. 1/4

S.E. 1/4 N.W. 1/4

S.W. 1/4 N.E. 1/4

Approx. 1/16 Line

Approx. Mid-Section Line

Match Line

Slope Limits

New R/W

W.B. Constr. ℄

E.B. Constr. ℄

Median ℄ Survey ℄

S.78° 31' 09"E.

W.B. Sta. 4811+52.26
New 10'x8'x96'-0" Box Culv.
Skew 30° Lt.
Std. C1-10-1, 30°Sk.& CW-4

New 100'x225' Drainage Ease. 1969

New No.2 Gate, Std C-12.01

W.B. Sta. 4818+68
New 6'x6'x 97'-0" Box Culv.
Skew 30° Lt.
Std. C1- -1, 30°Sk. & CW-4
New Outlet Apron, Rt.

New No.2 Gate Std. C-12.01

New 5 Wire Fence Std. C-12.01 & C-12.02

New 100'x180' Drain. Ease. 1969

New Drain. Easement 1969

W.B. Sta. 4828+85
New 42"x 134' Pipe Culv.
Skew 30° Lt.

New Drainage Easement 1969

Add'l Ease. 1969

W.B. Sta. 4836+15
New 48"x 214' Pipe Culv.
Skew 45° Lt.

New No.2 Gate, Std C-12.01

New 100'x50' Drainage Easement, 1969

E.B. Sta. 4812+67.74
New 10'x8'x 97'-0" Box Culv.
Skew 30° Lt.
Std. C1-10-1, 30° Sk. & CW-4
New Outlet Apron, Rt.

New No.2 Gate Std. C-12.01

E.B. Sta. 4819+83.47
New 6'x 6'x 97'-0" Box Culv.
Skew 30° Lt.
Std. C1-6-1, 30°Sk. & CW-4
New Outlet Apron, Rt.

E.B. Sta. 4830+00
New 42"x 116' Pipe Culv.
Skew 30° Lt.

E.B. Sta. 4838+15
New 48" x 200' Pipe Culv.
Skew 45° Lt.

New 200'x 100' Drainage Ease. 1969

P.O.T 4836+39.53
U.S.C.&G.S. Sur. Mkr.
Do Not Disturb

4810 4815 4820 4825 4830 4835 4840

4811+00 4812+67.74 4813+00 4815+00 4818+68 4819+83.47 4821+50 4822+50 4823+00 4824+00 4827+50 4830+00 4834+75 4835 4836+00 4836+25 4838+15 4838+75 4840+75

Match Line

Match Line

REDUCED SIZE DO NOT SCALE

Excess Drainage Easement

Click here for I-10 Index

EHRENBERG - PHOENIX HWY.
TONOPAH - EAST & WEST SEC.
MARICOPA COUNTY

REVISIONS				PROJECT NO.	I-10-2(12)91
C.O. No	DATE	BY	DESCRIPTION	DRAWING NO	D-7-T-689
2277	4-69	H.E.D.	Rev. Drain. Easmts, culverts, slope limits, stks. Added Parcels 7-161-B, E 7-162-A	SHEET NO.	8 of 32
2356	8-2969	A.W.B.	Cut back Drain. Ease. Lt. 4857ft. Added	DRAWN BY	J. Kratochvil
"	"	"	Irr. Ditch Lt. 4857+ to 4865+.	DATE COMP.	2-11-66
2417	10-25-69	J. Nez	Changed Sta. on New Drain. to 4840+76 and showed	SCALE	1" = 100'
"	"	"	Irrig. Wells Lt. & Rt. to be Exist and have 8" well casing.	CONSULTANT	Hayes & Dashney Engineers, Inc.
2487	12-18-69	EJT	Added West Phx. Estates Unit III subdiv.		
2487	1-13-70	P. Todd	Removed Parcel Bubble Lt. Sta. 4857+. (T-162-A)		
2514	1-27-70	MC	Added Par. T-162-I Drain. Ease.		
2943	3-18-70	dms	Revised B.C. & P.C. Lengths Add Surv. Marker		
4770	2-11-77	R.M.M.	Finalized		

CHECKED BY John Sprague

HARD COPY 6319 M10

T2N R7W

5/8" I.P. Set by Double proportion method

16 15 21 22

Exist Irrigation Well 8" Well Casing 4854+63.66 1629.84'

Ease. for Electric Line

1552.51'

West phoenix Estates

276 281 290 296 305

Exist. 4-Wire Fence Remove 303 Lin. Ft. Within R/W & Easements

New 100'x275' Drain. Ease. 1969

New Drain. Ease. New Bank Prot.

277 280

W.B. Sta. 4845+50 to 4845+97.15
New 3-10'x8'x123'-0" Box Culvert
Skew 45° Lt.
Std. C1-10-3, 45°Sk., CW-7 & CW-8
New Outlet Apron, Rt.

W.B. Sta. 4854+00
New 36"x176' Pipe Culv.
Skew 30° Lt.

2 New No. 1 Gates, Std. C-12.01

W.B. Sta. 4856+75
New 12'x10'x84' Box Culv.
Std. C1-12-1 & CW-9
Special Inlet Apron, Lt.
Outlet Apron Rt.

7-161 7-161-B 7-162-I

New Irrigation Headgate

100' Grader Rd.

278 279

New Drainage Easement - 1966

Med. Sta. 4856+62.44
200' Lt.

New Constr. Easement-1966

Conc. Lined Irr. Ditch to be constr. by others

Alfalfa Field

N.W. 1/4 N.W. 1/4

294

Exist. Conc. Lined Irrigation Ditch
Remove 1125 Lin. Ft. within New R/W

Approx. 1/16 Line

Unit III

293

Approx. 1/16 Line

292 307

7-161 N.W. 1/4 N.E. 1/4

New Bank Prot.

7-162

4.5'x1'x2' Irr. Ditch - Conc. Lined

Melon Field

Slope Limits

W.B. Constr. ℄

New 8"x410' Steel Water Line

P.O.T. 4856+67.47
U.S.C.&G.S. Surv. Marker
Do Not Disturb

Median ℄ Survey ℄

S 78° 31' 09" E.

New #2 Gate, Std. C-12.01

E.B. Constr. ℄

No Access

Slope Limits

New R/W

New Drainage Easement 1966

Med. P.O.T. 4857+03.10
Section Line

N 0°00'34" W

Med. Sta. 4857+74
New 36"x410' R.G.R.C.P.
Match Exist. Conc. Ditch

Med. Sta. 4858+20.28
200' Rt.

Reconstr. 200' Dirt Rd.

Med. Sta. 4858+36.35
279.05' Rt.

E.B. Sta. 4847+60 to 4847+97.15
New 3-10'x8'x119'-0" Box Culv.
Skew 45° Lt.
Std. C1-10-3, 45° Sk. & CW-7 & CW-8
New Outlet Apron, Rt.

7-161 S.E. 1/4 N.E. 1/4

E.B. Sta. 4856+75
New 12'x10'x84'-0" Box Culv.
Std. C1-12-1 & CW-9
New Outlet Apron, Rt.
Special Inlet Apron Lt.

Med. Sta. 4856+67.23
200' Rt.

2 New No. 1 Gates, Std. C-12.01

Med. Sta. 4856+89.37
308.93' Rt.

7-161 S.W. 1/4 N.E. 1/4

New 200'x100' Drainage Easement 1969

Approx. 1/16 Line

4840+75

New Drain. Ease. 1966

4859 +96.44 1096.67'

Exist. Irrigation Well 8" Well Casing

1/4 Cor. Not Fd.

21 22 27 28

Fd. Sec. Cor. - 2" I.P. & Brass Cap. U.S.G.L.O. 1914

FINALIZED

New 5 Wire Fence

Excess Drainage Easement

REDUCED SIZE DO NOT SCALE

Click here for I-10 Index

EHRENBERG - PHOENIX HWY.
TONOPAH - EAST & WEST SEC.
MARICOPA COUNTY

REVISIONS			
C.O. No.	DATE	BY	DESCRIPTION
1599	6-15-67	Pribley	Rev. Parcel Insert - Parcel 7-163
2277	4-69	H.B.D.	Rev. Culverts, Slope Limits, Sta's.
2497	12-18-69	E.J.T.	Added Parcel 7-162-A
			Added West Phx. Estates Subdivision
4770	2-11-77	R.M.M.	Revised Drain Easements Lt 4800 t...
			Finalized

PROJECT NO.	I-10-2(12)91
DRAWING NO.	D-7-T-689
SHEET NO.	9 of 32
DRAWN BY	J. Kratochvil
DATE COMP.	2-11-66
SCALE	1" = 100'
CONSULTANT	Hayes & Dashney Engineers, Inc.

CHECKED BY John Figueroa

HARD COPY 63/9 M 10

West Phoenix

Approx. 1/16 Line

Estates

T2N R7W

S.W. 1/4 N.E. 1/4

Med. Sta. 4870+97
New 30"x410' R.G.R.C.P.
Match Exist. Conc. Ditch

Cultivated Land Boundary

New 5 Wire Fence
Std. C-12.01

W.B. Sta. 4884+00
New 30"x 88' Pipe Culv.

W.B. 4889+25
New 36"x130' Pipe Culv.
Skew 45° Lt.

New 275'x 250'
Drain. Easement 1969

Unit III

4870 Line

4870+32.50
316.64'

No Access

New R/W

W.B. Constr. ℄

Slope Limits

Median ℄ Survey ℄

S.78° 31' 09" E.

200' 100' 200' 100'

E.B. Constr. ℄

Slope Limits

New R/W

No Access

No Access

E.B. Sta. 4870+50
New 24"x114' Pipe Culv.
Median Drain

Exist. Conc. Lined Irrigation Ditch
Remove From R/W

E.B. Sta. 4884+00
New 30"x 98' Pipe Culv.

E.B. Sta. 4891+85
New 36"x 152' Pipe Culv.
Skew 45° Lt.

Field Rd.

Match

Field Rd.

4.6'x1' Conc. Irr. Ditch

S.E. 1/4 N.W. 1/4

Approx. 1/16 Line

Approx. Mid-Section Line

Approx. Mid-Section Line

N.W. 1/4 S.E. 1/4

Approx. 1/16 Line

Match

4872+77.05
881.83'

FINALIZED

7-162 7-162-A 7-163

REDUCED SIZE
DO NOT SCALE

Click here for I-10 Index

EHRENBERG - PHOENIX HWY.
TONOPAH - EAST & WEST SEC.
MARICOPA COUNTY

REVISIONS			
C.O. No.	DATE	BY	DESCRIPTION
1175	6-30-66	D.G.M.	Added Exist. R/W Line To North 40' Parcel 7-164
1599	6-15-67	Bailey	Rev. Parcel Insert - Parcel 7-163
2277	4-69	H. & D.	Rev. Drain. Easmts, Culverts, Slope Limits, Stats.
			Added Parcels 7-162-A, 7-164-A & 7-165-A.
2417	10-26-69	J. Nez	Changed Sta. to POC, callout for Box Culv. at 4910+00
"	"	"	Added Prop. limits arrows between Par. 7-163 & 7-165.
2487	15-1860	E.J.T.	Added West Phx Estates Unit III Subdivision
2487	1-13-70	P. Todd	Revised Drain. Ease. Lt. Sta. 4899+ Added Par. 7-162-1
2548	3-20-70	dhrs	Revised Pipe Culvert Lengths.
2569	4-8-70	R.J.T.	Revised Par. 7-162-1
4770	2-11-71	R.M.M.	Finalized

PROJECT NO.	I-10-2(12)91
DRAWING NO.	D-7-7-689
SHEET NO.	10 of 32
DRAWN BY	J. Kratochvil
DATE COMP.	2-11-66
SCALE	1" = 100'
CONSULTANT	Hayes & Dashney Engineers, Inc.

CHECKED BY: John Figueroa

HARD COPY 6319 M10

FINALIZED

West Phoenix Estates

T2N R7W

S.W. 1/4 N.W. 1/4

S.E. 1/4 N.W. 1/4

N.E. 1/4 S.W. 1/4

N.E. 1/4 S.E. 1/4

N.W. 1/4 S.W. 1/4

Fd. Sec. Cor. 2" I.P. & Brass Cap U.S.G.L.O. 1914

Exist. R/W

W.B. POC. 4909+98. to 4910+32.02
New 3-10'x5'x86' Box Culvert
Skew 11° 30' Lt., New Outlet Apron, Rt.

W.B. Sta. 4902+00
New 10'x6'x119' Box Culv.
Skew 45° Lt.
Std. CI-10-1, 45°Sk., CW-7 & CW-8
New Outlet Apron Rt.

New Drainage Ease. - 1969

Loc Tan. Brg. S.77° 40' 14"E.

L.T.B. S.77° 45' 37"E.

W.B. Sta. 4911+85
New 30" x 110' Pipe Culv.
Skew 30° Lt.

W.B. Sta. 4916+60
New 36" x 104' Pipe Culv.
Skew 30° Lt.

W.B. Sta. 4918+50
New 36" x 144' Pipe Culv.
Skew 45° Lt.

New Drain. Ease. - 1969

New #2 Gate, Std. C-12.01

W.B. Sta. 4926+22
New 10'x5'x119' Box Culv.
Skew 45° Lt.
Std. CI-10-1, 45° Sk. & CW-5 & CW-6
New Outlet Apron Rt.

L.T.B. S.77° 51' 11" E

L.T.B. S.77° 53' 18" E

L = 310.65'
R = 34,477.48'

New No. 2 Gate Std. C-12.01

New R/W

Approx. Mid-Section Line

L = 1,535.12'
R = 34,477.48'

Slope Limits

200' Lt. Sta. 4899+78.58

200' Lt. Sta. 4902+18.40

W.B. Survey & Constr. ℄

L = 110.82

New Bank Prot.

Median & Survey ℄

S.78° 31' 09"E.

S.75° 07' 10"E.

1/4 Cor. Not in

E.B. Survey & Constr. ℄

E.B. Constr. ℄

Exist. 4 Wire Fence Remove From R/W

New #2 Gate, Std. C-12.01

New No. 2 Gate Std. C-12.01

E.B. Sta. 4904+00
New 10'x6'x119' Box Culv.
Skew 45° Lt.
Std. CI-10-1, 45°Sk., CW-7 & CW-8
New Outlet Apron Rt.

E.B. Sta. 4910+38.04 to 4910+72.06
New 3-10'x5'x66'-6' Box Culv.
Skew 11° 30' Lt., New Outlet Apron Rt.

Med. Sta. 4911+42.78
200' Rt.

Med. POT. 4911+01.98 - Sec. Line

Exist. R/W

N.0° 02' 59"W.

5283.49'

5/8" I.P. Set by Double proportion method

No Access

New Drainage Easement 1966

E.B. Sta. 4913+00
New 30" x 132' Pipe Culv.
Skew 30° Lt.

E.B. Sta. 4917+75
New 36" x 118' Pipe Culv.
Skew 30° Lt.

E.B. Sta. 4920+20
New 36" x 146' Pipe Culv.
Skew 45° Lt.

New 5 Wire Fence
Std. C-12.01 & C-12.02

Approx. 1/16 Line

E.B. Sta. 4927+48
New 10'x5'x119' Box Culv.
Std. CI-10-1, 45° Sk., CW-5 & CW-6
New Outlet Apron Rt.

New Drain. Ease. 1969

CURVE DATA: E.B., Med. & W.B.
Δ = 3° 23' 59" Rt.
D = 0° 10' 00"
R = 34,377.48'
T = 1,020.22'
L = 2,039.83'

REDUCED SIZE DO NOT SCALE

Click here for I-10 Index

EHRENBERG - PHOENIX HWY.
TONOPAH - EAST & WEST SEC.
MARICOPA COUNTY

Click here for I-10 Index

FINALIZED

C.O. No.	DATE	BY	DESCRIPTION
2277	4-69	H.R.D.	Rev. Drain. Easmts, Slope Limits, Culverts, Stds Added Parcel 7-166-1
2417	10-25-69	J. Nee	Revised as per C.O. 2417.
2487	12-29-69	E.U.T.	Removed 4" Cast Iron Pipe sta 4947+00
2548	3-1970	D.H.S.	Added 4" Cast Iron Pipe, sta 4947+00
4770	2-11-77	R.M.M.	Finalized

PROJECT NO.	I-10-2(12)91
DRAWING NO.	D-7-7-689
SHEET NO.	11 of 32
DRAWN BY	J. Kratochvil
DATE COMP.	2-11-66
SCALE	1" = 100'
CONSULTANT	Hayes & Dashney Engineers, Inc.

CHECKED BY John Dashney
HARD COPY 63/9 M10

Approx. Mid-Section Line
T2N R7W
7-164
7-165
7-166
7-167
7-166.1
23
New Drainage Easement, 1969
300' (R)
New #2 Gate, Std. C-12.01
New Drain. Easement 1966
Air Strip
NW 1/4 SE 1/4
NE 1/4 SE 1/4
New Bank Prot.
Med. Sta. 4945+00
154' Lt.
New 4" Cast Iron Pipe
No Access
N 78°05'46" E 500.68' (R)
392.4' (R)
500' (R)
Ramp "D" Sta. 10+20
New 8'x5'x74'-0" Box Culv.
Std. C1-8-1 & CW-3
New Outlet Apron, Rt.
New Drainage Easement
Med. Sta. 4955+00
390' Lt.
Med. Sta. 4950+00
180' Lt.
Med. Sta. 4958+85
725' Lt.
N 89°42'30" W 377.16'(R)
New R/W
S 63°51'11" W 510.34' (R)
175'
Ramp "D" Sta. 7+00
New 43'x27'x78' C.M.P. Arch
N 82°05'53" E
Ramp "D"
4930
4935
4940
4942.50
4945
4950
4955
4960
New R/W
100'
154'
W.B. Constr. ℄
Median ℄ Survey ℄
E.B. Survey ℄ Constr. ℄
54'
S 75°07'10" E.
E.B. Constr. ℄
Slope Limits
L = 186.19'
R = 34,277.48'
L = 185.91'
L = 2,033.90'
R = 34,277.48'
New R/W
Rad. Brg. N14°34'10"E
308.71'(R)
180'
100'
50' (R)
150'
250' (R)
Med. Sta. 4951+50
154' Rt.
No Access
Exist. 4-Wire Fence
Remove From R/W
S 64°56'04" E
Med. Sta. 4957+40
260' Rt.
Ramp "A"
N 34°23'14" W
New R/W
112.62' (R)
Match
P.T. 4933+63.99 Med.
NE 1/4 SW 1/4
SE 1/4 SE 1/4
7-165
7-166
7-167
New 5-Wire Fence
Med. Sta. 4938+50
New 42" x 366' Pipe Culv.
Skew 45° Lt.
Approx. Mid-Section Line
EQUATION
P.O.T. 4941+41.29 Med. Bk.
P.O.T. 4941+45.86 W.B. Bk.
P.T. 4941+36.73 E.B. Bk.
P.O.T. 4941+41.29 Med. Ahd.
New Drainage Easement 1969
Med. Sta. 4941+50
New 36" x 260' Pipe Culv.
New Drain. Easmt. 1966
4944+50
4946+50
4947+00
Med. Sta. 4944+46 to 4945+22
New 6-10'x5'x242'-0" Box Culv.
Skew 30° Lt.
Std. C1-10-6 30° Sk. & CW-3
New Outlet Apron Rt.
New #2 Gate, Std. C-12.01
Approx. 1/16 Line
Approx. 1/16 Line

TONOPAH INTERCHANGE
See Sheet C6
for Bearings
& Distances

Excess Drainage Easement

REDUCED SIZE
DO NOT SCALE

EHRENBERG - PHOENIX HWY.
TONOPAH - EAST & WEST SEC.
MARICOPA COUNTY

C.O. No.	DATE	BY	DESCRIPTION
3784	1-4-74	W.D.S.	Added Par. 7-167-1-L1
4770	2-11-77	R.M.M.	Finalized

C.O. No.	DATE	BY	DESCRIPTION
2548	3-12-70	dws	Added U.S.C.f.&S. Alker. Rev. Drain Struc.
3591	6-18-73	P.Todd	Add. Parcels 7-167-1, 7-171-B1, 7-168-1, 7-173-1-A, & Note denoting Access Control Only. Added Prop. Line for East 200' of S¼ Sec. 23.
"	"	"	
"	"	"	
3684	10-1-73	W.D.S.	Revised Access Control N. of I-10. Tonopah T.I. Par. 7-171-B, 7-167-1, Deleted 7-173-1-A & 7-168-1. Added T.O. Rr. Cross Rd. Sta. 17+80E

C.O. No.	DATE	BY	DESCRIPTION
1175	7-1-66	D.G.M.	Added Exist R/W To Parcels 7-167, 7-168, 7-169, 7-170, 7-171, 7-172. Relocated Control Pts. Of New R/W To Coincide With Exist R/W.
1221	8-2-66	D.G.M.	Changed Stationing Of New Control Pts.
1901	12-22-68	Nowacz	Rev. R/W, Control, Removed C.L. & ¼ Cross Rd. Calls 0+00 & Frontage Rd. Add 5-W Fence
1599	6-15-67	P.Walley	Rev. Parcel Insert - Parcel 7-168
2277	4-69	H.&D.	Rev. R/W, Dr. Easmt, Slope Lim., curb's, Sds.
			Added Parcel 7-167-A, 7-168-A, 7-171-A & 7-173-1
2417	10-28-69	J. Nez	Revised as per C.O. 2417.

PROJECT NO.	I-10-2(12)91
DRAWING NO.	D-7-T-689
SHEET NO.	12 of 32
DRAWN BY	J. Kratochvil
DATE COMP.	2-11-66
SCALE	1" = 100'
CONSULTANT	Hayes & Dashney Engineers, Inc.

HARD COPY 6/19. M10 CHECKED BY: John Thompson

R 7 W — T 2 N

Med. Sta. 4966+63.24 946.71' Lt. - 1969. New Drain. Esmt. - 1969 See Detail Sheet 26

Med. Sta. 4967+10 925' Lt. - 1966. New Drain. Esmt. - 1966

Med. Sta. 4969+90 795' Lt. New 5-W. Fence

Frontage Rd. P.O.C. 4+20 New 10'x4'x 70'-0" Box Culv. Skew 45° Lt. Std. C-1-10-1, 45°Sk., CW-516 New Outlet Apron Rt.

Deleted 10-1-73 40' Lt. Cross Rd. Sta. 0+24.55 New R/W 1969 Med. Sta. 4963+62.04 946.71' Lt. - 1969

Med. Sta. 4963+75 925' Lt. - 1966 Beg. Fence New R/W - 1969 New R/W - 1966

Ramp "C" 2-4" Transit Ducts at 48" Depth

Ramp "C" P.O.C. 4+76 New 10'x4'x50' Box Culv. Skew 45° Lt. Std. C-1-10-1, 45°Sk., CW-516 New Outlet Apron Rt.

Frontage Rd. New 5-Wire Fence Channel Change U.S.C.f.&S. Sur. Mkr. Do Not Disturb

Exist. R/W 1310.50' 2,642.35'

Cross Rd. Sta. 0+46.56 40' Rt. New R/W (1969) East 200' E½SE¼ Approx. Mid-Section Line

Med. Sta. 4962+50 820' Lt. New R/W 30' N 85°30'47" W 377.16' (R) S 58°30'47" W 400' (R)

Slope Limits Ramp "D" New Cattle Guards Without Gates Std. C-11.01

Exist. 3-Wire Fence Remove From R/W

Channel Change NE¼ SE¼

Cross Rd. Sta. 7+65 New 8'x5'x 256'-6" Box Culv. Skew 30° Rt. Std. C-8-1 - 30°Sk. & CW-3 New Outlet Apron Lt.

Crossroad Sta. 9+77.65 to Sta. 12+22.35 New 2-Span Continuous Cast-in-Place Reinf. Concrete Box Girder Underpass, Sk. 44°55'10" Rt.

W.B. Constr. ℄ Median & Survey ℄ S 75°07'10" E. E.B. Constr. ℄

Cross Rd. Sta. 18+00 New 48'x12'6 Pipe Culv. Sk. 15° Rt.

New Cattle Guards Without Gates Std. C-11.01

American Tel. & Tel. Easement 165'

Ramp "A" Sta. 14+10 New 30'x104 Pipe Culv. Sk. 30° Rt.

Ramp "B" Sta. 21+61.02 New 30'x3'x 198' C.M. Arch

Med. Sta. 4963+75 New 30'x3'x 198' C.M. Arch

Med. P.O.T. 4965-38.93 Sec. line

Cross Road Sta. 11+00

Dirt Road 41'm Ave.

N 0°02'20" W

N 75° 04' 50"

New R/W Ramp "A" New A.T.&T. Cable

Med. Sta. 4968+35 825' Rt.

New R/W Parcel 2 Parcel 1 Parcel 3 Parcel 4 Parcel 5 TONOPAH STORE Conc. Block Bldg.

Cross Rd. Sta. 21+61.02 40' Lt. 480'(R) 462.71' 342'(R) 240'(R) 251.85' (R) 1206.61' 295'

Rd. Sec. Cor.: 21 P. & Brass Cap 1914 U.S.G.L.O.

Cross Road Sta. 21+60.88 40' Rt. Exist. R/W

Med. Sta. 4966+75 825' Rt. New 5-Wire Fence

Ingress Egress Esmt. 4' Utility Esmt. to A.Z.G. Dkt. 10416, Pg. 31

Indian School Road

Med. Sta. 4962+80 New R/W New A.T.&T. Cable N 3°23'14" W 712.62' (R) 165'

Med. Sta. 4962+80 725' Rt. New 5-Wire Fence

SE¼ SE¼

N 3°24'38" E 40' Rt. Cr. Rd. Sta. 21+61.02 182.62' 30.83' 8.16' 40'x60' Rt. Crossrd. 22+00 40'x60' Lt. Crossrd. 22+00 N 4°30'22" W 40' 40' 20' 8.15' 20' 231.85' 240'(R) 180'(R) Exist. R/W Cross Rd. Sta. 22+00

DETAIL - PARCEL 7-173-1 (Not To Scale)

*NOTE: Parcels 7-167-1 & 7-171-B are for access control only.

REDUCED SIZE DO NOT SCALE

FINALIZED

TONOPAH INTERCHANGE
See Sheet 26 for Bearings & Distances

Excess Drainage Easement

Click here for I-10 Index

EHRENBERG - PHOENIX HWY.
TONOPAH - EAST & WEST SEC.
MARICOPA COUNTY

REVISIONS			
C.O. No.	DATE	BY	DESCRIPTION
1142	6-25-66	Nunez	Deleted 7-175 Revised 7-169
1401	12-22-66	Nunez	Add New 5-Wire Fence
1599	6-15-67	P.Valley	Rev. Parcel Insert - Parcel 7-168
2277	4-69	H.E.D.	Rev. Drain. Easmts, culv's, slope limits, stds. Added Parcels 7-169-A & 7-174-1
2417	10-28-69	J. Nez	Revised as per C.O. 2417.
2549	3-12-70	dws	Removed dyke, sta. 4985+20
4770	2-11-77	P. Mtn.	Finalized

PROJECT NO.	I-10-2(12)91
DRAWING NO.	D-7-T-689
SHEET NO.	13 of 32
DRAWN BY	J. Kratochvil
DATE COMP.	2-11-66
SCALE	1"=100'
CONSULTANT	Hayes & Dashney Engineers, Inc.

HARD COPY 6319 M10 CHECKED BY John Bergmann

N.W. 1/4 S.W. 1/4 — 7-168

N.E. 1/4 S.W. 1/4

T2N R7W

New 300' Ford Std. C-19.01

Med. Sta. 4973+05 to 4973+36.81
New 2-10'x4'x285'-6" Box Culv.
Skew 30° Lt.
Std. CI-10-2.45° Sk. & CW-5 & 6
New Outlet Apron Rt.

S27°28'37"E 460.11'(R)

New R/W

Med. Sta. 4973+00
455' Lt.

S.53°13'10"E 538.89'

Med. Sta. 4977+44
New 36"x 374' Pipe Culv.
Skew 30° Lt.

Exist. American Tel. & Tel. Co. Underground Cable

Med. Sta. 4978+00
254' Lt.

Approx. 1/16 Line

New 400' Ford Std. C-19.01

Med. Sta. 4998+88
New 10'x7'x 268'-6" Box Culv.
Skew 45° Lt.
Std. CI-10-1, 45° Sk. & CW-7 & CW-8
New Outlet Apron Rt.

S.W. 1/4 S.E. 1/4

New #2 Gate Std. C-12.01

New Drain. Ease. 1969

7-174 / 1

7-168 / 24

7-174 / 25

7-169 / 169

7-169

Ramp "C"

Slope Limits

4970 — 4975 — 4980 — 4985 — 4988+25 1966 — 4990 — 4990+00 1969 — 4994 — 5000

2-60' Orangeburg Pipes

New A.T. & T. Co. Cable
New R/W

Frontage Road Constr. ℄

W.B. Constr. ℄

S.75°07'10"E.

11°00'

Median & Survey ℄

2-300' Orangeburg Pipes

54' 54'

Med. Sta. 4977+17.7
Underground Cable Crossing

Match Line

16'

Channel Change

Ramp "B"

Med. Sta. 4980+00
185' Rt.

New A.T. & T. Co. Cable

7-169 A

200' 125'

Med. Sta. 4976+00
375' Rt.

New Drain. Ease. 1969, See Detail, Sheet 26.

100' 200'

S.W. 1/4 S.W. 1/4

7-169

New R/W

455'(R)

(R) 187.54'

(R) 1729

(R) 3235

158.45' (R)

7-173

Med. Sta. 4972+00
720' Rt.

New A.T. & T. Co. Cable

490'(R)

TONOPAH INTERCHANGE
See Sheet 26 for Bearings & Distances

REDUCED SIZE DO NOT SCALE

Approx. 1/16 Line

Med. Sta. 4985+00
154' Rt.

S.E. 1/4 S.W. 1/4

7-169

Med. Sta. 4985+00
New 3-30"x 216' Pipe Culv.

Slope Limits

E.B. Constr. ℄

New R/W

154'

54' 54'

FINALIZED

Mid-Section Line

7-174

New 5-Wire Fence
Std. C-12.01 & 12.02

Approx. Indian School Road

1/4 Cor. not found

New #2 Gate, Std. C-12.01

Exist. R/W

N.89°57'30"E.

30' Dirt Road

65'

Exist. R/W

Match Line

Excess Drainage Easement

Click here for I-10 Index

EHRENBERG - PHOENIX HWY.
TONOPAH - EAST & WEST SEC.
MARICOPA COUNTY

REVISIONS			
C.O. No.	DATE	F.Y.	DESCRIPTION
1142	5-25-66	Nunez	Deleted 7-175 Revised 7-169
1401	12-22-66	Vasquez	Add 5-Wire Fence Revised R/W Control
2277	4-69	H.E.D.	Rev. Drain. Easmts, Slope Lim. Culv's, Stds.
			Added Parcel 7-174-1
2417	10-27-69	J. Nez	Revised as per C.O. 2417.
2548	3-12-70	dms	Added U.S.C. & G.S. Mkr. & Sec. Cor. Note.
4770	2-11-77	R.M.M.	Finalized

PROJECT NO.	I-10-2(12)91
DRAWING NO.	D-7-7-689
SHEET NO.	14 of 32
DRAWN BY	J. Kratochvil
DATE COMP.	2-11-66
SCALE	1" = 100'
CONSULTANT	Hayes & Dashney Engineers, Inc.

CHECKED BY. Robert Dunyon

HARD COPY. 63/9 M.10

Approx. 1/16 Line

Frontage Rd. Sta. 41+72 to 42+10.5
New 3-10'×8'×50'-6" Box Culv.
Skew 30° Lt.
Std. C1-10-3 30° Sk., CW-4
New Outlet Apron Rt.

New #2 Gate, Std. C-12.01

New Drain. Ease. 1969

Med. Sta. 5004+30 to 5004+77.15
New 3-10'×8'×278'-0" Box Culv.
Skew 45° Lt.
Std. C1-10-3, 45° Sk. & CW-7 & CW-8
New Outlet Apron Rt.

American Tel. & Tel. Co. Easement

Med. Sta. 5013+54
New 2-36"×308' Pipe Culv.
Skew 45° Lt.

New 325' Ford
Std. C-13.01

Exist. 10' Dirt Road

New 5-Wire Fence
Std. C-12.01

Fd. 1/4 Cor.
1" I.P. & Brass Cap
U.S.G.L.O. 1914

R.7 W. / R.6 W.

T.2 N.

N.0°00'05"E. 2642.01'

New Drainage Easement 1966

Lot 4

Channel Change

N.36°39'09"W. 1014.47' (R)

844.28'

New 375' Ford - Std. C-19.01

F.R. Sta. 62+30
New 48"×72' Pipe Culv.
Skew 30° Lt.

OLD CAMP WASH

Flood Gate

31½' Easement for Electric Lines

Med. Sta. 5022+60
254' Lt.

Exist. 4-Wire Fence
Remove Within R/W

Med. Sta. 5019+41.81
254' Lt.

Exist. Sec. Cor. To Remain
New Surv. Monument & Cover

No Access

New No. 1 Gate

(R) 182.96

S.86°15'20"E. (R) 628.95' (R) 262.64'

Med. Sta. 5028+66.52
375.36 Lt.
End 5-Wire Fence - Remove

Med. Sta. 5029+00
249.74' Lt.

New R/W

5252.71'

New R/W

Frontage Rd. Constr. ℄

Slope Limits

W.B. Constr. ℄

Median ℄ Survey ℄

S.75°07'10"E.

E.B. Sta. 5010+67.62-50' Rt.

E.B. Constr. ℄

888.51' (R)

288.76'

25°

Chain Link Fence

Slope Limits

Exist. 3-Unit Cattle Guard
Remove

Med. Sta. 5029+00
154' Lt.

Med. Sta. 5024+40
New 48"×336' Pipe Culv.
Skew 30° Lt.

5026+75

7-177

Lot 1

N.0°00'05"E. 2641.55'

New Drainage Easement 1966

Match

W.B. Sta. 5025+46.17 to 5026+39.83
E.B. Sta. 5025+46.17 to 5026+39.83
2-New 3-Span Continuous
Reinforced Conc. Slab Bridges
38' Clear Roadway

New Grader Road - 26'

Med. Sta. 5017+10.44 - Sec. Line

Med. P.O.T. 5020+09.26 - Sec. Line

Med. Sta. 5020+50.18
154' Rt.

Found Sec. Cor.
1" I.P. 0.30' Below
Ground - U.S.G.L.O. 1914

U.S.C. & G.S. Sur. Mkr.
Do Not Disturb

Med. Sta. 5006+80
154' Rt.

Approx. 1/16 Line

N.E. ¼ N.E. ¼

N.W. ¼ N.E. ¼

Match

Fd. ¼ Cor. - 1" I.P.
& Brass Cap
U.S.G.L.O. 1914

FINALIZED

REDUCED SIZE
DO NOT SCALE

Excess Drainage Easement

Click here for I-10 Index

EHRENBERG - PHOENIX HWY.
TONOPAH - EAST & WEST SEC.
MARICOPA COUNTY

REVISIONS			
C.O No.	DATE	BY	DESCRIPTION
1077	3/30/66	R.M.D.	Showed Bearing Equation to beg. @ Sta. 5050
1175	7-1-66	D.G.M.	Deleted Parcel 7-178, Added Parcel 7-176
2277	4-69	H.&D.	Rev. Culvs., Slope limits, Stats.
2487	10-17-69	E.J.T.	Added New 36" Pipe Med sta 5048+10.
2569	4-8-70	R.J.T.	Revised Length of Pipe @ 5048+10
4770	2-11-77	R.M.M.	Finalized

PROJECT NO.	I-10-2(12)91
DRAWING NO.	D-7-T-689
SHEET NO.	15 of 32
DRAWN BY	J. Kratochvil
DATE COMP.	2-11-66
SCALE	1" = 100'
CONSULTANT	Hayes & Dashney Engineers, Inc.

HARD COPY 6319 M10 & 6319 M11 CHECKED BY

American Tel. & Tel. Co. Easement

S.E. 1/4 S.W. 1/4

S.W. 1/4 S.E. 1/4

16.5'

7-176

Sec. 19

Sec. 30

1/4 Cor. Not In

To Phoenix

Section Line

N 89° 57' 30" E

T2N

R6W

16.5'

5030+20
597.6
ARIZONA PUBLIC SERVICE SUBSTATION
3 Trans Formers
86'-10"
8'
8'
5030+71.6
604.5

30' Dirt Road

65'

65'

Med. Sta. 5035+00
New 24"x 192' Pipe Culv.

7-177

7-176

7-178

Med. Sta. 5059+84
New 36"x 338' Pipe Culv.
Skew 45° Lt.

N.W. 1/4 N.E. 1/4

5030 5035 5040 5045 5050 5055 5060

Line

BEARING EQUATION
S 75°07'10" E Bk. =
S 75°04'23" E Ahd.

No Access

New R/W

Slope Limits

W.B. Constr. ℄

154'

54'

54'

S. 75° 07' 10" E.

Median ℄ Survey ℄

S. 75° 04' 23" E.

154'

154'

54'

54'

Slope Limits

E.B. Constr. ℄

New R/W

No Access

N.E. 1/4 N.W. 1/4

Med. Sta. 5043+58
New 48"x 266' Pipe Culv.
Skew 30° Lt.

Med. Sta. 5047+31
New 236"x 264' Pipe Culv.
Skew 30° Lt.

Approx. Mid-Section Line

Med. Sta. 5048+10
New 36"x 356' R.G.R.C.P.
Irrigation Line

Med. Sta. 5055+00
New 48"x 250' Pipe Culv.

New 5-Wire Fence
Std. C-12.01

Approx. 1/16 Line

Match

Match

7-177

Lot 1

Approx. 1/16 Line

19 20 29

24 19 25

7-178

7-177

1

2

30

S.W. 1/4 N.E. 1/4

REDUCED SIZE
DO NOT SCALE

FINALIZED

Click here for I-10 Index

Click here for I-10 Index

EHRENBERG - PHOENIX HWY.
TONOPAH - EAST & WEST SEC.
MARICOPA COUNTY

REVISIONS			
C.O. No.	DATE	BY	DESCRIPTION
4770	2-11-77	R.M.M.	Finalized

REVISIONS			
C.O. No.	DATE	BY	DESCRIPTION
1175	7-1-66	D.G.M.	Deleted Parcel 7-178, Added Parcel 7-176
2277	4-69	H.F.D.	Rev. R/W, Slope Limits, Culverts, Slds. Added Parcel 7-176-A
2417	10-27-69	J. Nez	Added callout to underpass at Sta. 10+00 and Irrig.
"	"	"	Line at Sta. 5+00 Belmont Road.
2487	12-17-69	EJT	Relocated 36" Pipe from 5+00 to 12+00
2548	3-20-70	dws	Added Survey Marker & New Dike.
2569	4-8-70	RJT	Relocated & Revised Length of Pipe @ Sta. 12+00

PROJECT NO.	I-10-2(12)91
DRAWING NO.	D-7-T-689
SHEET NO.	16 of 32
DRAWN BY	J. Kratochvil
DATE COMP.	2-11-66
SCALE	1" = 100'
CONSULTANT	Hayes & Dashney Engineers, Inc.

CHECKED BY. John Stumpf

HARD COPY. 6-19-71

N.E. 1/4 N.E. 1/4

Fd. Property Cor.'s & Section Cor. - 3/4" I. Pipes

33' Lt. & Rt. Belmont Rd. Sta. 0+00

New R/W 1966

New R/W 1969

W.B. Sta. 5070+00
New 30"x 194' Pipe Culv.

7-178 (7-176)

7-176

7-176-A

N.W. 1/4 N.W. 1/4

Med. Sta. 5077+00
New 36"x 200' Pipe Culv

Med. P.O.T. 5074+45.44 - Sec. Line
Belmont Rd. Sta. 10+00

154' Lt.
Med. Sta. 5075+07.91

Approx. 1/16 Line

Med. Sta. 5085+31
New 42"x 324' R.G.R.C.P.
Match Exist. Conc. Ditch

New Drain. Easement 1966

Crossroad Sta. 8+75.15 to 11+19.85
New 2-Span Continuous Cast-in-Place
Conc. Box Girder Underpass, Sk. 14°55'00" Rt.

154' Lt.
Med. Sta. 5073+00.93

New R/W (1966)

W.B. Constr. ℄

Slope Limits

Median ℄ Survey ℄
S. 15° 04' 23" E.

U.S.C.&G.S. Survey Mkr. Do Not Disturb

E.B. Constr. ℄

Slope Limits

New R/W (1966)

Sta. 12+00 Belmont Rd.
New 36"x 290' R.G.R.C.P.
Irrigation Line

3' Dirt Irr. Ditch

154' Rt.
Med. Sta. 5075+89.95

New 5-Wire Fence
Std. C-12.01 & C-12.02

Med. Sta. 5066+00
New 36"x 202' Pipe Culv.

154' Rt.
Med. Sta. 5073+82.97

Exist. 1-Wire Elec. Fence
Remove From R/W

Exist. 5' Wide Conc. Lined Irr. Ditch
Remove From R/W

7-176-A

1/16 Dirt Road

New R/W 1966

New R/W 1969

Peach Orchard

FINALIZED

Exist. 1-Wire Elec. Fence
Remove From R/W

Match

Approx. 1/16 Line

Match

7-178

7-176

Approx. 1/16 Line

S.E. 1/4 N.E. 1/4

T2N R6W

BELMONT ROAD
GRADE SEPARATION
(CROSS ROAD See Sheet 25 OVER)
for Bearings
& Distances

Plum Orchard

33' Lt. & Rt.
Belmont Rd. Sta. 20+00

Approx. Mid-Section Line

1/4 Cor Not In

Fd. Sec. Cor. - 2" I.P. & Brass Cap
U.S.G.L.O. 1914

REDUCED SIZE
DO NOT SCALE

7-179

19 20 29 30 31 32

EHRENBERG - PHOENIX HWY.
TONOPAH - EAST & WEST SEC.
MARICOPA COUNTY

REVISIONS			
C.O. No	DATE	BY	DESCRIPTION
2277	4-69	H.L.D.	Rev. Drain. Easmts, Culvs, Slope Limits, Stds.
2417	10-27-69	J. Nez.	Added wash Sta. 5103+ and callout to Coyote Wash.
"	"	"	Added callout to 2 Gates, changed Sta. 5106+94 to 5106+96 in callout to Bot. Culv.
2548	3-20-70	dws	Added "Box R/W Cut" & Deleted Dike.
4770	2-11-77	R.M.M.	Finalized

PROJECT NO.	I-10-2(12)91
DRAWING NO.	D-7-T-689
SHEET NO.	17 of 32
DRAWN BY	J. Kratochvil
DATE COMP.	2-11-66
SCALE	1" = 100'
CONSULTANT	Hayes & Dashney Engineers, Inc.

CHECKED BY. John Simpson

HARD COPY. 6/19. M.11

W.B. Sta. 5090+51.67 to 5091+58.33
E.B. Sta. 5090+51.67 to 5091+58.33
2-New 3-Span R.C. Continuous
Slab Bridges, 38' Clear Roadway

Approx. 1/16 Line

Wheat Field

T2N R6W

Land Cleared of Brush

FINALIZED

S.W. 1/4 N.E. 1/4 — 7-180

S.E. 1/4 N.E. 1/4 — 7-180

Med. Sta. 5097+00
New 36"x 196' Pipe Culv.

7-179

New Drainage Easement 1966

Med. Sta. 5103+95
New 42"x 234' Pipe Culv.

New Drainage Easement 1969

S.75°04'23"E. 125' (R)

7-180-A

New #2 Gate
Std. C-12.01

N.44°55'37"E. 173.21' (R)

N.44°55'37"E. 253.81' (R) 225'

81.70' (R)

Med. Sta. 5115+50
New 2-30"x 214' Pipe Culv.

New R/W

Slope Limits

W.B. Constr. ℄

S.75°04'23"E.

Median ℄ Survey

E.B. Constr. ℄

Slope Limits

5090 5095 5100 5105 5110 5115 5120

COYOTE WASH

Chain Link Fence

154' 54' 54' 154'

New R/W

New 5-Wire Fence
Std. C-12.01 & C-12.02

Exist. 4-Wire Fence
Remove From R/W

Match Line

Med. Sta. 5099+00
New 42"x 200' Pipe Culv.

5103+50 New Drain. Easement 1966 5104+50

100'

7-180 A

7-181 A

250' (M) 250' (R)

New #2 Gate
Std. C-12.01

E.B. Sta. 5106+96 to 5107+16.50
New 2-10'x8'x200'-0" Box Culv.
Std. C1-10-2 & CW-2
New Outlet Apron Rt.

5106+50 New Drainage Easement 1969 5107+75

Exist. 4-Wire Fence
Remove From R/W

29

Approx. Mid-Section Line

N.E. 1/4 S.W. 1/4

N.W. 1/4 S.E. 1/4 — 7-181

N.E. 1/4 S.E. 1/4

7-179 7-180 7-181 29

Approx. 1/16 Line

REDUCED SIZE
DO NOT SCALE

Click here for I-10 Index

EHRENBERG - PHOENIX HWY.
TONOPAH - EAST & WEST SEC.
MARICOPA COUNTY

REVISIONS			
CONT.	DATE	BY	DESCRIPTION
2277	4-69	H. & D.	Rev. Slope Limits, culverts, stds.
2417	10-27-69	J. Nez	changed Sta. 5126+43 to 5126+74 and size 40" to 2-36" at Sta. 5144+75, Pipe Culv. callouts.
2548	3-20-70	dws	Added Survey Mkr.
4770	2-11-77	R.M.M.	Finalized

PROJECT NO.	I-10-2(12)91
DRAWING NO.	D-7-7-689
SHEET NO.	18 of 32
DRAWN BY	J. Kratochvil
DATE COMP.	2-11-66
SCALE	1"=100'
CONSULTANT	Hayes & Dashney Engineers, Inc.

CHECKED BY: John Hayes

HARD COPY 6/19 M 11

FINALIZED

S.E. 1/4 N.E. 1/4

T2N R6W

S.W. 1/4 N.W. 1/4

Alfalfa Field

Med. Sta. 5122+00
New 2-30"x204' Pipe Culv.

Exist. 4-Wire Fence
Remove From R/W

7-180

Fd. 1/4 Cor.-1" I.P. & Brass Cap U.S.G.L.O. 1914

Exist. 18' Gate
Exist. 15' Gate

U.S.C.&G.S. Bur. Mkr.
Do Not Disturb

Med. Sta. 5134+00
New 30"x212' Pipe Culv.

Approx. Mid-Section Line

Med. Sta. 5137+10
New 30"x208' Pipe Culv.

Med. Sta. 5144+75
New 2-36"x244' Pipe Culv.

N.E. 1/4 S.W. 1/4

5120 5125 5130 5135 5140 5145 5150

Match Line

28 29

No Access
Med. Sta. 5128+75.91
154' Lt.
New R/W

Slope Limits

W.B. Constr. ℄

S. 75° 04' 23" E.

Median ℄ Survey

E.B. Constr. ℄

154' 54' 54' 154'

Med. Sta. 5126+74
New 2-30"x244' Pipe Culv.
Skew 30° Rt.

7-181

Exist. 4-Wire Fence
Remove From R/W

Med. P.O.T. 5129+16.20 - Sec. Line

N.E. 1/4 S.E. 1/4

New R/W

No Access
Med. Sta. 5129+57.09
154' Rt.

N. 0° 03' 23" E.

264.185'

New 5-Wire Fence
Std. C-12.01

N.W. 1/4 S.W. 1/4

7-182

7-183

Match Line

29 28 33 32

Fd. Sec. Cor. - 2" I.P. & Brass Cap U.S.G.L.O. 1914

7-180 28 29 7-182 7-181 7-183

Approx. 1/16 Line

Approx. 1/16 Line

REDUCED SIZE
DO NOT SCALE

Click here for I-10 Index

EHRENBERG - PHOENIX HWY.
TONOPAH - EAST & WEST SEC.
MARICOPA COUNTY

REVISIONS			
C.O. No	DATE	BY	DESCRIPTION
2277	4-69	H.&D.	Rev. Drain. Easm'ts, Slope Limits, culverts, etc. Added Parcels 7-185-A & 7-184-1
2548	3-18-70	dws	Revised B.C. sta. 5154+
3415	11-6-72	D.G.M.	Changed Parcel 7-184-1 To 7-184-1-A.
"	"	"	Changed New Drain. Ease. Date To 1972.
4770	2-11-77	R.M.M.	Finalized

PROJECT NO.	I-10-2(12)91
DRAWING NO.	D-7-7-689
SHEET NO.	19 of 38
DRAWN BY	J. Kratochvil
DATE COMP.	2-11-66
SCALE	1" = 100'
CONSULTANT	Hayes & Dashney Engineers, Inc.

CHECKED BY: John Stephens

HARD COPY 6319 M.II

FINALIZED

Approx. Mid-Section Line

28

T2N R6W

T-183

T-184-1-A

T-184

T-184-1

New Drainage Easement-1966

New Drainage Easement-1972

New Drainage Easement-1969

8' Dirt Road

New 3-10'x5' Box Culv.

New No. 2 Gate, Std. C-12.01

N.E. 1/4 S.W. 1/4

N.W. 1/4 S.E. 1/4

N.E. 1/4 S.E. 1/4

S.E. 1/4 S.E. 1/4

S.W. 1/4 S.E. 1/4

S.E. 1/4 S.W. 1/4

5150 Line

5152+00 1966

5155

5157+50

5158+50

5159+00 1966

5160

5165

5170

5173

5174+00

5175+50

5178+50

5180 Line

Med. Sta. 5173+00
New 2-30"x204' Pipe Culv.

Med. Sta. 5165+20
New 3-30"x200' Pipe Culv.

350' (R)

100' (R)

75' (R)

50' (R)

No Access

New R/W

Slope Limits

W.B. Constr. ℄

Median & Survey ℄

S. 75° 04' 23" E.

E.B. Constr. ℄

154'

54'

New No. 2 Gate, Std. C-12.01

No Access

175' (R)

150' (R)

New Drainage Easement 1969

Match

7-183-A

5153+50

5155+00

Dirt Irr. Ditch

Approx. 1/16 Line

Approx. Mid-Section Line

Med. Sta. 5157+92
New 30"x254' Pipe Culv.
Skew 30° Rt.

5164+75

New Drain. Ease. 1966

5165+50

New 5-Wire Fence
Std. C-12.01

Approx. 1/16 Line

Match

REDUCED SIZE
DO NOT SCALE

Excess Drainage Easements

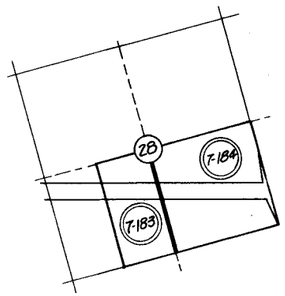

Click here for I-10 Index

Click here for I-10 Index

EHRENBERG - PHOENIX HWY.
TONOPAH - EAST & WEST SEC.
MARICOPA COUNTY

REVISIONS			
C.O. NO.	DATE	BY	DESCRIPTION
1077	3/30/66	F.M.B.	Added Info. @ Wintbrg. Rd. Gd. Sep. Per. Mkd. Print
1175	7-1-66	O.G.M.	Added 10' Mountain States T. & T. Co. Easm't.
2277	4-69	H. & D.	Rev. R/W, Drain. Easm'ts, slope limits, cuts, Sta's.
			New Sheet. Added Parcels 7-184-1, 7-185-A, 7-186-1, 7-187-A, & 7-188-A
2417	10-28-69	J. Nez	Added washes 5180+ and 5186+, added callout
"	"	"	for underpass at Med. P.O.T. 5183+81.46.
2548	3-12-70	dws	Revised Drain. Struc. Per Constr. Plans
4770	2-11-77	R.M.M.	Finalized

PROJECT NO.	I-10-2(12)91
DRAWING NO.	0-7-7-689
SHEET NO.	20 of 32
DRAWN BY	J. Kratochvil
DATE COMP.	2-11-66
SCALE	1" = 100'
CONSULTANT	Hayes & Dashney Engineers, Inc.

FINALIZED

CHECKED BY. Dennis W. Spurlock

HARD COPY

Fd. 1/4 Cor. - 1" I.P. & Brass Cap 3" below ground U.S.G.L.O. 1914

Wintersburg Rd. Sta. 0+00 33' Rt. -

Wintersburg Rd. Sta. 0+00 100' Lt. - 1969

Wintersburg Rd. Sta. 0+00 75' Lt. - 1966

10' Easement to Mountain States T. & T. Co.

Wintersburg Rd. Sta. 3+00 - 100' Lt. - 1969

New 20' Grader Rd.

Crossroad Sta. 8+77.66 to Sta. 11+22.34
New 2-Span Continuous Cast-in-Place Conc. Box Girder Underpass, Sk. 14°54'15" Rt.
28' Clear Roadway

Med. Sta. 5182+11.12 154' Lt. - 1969

Med. Sta. 5182+36.99 154' Lt. - 1966

Med. Sta. 5184+43.95 154' Lt. - 1966

Med. Sta. 5183+11.21 154' Lt. - 1969

Med. Sta. 5185+89 to 5186+11.50
New 10'x6'x192' Box Culv.
Std. C1-10-2 & CW-2
New Outlet Apron Rt.

Med. Sta. 5197+50
New 3-36"x210' Pipe Culv.

New Drainage Easement - 1969

New Drainage Easement - 1966

New R/W

New No. 2 Gate Std. C-12.01

Slope Limits

W.B. Constr. ℄

E.B. Constr. ℄

Median & Survey ℄

3.75° 04' 23" E.

New 5 Wire Fence Std. C-12.01 & C-12.02

Approx. Property Line

Approx. 1/16 Line

T. 2 N.

R. 6 W.

NE1/4 SW1/4

N.W1/4 SW1/4

SE1/4 SW1/4

S.W1/4 SW1/4

N.W1/4 NW1/4

SE1/4 SE1/4

N.E1/4 SE1/4

Match Line

Match FOUR MILE

New D.E. 1966
New No. 2 Gate, Std. C-12.01

SEE DETAIL 'A'

NEW DRAIN. EASE. 1969
Med. Sta. 5185+67.32
154' Rt. - 1969

Med. Sta. 5185+25.93
154' Rt. - 1966

Crossrd. 13+64 to 13+95.81
New 2-10'x8'x202'-6" Box Culv., Std. C1-10-2, 45° Sk.
New Outlet Apron Rt.

Cross Road Over
WINTERSBURG ROAD GRADE SEPARATION

Med. Sta. 5183+18.97 - 154' Rt. - 1966

Med. Sta. 5182+67.23 - 154' Rt. - 1969

Med. Sta. 5180+83.3 to 5181+27.17
New 4-10'x7'x192' Box Culv.
Std. C1-10-4 & CW-2
New Outlet Apron Rt.

Drainage Easement
200 Rt. Crossrd. Sta's 14+50 and 16+00 - 1969

Sta. 19+86.55

See Detail 'B'

Fd. Sec. Cor. - 2" I.P. & Brass Cap 3" below ground U.S.G.L.O. 1914

N89°57'36"E

N.89°57'36E"-2639.88'(C)

Wintersburg ℄ ℄ Sec. Line N.0°01'23"E

Sta. 19+86.55 ℄ Sec. Cor.

Sta. 20+00 End Constr.

33'℄50' Lt Wintersburg Rd. Sta. 19+86.55 New R/W 1966 New R/W 1969 33'℄50' Lt Wintersburg Rd. Sta. 20+36.55 S.89°58'27"E.

33'℄50' Rt Wintersburg Rd. Sta. 19+86.55 New R/W 1966 New R/W 1969 33'℄50' Rt Wintersburg Rd. Sta. 20+36.55

Detail 'B' - Scale 1" = 50'

Std. Line

& Dirt Road

DETAIL 'A' New Drain. Ease. 1966

150.19' N.6°31'23"E

211.29'(R) N.44°55'37"E.

New Drain. Ease. 1969
172'-N.45°10'50"E.
34.78'-N.6°31'23"E.
55.93' N.45°10'50"E.

Excess Drainage Easement

REDUCED SIZE DO NOT SCALE

EHRENBERG - PHOENIX HWY.
TONOPAH - EAST & WEST SEC.
MARICOPA COUNTY

Click here for I-10 Index

REVISIONS			
C.O. No.	DATE	BY	DESCRIPTION
1077	3-30-66	F.M.E.	Corr. quarter, quarter designations.
2277	4-69	H.F.D.	Rev. Drain. Easmnts, Slope limits, culverts, Stds.
			Added Parcels 7-191-A & 7-192-A
2417	10-28-69	J. Nez.	Added callout to 1/4 Cor.
2548	3-12-70	dws	Deleted dykes, sta. 52144 5222, Added Gur.
"	"	"	Marker & Callout
4770	2-11-77	R.M.M.	Finalized

PROJECT NO.	I-10-2(12)91
DRAWING NO.	D-7-T-689
SHEET NO.	21 of 38
DRAWN BY	J. Kratochvil
DATE COMP.	2-11-66
SCALE	1" = 100'
CONSULTANT	Hayes & Dashney Engineers, Inc.

CHECKED BY. John B. Thompson

HARD COPY. 6/19 M11

T2N R6W

S.W. 1/4 S.E. 1/4

S 1/2 S.E. 1/4 S.E. 1/4

Med. Sta. 5214+00
New 30"x202' Pipe Culv.

Med. Sta. 5220+00
New 24"x198' Pipe Culv.

W.B. Sta. 5228+72 to 5229+27
New 5-10'x5'x70'0" Box Culv.
Std. Cl. 10-5; CW-1
New Outlet Apron Rt.

New No. 2 Gate, Std. C-12.01

Detail 'A'

See Detail 'A'

Drainage Easement-1966

Fd. Sec. Cor. - 2" I.P & Brass Cap U.S.G.L.O. 1914

Rdwy. Easement

Med. Sta. 5227+87.29
154' Lt.

Med. Sta. 5238+06.11
154' Lt.

Dirt Rd.

No Access

New R/W

Slope Limits

W.B. Constr. ℄

S. 75° 04' 23" E.

Median ℄ Survey

E.B. Constr. ℄

599.73'

1,057.61' (R)

No Access
Med. Sta. 5216+28.05
154' Rt.

Fd. 1/4 Cor. - 1" I.P & Brass Cap U.S.G.L.O. 1914

Mid-Section Line

Approx.

Med. P.O.T. 5222+07.67 - Sec. Line

Approx. 1/16 Line

N.W. 1/4 N.E. 1/4

N.E. 1/4 N.E. 1/4

N.W. 1/4 N.W. 1/4

New No. 2 Gate, Std. C-12.01

New Drainage Easement-1969

U.S.C.&G.S. Survey Mkr. Do Not Disturb

Med. Sta. 5240+00
New 3-36"x210' Pipe Culv.

Med Sta. 5238+88.09
154' Rt.

New 5 Wire Fence
Std. C-12.01 & C-12.02

E.B. Sta. 5228+72 to 5229+27
New 5-10'x5'x65'0" Box Culv.
Std. Cl-10-5, CW-1
New Outlet Apron Rt.

Med. P.O.T. 5238+47.10 - Sec. Line

Match New Drainage Easement-1966

N0°01' 18" E.

2642.39'

Fd. 1/4 Cor. - 1" I.P. and Brass Cap. U.S.G.L.O. 1914

7-187 7-188 7-189 7-190 7-191 7-191 A 7-192 7-192 A 7-193 L-1 7-193

FINALIZED

REDUCED SIZE DO NOT SCALE

Excess Drainage Easement

EHRENBERG - PHOENIX HWY.
TONOPAH - EAST & WEST SEC.
MARICOPA COUNTY

Click here for I-10 Index

REVISIONS			
C.O No	DATE	BY	DESCRIPTION
2277	4-69	H.V.D.	Rev. Drain. Easmt's, Slope Limits, Culverts, Stds. Added Parcel 7-193-A.
2417	10-28-69	J. Nez	Showed North line Sec. 35 as being approximate.
2543	3-12-70	dwg	Revised Box Culvert
4770	2-11-77	R.M.M.	Finalized

PROJECT NO.	I-10-2(12)91
DRAWING NO.	D-7-T-689
SHEET NO.	22 of 32
DRAWN BY	J. Kratochvil
DATE COMP.	2-11-66
SCALE	1"-100'
CONSULTANT	Hayes & Dashney Engineers, Inc.

CHECKED BY. John Stephens

HARD COPY. 6319 M11

FINALIZED

T2N R6W

Sec. 26
Sec. 35
Approx. Sec. Line
N.W. 1/4 N.E. 1/4
N.E. 1/4 N.W. 1/4
N.W. 1/4 N.W. 1/4
5240 Line
5245
5250
5255
5260
5265
5270 Line
7-193
7-193 L-1
7-193 A
7-193-A -L1
New #2 Gate, Std. C-12.01
Drainage Easement - 1966
W.B. Sta. 5257+80
New 10'x6'x192' Box Culv.
Std. C1-10-1 & CW-2
New Outlet Apron Rt.
5257+50
5258+50
New R/W
Slope Limits
154'
54'
W.B. Constr. ℄
S. 75° 04' 23" E.
Median ℄ Survey
E.B. Constr. ℄
Med. Sta. 5245+50
New 36"x218' Pipe Culv.
New 5-Wire Fence
Std. C-12.01 & C-12.02
Approx. 1/16 Line
Match Drainage Easc. 1966
5240+50
Approx. Sec. Line
Fd. 1/4 Cor. - 1" I.P. & Brass Cap U.S.G.L.O. 1914
34
35
100'
50'
5257+00
5257+25
5258+50
Drain. Easc. 1966
New Drain Easc. 1969
Med. Sta. 5266+50
New 2-42"x210' Pipe Culv.
Approx. Mid-Sec. Line
S.W. 1/4 N.E. 1/4
S.E. 1/4 N.W. 1/4
Match
Excess Drainage Easement

REDUCED SIZE
DO NOT SCALE

EHRENBERG - PHOENIX HWY.
TONOPAH - EAST & WEST SEC.
MARICOPA COUNTY

REVISIONS			
C.O. No	DATE	BY	DESCRIPTION
1506	9-21-67	R.L.R.	Deleted end of R/W & Const. Projects at Sect. Line & Added Parcel T-161-A
2277	4-1-69	H.D.	Rev. Culverts, Slope limits, Stds.
2417	10-28-69	J. Nez	Changed E.B. Sta. to Med. Sta. Box Culv. Showed no access
"	"	"	L & Rt. Sta. 5293 and Exist. Tele. line to be removed
2548	3-12-70	dwg	Added Survey Marker & Callout
4770	2-11-77	R.M.M.	Finalized

PROJECT NO.	I-10-2(12)91
DRAWING NO.	D-T-T-689
SHEET NO.	23 of 32
DRAWN BY	J. Kratochvil
DATE COMP.	2-11-66
SCALE	1" = 100'
CONSULTANT	Hayes & Dashney Engineers, Inc.

CHECKED BY: John Hayes

HARD COPY 6319.M11

Fd. Sec. Cor. - 2" I.P & Brass Cap U.S.G.L.O. 1914

26 25 35 36

T2N RGW

N.E. 1/4 N.E. 1/4

N.W. 1/4 N.W. 1/4

N.0° 01' 53"E.

2642.69

FINALIZED

Drainage Easement 1966

5280+00

5281+00

350'

T-193 L-1

T-193

N.W. 1/4 N.E. 1/4

Med. Sta. 5278+50
New 2-36"x234' Pipe Culv.

5270 Line

5275

5280

5285

5290

5295

5300 Line

Approx. 1/16 Line

New #2 Gate, Std. C-1201

New R/W

Slope Limits

154'

W.B. Const. ℄

S.75° 04' 23"E.

Median ℄ Survey ℄

E.B. Const. ℄

Med. Sta. 5292+70.56
154' Lt.

No Access

U.S.C.&G.S. Survey Mkr.
Do Not Disturb

T-161A

S.W. 1/4 N.W. 1/4

10 Dirt Road

1933.35

59.35'

Exist. Telephone Line
To be moved by others

No Access

Med. Sta. 5293+02.38
164' Rt.

Med. P.O.T. 5293+11.52 - Sec. Line

817.10'

Fd. 1/4 Cor. - 1" I.P & Brass Cap U.S.G.L.O. 1914

35 36

Approx. Mid-Sec. Line

New 5-Wire Fence
Std. C-12.01 & C-12.02

New #2 Gate, Std. C-12.01

Med. Sta. 5286+14 to 5286+36.50
New 2-10'x5'x 209' Box Culv.
Std. C1-10-2 & CW-1
New Outlet Apron Rt.

Match

S.W. 1/4 N.E. 1/4

S.E. 1/4 N.E. 1/4

Approx. 1/16 Line

REDUCED SIZE DO NOT SCALE

Click here for I-10 Index

EHRENBERG - PHOENIX HWY.
TONOPAH - EAST & WEST SEC.
MARICOPA COUNTY

REVISIONS				PROJECT NO.	I-10-2(12)91
C.O. No.	DATE	BY	DESCRIPTION	DRAWING NO.	D-7-T-609
1806	3-24-67	R.L.R.	New Sheet	SHEET NO.	24 of 32
2277	4-6-9	H.H.D.	Rev. Culvert, added Slope Limits	DRAWN BY	R. Robinson
2548	3-12-70	dms	Added New Dyke	DATE COMP.	Mar. 15, 1967
3525	9-23-73	W.O.S.	Added New Drain. Ease. (1973) & Note	SCALE	1"=100'
4770	2-11-77	R.M.M.	Finalized		

CHECKED BY. Dennis W. Spencer

HARD COPY. 6319 MII

FINALIZED

T.2N. R.6W.

Approx. ¼ Line

New Drain. Ease. (1973)

SW¼ NE¼

NOTE: New Drainage Easements (1973) Begining Left & Right Sta. 5314+00 To Be Acquired Under R/W Project I-10-2(15).

SW¼ NW¼

SE¼ NW¼

Line 5300

5305

5310

5315

5320

5325

2-36"x206' Pipe Culvs.

New 3-36" Pipe Culv.

New R/W

New 42" Pipe Culv.

New Channel

New Dyke

W.B. ℄

Brg. Equa. S75°04'23"E Bk. = S75°01'36"E Ahd.

SURVEY ℄ MED

E.B. ℄

54'

15'

15'

15'

15'

36

New R/W

New 5 Wire Fence

Approx. ¼ Line

STA. 5314+00±

New Channel

New 10'x400' Channel

New Drain Ease. (1973) See Note Above.

4 Strand Barb Wire Fence Remove Within R/W

Approx. ¼ Line

North

END CONST. PROJ. I-10-2(13)91

BEG. CONST. PROJ. I-10-2(16)101

7-161-A

STA. 5320+80±

END R/W PROJECT I-10-2(12)91

BEGIN R/W PROJECT I-10-2(15)101

NW¼ SW¼

NE¼ SW¼

NW¼ SE¼

REDUCED SIZE DO NOT SCALE

Click here for I-10 Index

EHRENBERG - PHOENIX HWY.
TONOPAH - EAST & WEST SEC.
MARICOPA COUNTY

REVISIONS			
C.O. No.	DATE	BY	DESCRIPTION
2277	4-6-67	H.&D.	Rev. R/W Slope Limits, Culverts Parcel 7-176-A.
2417	10-28-68	J. Nez	Added "Sec Line" to callout at Med. Sta 5074+45.44 and
"	"	"	changed sheet no. at bottom of sheet from 15 to 16.
2487	12-17-68	EJT	Relocated Pipe from 5+00 to 12+00
2569	4-8-70	RJT	Relocated Pipe @ 12+00. Revised length
4770	2-11-77	R.M.M.	Finalized

PROJECT NO.	I-10-2(12)91
DRAWING NO.	D-7-T-689
SHEET NO.	25 OF 32
DRAWN BY	North
DATE COMP.	2-11-66
SCALE	1" = 100'
CONSULTANT	Hayes & Dashney Engineers, Inc.

HARD COPY ____ CHECKED BY. John Stephens

T2N R6W

NW¼ NW¼ | SW¼ NW¼ | NE¼ NE¼ | SE¼ NE¼

Approx. ½ Sec Line

Approx. Mid-Section Line

Found Sec. Cor. 2" I.P. C.B.B.M. Cap USGLO 1914

Property Cor. & Sec. Cor. Fd. ¾" Iron Pipes

American Tel. & Tel. Co. Easement

Peach Orchard

Plum Orchard

Med. Sta. 5074+45.44 - Sec. Line
Cross Road Sta. 10+00

Med. Sta. 5075+59.61
154' Lt. - 1969

Med. Sta. 5075+07.91
154' Lt. - 1966

120' Lt.
Belmont Rd. Sta. 5+00

New R/W-1966

New R/W-1969

N.4° 29' 47" W. 381.77'(R)

507.51'(R) N. 9° 51' 36" W.

N.4° 28' 27" W. 869.85'(R)

5075

5.10'

N.B. Constr. E

36" CMP (Med. & Survey E)

S. 75° 01' 23" E.

E.B. Constr. E

Med. Sta. 5076+41.69
154' Rt. - 1969

Exist. 1-Wire Elec. Fence
Remove 2000 Lin. Ft.
Within R/W

Med. Sta. 5075+89.95
154' Rt. - 1966

New R/W-1969

New R/W-1966

N.4° 42' 57" E. 816.75'(R)

809.17'(R) N. 8° 19' 27" E.

16' Dirt Road

5,282.79'

1476.85'

N 0° 00' 38" E.

16.5'

33' Lt. & Rt.
Belmont Rd. Sta. 0+00
Begin Construction

816.75'(R) N.4° 42' 57" E.

New R/W-1966

N. 8° 19' 27" E. 809.17'(R)

New R/W-1969

N.4° 24' 27" W. 869.85'(R)

New R/W-1966

N. 7° 33' 28" W. 888.33'(R)

New R/W-1969

33' Lt. & Rt.
Belmont Rd. Sta. 20+00
End Constr.

Sta. 12+00
New 36" x 290' R.G.R.C.P.

Med. Sta. 5073+82.97
154' Rt. - 1966

Med. Sta. 5073+31.27
154' Rt. - 1969

Med. Sta. 5073+00.93
154' Lt. - 1966

5070

Med. Sta. 5072+49.19
154' Lt. - 1969

51.10'

3' Drop

100' 154' 54' 100'

300'

7-176 A

FINALIZED

BELMONT ROAD GRADE SEPARATION

See Sheet 16

CROSS ROAD OVER

REDUCED SIZE DO NOT SCALE

Click here for I-10 Index

EHRENBERG - PHOENIX HWY.
TONOPAH - EAST & WEST SEC.
MARICOPA COUNTY

Click here for I-10 Index

REVISIONS				PROJECT NO.	I-10-2(12)91
C.O. No.	DATE	BY	DESCRIPTION	DRAWING NO.	D-7-T-689
1175	7-20-66	D.G.M.	Added Exist. R/W Lines 40' Rt & Lt. Cross Rd.	SHEET NO.	26 of 32
			Relocated Control Pts. Of New R/W To Co-incide With Exist. R/W	DRAWN BY	North
1221	8-2-66	D.G.M.	Changed Dimensions Of New Control Pts.	DATE COMP.	2-11-66
2277	4-69	H.E.D.	Rev. R/W, Drain. Easmts. culverts, Details A,B,C, D, & E. Showed Parcels 7-167-A, 7-168-A, 7-169-A, 7-171-A, & 7-173-1	SCALE	1" = 200'
4770	2-11-77	R.M.M.	Finalized	CONSULTANT	Hayes & Dashney Engineers, Inc.

FINALIZED

T.2N. R.7W.

Fd. ¼ Cor. 1"I.P.& Brass Cap U.S.G.L.O. 1914

Crossroad Sta. 0+00
Approx. Mid-Section Line
40' Rt. Cross Rd. Sta. 0+46.56
40' Lt. Cross Rd. Sta. 0+24.55
Med. Sta. 4962+50 820' Lt.
Med. Sta. 4958+85 725' Lt.
Med. Sta. 4955+00 390' Lt.
Med. Sta. 4945+00 154' Lt.
Med. Sta. 4950+00 180' Lt.
Med. Sta. 4963+75 925' Lt. -1966
SEE DETAIL A
Med. Sta. 4967+10 925' Lt. -1966
SEE Detail D
Med. Sta. 4969+00 795' Lt.
Med. Sta. 4973+00 455' Lt.
Med. Sta. 4978+00 254' Lt.
Med. Sta. 4965+38.93 Cross. Rd. Sta. 11+00
Med. Sta. 4951+50 154' Rt.
Med. Sta. 4957+40 260' Rt.
Med. Sta. 4962+80 725' Rt.
Med. Sta. 4966+75 825' Rt.
Med. Sta. 4968+35 825' Rt.
Med. Sta. 4972+00 720' Rt.
Med. Sta. 4976+00 375' Rt.
Med. Sta. 4980+00 185' Rt.
Med. Sta. 4985+00 154' Rt.
Crossroad Sta. 22+00
40' Rt. Cross Rd. Sta. 21+60.88
40' Lt. Cross Rd. Sta. 21+61.02
Exist R/W
Approx. ¼ Line
W. B. Constr. &
Med. & Survey &
E.B. Constr. &
NE¼ SE¼
NW¼ SW¼
SE¼ SE¼
SW¼ SW¼
7-166
7-167
7-168
7-169
7-170
7-171
7-173
7-173-1
7-168 A
7-169 A
SEE Detail A
SEE Detail B
SEE Detail C
SEE Detail D
SEE Detail E
Detail 'E'
S 75°07'10"E 1988'
N 35°12'53"E 125'(R)
S 75°07'10"E 300.68'
S 75°07'10"E 900.68'(R)
N 82°05'53"E 542.31'
S 89°48'30"E 377.16'(M)
N 63°51'34"E 510.34'(R)
S 75°07'10"E 385.00'(R)
S 52°38'53"E 140.11'(R)
S 53°15'10"E 152.89'
S 75°07'10"E 1985'
S 75°07'10"E 1965'
S 75°07'10"E 1965'
S 75°07'10"E 1965

EHRENBERG-PHOENIX HWY.
TONOPAH-EAST & WEST SEC.
MARICOPA COUNTY

Click here for I-10 Index

CHECKED BY: John Bourque

HARD COPY

FINALIZED

REVISIONS				PROJECT NO.	I-10-2(12)91
C.O. No	DATE	BY	DESCRIPTION	DRAWING NO.	D-7-T-689
1706	3/2/67	R.L.R.	Added Plat covering Parcel 7-161-A	SHEET NO.	27 of 32
2277	4-69	HAD	Added Plat Covering Parcel 7-161-B	DRAWN BY	JIM BRANDON
2364	7-30-69	R.F.L.	Changed Subdivision Call to NE.	DATE COMP.	1-31-66
4770	2-11-77	RMM.	Finalized	SCALE	1"=1000'


Section 21
Subdivision N½ NW¼ NE¼
Township 2 N.
Range 7 W. County MARICOPA

ARIZONA HIGHWAY DEPARTMENT
RIGHT OF WAY SECTION

Serial No. AR-031626
EHRENBERG - PHOENIX Interstate Highway
Project No. I-10-2(12)91

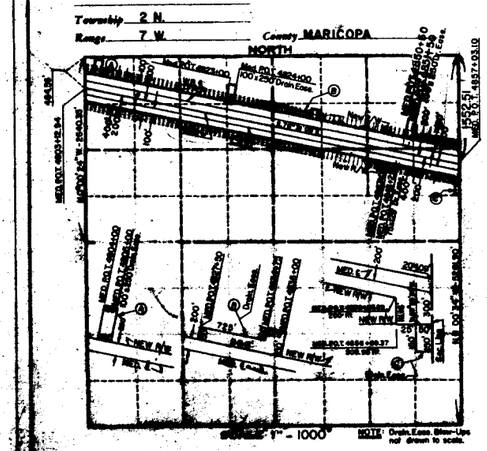
NORTH
MED. POT. 4803+12.94
MED. POT. 4802+50
MED. POT. 4804+00
MED. POT. 4805+50
MED. POT. 4807+03.10
MED. POT. 4857+03.10
N. 0°00'54"W. - 2640.36
S. 0°00'54"W. - 2640.36
1552.51
