EHRENBERG–PHOENIX HWY.

79TH AVE. (PARK & RIDE LOT)

MARICOPA COUNTY

OWNERSHIP RECORD

PARCEL NUMBER	OWNER	DESCRIPTION	TOTAL AREA	AREA REQUIRED: GROSS INCLUDING EXISTING R/W	AREA REQUIRED: NET EXCLUDING EXISTING R/W	EASEMENT AREA	REMAINDER: LEFT	REMAINDER: RIGHT	SHEET NUMBER
7-3914	William Paul Ritter, et ux	Pt. Lots 1 & 2, Sec 2, T.1N.R.1E.	~~1,807,590~~ ~~1,752,662~~		~~495,249~~ ~~297,946~~		~~1,312,341~~ ~~1,454,716~~		1
7-3915	Rousseau, a Limited Partnership	Pt. W½ Sec. 2, T.1N.R.1E.	~~1,716,184~~ ~~1,77,109~~		~~92,224~~ ~~93,336~~		~~1,670,085~~ ~~1,677,773~~		1
7-6240	Salt River Project Agric Improv.	Pt. Lot 2, Sec. 2, T.1N, R.1E.			21,631				1

ACQUISITION RECORD

BOARD APPROVAL	TYPE & DATE OF INSTRUMENT	RECORDED: DATE	RECORDED: BOOK	RECORDED: PAGE
	O.T.P. 12-16-86	1-29-87	87	055~~[illegible]~~

REVISIONS

C.O. No.	DATE	BY	DESCRIPTION
7202	5-20-86	JMG	Revised Prop. Limits Par. 7-3914 & 7-3915
"	"	"	Revised New R/W & Result. Areas Par. 7-3914 & 7-3915
7343	7-28-86	"	" " " " " " 7-3915
7430	12-31-86	MTP	Added Topo to NE 1/4, NW 1/4.
7776	8-11-88	MTP	Added Par. 7-6240 & Detail "B"
7783	8-23-88	KJW	Added Construction Features

PROJECT NO.	QI-10-2 (120)
DRAWING NO.	D-7-T-809
SHEET NO.	1 of 1
DRAWN BY	JMG
DATE COMP.	7-2-85
SCALE	1" = 100'

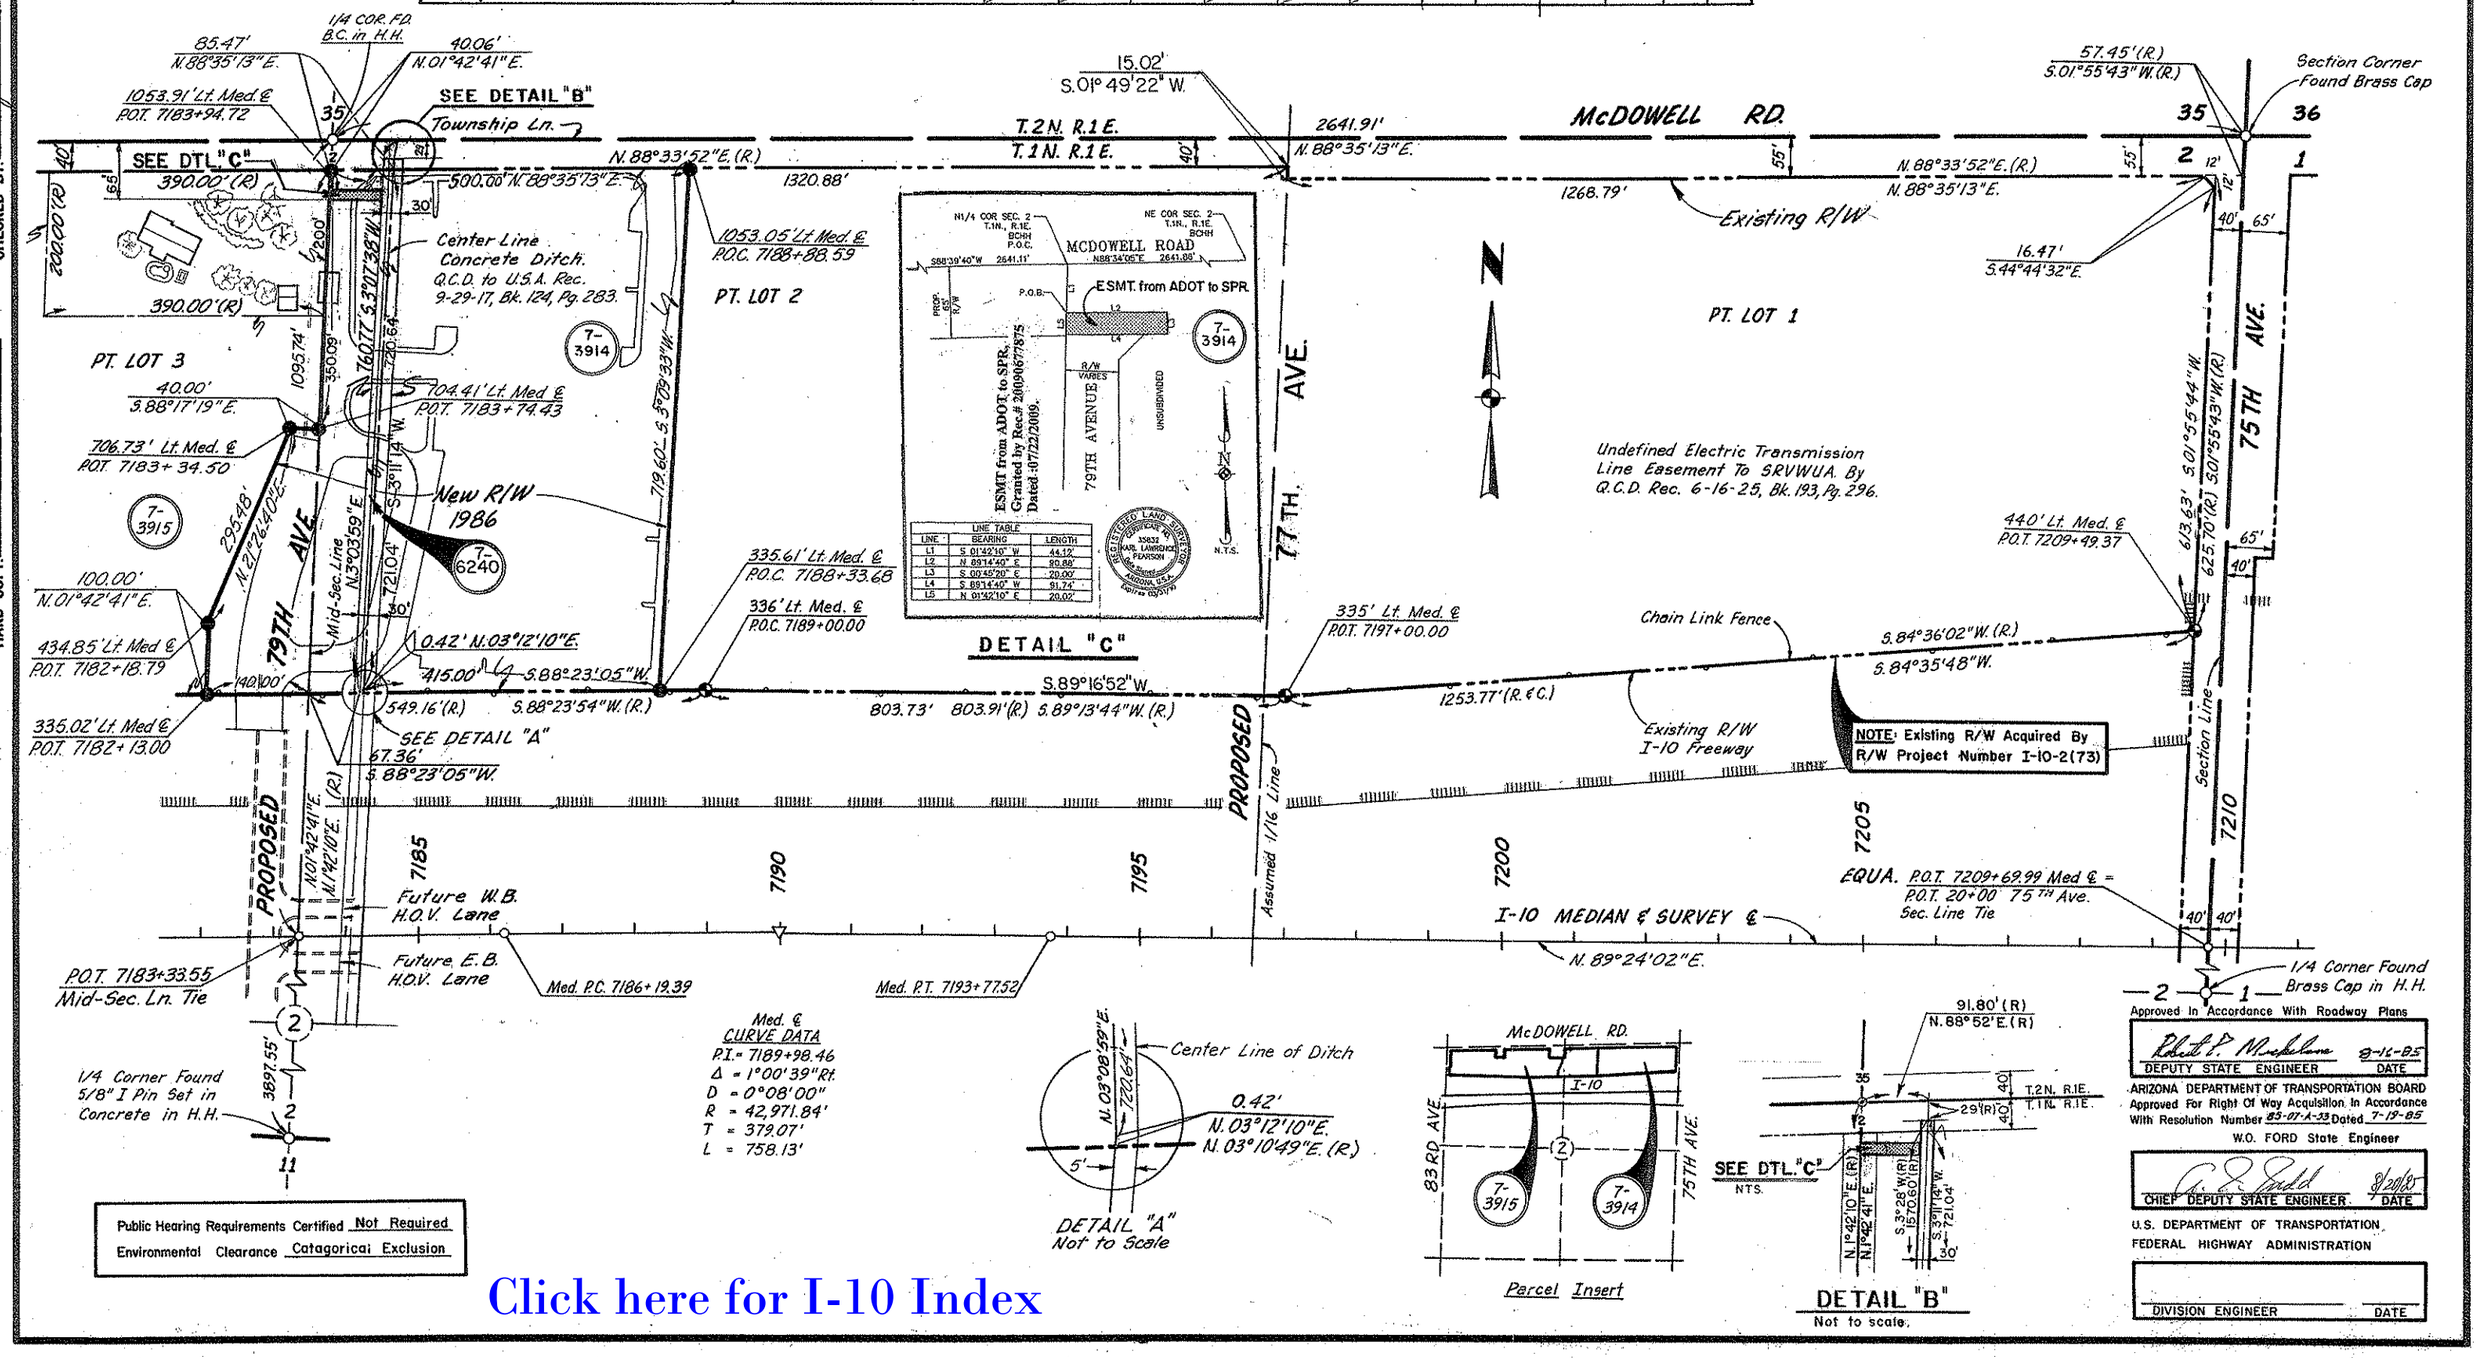

Public Hearing Requirements Certified Not Required

Environmental Clearance Catagorical Exclusion

CHECKED BY: M. Boudro

HARD COPY: 8029 M1

Click here for I-10 Index