CASA GRANDE - TUCSON HWY.

I-10 AT 22ND. ST. O.P.

PIMA COUNTY

PRELIMINARY PRINT

FOR ENGINEERING USE ONLY

SUBJECT TO DESIGN CHANGES, ADDITIONS, ALTERATIONS & CORRECTIONS

DATE 11/15/91 BY Hadley

REGISTERED LAND SURVEYOR CERTIFICATE NO. 7-30 ARIZONA, U.S.A.

REVISIONS				PROJECT NO.	I-10-4-940
C.O. No.	DATE	BY	DESCRIPTION	DRAWING NO.	0-10-T-352
07358	8-12-86	A.T.S.	REPLOT SECTION LINE	SHEET NO.	1 OF 2
7379	9-22-86	A.J.S.	ADD D.E. & T.C.E. PAR. 10-537	DRAWN BY	R.S.
7431	1-8-87	A.J.S.	ADDED NEW C.M.P. & CATCH BASIN	DATE COMP.	6-30-86
"	"	"	RT. STA. 79+14.50	SCALE	1"=50'
8063	1-11-90	MTP	Added Detail "C" & Rev. Par. 10-538		
8399	9-13-91	GRJ	Revised Detail "C"		

Exist. R/W Acquired under Project I-10-4(23).

The Proposed Cutback Extension Area Will Be Used in Exchange For A Portion Of The New R/W Under Parcel 10-538.

OWNERSHIP RECORD / ACQUISITION RECORD

PARCEL NUMBER	OWNER	DESCRIPTION	TOTAL AREA	AREA REQUIRED GROSS INCLUDING EXISTING R/W	AREA REQUIRED NET EXCLUDING EXISTING R/W	EASEMENT AREA	REMAINDER LEFT	REMAINDER RIGHT	BOARD APPROVAL	TYPE & DATE OF INSTRUMENT	RECORDED DATE	RECORDED BOOK	RECORDED PAGE
10-537	AMERICAN INTERNATIONAL HOTEL CONSULTANTS, INC.	PT. SE¼SE¼, SEC. 14, T14S, R13E	281,364 S.F.		1,712 S.F.	502 ± D.E. 1005 ± T.C.E.		~~279,652 S.F.~~ 279,150 S.F.	10-30-86	EXS. TCE 10-20-86	12-02-86	7922	903-906
10-538	BELLA BLEIER, TRUSTEE TRUST DATED 4-16-81	PT. SE¼SE¼, SEC. 14, T14S, R13E	1,003 S.F.		~~142.00~~ 110.00 S.F.			~~861.00~~ 893.00 S.F.					
10-539	BEATRIZ C. AQUINO	PT. SE¼SE¼, SEC. 14, T14S, R13E	6,362 S.F.		635 S.F.			5727 S.F.	11-20-86	R/E 11-10-86	01-20-87	7965	800-802
10-540	RONALD G. VAN ALSTINE, ET UX	PT. SE¼SE¼, SEC. 14, T14S, R13E	11,177 S.F.		635 S.F.			10,542 S.F.	07-02-87	W.D. 04-07-87	07-27-87	08085	0728

Click here for I-10 Index

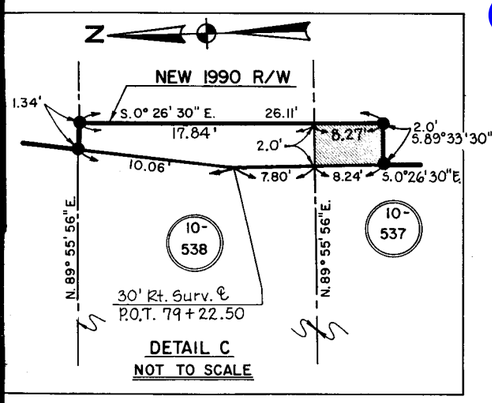

DETAIL C
NOT TO SCALE

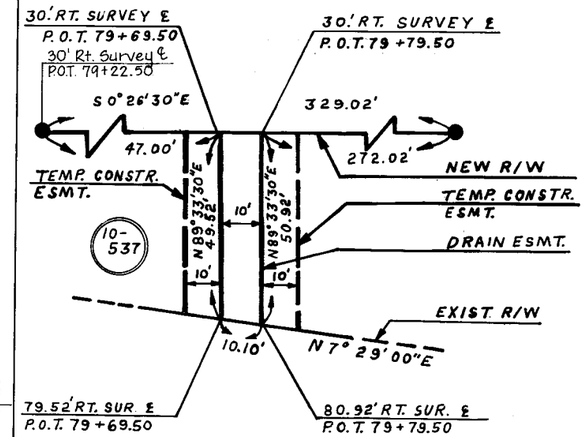

DETAIL A
NOT TO SCALE

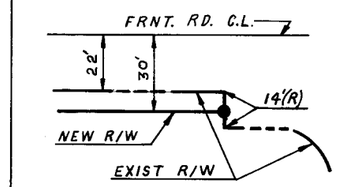

DETAIL B
NOT TO SCALE

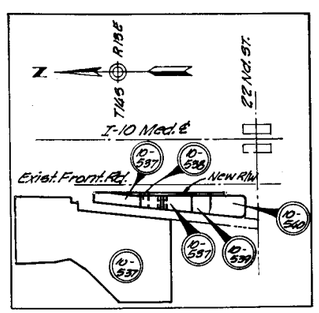

PARCEL INSERT
No Scale

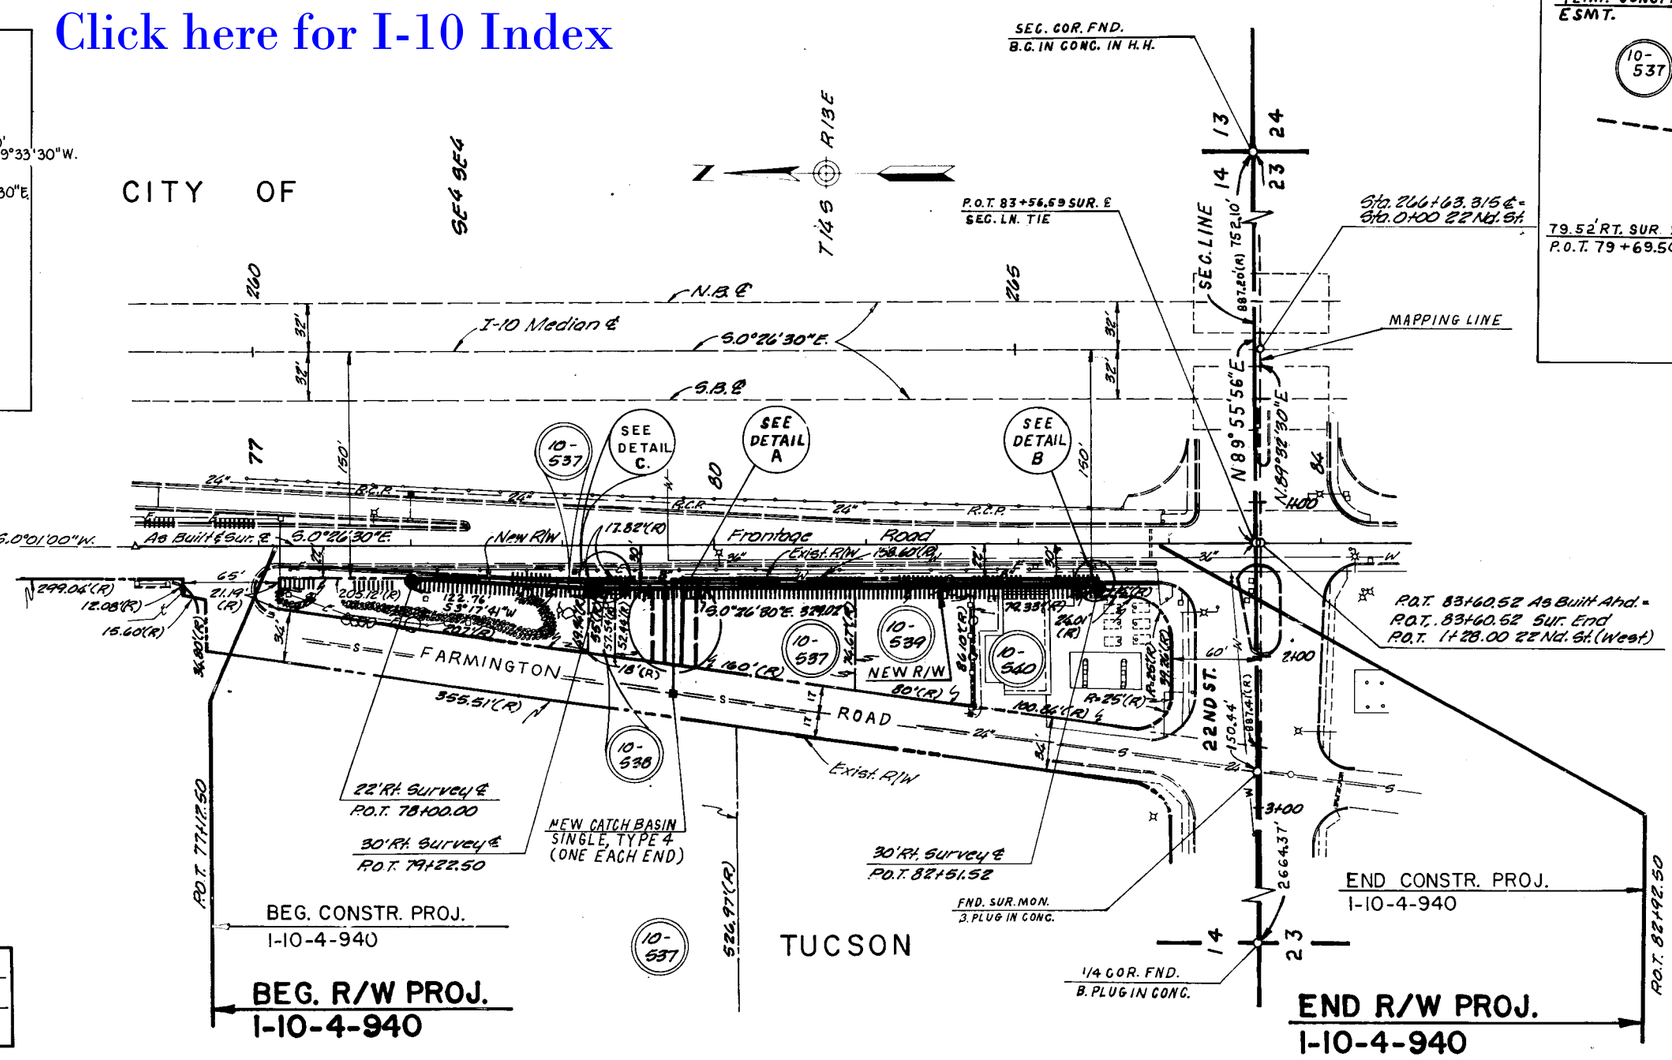

PUBLIC HEARING REQUIREMENTS CERTIFIED Not Required

ENVIRONMENTAL CLEARANCE Categorical Exclusion

APPROVED IN ACCORDANCE WITH ROADWAY PLANS

DEPUTY STATE ENGINEER — DATE 7/28/86

ARIZONA DEPARTMENT OF TRANSPORTATION BOARD APPROVED FOR RIGHT OF WAY ACQUISITION IN ACCORDANCE WITH RESOLUTION NUMBER 86-07-A-55 DATED 7-25-86

WALTER O. FORD — STATE ENGINEER

CHIEF DEPUTY STATE ENGINEER — DATE 7/28/86

U.S. DEPARTMENT OF TRANSPORTATION

FEDERAL HIGHWAY ADMINISTRATION

DIVISION ADMINISTRATION — DATE