Click here for I-10 Index

TUCSON – BENSON HWY.
NO NAME CANYON DRAIN. AREA
PIMA COUNTY

REVISIONS			
C.O. No.	DATE	BY	DESCRIPTION
5641	8-1-80	J. Mc.	Add Parcel 10-397-A
5668	9-17-80	P.Todd	Moved New R/W (Parcel 10-397) 45' Easterly.
"	"	"	Deleted Parcel 10-397-A.

PROJECT NO.	F-10-5-601
DRAWING NO.	D-10-T-388
SHEET NO.	1 OF 1
DRAWN BY	C. PEPPER
DATE COMP.	1-12-76
SCALE	1"=100'

PRINTED
OCT 22 1980
R/W PLANS
PHOENIX, ARIZONA

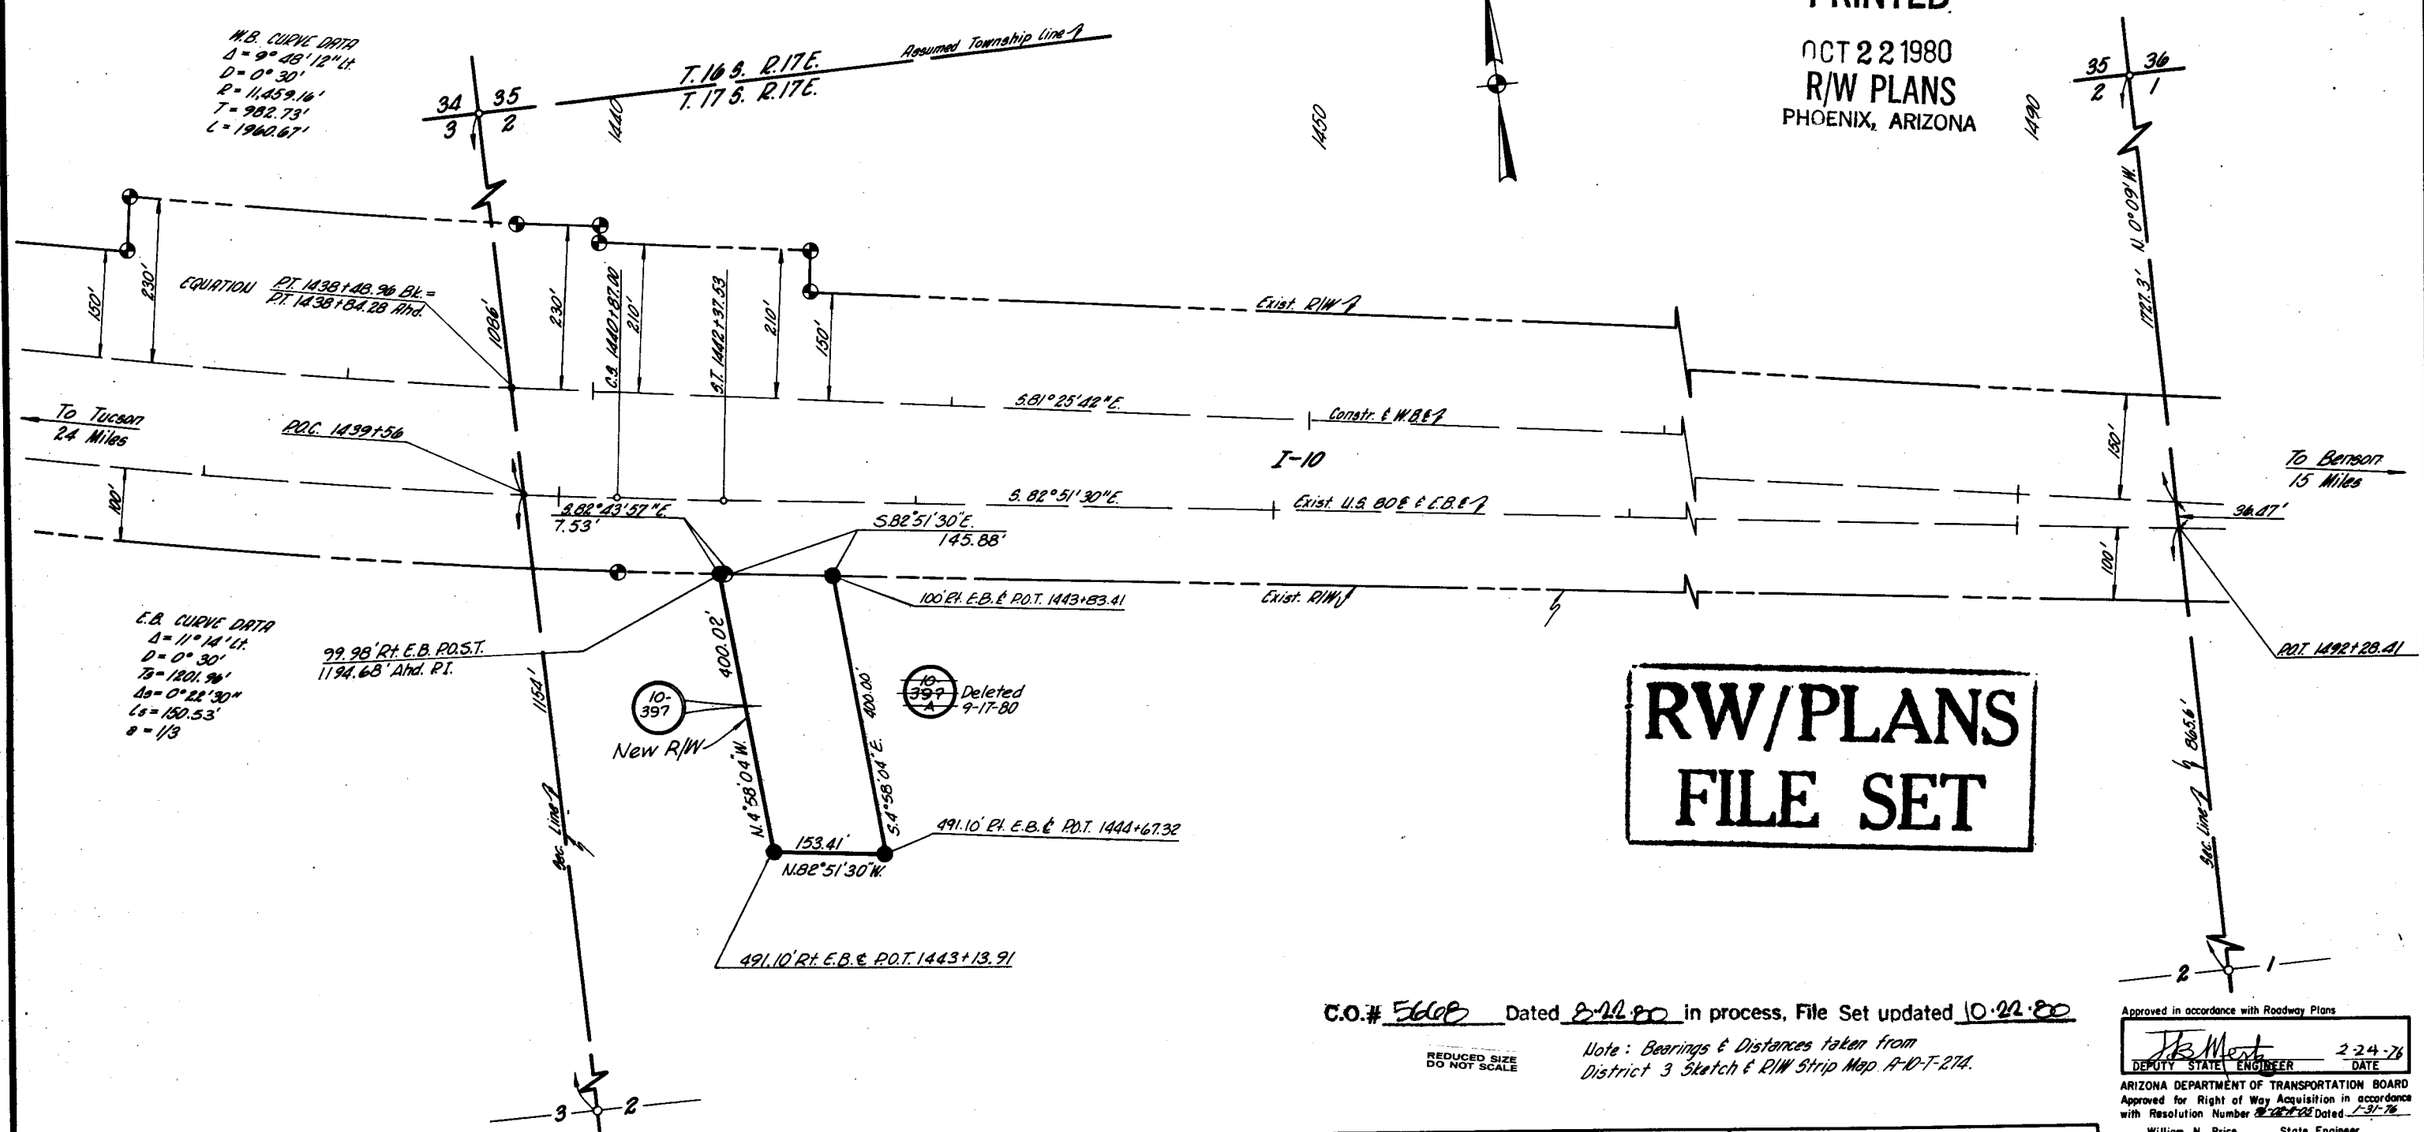

RW/PLANS
FILE SET

C.O.# 5668 Dated 8-22-80 in process, File Set updated 10-22-80

REDUCED SIZE DO NOT SCALE

Note: Bearings & Distances taken from District 3 Sketch & R/W Strip Map A-10-T-274.

Approved in accordance with Roadway Plans
DEPUTY STATE ENGINEER 2-24-76 DATE

ARIZONA DEPARTMENT OF TRANSPORTATION BOARD
Approved for Right of Way Acquisition in accordance with Resolution Number [illegible] Dated 1-31-76
William N. Price State Engineer

CHIEF DEPUTY STATE ENGINEER 2-24-76 DATE

ACQUISITION DETAIL SHEET
PARCEL NO. 10-397 & 10-397-A

OWNERSHIP RECORD / ACQUISITION RECORD

PARCEL NUMBER	OWNER	DESCRIPTION	TOTAL AREA	AREA REQUIRED: GROSS INCLUDING EXISTING R/W	AREA REQUIRED: NET EXCLUDING EXISTING R/W	EASEMENT AREA	REMAINDER: LEFT	REMAINDER: RIGHT	SHEET NUMBER	COMMISSION APPROVAL	TYPE & DATE OF INSTRUMENT	RECORDED: DATE	RECORDED: BOOK	RECORDED: PAGE
10-397	State of Arizona (State Land Department)	Part of Section 2, T.17 S., R.17 E.			1.38 Ac.				1	9-15-76	Grant 10-8-76	Not Recorded		
-L1	Quarter Circle Spear Ranch #L.T.G.-437	" " " " " "			1.38 Ac.				1					
~~10-397-A~~	~~State of Arizona (State Land Department)~~	" " " " " "		DELETED	~~8-80~~ 9-17-80				1					
~~-L1~~	~~Quarter Circle Spear Ranch #L.T.G. 437~~	" " " " " "		DELETED	~~8-80~~ 9-17-80				1					

CHECKED BY: [illegible]
HARD COPY A-10-T-274
BRUNING 44-512