TUCSON - BENSON HWY.
WHETSTONE DRAINAGE EASEMENT
COCHISE COUNTY

Click here for I-10 Index

C.O. NO.	DATE	BY	REMARKS
9478	4-18-01	DET	ADDED DRAINAGE E.SMT. LT. STA. 1225 to 1228
9524	11-01-01	R.C.	DELETED DRAINAGE E.SMT. LT. STA. 1225 to 1228
"	"	"	DELETED PARCEL 2-0977

PROJECT NO.	I-10-5-702
DRAWING NO.	D-2-T-461
SHEET NO.	1 of 1
DRAWN BY	Rene'
DATE COMP.	4-29-83
SCALE	1" = 100'

OWNERSHIP RECORD										ACQUISITION RECORD				
PARCEL NUMBER	OWNER	DESCRIPTION	TOTAL AREA	AREA REQUIRED: GROSS INCLUDING EXIST. R/W	AREA REQUIRED: NET EXCLUDING EXIST. R/W	EASEMENT AREA	REMAINDER: LEFT	REMAINDER: RIGHT	SHEET NUMBER	BOARD APPROVAL	TYPE & DATE OF INSTRUMENT	RECORDED: DATE	RECORDED: BOOK	RECORDED: PAGE
2-631	KATHRYN H. GETZWILLER	Pt. NE4 NW4 Sec. 13, T.17S. R.19E.	297.0 Ac.			0.9 Ac.		296.1 Ac.	1	3-9-84	Esmt. 1-20-84	3-16-84	1748	162-163
~~2-0977~~	" "	" "	" "			~~0.95 Ac.~~	~~0.95 Ac.~~	DELETED		11-01-01				

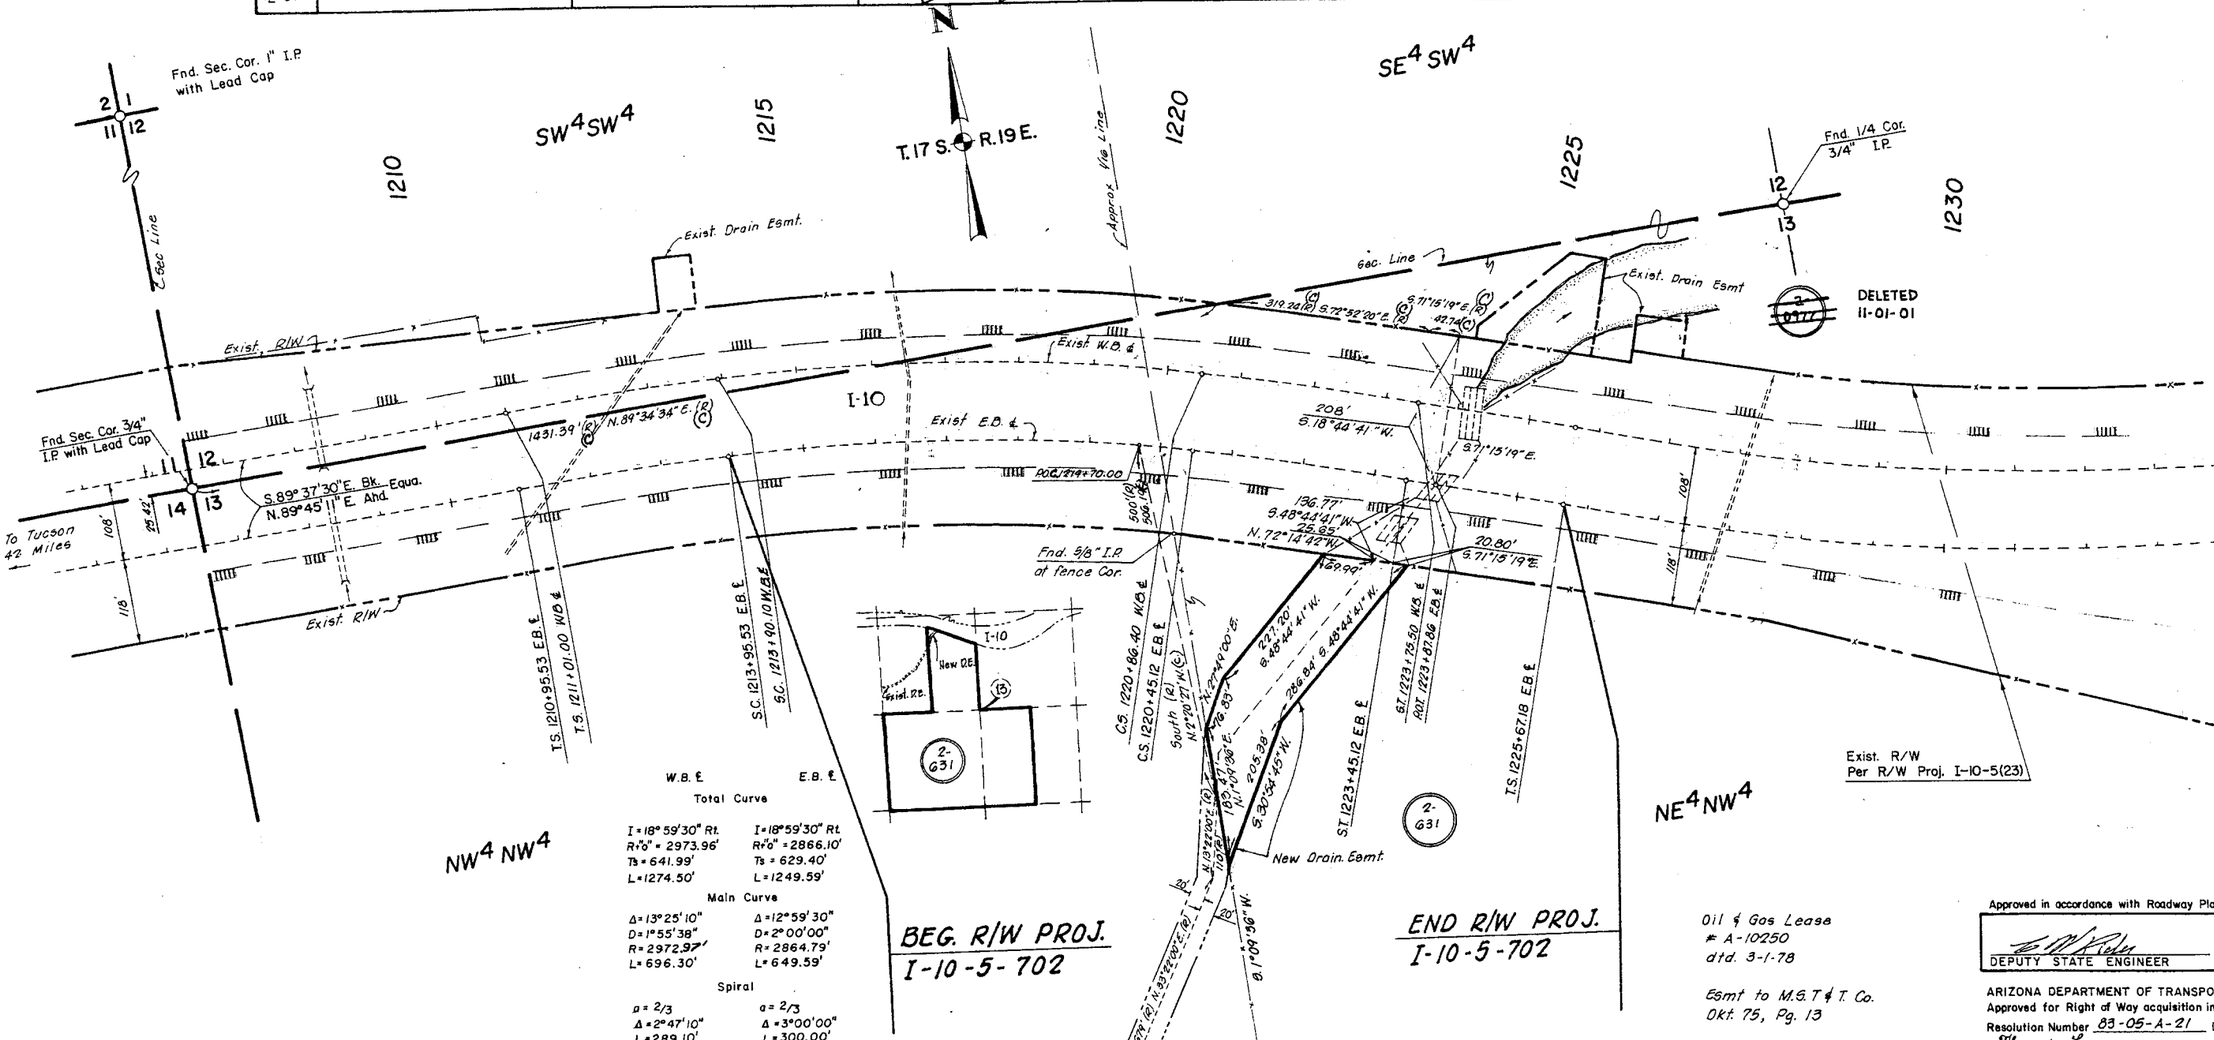

	W.B. ℄	E.B. ℄
Total Curve		
	I = 18°59'30" Rt.	I = 18°59'30" Rt.
	R+'o" = 2973.96'	R+'o" = 2866.10'
	Ts = 641.99'	Ts = 629.40'
	L = 1274.50'	L = 1249.59'
Main Curve		
	Δ = 13°25'10"	Δ = 12°59'30"
	D = 1°55'38"	D = 2°00'00"
	R = 2972.97'	R = 2864.79'
	L = 696.30'	L = 649.59'
Spiral		
	a = 2/3	a = 2/3
	Δ = 2°47'10"	Δ = 3°00'00"
	L = 289.10'	L = 300.00'

Oil & Gas Lease # A-10250 dtd. 3-1-78

Esmt to M.S.T. & T. Co. Okt. 75, Pg. 13

Approved in accordance with Roadway Plans

DEPUTY STATE ENGINEER — DATE 5/12/83

ARIZONA DEPARTMENT OF TRANSPORTATION BOARD
Approved for Right of Way acquisition in accordance with Resolution Number 83-05-A-21 Dated 4-15-83
Thomas, Lammers, State Engineer

CHIEF DEPUTY STATE ENGINEER — DATE 5-5-83

Public Hearing Requirements Satisfied. Not Req'd.
Environmental Impact Statement Requirements Satisfied. 4-26-83

ADOT Survey 11-82
HARD COPY I-10-5(23) R/W Plans
CHECKED BY

AFTER C.O. # 9524