D-2-T-378

Hard Copy 2-H-370

OWNERSHIP RECORD		
ITEM	OWNER	DESCRIPTION
A-23D	STATE LAND	SECTION 27, T-12S R-26E

LEASED TO COOK CATTLE COMPANY

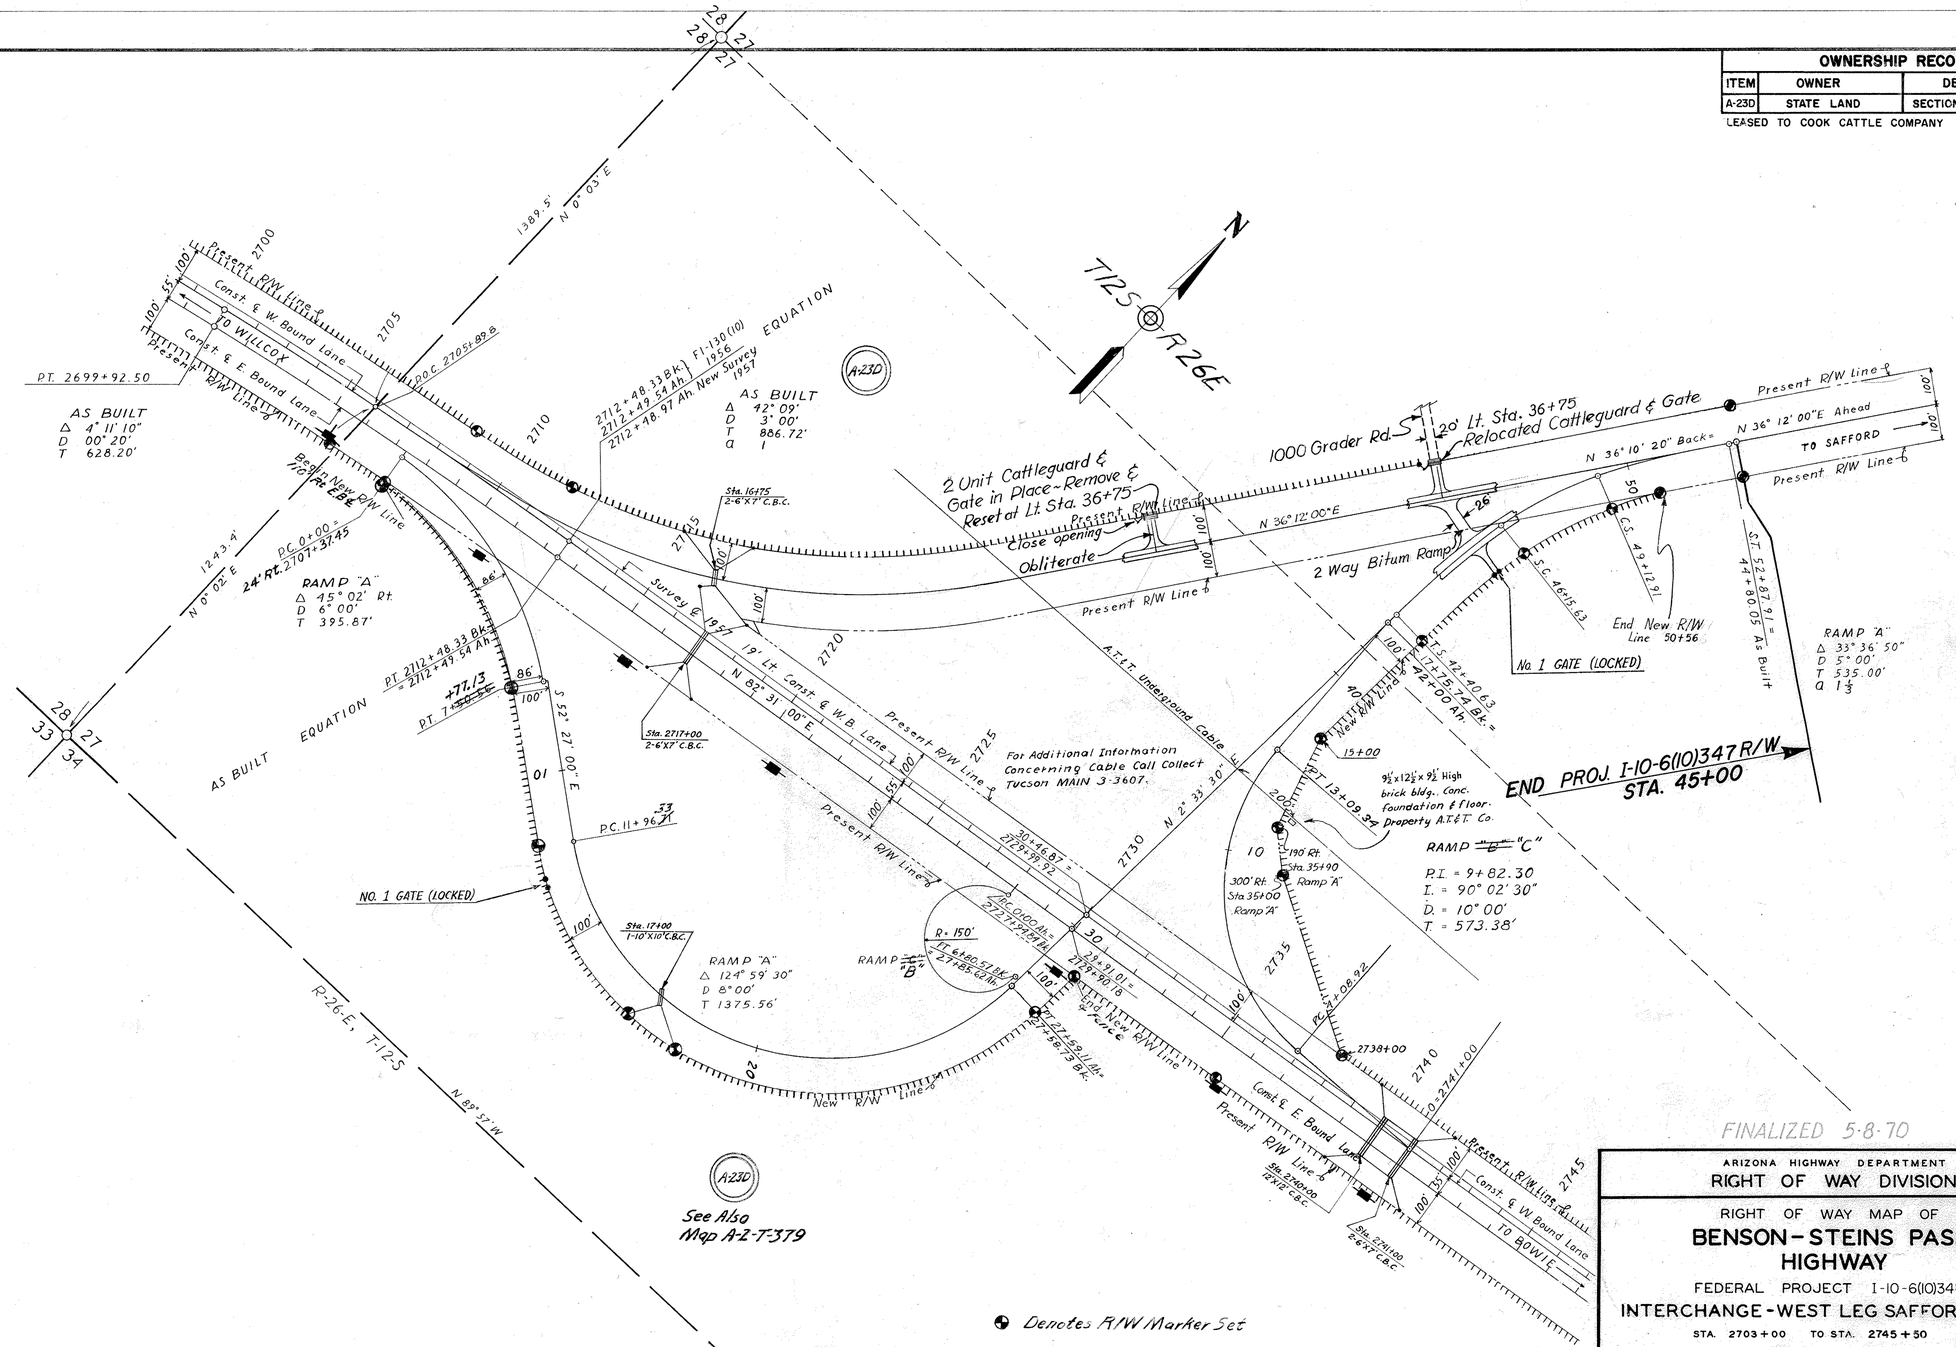

Denotes R/W Marker Set

I CERTIFY THAT THESE R/W PLANS HAVE BEEN COMPARED WITH THE AS-BUILT PLANS OF PROJECT I-10-6(10) & THAT THE STATE OF ARIZONA HAS GOOD AND SUFFICIENT TITLE TO THE R/W AS SHOWN HEREON. 12-19-66
JOHN M. GORMAN
DO NOT REVISE OR ALTER

Registered Professional Engineer (Civil) CERTIFICATE EXPIRES FRANCIS M. LIMBAUGH DEC. 31, 1969 ARIZONA, U.S.A.

LIMBAUGH ENGINEERING CONSULTING ENGINEERS

DESIGN		
TRACED		
CHECKED		

SUBMITTED BY: F. M. Limbaugh
FOR THE CONSULTING ENGINEER

FINALIZED 5-8-70

ARIZONA HIGHWAY DEPARTMENT
RIGHT OF WAY DIVISION

RIGHT OF WAY MAP OF
BENSON-STEINS PASS HIGHWAY
FEDERAL PROJECT I-10-6(10)347 R/W
INTERCHANGE-WEST LEG SAFFORD WYE
STA. 2703+00 TO STA. 2745+50
COCHISE COUNTY

ABUTTORS RIGHTS, INCLUDING ACCESS RIGHTS TO BE ACQUIRED.
DATE _____ ASS'T. STATE ENGINEER

N.W. A.D. W.I.E. 12-15-66 R.W.B.

ALIGNMENT, RIGHT OF WAY, AND CONTROL OF ACCESS APPROVED IN ACCORDANCE WITH RESOLUTION DATED: 7-28 1958, MINUTES OF THE ARIZONA HIGHWAY COMMISSION.

ACCESS RIGHTS REQUIRED SHOWN THUS:

DRAWN BY	DATE	SCALE	CHECKED BY	FILE NO.
K.A. CUMMINGS	DEC. 18 1957	1" = 200'		D-2-T-378

Click here for I-10 Index