Click here for I-10 Index

I-10-6(26)316 10

D-2T-402

7-11-1961 R. E. Lawrence

DATED 6-30-61 NO. 61-175

8691

BENSON-STEINS PASS

I-10-6 (26) 316
COCHISE

FINALIZED

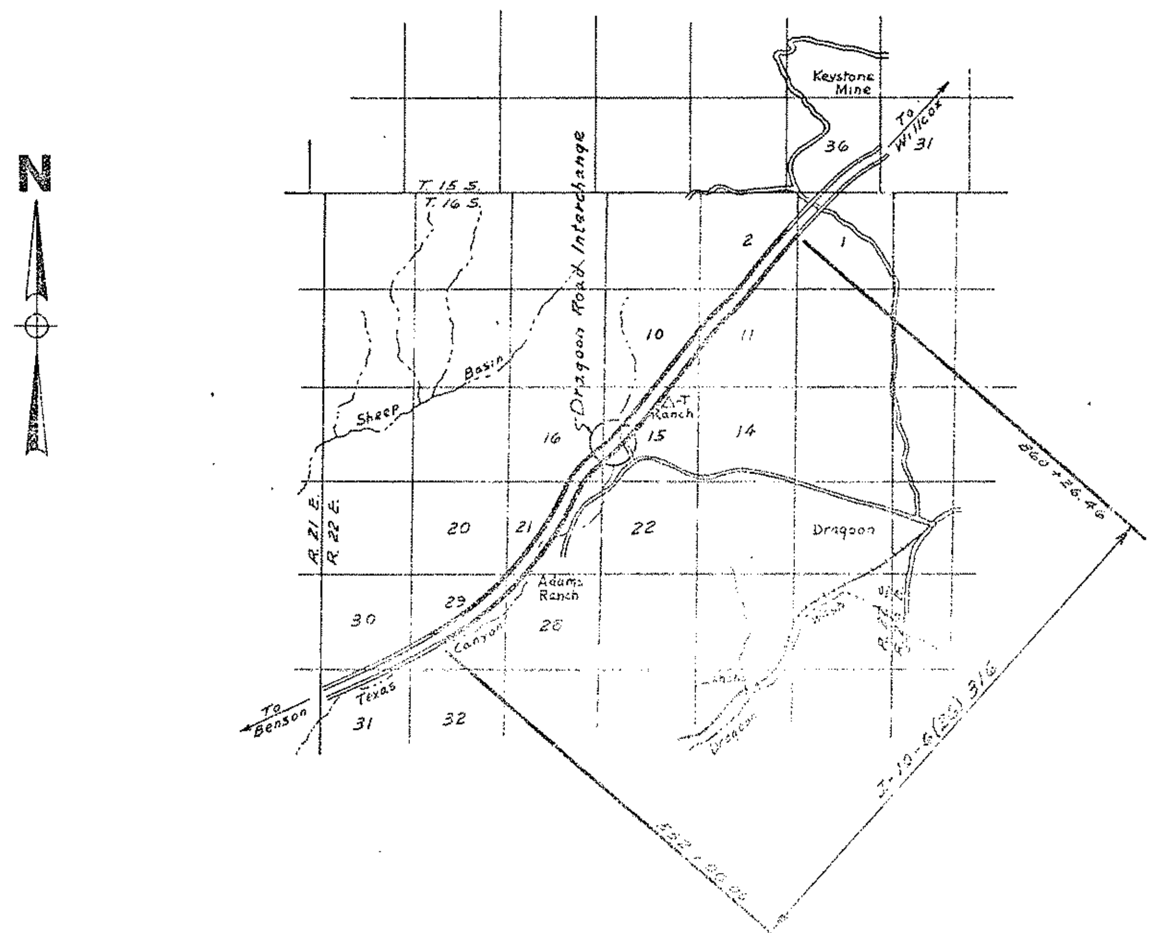

FINALIZATION REVIEW PLANS

As-Built Review: 8-18-70 Hartrim
Parcel Review: 7-16-70 Peterson
Finalization 8-18-70 Hopkins
Supervisor, R/W Plans: [illegible] 8-19-70
Change Order No: 2692
To Administration Division: [illegible] Hopkins 8/19/70

REVISIONS

CO No	DATE	BY	DESCRIPTION
		J.L. Hartrim	FINALIZATION - Changes Shown In Orange
	5-[illegible]-[illegible]	[illegible]	[illegible]
	12-19-60	G. G. H.	[illegible]
	8-10-61	Pete Jensen	Added New R/W on both sides of Hwy. Between Sta's 685 & 690
	8-15-61	Consultant	Revised Dragoon Road Interchange
	8-16-61	L. Draper	Revised Acreage Taken For Items C-624 & C-625
	11-23-61	[illegible]	Changed Distance From 546.50 to 543.50 Item C-623 Also Revised Taken From 2.735 to .31 and Changed Acreage Remaining From [illegible] & [illegible].35 On Item C-623
	[illegible]-62	L. Draper	[illegible] Revised Acreages For Items [illegible]
	[illegible]	[illegible]	[illegible] Sheet 6 of 10. [illegible] Sheet 4 [illegible]

BENSON-STEINS PASS HWY.
TEXAS CANYON-JOHNSON ROAD
COCHISE COUNTY

Click here for I-10 Index

REVISIONS					
C.O. No	DATE	BY	DESCRIPTION	PROJECT NO.	I-10-6(26)316
2632	[illegible]	Hartrim	FINALIZATION-Changes Shown In Orange	DRAWING NO.	D-27-402
				SHEET NO.	2 of 10
				DRAWN BY	L. Draper
				DATE COMP.	7-12-61
				SCALE	

FINALIZED

OWNERSHIP RECORD SHEET

ITEM	OWNER	DESCRIPTION	ACREAGE TAKEN	ACREAGE REMAIN'G	DATE PROP ACQUIRED	SHEET NO.	RECORDING DATE & TYPE OF INSTR.	BOOK & PAGE
C-623	~~Bert H. & Mary Jane Bellusci H/W 2/3 Int.~~ Jack A. & Violet R. Wilson H/W 3/5 Int.	E½ NW¼, SW¼ NE¼, NW¼ SE¼, Pt. NE¼ SW¼ SEC. 15 T. 16 S. R. 22 E.	.31	185.38	3-23-62	6 & 7	8-6-68 F.O.C.	Dkt. 551/377-380A
C-624	Lloyd C. & Letha B. Adams H/W	E½ SW¼, SE¼ NW¼, E½, Pt. NE¼ NW¼, Sec. 29 NW¼ Sec. 28 SW¼, E½ NW¼, NE¼ Sec. 21; Pt. NW¼ SW¼, W½ NW¼, SW¼ SW¼, Pt. SE¼ SW¼, Pt. NE¼ SW¼ Sec. 15 T. 16 S. R. 22 E.	6.75 ~~6.712~~ Drainage Easement .20	~~1120.262~~ 1,603.93	3-19-62	3, 4, 5 & 6	3-22-65 F.O.C.	Dkt. 379/486-493
C-625	State	Pt. Lot 1, Pt. S½ NE¼, NW¼ SE¼, NE¼ SW¼, SW¼ SE¼ Sec. 2 T. 16 S. R. 22 E.	Access Rights Only	—	8-23-61	8 & 10	8-23-61	R/W Grant
		SE¼ Sec. 16, NW¼ NE¼ Sec. 15 T. 16 S. R. 22 E.	0.711	159.289	8-23-61	5 & 6	8-23-61	R/W Grant
C-625 -L1	Grazing Lease - Lloyd C. Adams Dragoon Arizona	All Sec. 16 T. 16 S. R. 22 E.	—	—	—	5 & 6	—	—
C-625 -L2	Grazing Lease - William S. Fulton Dragoon Arizona	NW¼ NE¼ Sec. 15 T. 16 S. R. 22 E.	—	—	—	7	—	—
C-625 -L3	Grazing Lease - Lizzie Adams	NE¼ SE¼, SE¼ SW¼ Sec. 2 T. 16 S. R. 22 E.	—	—	—	8 & 10	—	—
C-626	James L. & Margaret I. Finley H/W	Pt. N½ NW¼ SW¼ Sec. 15 T. 16 S. R. 22 E.	2.~~549~~68	2.~~382~~31	3-23-62	6	8-6-68 F.O.C.	Dkt. 551/377-380A
C-627	Roy W. & Geraldine C. McGoffin	E½ SW¼, SW¼ SW¼ Sec. 10 T. 16 S. R. 22 E.	Access Rights Only	—	3-14-62	7	6-13-62 Easm't.	Dkt. 303/491-492
C-628	William S. & Rose H. Fulton H/W	N½ SE¼, SW¼ SE¼, SE¼ NE¼, SE¼ SE¼, Sec. 10 SW¼ NW¼, NW¼ NW¼, E½ NW¼, Sec. 11 T. 16 S. R. 22 E.	Access Rights Only	—	2-15-62	7, 8 & 9	6-19-62 Easm't.	Dkt. 304/137-138
C-629	~~A. Hicks Lawrence New York N.Y.~~	~~Pt. S½ NE¼, Pt. Lot 1 Sec. 2 T. 16 S. R. 22 E.~~	~~Access Rights Only~~	—	—	~~10~~	PREVIOUS	ACQUISITION
C-630	U.S. Government - Grazing Lease Mr. & Mrs. Elmer Walker Dragoon Ariz.	Pt. Lot 1 Sec. 10 T. 16 S. R. 22 E.	~~Access Rights Only~~ 3675 Sq. Ft.	—	11-28-61	9	1-25-62	R/W Grant
A-138	~~Carl H. Ingwer Jr. S/S~~	~~NW¼ SW¼ Sec. 29 T. 16 S. R. 22 E.~~	~~Access Rights Only~~	—	—	~~3~~	ACQUIRED	UNDER
A-139	~~Lloyd C. & Letha B. Adams H/W~~	~~SW¼ SW¼ Sec. 29 T. 16 S. R. 22 E.~~	~~Access Rights Only~~	—	—	~~3~~	PROJECT	I-10-6(8)
C-628-1	William S. & Rose H. Fulton, H/W	Pt. SE¼ NE¼, Sec. 10, & Pt. W½ NW¼, Sec. 11, T. 16 S. - R. 22 E.	REST AREAS 9.84 Ac.	309.06	6-6-62	7, 8, & 9	3-6-63 W.D.	Dkt. 322/121-123

BENSON–STEINS PASS HWY.
TEXAS CANYON–JOHNSON ROAD
COCHISE COUNTY

REVISIONS			
C.O. No.	DATE	BY	DESCRIPTION
		Hartrim	FINALIZATION-Changes Shown In Orange

PROJECT NO.	I-10-6(26)316
DRAWING NO.	D-2T-402
SHEET NO.	3 of 10
DRAWN BY	J.G.M.
DATE	5/9/61
SCALE	1"=100'

FINALIZED

T.16S. R.22E.

E.B. CONSTR. ℄	E.B. SURVEY ℄
Δ = 34°-22'-31" Lt.	Δ = 39°41'-00" Lt.
D = 0°-23'-54"	D = 0°24'-00"
R = 14,381.21'	R = 14,323.95'
T = 4448.33'	T = 5169.10'
L = 8628.17'	L = 9920.80'

Acquired Previous Proj. I-10-6(8)310 R/W — A-138 — NW ¼ SW ¼ — Sec. Line — Approx. 1/16 Sec. Line — Approx. Mid Sec. Line — SW ¼ NE ¼ — NW ¼ NE ¼ — C-624

Exist. R/W — 540 — Existing 40' Roadway — P.C.C. 549+00.00 E.B. — 550 — Exist Type 1 gate-Remove-Fence Across — 4 BW Fence — 560 — 570 — 160' — 60' — 100'

Exist. West Bound ℄ — East Bound Survey ℄ — East Bound ℄ — N. 66°40'-30" E. — 2 — 42" CMP — 54" CMP — M.P. #304 — Not Found — 29

Exist. R/W — 26° — American Tel. & Tel. Coaxial Cable — El Paso Natural Gas Pipeline — Approx. 1/16 Sec. Line — SW ¼ SW ¼ — Acquired Previous Proj. I-10-6(8)310 R/W — A-139

Exist Type 2 gate-Remove Fence Across — P.O.C. 557+00 to P.O.C. 557+75 — Temporary 20' Construction Easement — 566+40.00 Power Line — Exist. R/W — Approx. Mid Sec. Line — NW ¼ SE ¼ — C-624

END PROJ. I-10-6(8)310 R/W — P.O.C. 552+00.00
~~END PROJ.~~ — BEGIN PROJ. I-10-6(26)316 R/W
END CONST. PROJ. I-10-6(9)310 — BEGIN PROJ. I-10-6(27)316 CONSTR.
SEE R/W MAP A-2T-374

NOTE: All Stationing is in reference to the East Bound Survey ℄.

Approx. Mid Sec. Line — SW ¼ NE ¼ — C-624 — Exist. R/W — 570 — 160' — 50' — 100' — Exist West Bound ℄ — East Bound Survey ℄ — East Bound Constr. ℄ — 580 — 2 — 4 BW Fence — U.S.C.&G.S. Triang. Sta. "CUT" (1960) — 2 Wire — NW ¼ NE ¼ — C-624 — Not Found — E.B. Constr. ℄ Δ = 34°-22'-31" Lt. D = 0°-23'-54" R = 14,381.21' T = 4448.33' L = 8628.17' — E.B. SURVEY ℄ Δ = 39°41'-00" Lt. D = 0°24'-00" R = 14,323.95' T = 5169.10' L = 9920.80' — 6'x7' C.B.C. P.O.C. 596+90.4 — NE ¼ NE ¼ — C-624 — Exist Type 1 gate Remove Fence Across — Exist. R/W — 590 — 30 Wire AT&T — 42" CMP — 600 — 160' — 60' — 100' — 6'x6' CBC — Exist. R/W

NW ¼ SE ¼ — Approx. Mid Sec. Line — C-624 — Approx. 1/16 Sec. Line — C-624 — SE ¼ NE ¼ — Approx. 1/16 Sec. Line — C-624 — P.O.C. 596+50 to P.O.C. 597+50 — Temporary 20' Construction Easement — P.O.S.T. 1201.00' Ahd. of P.I. Survey ℄ — 1112.90' to Sec. Cor. — N. 0°-04'-00" W. — N. 26°59'-30" E.

Click here for I-10 Index

BENSON–STEINS PASS HWY.
TEXAS CANYON–JOHNSON ROAD
COCHISE COUNTY

Click here for I-10 Index

REVISIONS			
C.O. No	DATE	BY	DESCRIPTION
2692	6-17-70	Hartrum	FINALIZED Slight Changes Shown In Orange

PROJECT NO.	I-10-6(26)316
DRAWING NO.	D-2T-402
SHEET NO.	4 of 10
DRAWN BY	J.G.M.
DATE	5/9/61
SCALE	1"=100'

ROLAND WADSWORTH, JR. REG. No. 11461 — REGISTERED LAND SURVEYOR — STATE OF ARIZONA

FINALIZED

E.B. SURVEY ℄
Δ = 39°41'-00" Lt.
D = 0°24'-00"
R = 14,323.95'
T = 5169.10'
L = 9920.80'

T.16.S. R.22.E.

NE ¼ NE ¼ — C-624 — P.O.C. 604+18.05 — P.O.C. 602+24.58 — Exist. R/W — 30 Wire AT&T — 160' — 60' — 100' — 600 — 601

Sec. Cor. Found Stone Marked 4 Notches on East, 2 Notches on South, Mound of Stone West.

SE ¼ SE ¼ — 20 — 29 — 21 — 28 — 25023 — 4610 — 3752' — 20539'

SW ¼ SW ¼ — C-624

P.O.C. 604+78.48

610

4 BW Fence

2652.20 — 154.39' — N.0°04-00"W. — 603+50.0 Tgt. Line. — 127.59'

¼ Cor. Found 1" Iron Pipe Mound of Stone West.

P.O.C. 606+07.93

Exist Type 1 gate & 2 Unit Cattle Guard Remove & Salvage - Fence Across

New Type 1 gate (Locked)

P.O.C. 601+18.05

N.89°59'00"E. 197.60'

P.O.C. 606+86.90

P.O.T. 2450.4' Ah. of P.I. Survey ℄

NW ¼ NW ¼ — 2624.49' — ¼ Cor. Found Stone Marked ¼ on North, Witnessed By 2 Bearing Trees

M.P. #305

90" Str. Plate Pipe

2 Wire

P.O.C. 619+00 to P.O.C. 621+00
Temporary 30' Construction Easement

620

NW ¼ SW ¼ — C-624 — Exist Type 1 gate To Remain Locked — Exist. R/W — 630 — 160' — 60' — 100'

Exist. West Bound ℄
East Bound Survey ℄
East Bound Const. ℄

Approx. 1/16 Sec. Line — Not Found — SE ¼ SW ¼ — Approx. 1/16 Sec. Line

NE ¼ SW ¼ — C-624

NW ¼ SW ¼ — Approx. 1/16 Sec. Line

Approx. Mid Sec. Line — P.T. 634+93.80 — C-624

P.T. 635+28.17 E.B. Bk
P.T. 635+26.13 E.B. Ahd
EQUATION

96" Str. Plate Pipe

Exist Type 1 gate - Remove - Fence Across

P.O.T. 647+00.00

4 BW Fence

630 — 640 — 650 — 660

N. 26°59'-30"E.

48" CMP

Exist. West Bound ℄
East Bound Survey ℄
East Bound Const. ℄

Exist. R/W

P.O.C. 634+25 to P.O.T. 635+25
Temporary 30' Construction Easement

Exist Type 2 gate - Remove Fence Across

2 Wire

NE ¼ SW ¼ — C-624 — SE ¼ NW ¼ — Approx. Mid Sec. Line — 21 — Not Found

SW ¼ NE ¼ — C-624 — Approx. 1/16 Sec. Line — NW ¼ NE ¼ — C-624 — 21 — Not Found

BENSON–STEINS PASS HWY.
TEXAS CANYON–JOHNSON ROAD
COCHISE COUNTY

REVISIONS			
CO. No.	DATE	BY	DESCRIPTION
2692	8-17-70	Yakeley	FINAL ALIGNMENT - Changes Shown In Orange

PROJECT NO.	I-10-6(26)316
DRAWING NO.	D-2T-402
SHEET NO.	5 of 10
DRAWN BY	J.G.M.
DATE	5/9/61
SCALE	1"=100'

ROLAND WASHBURN, JR. Exp. 31, 19 61 ARIZONA

1/4 Cor. Found Stone Marked 1/4 on North, Witnessed By Mound of Stone North.

Approx. Mid Sec. Line

NW 1/4 NE 1/4

C-624

N 89°57'30" E

C-625

C-625 L-1

SW 1/4 SE 1/4

T. 16 S. R. 22 E.

P.O.C. 666+26.21

Exist. Type 1 gate - Remove - Fence Across

Exist. Type 1 gate - Remove - Fence Across

P.I. 672+40.60 E.B. Survey ℄

P.O.S.T. 667+12.20

Sec. Line

Approx. 1/16 Sec. Line Not Found

Approx. 1/16 Sec. Line

C-625

C-625 L-1

P.O.C. 687+50 to 688+25 100' Construction Easement

NE 1/4 SE 1/4

125' RT. W.B. 686+75

125' RT. W.B. 688+25

Exist. Type 1 gate - Remove - Fence Across

Exist. R/W

P.C. 662+55.81 E.B.

Existing West Bound ℄

East Bound Survey ℄

East Bound Const. ℄

New R/W

Exist. R/W

160'

60'

10'

100'

660

18.91'

161.80'

128.10'

M.P. 306

8'x6' C.B.C.

670

43° C.M.P.

680

690

700

710

N 26°59'30" E

N 51°11'30" E

Ramp "D"

90" Str. Plate Pipe

Exist. Type 2 gate - Remove - Fence Across

P.O.C. 667+91.86

4 BW Fence

P.O.C. 667+25.47

P.T. 681+91.81 E.B. Bk

P.T. 681+95.79 E.B. Ahd

EQUATION

E.B. Survey ℄ SPIRAL

a = 1/2

Δ = 1°33'-45" Rt.

L = 250.00'

t = 125.00'

"0" = 0.57'

T.S. 661+32.80

S.C. 663+82.80

C.S. 680+68.80

S.T. 683+18.80

150' RT. E.B. 686+50

150' RT. E.B. 688+50

Exist. R/W

Exist. Type 2 gate - Remove Fence Across

E.B. SURVEY ℄

TOTAL		MAIN	
Δ =	24°12'00" Rt.	Δ =	21°04'30" Rt.
R+0 =	4584.23'	D =	1°15'00"
T =	1107.80'	R =	4583.66'
L =	2186.00'	L =	1686.00'

2659.30'

1859.19'

Not Found

NE 1/4 NE 1/4

Sec. Cor. Found "X" on West Slope of Boulders Witnessed By 2 Bearing Trees.

FINALIZED

Sec. Cor. Found "X" on Rock Ledge Mound of Stone Placed By R.E. Cain.

(R.E. Lawrence 1938) N 1°56' W

New R/W

R/W Markers Set

Approx. Mid Sec. Line

4 BW Fence To Remain

4 BW Fence Remove

℄ RAMP "C"

℄ RAMP "D"

Exist. R/W

R/W Marker Set

3,322.50'

2,552.44'

0.33' N & 9' To 1/4 Cor.

P.O.T. 693+00.00 E.B. Survey ℄

P.C. 700+06.27 W.B.

P.C. 700+06.27 E.B.

P.O.T. 695+39.77 (Col.)

N 51°11'-30" E

Existing West Bound ℄

East Bound Survey ℄

East Bound Const. ℄

℄ RAMP "A"

℄ RAMP "B"

New R/W

R/W Markers Set

Exist. R/W

N 0°03'30" E 1891.50'

1929.37' N 1°26'26" E

EQUATION P.T. 717+57.11 W.B. Bk

P.T. 717+75.43 W.B. Ahd

N. 33°28'00" E.

P.C. 718+77.43 E.B.

P.T. 717+78.77 E.B. Bk

P.T. 717+75.43 E.B. Ahd

EQUATION

Not Found

Not Found

T. 16 S. R. 22 E.

DRAGOON ROAD INTERCHANGE

SEE SHEET NO. 6

Click here for I-10 Index

BENSON–STEINS PASS HWY.
TEXAS CANYON–JOHNSON ROAD
COCHISE COUNTY

Click here for I-10 Index

REVISIONS			
C.O. No.	DATE	BY	DESCRIPTION
2692	8-17-70	Fortrim	FINALIZATION - Changes Shown in Orange

PROJECT NO.	I-10-6(26)316
DRAWING NO.	D-2T-402
SHEET NO.	6 of 10
DRAWN BY	J.G.M.
DATE	5/9/61
SCALE	1"=100'

FINALIZED

T.16S. R.22E.

E.B. SURVEY & SPIRAL
a = 1/2
Δ = 1°-00'-00"
L = 200.00'
t = 100.00'
'o' = 0.29'

E.B. SURVEY & MAIN
TOTAL Δ = 17°-43'-30" Lt.
R = 0 + 5729.87'
T = 993.50'
L = 1972.50'
MAIN Δ = 15°-43'-30" Lt.
D = 1°-00'-00"
R = 5729.58'
L = 1572.50'

EQUATION P.T. 717+57.11 W.B. Bk = P.T. 717+75.43 W.B. Ahd
EQUATION P.T. 717+78.77 E.B. Bk = P.T. 717+75.43 E.B. Ahd

Exist. Edmy.
New Edge Road
R.E. Lawrence (1938)
Temporary Construction Easement for Connection to Exist. Mining Rd.
2 Wire
Not Found
Sec. Cor. Fd. "X" on Rock Ledge, Mound of Stone Placed By R.E. Cain
NE 1/4 SE 1/4
SE 1/4 NE 1/4
SW 1/4 NW 1/4
NW 1/4 NW 1/4
Approx. 1/16 Sec. Line
C-625
C-625 L-1
C-624
C-626
C-623
459.84' Lt. Survey ℄ P.O.S.T. 700+28.98
470.03' Lt. Survey ℄ P.O.C. 702+48.49
N.46°-49'-03"E.
New R/W
New Cattle Guard, 2 Unit
Limit of Slope
R/W Markers Set
P.O.T. 695+20.85
N.20°-38'-53"E.
Exist. R/W
Ramp "D" ℄
Ramp "C" ℄
N.25°-38'-W.
P.O.C. 705+50.00
2-8"x7"x16' Conc. Box In Pl.
Ext. Rt. & Ext. Lt.
N.77°-46'-57"E.
P.O.C. 707+79.60
4 BW Fence
P.O.T. 694+80.00
N.51°-11'-30"E.
T.S. 699+04.60
P.C. 700+06.27 WB & EB
R=5569.58'
West Bound ℄
East Bound Survey ℄
East Bound Constr. ℄
P.O.C. 704+71.24
P.I. 708+98.10 E.B. SURVEY ℄
Ramp "A" ℄
P.O.T. 695+39.77
S.C. 701+04.60
P.O.T. 694+55.12
N.62°-15'-42"E.
Ramp "B" ℄
C.S. 716+77.10
S.T. 718+77.10
P.C. 718+78.10 Survey ℄
N.30°-31'-00"E.
257.55' Rt. Survey ℄ P.O.C. 706+97.96
258.10' Rt. Survey ℄ P.O.C. 702+28.35
N.46°-32'-30"E.
N.82°-42'-30"W.
New Cattle Guard, 4 Unit
New Type I gate
S.47°-26'-W. 296.53'
N.34°-56'-44"E. 61.24'
N.0°-03'-30"E. 1891.30'
N.1°-26'-26"E.
Not Found Section Line
SE 1/4 SE 1/4
SW 1/4 SW 1/4
NW 1/4 SW 1/4
NE 1/4 SW 1/4
Sec. Cor. Fd. "X" on West Slope of Boulders, Witnessed By 2 Bearing Trees.
Approx. 1/16 Sec. Line
Not Found
Not Found
Not Found
Exist. R/W
Limit of Slope
R/W Marker Set
New R/W
Conc. Blk. Cafe
Gas Sta. Wash Hse.
Water Tank
Old Shed
Pump Island
Sign Base
Well
Fr. Shed
Conc. Blk. Foundation
Old Tank
Exist. Road
Exist. R/W
R=5829.58'
L=1235.38
L=775.27'
L=460.11'
543.50'
1020.74'
1798.35'
1891.30'
599.2'
209.63'
357.48'
448.56'
349.53'
415.17'
417.40'
296.53'
206.31'
471.24'
2146.54'
240.77'
351.45'
DRAGOON ROAD INTERCHANGE
SEE SHEET NO. 5

BENSON–STEINS PASS HWY.
TEXAS CANYON–JOHNSON ROAD
COCHISE COUNTY

Click here for I-10 Index

REVISIONS			
C.O No.	DATE	BY	DESCRIPTION
2692	8-17-70	Hartrim	FINALIZATION-Changes Shown In Orange

PROJECT NO.	I-10-6(26)316
DRAWING NO.	D-2T-402
SHEET NO.	7 of 10
DRAWN BY	J.G.M.
DATE	5/9/61
SCALE	1"=100'

Registered Professional Engineer (Civil) CERTIFICATE EXPIRES NO. 3119 Wade Cook, Jr. ARIZONA, U.S.A.

T.16S. R.22E.

Approx. 1/16 Sec. Line — NE¼ NW¼ — C-623

Exist. R/W — 4 BW Fence — Exist Type I gate-Remove & Fence Across

160' / 60' / 100'

M.P. #307 — 720

Exist. R/W — Exist Type I gate & 2 Unit Cattle Guard-Remove & Fence Across — 15° Skew Ahd.

E.B. SURVEY ℄
Δ = 7°43'-00" Rt.
D = 0°06'-00"
R = 57,295.80'
T = 3864.40'
L = 7716.70'

10:10' C.B.C.
P.O.T. 726+19.20

Ramp B T — 4 BW Fence Remove — 730

Existing West Bound ℄
East Bound Survey ℄
East Bound Constr. ℄

SE¼ NW¼ — C-623

Sec. Cor. Found "X" on Rock Ledge Mound of Stone Placed By R.E. Cain.

N89°22'-30"E 2731.3' R.E. Lawrence Survey (1938)

9 / 16 / 10 / 15

SE¼ SW¼ — C-627

P.O.C. 737+43.15

46.67

¼ Cor. Found

232.11

111.30

42.14

P.O.T. 738+38.40 Sec. Line (Survey ℄)

N. 33°28'-00"E.

2 / 2

225.59

P.O.C. 739+63.08

P.O.C. 739+39.21

R/W Marker Set

Approx. Mid Sec. Line

Not Found (15)

NW¼ NE¼ — C-625 — C-625 L2

N89°24'-00"E 2175.00' R.E. Lawrence Survey (1938) 2586.28'

10 / 15 / 11 / 14

Sec. Cor. Found Stone Marked 4 Notches on South 2 Notches on East Witnessed By a Mound of Stone North.

Not Found (10)

SW¼ SE¼ — C-628

5 BW Fence — Exist. R/W

4 BW Fence — Exist. R/W

6'x7' C.B.C.
P.O.T. 744+24.0

FINALIZED

Approx. 1/16 Sec. Line — NW¼ SE¼ — C-628

T.16S. R.22E.

5 BW Fence — Exist. R/W

P.I. 757+42.50 E.B. Survey ℄

160' / 60' / 100'

2 / 2

Existing West Bound ℄
East Bound Survey ℄
East Bound Constr. ℄

750 — 720

5 BW Fence Remove

Not Found

SW¼ SE¼ — C-628

Approx. 1/16 Sec. Line — SE¼ SE¼

E.B. CONSTR. ℄
Δ = 7°-37'-31" Rt.
D = 0°-06'-00"
R = 57,295.80'
T = 3818.28'
L = 7625.28'

E.B. SURVEY ℄
Δ = 7°43'-00" Rt.
D = 0°-06'-00"
R = 57,295.80'
T = 3864.40'
L = 7716.70'

Approx. Mid Sec. Line — Not Found (10)

SE¼ NE¼ — C-628

Sta. 781+01.22
585' Lt. Exist. ℄

R/W Marker Set

Sta. 778+79.30
160' Lt. Exist. ℄

C-628-1

48" C.M.P.

4 BW Fence — Exist. R/W

R/W Marker Set

MATCH LINE

160' / 60' / 100'

2 / 2

M.P. #308 — 710

R/W Marker Set — 780

4 BW Fence — Exist. R/W

NE¼ SE¼ — C-628

Sec. Cor. #3 for Restking (Covers Shts 1-6)

C-628-1

TO REST AREA

Sec. Cor. Found Stone Marked 4 Notches on South 2 Notches on East Witnessed By Mound of Stone North

N0°07'-30"E 5287.10 to Sec. Cor.

¼ Cor. Not Found

Sta. 777+66.38
100' Rt. Exist. ℄

10 / 15 / 11 / 14

R/W Marker Set

Sta. 779+99.04
335' Rt. Exist. ℄

BENSON--STEINS PASS HWY.
TEXAS CANYON-JOHNSON ROAD
COCHISE COUNTY

REVISIONS			
C O No.	DATE	BY	DESCRIPTION
2692	8-17-70	Hertrim	FINALIZATION - Changes Shown In Orange

PROJECT NO.	I-10-6(26)316
DRAWING NO.	D-2T-402
SHEET NO.	8 of 10
DRAWN BY	J.G.M.
DATE	5/9/61
SCALE	1"=100'

Registered Professional Engineer — Roland Wagoner — Arizona, U.S.A.

Sta. 787+98.78
385 Lt. Exist. ℄
Sec. Cor. Found 2" Iron Pipe With Brass Cap U.S.G.L.O. 1918, Witnessed By a Mound of Stone West.

N 40°19'-02"E 697.56'
S ¼ NE ¼
WITCH LANE
N00°07'-30"E 5287.10
1352.50'
C-628 -1
P.O.S.T. 2428.50' Ahd P.I. (Survey ℄)
W.B. REST AREA
See C.O. #3 (See Sheet 9)
6.6' C. Bridge C.
P.O.T. 790+83.0
Sta. 790+25.70
160' Lt. Exist. ℄
T.16S. R.22E.
N
P.T. 795+94.80
Exist. R/W
4 BW Fence
NW ¼ NW ¼
C-628
Sec. Cor. Found 2" Iron Pipe With Brass Cap U.S.G.L.O. 1918, Witnessed By A Mound Of Stone West.
S89°57'-00"E 1102.90'
Not Found
P.O.T. 806+11.76
P.O.T. 807+51.50 Sec. Line
Survey ℄
C-625
C-625 L-3
SE ¼ SW ¼
Exist. R/W
160'
60'
100'
780
790
800
810
Existing West Bound ℄
N41°11'-00"E Survey ℄
East Bound Survey ℄
East Bound Constr. ℄
2
TO SHEET 7 of 10
E.B. REST AREA
See C.O. #3 (See Sheet 9)
R/W Marker Set
Sta. 789+33.62
100' Rt. Exist. ℄
SW ¼ NW ¼
Approx. 1/16 Sec. Line
EQUATION P.T. 795+02.95 E.B. Bk. = P.O.T. 795+12.75 Ahd E.B. Ahd.
4 BW Fence
USC&GS Station "Texas Summit" (1960)
Exist Type I gate - Remove - Fence Across
48" CMP
P.O.T. 808+38.84
132.77'
2622.40'
786.73'
Exist. R/W
NE ¼ NW ¼
C-628
Sec. Cor. Found Stone Marked 4 Notches on South 2 Notches on East Witnessed By a Mound of Stone North
-701.92'
S 89°58'-00"W
Sta. 787+00.96
335' Rt. Exist. ℄
Cor. Found Stone Marked # on North Witnessed By 2 Bearing Trees.
T.16S. R.22E.

FINALIZED

SE ¼ SW ¼
C-625
C-625 L-3
T.16S. R.22E.
N
2
Exist. R/W
Exist Type I gate - Remove - Fence Across
4 BW Fence
Not Found
Approx. Mid Sec. Line
C-625
Exist Type I gate - Remove - Fence Across
Exist. R/W
810
820
830
840
160'
60'
100'
Existing West Bound ℄
N41°11'-00"E Survey ℄
East Bound Survey ℄
N41°05'-31"E E.B. ℄
M.P. #309
East Bound Constr. ℄
2
Exist. R/W
Exist Type 2 gate - Remove Fence Across
6'x7' C.B.C.
P.O.T. 813+48.5
6'x7' C.B.C.
P.O.T. 833+38.5
Exist Type 2 gate - Remove - Fence Across
Exist. R/W
Sec. Line
Approx. Mid Sec. Line
Approx. 1/16 Sec. Line
SW ¼ SE ¼
C-625
NW ¼ SE ¼
Approx. 1/16 Sec. Line

Click here for I-10 Index

BENSON–STEINS PASS HWY.
TEXAS CANYON–JOHNSON ROAD
COCHISE COUNTY

REVISIONS			
C.O. No.	DATE	BY	DESCRIPTION
2692	8-17-70	Hartrim	FINALIZATION - Changes Shown In Orange

PROJECT NO.	I-10-6(26)316
DRAWING NO.	D-2T-402
SHEET NO.	9 of 10
DRAWN BY	J.G.M.
DATE	5/9/61
SCALE	1"=50'

FINALIZED

Registered Professional Engineer — Certificate Expires — Robert Wasmuth, Jr. — Dec. 31, 1961 — Arizona, U.S.A.

C-628

C-628-1

C-630

T.16 S. R.22 E.

SE¼ NE¼

NE¼ NW¼

NW¼ NW¼

SW¼ NW¼

Lot 1

Sec. Cor Found 2" Iron Pipe With Brass Cap, U.S.G.L.O. 1918, Witness By a Mound of Stone West.

N40°19'02"E 109.88' 8.71'

71.19'

84.84'

Not Found

P.O.C. 781+01.22
385' Lt. Survey ℄

R/W Marker Set

N.40°19'02"E.
697.56'

P.O.C. 778+74.50
160' Lt. Survey ℄

N.4°57'41"W.
315'

160' Lt. Survey ℄
P.O.C. 778+74.30
R/W Marker Set

Exist. R/W

R=57,455.8

456.91'

4 BW Fence

REST AREA

1730.22'

5287.10'

Approx. 1/16 Sec. Line N.89°58'07"E.

N.89°02'19"E.
315'

P.O.C. 787+98.70
385' Lt. Survey ℄

R/W Marker Set

Exist. R/W

P.O.C. 790+25.70
160' Lt. Survey ℄

R/W Marker Set

Exist. R/W

1151.40'

R=57,455.8

REST ROOM

RAMADA

FIREPLACE

24'

TABLE

RAMADA

FIREPLACE

24'

EXIST. REST AREA

222.28'

142'

129'

130'

130'

160'

60'

760

790

Existing West Bound ℄

East Bound Survey ℄

East Bound

P.O.S.T. 2428.50' Ahd. P.I. (Survey ℄)

28.21'

P.O.C. 781+37.47

157.08'

100'

56'

Constr. ℄

EXIST. REST AREA

58'

76'

REST ROOM

TABLE

TABLE

RAMADA

FIREPLACE

Exist. R/W

R=57,195.8

R=57,195.8

R/W Marker Set

4 BW Fence

1167.24'

R/W Marker Set

Exist. R/W

REST AREA

P.O.C. 790+83.00
6×6×128.9' Conc. Box In Pl.
Ext. Rt. 18'

P.O.C. 789+33.62
100' Rt. Survey ℄

P.O.C. 777+66.38
100' Rt. Survey ℄

3556.88'

3.32'
S.84°55'19"W.

3.32'
S.55°08'41"E.

¼ Cor. Not Found

N.0°07'30"E.

10 11 15 14

Sec. Cor. Found Stone Marked 4 Notches on South, 2 Notches on East Witnessed By a Mound of Stone North.

R/W Marker Set

701.92'
S.89°53'19"W.

R/W Marker Set

P.O.C. 779+99.04
335' Rt. Survey ℄

P.O.C. 787+00.96
335' Rt. Survey ℄

E.B. CONSTR. ℄
Δ = 7°-37'-31" Rt.
D = 0°-06'-00"
R = 57,295.80'
T = 3818.28'
L = 7625.28'

E.B. SURVEY ℄
Δ = 7°43'-00" Rt.
D = 0°06'-00"
R = 57,295.80'
T = 3864.40'
L = 7716.70'

R.L.A.

I-10-6(27)

Click here for I-10 Index

BENSON–STEINS PASS HWY.
TEXAS CANYON–JOHNSON ROAD
COCHISE COUNTY

PROJECT NO.	I-10-6(26)316
DRAWING NO.	D-2T-402
SHEET NO.	10 of 10
DRAWN BY	J.G.M.
DATE	5/9/61
SCALE	1"=100'

ROLAND MARCHBORTH, JR. REGISTERED LAND SURVEYOR No. 1961 PHOENIX, ARIZONA

THIRD STANDARD PARALLEL SOUTH
T.15S. R.22E.
T.16S. R.22E.

Sec. 2 — Sec. 35 — Sec. 36 — Sec. 1

SW¼ NE¼ — NE¼ NE¼ — NW¼ NW¼ — SW¼ NW¼ — NE¼ SE¼ — SE¼ NE¼

C-625 — C-629 — C-625 L-3

Approx. 1/16 Sec. Line — Approx. Mid Sec. Line — Section Line — Sec. Line (Survey ℄)

N33°34'W. 600' to Cor.

S.56°26'W. 1500' to Cor.

P.O.T. 846+00.00 Survey ℄

7.16 — R.22E.

TUNGSTEN MINING CLAIM
GIJA #2
M.S. 4002

2-10"7" C.B.C.
P.O.C. 860+26.46
P.C. 856+10.93 E.B.
P.C. 850+24.64 E.B.

Sec. Cor. Found Stone Marked 5 Notches on West, S.C. on North.

Closing Cor. Found Stone Marked / Notch on East 5 Notches on West

Exist. Type I gate — Remove fence Across

Exist Type I gate To Remain

P.O.C. 861+35.09

Exist. R/W — Not Found — 91.39' — Existing West Bound — East Bound, Survey ℄ — East Bound Constr. ℄

160' — 60' — 100'

840 — 248.86' — 380.18' — 850 — 4 BW Fence — 902.74' — 870.96' — 1658' — 160' — 100' — 166' — 1036.52' — 237.45' — 153.49' — 242.28' — Not Found — 220.35' — 8.43' — 166' — 100' — 2622.7' — 998.35'

N41°11'00"E. E.B. Survey ℄
N41°05'31"E E.B. Constr. ℄

Dyke in Place

Exist. R/W — Exist Type I gate-Remove-Fence Across

Parcel 69 L — Acquired Under Proj. I-002-5(3) St. Land Off R/W #1687

N0°35'00"W.
N33°34'W.

N2°31'E. 877.5'

¼ Cor Found 1" Iron Pipe With Brass Cap U.S.G.L.O. (1918)

P.O.C. 859+56.86

P.O.C. 860+26.46

END PROJ. I-10-6(26)316 R/W

END PROJ. I-10-6(27)316 CONSTR.

BEGIN PROJ. I-002-5-(3) SEE R/W MAP A-2T-366

S.89°58'00"E.

E.B. SURVEY ℄	E.B. CONSTR. ℄
Δ = 21°22'30" Rt.	Δ = 21°27'59" Rt.
D = 0°40'00"	D = 0°40'
R = 8594.37'	R = 8594.37'
T = 1621.98'	T = 1629.08'
L = 3206.25'	L = 3219.96'

REVISIONS

C.O. No.	DATE	BY	DESCRIPTION
2692	8-17-70	Hartrim	FINALIZATION - Changes Shown In Orange

FINALIZED

Click here for I-10 Index