Click here for I-10 Index

FED ROAD DIVISION	STATE	PROJECT NUMBER	SHEET NUMBER	TOTAL SHEETS	FINALIZED PLANS
7	ARIZ.	I-10-6(52)	1	21	

DRAWING NUMBER	D-2-T-430

6842	6-29-77	R.M.M.	Finalized

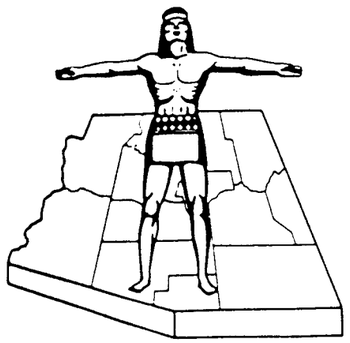

STATE OF ARIZONA
STATE HIGHWAY DEPARTMENT

RIGHT OF WAY PLAN OF THE
BENSON—STEINS PASS
STATE HIGHWAY
PROJECT NO. I-10-6(52)
COCHISE
COUNTY

FINALIZED

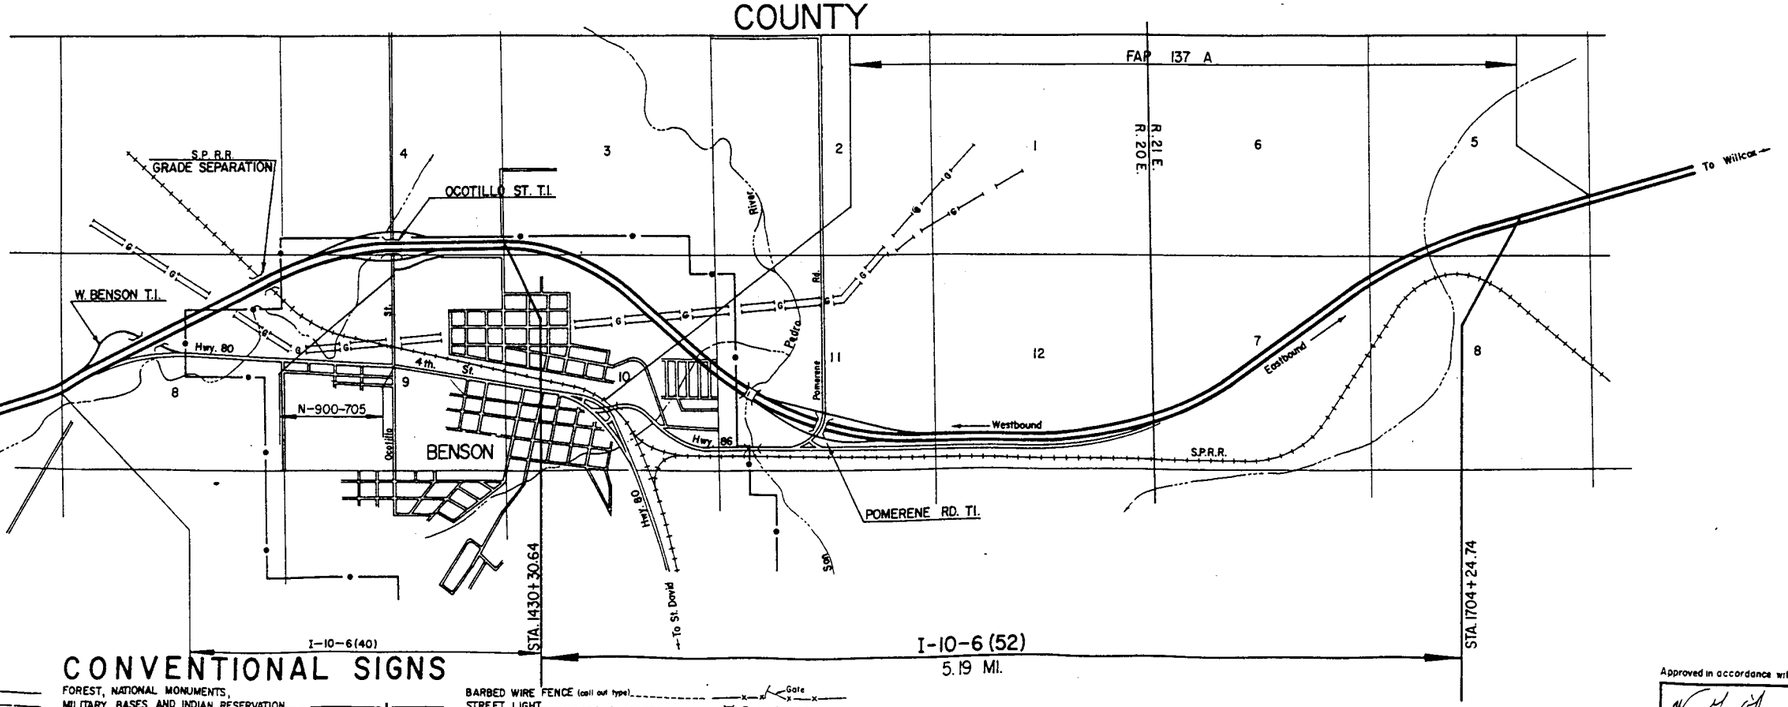

CONVENTIONAL SIGNS

- HIGHWAY CENTER LINE (Laid)
- HIGHWAY R/W LINE (Existing)
- CONTROLLED ACCESS (Existing) (Proposed)
- R R R/W COMMON TO HIGHWAY R/W (Existing)
- R R R/W LINE (Existing)
- TOWNSHIP AND RANGE LINE
- SECTION LINE
- 1/4 LINE OR MID-SECTION LINE
- 1/16 LINE
- PROPERTY LINE (Not part of a Subdivision)
- SUBDIVISION OR LOT LINE
- ORIGINAL LOT LINE
- STATE AND NATIONAL BOUNDARIES
- COUNTY LINE
- CITY LIMITS
- LAND GRANTS BOUNDARIES

- FOREST, NATIONAL MONUMENTS, MILITARY BASES AND INDIAN RESERVATION — I
- SURVEY MEANDER LINE — II
- NEW R/W CONTROL POINT
- EXISTING R/W MARKER
- PARCEL NUMBER — 7-001
- RAILROAD TRACK
- POWER LINE
- POWER TRANSMISSION LINE
- TELEPHONE LINE
- COMBINATION TELEPHONE AND POWER LINE
- UNDERGROUND TELEPHONE CABLE — T T
- WATER LINE — W 2"
- GAS LINE — G 2"
- SEWER LINE — S 2" (Show size of line in alternate spaces)
- STORM DRAIN — SD 2"
- CHAIN LINK FENCE

- BARBED WIRE FENCE (call out type)
- STREET LIGHT
- WATER METER
- WATER VALVE
- DOWN GUY
- FIRE HYDRANT
- GAS METER
- GAS VALVE
- MANHOLE (existing)
- ROAD (existing)
- PROPERTY ANCHOR BARS
- PROPERTY LIMITS ARROWS
- CANAL, CHANNEL OR DITCH
- BRIDGE
- BOX CULVERTS
- CATTLE GUARD
- RIVER
- PIPE CULVERTS (New) (Existing)
- DYKE

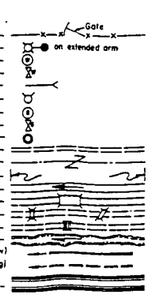

REDUCED SIZE
DO NOT SCALE

Approved in accordance with Roadway Plans

W. D. Ottosen — 10-1-69
ASSISTANT STATE ENGINEER — DATE

ARIZONA STATE HIGHWAY COMMISSION
Approved for Right of Way Acquisition in accordance with Resolution Number 69-62 dated 7-15-69
William N. Price — State Highway Engineer

10-1-69
DEPUTY STATE ENGINEER — DATE

U. S. DEPARTMENT OF TRANSPORTATION
FEDERAL HIGHWAY ADMINISTRATION
BUREAU OF PUBLIC ROADS
Approved:

DIVISION ENGINEER — DATE

Click here for I-10 Index

BENSON - STEINS PASS HWY.
BENSON INTERSTATE FREEWAY UNIT II
COCHISE COUNTY

FINALIZED

REVISIONS			
C.C. No.	DATE	BY	DESCRIPTION
2509	1-22-70	EJT	Revised Parcel 2-206
2536	2-9-70	P.Todd	Add. Areas from Deleted Parcel 2-206-1 to 2-207 on separate Line, lower portion of Record Col.
2532	2-9-70	P.Todd	Chngd. Owners name, Parcel 2-205, from Loma Linda University, a Calif. Corp, to Tracy R. Comstock et ux.
2576	3-5-70	MF	Added Rem. R/ Area to Excess Areas Par. 2-198
2580	4-1-70	P.Todd	Deleted Parcel 2-209. Revised Area for Parcels 2-206 & 2-207.
2578	4-7-70	P.Todd	Exc. Areas not changed in Parcel 2-199
2586	4-17-70	A.W.B.	Revised Par. 2-199, 200, 202
2607	5-29-70	L.M.F.	Changed Sheet No. to 21.
2740	10-15-70	A.W.B.	Revised Par. 2-205.
2801	12-10-70	Morris	Revised Areas of Parcel 2-207 & Added Note Re. to Same Parcel.
"	"	"	Deleted Parcel 2-206.
2796	12-17-70	L.G.M.	Comp. acq. record.
2837	1-21-71	T.E.K.	Rev'd Par. 2-207, added Par. 2-207-A.
2841	2-4-71	R.L.R.	Revised Acq. Rec. Parcels 2-198, 2-207, 2-208
2936	4-27-71	Morris	Revised Area Par. 2-198 & Note Re. to Excess R/W.
"	"	"	
3417	1-3-72	D.G.M.	Revised Areas Par. 2-207 & ***Note.
"	"	"	Deleted Par. 2-207-A.
4799	3-23-77	R.C.O.	Rev'd Areas Par. 2-207 & removed Excess R/W note. ***
4842	4-29-77	P.M.M.	Finalized

PROJECT NO.	I-10-6(52)306
DRAWING NO.	D-2-T-430
SHEET NO.	2 of 21
DRAWN BY	Gromer
DATE COMP.	9-30-69
SCALE	
Consultant	O'Brien & Speer

CHECKED BY R.F.C. For Consultant

HARD COPY

OWNERSHIP RECORD

PARCEL NUMBER	OWNER	DESCRIPTION	TOTAL AREA	AREA REQUIRED GROSS INCLUDING EXISTING R/W	AREA REQUIRED NET EXCLUDING EXISTING R/W	EASEMENT AREA	REMAINDER LEFT	REMAINDER RIGHT	SHEET NUMBER
2-198	Max Treu Jr., et ux	Pt. of S½ SW¼, Sec. 3, T.17S., R.20E.	20.0 Ac.	8.8 Ac.	⊕ ~~8.9~~ ~~21 A.~~ Ac.	10.7 Ac.	~~0.0~~ ~~.03 A.~~ Ac.		5 & 6
2-199	Percy A. Devereaux, et ux	Pt. of NW¼ NW¼, Sec. 10, T.17S., R.20E.	12.0 Ac.	~~11 Ac.~~ 6.0 Ac.	~~0.007 Ac.~~ 4.9 Ac.	~~4.9~~ Ac.		6.0 Ac.	5
2-200	Margaret Emmeline Haverty a widow	Pt. of NW¼ NW¼, Sec. 10, T.17S., R.20E.	15.6 Ac.	~~11 Ac.~~ 1.5 Ac.	~~0.9 Ac.~~ 1.3 Ac.	~~0.4~~ Ac.		14.1 Ac.	5 & 6
2-201	Glenn D. Scott, et ux	Pt. of N½ NW¼, Sec. 10, T.17S., R.20E.	6.3 Ac.	1.2 Ac.	1.1 Ac.			5.1 Ac.	5 & 6
2-202	Percy A. Devereaux, et ux	Pt. of E½ NW¼, Sec. 10, T.17S., R.20E.	36.9 Ac.		~~0.7 Ac.~~ 17.8 † Ac.	~~7.0~~ Ac.	~~1.9~~ Ac.	19.1 Ac.	6
2-203	George J. Scott, et ux	Pt. of NE¼, Sec. 10, T.17S., R.20E.	159.0 Ac.		26.0 Ac.		94.6 Ac.	38.4 Ac.	6 & 7
2-204	William B. Logan, et ux	Pt. of SE¼ NE¼, Sec. 10, T.17S., R.20E.	1.0 Ac.		1.0 Ac.				7
2-205	Tracy R. Comstock et. ux.	Pt. of Lot 13, BIK "C"; Lots 12, 13, 14 & Pt. of Lots 10, 11, 15, 16, BIK "D"; Lots 9, 10, 11, 12, 13, 14, 15, 16, 17 & Pt. Lots 7, 8, 18, 19 BIK "E" Lots 6, 7, 8, 9, 10, 11, 12 & Pt. Lots 4 & 5 BIK "F" Comstock Addition, Sec. 10, T.17S, R20E	⊙ ~~15.8~~ 5.7 Ac.		⊙ 5.7 Ac.			⊙ ~~10.5~~ Ac.	7
		Pt. of NW¼ SW¼, Sec. 11, T.17S., R.20E.	~~40.0~~ 12.9 Ac.		12.9 Ac.		~~15.9~~ Ac.	~~11.2~~ Ac.	7 & 8
~~2-206~~	~~Alvah & Carman Fenn, H/W~~	~~Pt. of E½ SW¼, Sec. 11, T.17S., R.20E.~~	~~4.58 Ac.~~	~~.02 Ac.~~	DELETED		~~4.38~~ Ac.		8 & 15
2-207	Alvah F. & Barbara H. Fenn, H/W	Pt. of E½ SW¼, Sec. 11, T.17S., R.20E.	51.0 Ac.	~~31.6~~ 31.5 Ac.	~~21.6~~ 21.1 Ac.		8.3 Ac.	~~17.1~~ 17.2 Ac.	8 & 15
2-208	Henry F. Fenn, et ux	Pt. of E½ SW¼, Sec. 11, T.17S., R.20E.	2.8 Ac.	2.8 Ac.	2.5 Ac.				8
~~2-209~~ **	~~Alvah F & Barbara H. Fenn, H/W~~	~~Pt. of NE¼ SW¼, Sec. 11, T.17S., R.20E.~~	~~0.5 Ac.~~	* ~~0.1 Ac.~~	DELETED 4-4-70				8 & 15
2-210	Jeddy B. Fenn, et ux	Pt. of NW¼ SE¼, Sec. 11, T.17S., R.20E.	0.5 Ac.	0.5 Ac.	0.3 Ac.				8 & 15
2-211	Margorie F. Anderson a widow	Pt. of NW¼ SE¼, Sec. 11, T.17S., R.20E.	0.3 Ac.	0.3 Ac.	0.2 Ac.				15
2-212	Max J. Fenn, et ux	Pt. of W½ SE¼, Sec. 11, T.17S., R.20E.	58.9 Ac.	24.3 Ac.	22.3 Ac.		34.6 Ac.		8, 9, & 15
2-213	Carl H. Ingwer, Jr. s/s	Pt. of E½ SE¼, Sec. 11, T.17S., R.20E. Pt. of SW¼, Sec. 12, T.17S., R.20E.	190.2 Ac.	37.3 Ac.	26.3 Ac.	0.7 Ac.	152.2 Ac.		9 & 10
2-214	Fred O. Ramsey, et ux	Pt. of S½ SW¼, Sec. 12, T.17S., R.20E.	9.5 Ac.		6.8 Ac.	0.8 Ac.	1.9 Ac.		9 & 10
2-215	James E. Hamblen as Trustee for Western Growth Capital Corp. et al	Pt. of Lots 1 & 4 thru 14, P.I.C. Benson Acres.	858,536 Sq. Ft.	643,608 Sq. Ft.	624,993 Sq. Ft.	82,580 Sq. Ft.	132,348 Sq. Ft.		10 & 11
		Pt. of SE¼, Sec. 12, T.17S., R.20E.	78.3 Ac.			0.8 Ac.	77.5 Ac.		10 & 11
2-216	James E. Hamblen as Trustee for Western Growth Capital Corp et al	Pt. of Lots 2, 3, & 4, P.I.C. Benson Acres.	203,059 Sq. Ft.		152,260 Sq. Ft.		50,799 Sq. Ft.		10
2-217	Ken W. Pearson, et ux	Pt. of Lot 14, P.I.C. Benson Acres.	32,213 Sq. Ft.		24,163 Sq. Ft.		8,050 Sq. Ft.		11
2-218	Janet S. Ziment a widow	Pt. of W½ SW¼, Sec. 7, T.17S., R.21E.	62.8 Ac.	16.5 Ac.	9.9 Ac.		21.7 Ac.	24.6 Ac.	11
~~2207-A~~	~~Alvah F. & Barbara H. Fenn, H/W~~	~~Pt. E½ SW¼, Sec. 11, T.17S., R.20E.~~	~~4.1 Ac.~~	~~4.1 Ac. 2.0 Ac.~~ Deleted 10-25-72 C.O. 3417					~~8~~

ACQUISITION RECORD

COMMISSION APPROVAL	TYPE & DATE OF INSTRUMENT	RECORDED DATE	RECORDED BOOK	RECORDED PAGE
9-17-71	F.O.C. 12-29-71	1-14-72	747	275-77
4-24-70	W.D. 4-1-70	5-20-70	638	537-8
4-24-70	W.D. 3-18-70	5-20-70	638	534-5
5-22-70	W.D. 4-29-70	6-17-70	643	419-20
4-24-70	W.D. 3-17-70	5-20-70	638	539-40, 541-2
6-26-70	W.D. 6-18-70	7-28-70	649	358-9
5-8-70	W.D. 4-15-70	6-3-70	641	122
7-17-70	W.D. 5-25-70	8-21-70	653	158-9
12-4-70	W.D. 11-4-70	1-5-71	673	337-8
12-4-70	W.D. 11-18-70	12-15-70	670	424
6-15-70	W.D. 4-29-70	7-14-70	647	357
4-24-70	W.D. 3-18-70	5-20-70	638	536
8-10-73	F.O.C. 12-13-73	1-21-74	907	366-70
1-8-70	W.D. 11-1969	2-9-70	624	511-2
	Exmt. 11-19-69	2-9-70	624	513-4
	~~W.D. 3-17-70~~	~~6-15-70~~	~~643~~	~~148-9~~
4-24-70	~~Exc. 3-17-70~~	6-15-70	643	150-1
11-16-73	F.O.C. 3-26-74	4-15-74	924	109-112
11-16-73	F.O.C. 4-23-75	5-7-75	1006	375-77
2-10-70	W.D. 11-25-69	3-16-70	629	306-7
2-21-73	F.O.C. 9-6-73	10-30-74	967	571-73

⊙ - Includes areas of streets & alleys lying within the NE¼ SE¼ Sec. 10. ("Comstock Addition")

* - Indicates acquisition of underlying fee only.

** Deleted 4-4-70 C.O. 2580

* Includes Excess R/W of 1.9 Ac.

⊕ Net Includes 0.5 Acres of Excess R/W.

Click here for I-10 Index

BENSON - STEINS PASS HWY.
BENSON INTERSTATE FREEWAY UNIT II
COCHISE COUNTY

FINALIZED

CHECKED BY R.T.O. For Consultant

HARD COPY

REVISIONS (cont.)

2898	3-19-71	TEK	Added Parcel 2-134-1
2909	4-7-71	TEK	Deleted Parcel 2-134-1
2911	4-7-71	GSG	Added Parcel 2-203-1
3476	12-29-71	P.Todd	Add Parcel 2-213-A
4842	4-29-77	R.M.M.	Finalized

REVISIONS

C.O. No.	DATE	BY	DESCRIPTION
2509	1-22-70	EJT	Added Parcel 2-206-1.
2536	2-9-70	P.Todd	Deleted Parcel 2-206-1.
2607	5-29-70	L.M.F.	Changed Sheet No. to 21.
2722	9-23-70	D.W.B.	Added Par. 2-205-A
2740	10-15-70	"	Revised Par. 2-205-A to 2-205-1
2796	12-17-70	L.G.B.	Comp. acq. record
2841	2-4-71	R.L.R.	Added Retarded onto Parcel 2-205-1

PROJECT NO.	I-10-6(52)306
DRAWING NO.	D-2-T-430
SHEET NO.	3 of 21
DRAWN BY	Gromer
DATE COMP.	9-30-69
SCALE	
Consultant	O'Brien & Speer

OWNERSHIP RECORD / ACQUISITION RECORD

PARCEL NUMBER	OWNER	DESCRIPTION	TOTAL AREA	AREA REQUIRED GROSS INCLUDING EXISTING R/W	AREA REQUIRED NET EXCLUDING EXISTING R/W	EASEMENT AREA	REMAINDER LEFT	REMAINDER RIGHT	SHEET NUMBER	COMMISSION APPROVAL	TYPE & DATE OF INSTRUMENT	RECORDED DATE	RECORDED BOOK	RECORDED PAGE
2-219	Transamerica Title Ins. Co., as Trustee, under Trust No. 26711.	Pt. of E½ SW¼, Sec. 7, T.17S., R.21E.	80.0 Ac.	15.3 Ac.	8.1 Ac.	0.3 Ac.	3.5 Ac.	60.9 Ac.	11 & 12	2-21-73	F.O.C. 9-19-73	9-12-74	956	465-68
2-220	Max Kortchner, et ux, et al	Pt. of SE¼ NE¼ Pt. of N½ SE¼, Sec. 7, T.17S., R.21E	144.5 Ac.	4.8 Ac.	1.1 Ac.			139.7 Ac.	12 & 13	11-3-72	Amended F.O.C. 1-20-74	4-3-74	921	528-30
2-221	State of Arizona (State Land Dept.)	Pt. of N½, Sec. 7, T. 17 S., R. 21 E.	277.4 Ac.	38.5 Ac.	27.1 Ac.				12 & 13	3-20-70	R/W Grant 4-14-70	NOT RECORDED		
L-1	Grazing Lease (G493) To: James A. Kartchner, et al	Pt. of N½, Sec. 7. T.17S., R.21E.	277.4 Ac.						12 & 13					
2-222	State of Arizona (State Land Dept.)	Pt. of NW¼, Sec. 8, T.17S., R.21E.	320.0 Ac.	18.4 Ac.	9.6 Ac.				13 & 14	2-10-70	R/W Grant 3-3-70	NOT RECORDED		
L-1	Grazing Lease (G493) To: James A. Kartchner, et al	N½ N½, SW¼ NW¼, SE¼ NE¼ North of Railroad, Sec. 8, T.17S., R.21E.	280.0 Ac.						13 & 14					
2-223	State of Arizona (State Land Dept.)	Pt. of S½, Sec. 5, T.17S., R.21E.	639.2 Ac.	22.3 Ac.	13.6 Ac.	7.3 Ac.			13, 14, & 15	3-20-70	R/W Grant 4-14-70	NOT RECORDED		
L-1	Grazing Lease (G493) To: James A. Kartchner et al	Pt. of S½, Sec. 5, T.17S., R.21E	639.2 Ac.						13, 14, & 15					
2-198-1	Wayne Malboeuf, et ux, et al	Pt. of S½ SW¼, Sec. 3, T.17S., R.20E.	549 Ac.	342 Sq.ft.	142 Sq.ft.	0.8 Ac.	54.1 Ac.		5 & 6	5-8-70	W.D. 3-31-70 Esmt. 3-31-70	6-4-70 6-4-70	641 641	281-2 279-80
*~~2206-1~~	Alvah F. & Barbara H. Fenn H/W	Pt of E½ SW¼, Sec. 11, T.17S., R.20E.	9.4 Ac.	DELETED			1.9 Ac.	0.1 Ac.	8					
2-205-1	Lassen Foundation	Pt. of NW¼ SW¼, Sec. 11, T.17S., R.20E.	27.1 Ac.		1.0 Ac.		15.9 Ac.	10.2 Ac.	7	12-18-70	W.D. 10-19-70	1-27-71	677	387 & 388
*~~2-134-1~~	Arjay, Inc.	Pt of S² SE⁴ Sec. 4, T.17S., R.20E.	40.7 Ac.	DELETED					16					
2-203-1	A.L. Hawes, et ux.	SW¼, SW¼ Sec. 11, T17S, R20E		WATER USE AGREEMENT ONLY						—	Agreement 5-19-71	8-29-77	1178	548-9
2-213-A	Carl H. Ingwer, Jr. s/s	Pt. of SE¼ SE¼, Sec. 11, T.17S., R.20E.	152.9 Ac.			0.7 Ac.	152.2 Ac.		9	5-11-73	Ease. 3-23-73	6-15-73	864	107-08

*Deleted - C.O. 2536

*Deleted - C.O. 2909

Click here for I-10 Index

BENSON-STEINS PASS HWY.
BENSON INTERSTATE FREEWAY UNIT II
COCHISE COUNTY

CURVE DATA

	① E.B.℄	① Surv&Off.Med℄	① W.B.℄	*② E.B.℄	*② Off. Med℄	*② W.B.℄	*③ E.B.℄	*③ Off.Med℄	*③ W.B.℄	*④ E.B.℄	*④ Off.Med℄	*④ W.B.℄	*⑤ E.B.℄	*⑤ Off.Med℄	*⑤ W.B.℄
P.I.Sta.	1447+35.75	1447+56.37	1447+76.99	1517+89.53	1517+59.26	1517+49.00	1565+12.17	1565+10.38	1585+08.58	1602+74.41	1602+54.30	1602+34.19	1660+12.40	1670+22.65	1660+32.90
Δ	41°47'50"Rt.	41°47'50"Rt.	41°47'50"Rt.	41°08'20"Lt.	41°08'20"Lt.	41°08'20"Lt.	3°48'36"Lt.	3°48'36"Lt.	3°48'36"Lt.	34°00'28"Lt.	34°00'28"Lt.	34°00'28"Lt.	21°29'30"Rt.	21°29'30"Rt.	21°29'30"Rt.
D	1°15'53.65"	1°15'00"	1°14'07.61"	0°39'45.01"	0°40'00"	0°40'15.17"	0°39'45.01"	0°40'00"	0°40'15.17"	0°30'15.21"	0°30'23.87"	0°30'32.62"	1°00'34.25"	1°00'00"	0°59'26.39"
R	4,529.66'	4,583.66'	4637.66'	8648.37'	8594.37'	8540.37'	8,648.37'	8,594.37'	8,540.37'	11,363.16'	11,309.16'	11,255.16'	5,675.58'	5729.58'	5,783.58'
T	1,729.58'	1,750.20'	1,770.82'	3245.45'	3225.18'	3204.92'	287.65'	285.86'	284.06'	3,474.80'	3,458.28'	3,441.76'	1,077.11'	1,087.36'	1,097.61'
L	3304.38'	3343.77'	3383.17'	6209.61'	6170.83'	6132.06'	575.09'	571.50'	567.91'	6,744.36'	6,712.31'	6,680.26'	2,128.91'	2,149.17'	2,169.42'

REVISIONS				PROJECT NO.	I-10-6(52)306
C.O. No.	DATE	BY	DESCRIPTION	DRAWING NO.	D-2-T-430
2578	4-7-70	P.Todd	Drain Ease. cut back From 385 to 170 ft. parallel To N. Robins St. in Parcel No. 2-129	SHEET NO.	4 of 21
2607	5-29-70	L.M.F.	Changed Sheet No. To 21, Added Constr. Projects	DRAWN BY	G.M.B.
2722	9-23-70	A.W.B.	Added New R/W (1970) Pl Sta. 1501+00	DATE COMP.	9-30-69
2743	10-20-70	D.J.M.	Chng. Begin Constr. Proj. I-10-6(66) To Sta 1539+00	SCALE	1" = 1,000'
				CONSULTANT	O'Brien/Speer

CHECKED BY R.T.D. For Consultant

HARD COPY 0863 MI

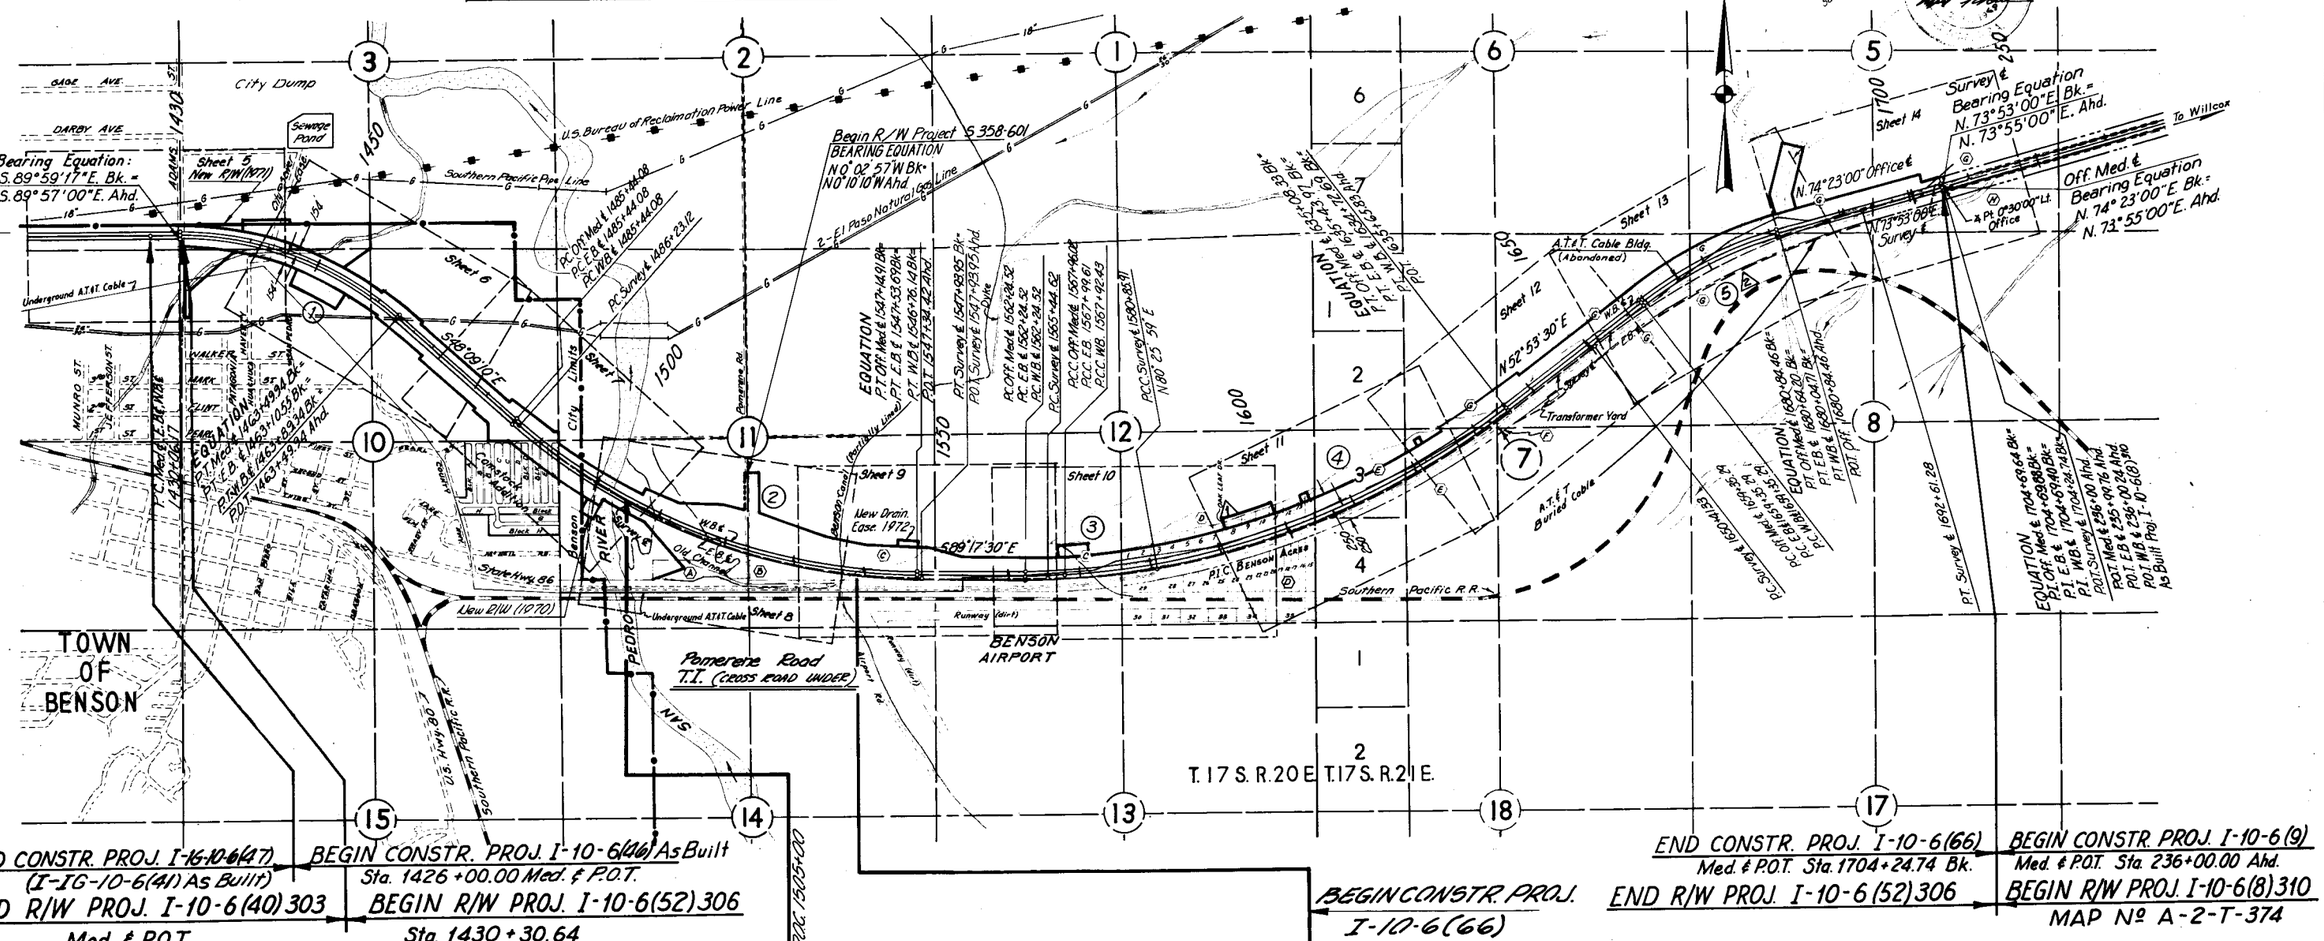

END CONSTR. PROJ. I-16-10-6(47) (I-IG-10-6(41) As Built)
END R/W PROJ. I-10-6(40)303
Med. & P.O.T.
MAP Nº D-2-T-427

BEGIN CONSTR. PROJ. I-10-6(46) As Built
Sta. 1426+00.00 Med. & P.O.T.
BEGIN R/W PROJ. I-10-6(52)306
Sta. 1430+30.64

END CONSTR. PROJ.
I-10-6(46) As Built

END CONSTR. PROJ. I-16-10-6(47)
BEGIN CONSTR. PROJ. AT W.B. Sta. 1306+07.61 ℄ E.B. Sta. 1315+00.00

BEGIN CONSTR. PROJ.
I-10-6(66)

END CONSTR. PROJ. I-10-6(66)
Med. & P.O.T. Sta. 1704+24.74 Bk.
END R/W PROJ. I-10-6(52)306

BEGIN CONSTR. PROJ. I-10-6(9)
Med. & P.O.T. Sta. 236+00.00 Ahd.
BEGIN R/W PROJ. I-10-6(8)310
MAP Nº A-2-T-374

VICINITY MAP
1" = 1000'

Existing Curve Data

		⚠	⚠
TOTAL	Δ	37°50' Lt.	21°00' Rt.
	R+"0"	11,460.04'	11,460.04'
	Ts	3977.1'	2173.8'
	L	7666.7'	4300.0'
MAIN	Δc	37°20' Lt.	20°30' Rt.
	Dc	0°30'	0°30'
	Rc	11,460.0'	11,460.0'
	Lc	7466.7'	4100.0'
SPIRAL	α	1/2	1/2
	Δs	0°15' Lt.	0°15' Rt.
	Ls	100.0'	100.0'
	"0"	0.04'	0.04'
	t	50.0'	50.0'

* Survey ℄ Curve Data

P.I. Sta.	② 1518+48.30	③ 1573+17.34	④ 1608+79.88	⑤ 1671+75.23
Δ	41°08'20"Lt.	10°16'31"Lt.	27°32'29"Lt.	20°59'30"Rt.
D	0°40'00"	0°40'00"	0°30'09.32"	0°29'50.78"
R	8594.37'	8,594.37'	11,400.16'	11,518.16'
T	3225.18'	772.72'	2,793.97'	2,133.90'
L	6170.83'	1541.29'	5,479.92'	4,219.95'

REDUCED SIZE
DO NOT SCALE

FINALIZED

INDEX TO EXISTING R/W

Index	Subdivision	Sec.	Twp.	Rng.	Acq. From	Type	Book	Page	Width	Year	Parcel No.
A	E½ SW¼	11	17S.	20E.	Lorenzo Wo	Easmt.	130	46-47	Varies	1940	F.A.P. 137A
B	W½ SE¼	11	"	"	W.L. Fenn, et ux	Easmt.	130	38-39	180'	"	" "
C	SE¼ SE¼	11	"	"	J.L. Getzwiller, et ux	"	"	40-41	200'	"	" "
C.	S½ SW¼	12	"	"	" " "	"	"	"	"	"	" "
D	SE¼	12	"	"	F.C. Greissinger, et ux	"	"	43-44	"	"	" "
E	SW¼	7	17S.	21E.	John W. Brown, et ux	"	"	36-37	"	"	" "
F	NW cor. SE¼	7	"	"	J.A. McClure, et ux	"	"	41-43	"	"	" "
G	Part of	7&8	"	"	State Land Dept.	Permit	#404	—	200'	1940	" "
G.	Part of S½	5	"	"	" " "	"	"	—	"	"	F.A.P. 137A
H	S½ S½	5	"	"	Carl H. Ingwer, Jr., Lessee	"	#1954	—	" ±	1959	A-137-B

Click here for I-10 Index

BENSON - STEINS PASS HWY.
BENSON INTERSTATE FREEWAY - UNIT II
COCHISE COUNTY

CHECKED BY R.T.O. For Consultant

HARD COPY 6863 MI

REVISIONS				PROJECT NO.	I-10-6-(52)306
NO.	DATE	BY	DESCRIPTION	DRAWING NO.	D-2-T-430
2578	4-7-70	P.Toad	Cut back Drain Ease. from 385' to 370' in Parcel	SHEET NO.	5 of 21
2586	4-15-70	A.W.B.	No 2-199, parallel to N. Adams St. Changed Drain. Ease. on Par. 2-199 & 2-200 to New R/W.	DRAWN BY	Gromer
2607	5-20-70	L.M.F.	Changed Sheet No. to 21. Added Note E. Changed Dist. Tie 1324.26' on Sht. 6.	DATE COMP.	9-30-69
2776	11-23-70	J.A.M.	Revised Access Control Pt 1440+.	SCALE	1" = 100'
2898	3-18-71	T.E.K.	Added Parcel 2-134-1 & New R/W (1971)	Consultant	O'Brien & Speer
2909	4-8-71	T.E.K.	Removed Parcel 2-134-1		
2936	4-28-71	Marin	Removed Artesian Well Sta. 1434+; Zipped		
"	"	"	Rem. Lt. of Par. 2-198 & Noted on Excess R/W		
3493	1-26-73	R.L.R.	Revised Constr. Proj. Nos.		
4002	4-29-77	R.M.M.	Finalized		

FINALIZED

New R/W (1971) To be acquired under Project I-10-6(40)

1/16 Cor. Fd. 1½" Iron Pipe S.E. cor. Ranchitas Los Alamos Unit #2

30'

NOTE: For details of Access Rd. connecting Ocotillo Rd. & City of Benson Disposal Area see Detail Sheet 16 of 21 this Project.

T. 17 S. — R. 20 E.

SW¼ of SW¼

SE¼ of SW¼

0.5 Acres Excess R/W
L-3-11

Rdwy. Easement Rec. 8-8-63 DKT 333, Page 425

Easement & rights incident to Electric Transmission Lines DKT. 33/182 To: U.S.Govt.

Approx. 1/16 Line

154 Lt. Med. ℄ Sta 1430+29.53 L.T.B. S89°39'29"E

154 Lt. Med. ℄ Sta 1430+77.90 L.T.B. S89°03'12"E.

154 Lt. Med. ℄ Sta 1431+94.77 L.T.B. S87°35'33"E

154 Lt. Med. ℄ P.C. 1430+06.17

24.14' 0°0'½" R=4737.66, L=24.14' 1.50° L=120.80' R=4737.44' 170.73' Benson City Limits New R/W

24.23' 50' 330' 400' Med P.O.S.I. 1430+30.64

Med. ℄ P.C. 1430+06.17 24.47' R=4583.66, L=24.47' N0°04'23"W 3340.8' Rdwy Easement Rec 8-8-63 DKT 333, Page 425

Med. ℄ P.O.C. 1430+30.64 Section Line

154 Rt. Med. ℄ Sta 1430+31.83 L.T.B. S89°37'45"E

154' Rt. Med. ℄ P.C. 1430+06.17 24.80' R=4429.66' L=24.80' 1.50° 100' 154' Rt. Med. ℄ 1430+83.58 L.T.B. S88°-58'-34.9"E New R/W L=24.17'

4 3 9 10 S89°42'21"E

DETAIL

Tucson

Willcox

Match Line

2-199

BEARING EQUATION S0°08'13"W Bk. = S0°10'30"W Ahd.

949.53'(R) 50' 50' S0°10'30"W 370' New R/W (1970)

S89°49'30"E 547.63'(R)

296.3' Ingress - Egress to Parcel 2-199

ADAMS STREET

9 10 1/4 Corner Fnd. 2" B.C. set in concrete Set By Deputy Co. Engnr.

CURVE DATA

	E.B. ℄	Med. ℄	W.B. ℄
Δ =	41°47'50" Rt.	41°47'50" Rt.	41°47'50" Rt.
D =	1°15'53.65"	1°15'00"	1°14'07.61"
R =	4529.66'	4583.66'	4637.66'
T =	1729.58'	1750.20'	1770.82'
L =	3304.38'	3343.77'	3383.17'

2-198-1 2-198 2-202 2-199 2-200 2-201 New R/W Med ℄ New R/W

END CONSTR. PROJ. I-IG-10-6(41) (I-IG-10-6(41) As Built)

BEGIN CONSTR. PROJ. I-10-6(46) As Built

BEARING EQUATION S89°59'17"E Bk. = S89°57'00"E Ahd.

Exist. 4 B.W. Fence Remove Within R/W

BEARING EQUATION N0°06'40"W Bk. = N0°04'23"W Ahd. 1324.26'

Sta 1426+00

1430

16' Dirt Rd.

Exist. 3 B.W. Fence

No Access

See Detail Lt.

New 36" Pipe Culv. (Remove)

Corral

Bd Fence

Hydrant

New 5 Wire Fence

154.00' Lt. Med. ℄ Sta 1438+37.39 L.T.B. S79°33'35"E

2-198-1

New R/W (1971)

New Rail Bank Protection

Exist. M.H. - fill with sand

Exist. Wire Mesh Fence (Remove Within R/W)

New Drainage Easement

(R) 650.00' S89°42'21"E

Benson City Limits

1147.80' S89°42'21"E

Benson City Sewers Ease. Rec. DKT 353 Page 47

N00°17'39"E

New 80' Channel L=1785.66' R=4737.66'

Slope Limits

New R/W 1445

W.A. Constr. ℄

Median Survey ℄

E.B. Constr. ℄

Adobe Ruins

Reference (Wire Fence)

New 20" Sleeve for Water New 8" Sleeve for Gas

Hydrant

Wall (rock)

Dirt Tank

Artesian Well w/ pump

2627.84' S89°42'21"E 792.67'

L=474.27' 473.16' 423.16'

West 547.63'(R) 545.11'(C)

154 Rt. Med. ℄ Sta. 1435+22.59 L.T.B. S83°29'41"E

P.O.C. 1430+30.64 Section Line

24' Dirt Road

Hse. Hse. Hse. Hse. Hse.

Existing Curb Cut No Access 1430+06.17

Section Corner Fnd. 3/4" I.P. w/ 2" Br. Cap 2" Below Oiled Surface Set by Deputy Co. Engr.

STREET

P.C. W.B. ℄ Survey E.B. ℄ 1430+06.17

3/4" I.P.

South 349.53'(R)

AT&T Buried Cable U.G.C.M.

2-199

New 80 Chan.

New R/W (1970)

N51°28'58"E 818.10'

See Detail Below

365.85'(R)

9.19'(R)

New 6-10×7 Box Culv. New Outlet Apron New Med. C.B.

Exist. Wire Mesh Fence Remove Within R/W

154' Rt. Med. ℄ Sta. 1438+00 L.T.B. S80°01'38"E

2-200

New R/W

LTB S73°35'56"E

Exist. M.H. - fill with sand

LTB S69°48'39"E

New 5 Wire Fence

Exist. V.C.P. sewer Plug ends with concrete

Benson City Sewers Ease. Rec. DKT 353 Page 48

2-201

Match Line

NW¼ NW¼

NE¼ NW¼

North 950.53'(R) S0°10'30"E 370'(R) South 1417.20'(R)

North 950.53'(R) N0°10'W 368.20'(R) Approx. 1/16 Line

S0°10'E 368.20'(R) South 1417.20'(R) N0°17'39"E(C)

Exist. 5 B.W. Fence

Exist. W.M. E.B. 279.73'(R) 278.48'(C)

475.45'

238.38'(R)

L=292.86'

L=496.97'

L=195.63'

R=4429.66'

New R/W

Slope Limits

New 80' Chan.

New R/W 1445












Approx. 1/16 Line

Match Line

DETAIL

Match Line S89°42'21"E 71.95'

NE Prop. Corner

L=72.46' R=4429.66'

8.47'(R)

North (R) N0°17'39"E(C)

LTB S82°39'27"E

1/4 Cor. Fd. 2" B.C. set in concrete Set by Deputy Co. Engnr.

Note: Remove Existing Fence Within R/W Unless Noted.

END R/W PROJ. I-10-6 (40) 303

BEGIN R/W PROJ. I-10-6(52) 306

R/W MAP Nº D-2-T-427

New R/W and Controlled Access to be Acquired Under R/W Proj. I-10-6(40)

Sta. 1430+30.64

REDUCED SIZE DO NOT SCALE

Click here for I-10 Index

BENSON - STEINS PASS HWY.
BENSON INTERSTATE FREEWAY - UNIT II
COCHISE COUNTY

NO.	DATE	BY	DESCRIPTION
2586	4-16-70	A.W.B.	Changed New Drain on Par. 2-202 to New R/W. Added Excess R/W.
2607	5-29-70	L.M.F.	Changed Sheet No. to 21
2588	9-30-70	DWS	ADDED NEW DYKE RT. STA. 1448.
2796	12-17-70	LGK	Revised gas line - Sta. 1458. Called-out New 30" R.C.P. at Sta. 1473.
"	"	"	
4842	4-29-77	R.M.M.	Finalized

PROJECT NO.	I-10-6-(52)306
DRAWING NO.	D-2-7-430
SHEET NO.	6 of 21
DRAWN BY	Gromer
DATE COMP.	9-30-69
SCALE	1" = 100'
Consultant	O'Brien & Speer

FINALIZED

Par. 2-202 Excess R/W (1.9 Ac.) L-3-7

T. 17 S. R. 20 E.

Benson City Limits

New Drainage Easement

S 89°42'21" E 1147.80'

SE 1/4 of SW 1/4

New 80 Chan

POST 26257 Ahd. Med. P.I.

S 89°57'00" E

154' Lt. Med. ℄ Sta. 1447+57 Ahd.

LTB S 68°03'46" E

Exist. Wire Mesh Fence Remove Within R/W

194.74'

178.56'

New R/W

475.45'

N 89°57'00" W 239.96' (R)

100'

54'

2627.84'

S 89°42'21" E

691.82'

New R/W (1970)

West 1131.75' (R) 1126.54' (C)

154' Lt. Med. ℄ Sta. 1453+50

LTB S 60°39'08" E

L = 612.76' R = 4737.66'

Sect. Line

U.S.C.&G.S. B.M. # U-358

N 82°08'00" E 422.98' (R)

Mon. Cen. Line Sta. 1453+50

Mid. Sec. Line

1/4 Cor. Fd. 2" Br. Cap

Set

N 00°27'00" W 3300.00'

154' Lt. Med. ℄ Sta. 1459+50

LTB S 53°09'07" E

170' Lt. Med. ℄ Sta. 1459+50

L.T.B. S 56°01'23" E

L = 237.41'

L = 982.78'

R = 4753.66' L = 414.77'

NW 1/4 of NE 1/4

℄ Relocated El Paso Natural Gas Line

170' Lt. Med. ℄ Sta. 1463+49.94

170' Lt. Med. ℄ Sta. 1466+50

154' Lt. Med. ℄ Sta. 1466+50

NE 1/4 of NE 1/4

2-203

1445 1450 1455 1460 1465 1470 1475

℄ Relocated El Paso Natural Gas Line Slope Limits

W.B. Const. ℄

Med. Survey ℄

E.B. Const. ℄

Approx. 1/16 line

New 5 Wire Fence

S 48°09'10" E

New R/W

100'

54'

160'

New 40' Channel

Gravel Plant

175' Rt. Med. ℄ Sta. 1463+49.94

214' Rt. Med. ℄ Sta. 1469+50

175' Rt. Med. ℄ Sta. 1469+50

Exist. Conc. Lined Ditch Remove 250' to R/W

New 30" R.G.R.C.P.

Match

New R/W

L = 773.12'

New 6'x4' Box Culv.

L = 366.74'

L = 164.78'

L = 240.40' R = 4408.66'

L.T.B. S 53°24'30" E

154' Rt. Med. ℄ Sta. 1461+00

175' Rt. Med. ℄ Sta. 1461+00

L.T.B. S 51°16'37" E

EQUATION:
Rt. W.B. ℄ 1463+89.34 Bk. =
P.T. Med. ℄ 1463+49.94 Bk. =
P.T. E.B. ℄ 1463+10.55 Bk. =
P.O.T. 1463+49.94 Ahd.

L = 128.25'

L = 292.86'

L.T.B. S 69°40'39" E

R = 4429.66'

154' Rt. Med. ℄ Sta. 1447+50

424' Rt. Med. ℄ Sta. 1447+50

L.T.B. S 68°09'08" E

New 36" Pipe Culv.

R = 4159.66, L = 726.0' NE 1/4 of NW 1/4

New R/W (1970)

East 1068.9' (R)

424' Rt. Med. ℄ Sta. 1455+50

L.T.B. S 58°09'08" E

154' Rt. Med. ℄ Sta. 1455+50

Existing 5' B.W. Fence Remove Within R/W

A T & T Buried Cable

UGCM

Match

N 0°17'56" E

N 0°10'00" W 998.20' (R)

S 0°10'00" E 2627.84' (R)

South 1068.9' (R)

North 1068.9' (R)

Approx. 1/16 Line

1068.9' (R)

NW 1/4 NW 1/4

SW 1/4 of NE 1/4

SE 1/4 of NW 1/4

North 1322.3' (R) North 1967.5' (R)

N 0°10'00" W 1544.75' (R)

125.0' (R)

East 614.87' (R)

North 2628.36' (R)

South 6285'

Note: Remove Existing Fence Within R/W Unless Noted.

10 Mid Section Cor. Fd. 1" I.P. Locally Accepted Cor.

CURVE DATA

	E.B. ℄	Med. Survey ℄	W.B. ℄
Δ =	41°47'50" Rt.	41°47'50" Rt.	41°47'50" Rt.
D =	1°15'53.65"	1°15'00"	1°14'07.61"
R =	4529.66'	4583.66'	4637.66'
T =	1729.58'	1750.20'	1770.82'
L =	3304.38'	3343.77'	3383.17'

REDUCED SIZE DO NOT SCALE

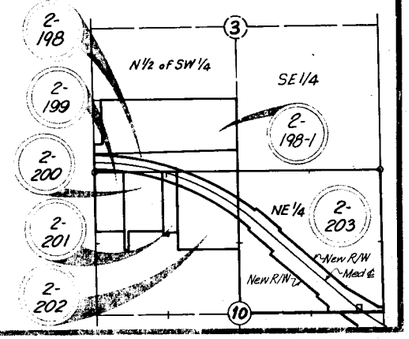

CHECKED BY R.T.O. For Consultant

HARD COPY 6863 MI

Click here for I-10 Index

BENSON - STEINS PASS HWY.
BENSON INTERSTATE FREEWAY UNIT II
COCHISE COUNTY

CHECKED BY: R.T.D. For Consultant

HARD COPY 6863 M1

REVISIONS			
C.O. No	DATE	BY	DESCRIPTION
2607	6-29-70	C.M.F.	Changed Sheet No. to 21.
2722	9-23-70	A.W.B.	Added New R/W (1970) Par. 2-205-A
2505	9-30-70	D.W.S.	REVISED DRAIN. STRUC. PER CONST. PLANS.
2740	10-16-70	A.W.B.	Revised ownership 2-205, added 2-205-1
2756	10-31-70	W.H.T.	Revised Access Control
2776	11-24-70	J.A.M.	Called out Water Line at M 720+65.
2796	12-7-70	L.G.G.	Added utility lines on mid-section line.
"	"	"	Called-out "New 2-54" R.C.M.P. at 1500
"	"	"	Added Yard Ln. Sta. 1483+30.

PROJECT NO.	I-10-6(52)306
DRAWING NO.	D-2-T-430
SHEET NO.	7 of 21
DRAWN BY	Gromer
DATE COMP.	9-30-69
SCALE	1" = 100'
Consultant	O'Brien & Speer

Registered Professional Engineer (Civil) — Certificate Expires — ROBERT T. O'BRIEN — Arizona U.S.A.

Note: Remove Existing Fence Within R/W Unless Noted.

CURVE DATA

	Survey ℄	E.B. ℄	Office Med.℄	W.B. ℄
Δ =	41°08'20"	41°08'20" Lt.	41°08'20" Lt.	41°08'20" Lt.
D =	0°40'00"	0°39'45.01"	0°40'00"	0°40'15.17"
R =	8594.37'	8648.37'	8594.37'	8540.37'
T =	3225.18'	3245.45'	3225.18'	3204.92'
L =	6170.83'	6209.61'	6170.83'	6132.06'

Benson

SW1/4 of NW1/4

Sec. Cor. Fd. 2" Br. Cap.

3 2 10 11

N. 0°28'46" W. 2635.68'

T17S R20E

Survey ℄ R/C. 1486+88.67 N 37°05'20" E

Survey ℄ R/C. 1486+23.12

Survey ℄ P.O.S.T. 1493+62.45

DETAIL

Survey ℄ R/C. 1486+23.12

℄ 713.75'

759.35'

2-203

2-204

2-205

2-205-1

Cultivated Field

SE1/4 of NE1/4

Exist. Conc. Lined Ditch Remove within R/W

Type 1 Double Gate

New Ditch By Others

New 20' Rd. 6" Select Mat'l.

204' Lt. Med. ℄ Sta. 1483+00

154' Lt. Med. ℄ Sta. 1483+00

351°20'25" E

759.61'

New 16'x14' Box Culv. 1 Equipment Pass

1485 P.C. Wall, Off Med. L.B. ℄ 1485+44.08

5 Wire Fence Survey ℄ P.C. 1486+23.12

1475 Line

1480

New 5 Wire Fence

New R/W

Slope Limits

New 20" Sleeve for Water Line

S. 48°09'10" E.

54'

180'

New 40' Channel

Match

New R/W

214' Rt. Med. ℄ Sta. 1480+00

264' Rt. Med. ℄ Sta. 1480+00

275.00'

New 20'x 40' Ford

264' Rt. Med. ℄ Sta. 1482+75

New 20' Bit. Surf. Rd.

Approx. 1/4 Line

Mid-Sect. Line

SW1/4 of NE1/4

2-203

10

ABANDONED TO THE CITY OF BENSON BY RES. 98-07-A-029, REC. 7-30-98, FEE # 98072664

1/4 cor. Fd. 2" Br. Cap.

589°39'10" E 626.56' (R)

See Detail Above

Type 1 Gate

New R/W

1485

1495

W.B. Constr. ℄

Office Med. ℄

℄ Survey ℄

E.B. Constr. ℄

New 5' Sleeve for Gas & 20" Sleeve for Water

New 40' Channel

L = 991.98' R = 8858.37'

L = 495.57'

Cultivated Field

Clifton Ave.

Talmadge Ave.

Block D

Block E

Block G

Block H

Block I

Scott Ave.

COMSTOCK ADDITION

Comstock Street

Tracy St.

N 0°28'00" E 2653.38'

Easement for Gas & Sewer lines to City of Benson DKT. 38 Page 66

Sec. Cor. Fd. 1/2" x 1½" Bar

11 14 10 15

Note: In Blocks D & E, COMSTOCK ADDITION Sewer laterals in place - if any exist - Will not be tied in to the New 10" Sewer Line

River Control Easmt. To: State of Arizona, M5CL 52128T

New 3-Span Conc. Girder Bridge

RIVER

NW1/4 of SW1/4

New R/W

OLD CHANNEL Top of Bank

Approx. 1/4 Line

1505

100'

L = 681.65'

New R/W

Match

154' Rt. Med. ℄ Sta. 1502+00

L.T.B. S 59°11'32" E

500' (R)

West (R)

SAN PEDRO

Approx. 1/4 Line

264' Rt. Med. ℄ Sta. 1502+00

L.T.B. S 59°11'32" E.

464' Rt. Med. ℄ Sta. 1502+00

464' Rt. Med. ℄ Sta. 1500+00

600' (R)

Med. ℄ P.O.B. T. 1493+31.41

Section Line

L.T.B. S 53°24'06" E

Med. P.O.B.T. 1493+62.45

2-New 54" R.C.R.C.P.

L = 1409.33' R = 8440.37'

See Detail Above

New 3-Span Conc. Girder Bridge

New R/W

W.B. Constr. ℄

Office Med. ℄

℄ Survey ℄

E.B. Constr. ℄

New 5' Sleeve for Gas & 20" Sleeve for Water

New 40' Channel

L = 206.14

D = 8858.37'

Cultivated Field

New R/W (1970)

264' Rt. Med. ℄ Sta. 1500+00

L.T.B. S 57°51'32" E.

264' Rt. Med. ℄ Sta. 1495+19.21

L.T.B. S 54°39'13" E

210.19 (R)

L 68°51'32" W

Limits

C.O. No.	DATE	BY	DESCRIPTION
2776	12-7-70	JAS.	Added 2-205-1
2880	4-23-71	R.W.M.	Extended

Click here for I-10 Index

BENSON - STEINS PASS HIGHWAY
BENSON INTERSTATE FREEWAY UNIT II
COCHISE COUNTY

I-10-6(52) 306
D-2-T-430
8 of 21
Gromer
9-30-69
1" = 100'
Consultant: O'Brien & Speer

CURVE DATA

Survey ℄	E.B. Office ℄	Office Med ℄	W.B. Office ℄
Δ = 41°08'20"	41°08'20" Lt.	41°08'20" Lt.	41°08'20" Lt.
D = 0°40'00"	0°39'45.01"	0°40'00"	0°40'15.17"
R = 8594.37'	8648.37'	8594.37'	8540.37'
T = 3225.18'	3245.45'	3225.18'	3204.92'
L = 6170.83'	6209.61'	6170.83'	6132.06'

2509	1-28-70	E.U.T.	Added Parcel 2-206.
2536	2-9-70	P. Todd	Deleted Parcel Bubble No. 2-206-1, Add. Parcel Bubble No. 2-207 Lt. Sta. 15+13.3 + / to Parc. Incr.
2580	4-4-70	P. Todd	Revised Parcels 2-206 & 2-207. Deleted Parcel 2-209. Add. LTB 154' Rt. Med. ℄ Sta. 1508+50.00.
2607	6-29-70	L.M.F.	Changed Sheet No. to 2-206-1 & 4 Left Prints
9417	10-18-71	D.A.M.	Changed Interchange Fencing Per Const. Plan
"	"	"	Deleted Parcel 2-207-A. Deleted & Added Lt. Line
3476	12-29-71	P. Todd	Revised Drain Channel to conform to Const. Plans. Add Lap Lt. Sleeve Sta. 15+21 + Add. New 20' Gr. Rd. in NW Quad. of I-10

Pomerene Road T.I.
Crossroad Under
See Sheet 15 For Continuation Of Pomerene Road

T. 17S. R. 20E.

NW¼ SE¼ · SW¼ SE¼ · NE¼ SW¼ · NW¼ SW¼ · SW¼ SW¼ · SE¼ SW¼

San Pedro River

154' Lt. Med. ℄ Sta. 1506+50
R=8440.37' L=1409.33'
New R/W
Line 1505
(Radial) N27°48'28"E 90.0'(R)
250' Lt. Med. ℄ Sta. 1506+50
S65°08'22"E 485.20'(R)
260' Lt. Med. ℄ Sta. 1511+50
719.52'(R)
New 3 Wire Line Fence Toe Of Slope
Line 1510
New 23'x 103'-2" Chute Spillway
End Fence S88°28'58"E 614.72'(R)
New 4-Wire Fence
480' Lt. Med. ℄ Sta. 1517+50
Deleted C.O. 2580
Buried Cable Min Bell Tel Co.
Center of Section 3/8" Iron Pin
Fd.
Deleted C.O. 2580
Replace 2" Water Line With New 2" Gal. Pipe
S76°59'38"E 303.80'(R)
524.41' Lt. Med. ℄ Sta. 1520+69.20
New Type I Gate
240' Lt. Med. ℄ Sta. 1516+10
New 5 Wire Fence
S64°29'44"E 447.01'
300' Lt. Med. ℄ Sta. 1520+00
Artesian Well To Remain
New 30' Rd. Rt.
Deleted by C.O. No 2536
Ramp 'A' 1515
385.35' S78°54'57"E
West (R) 296' (R)
Off. Med. ℄ Survey ℄
W.B. Office & Constr. ℄
1024'(R)
R=8748.37' L=661.65'
NW¼ SW¼
Exist. Channel Control Ease
Approx. 1/16 Line
154' Rt. Med. ℄ Sta. 1508+50 L.T.B. S.63°31'20"E.
500'(R)
S41°29'48"E 886.53'
New 42" Pipe Culv.
OLD CHANNEL
E.B. Office & Constr. ℄
New 3 Span Cont. C.I.P.R.C. Box Girder Overpass
Ramp 'C'
Slope Limits
2-16" Wells Cap & Abandon
West (R) 1024' (R)
1320'(R) West (R)
Exist. 10" Water Line-Remove Within R/W
New 5 Wire Fence
ABANDONED IPRR 62-140 3/8/67-9
Nov 18 10-23-64
West 88.2' (R)
328'±
New Interstate R/W
525' Rt. Med. ℄ Sta. 1516+25
N78°10'02"E 525.25'(R)
Deleted 10-25-72 C.O. 3417
S89°17'30"E
SE¼ SW¼
South 660.75'(R) N0°44'30"E 415'(R)
Approx. 1/16 Line South 710 Rods (R)
ROAD TO OLD CROSSROAD
SW¼ SW¼
Exist. R/W
END CONSTR. PROJ. I-10-6(46) As Built
Exist. Hwy. 86 Sta. 45+50 ±
To Benson
T&T Underground Cable
U.G.C.M.
Southern Pacific Railroad
Exist. R/W
S89°14'45"E 1320'(R)
S89°44'E 1320'(R)
North 2977.8'(R) From Sec. Line
15.1 Acres Remainder (Include 6.1 Acres R.R. Easement)
FINALIZED
REDUCED SIZE DO NOT SCALE
Exist. Ease. 2.12 Acres covered by Highway Easement Deed Rec. 1-26-40, Dk. 130, Pg 46.
West 1320'(R)
11
14
1/4 Corner Fd. 2" x 2" Stake
N.0°02'51"W 2646.54'
540.70'
Deleted 10-25-72 C.O. 3417

Pomerene Road
5 Wire Fence 518.13' Lt. Med. ℄ Sta. 1522+94.70
North 132'(R)
East 150'(R)
2" Gas Line
East 4 B.W. Fence Remove Within R/W
New 4-10'x4' C.B.C.
S70°56'07"E 1050.45'(R)
New 4 Wire Fence
Approx. 1/16 Line
410' Lt. Med. ℄ Sta. 1534+00
S79°31'36"E 573.09'(R)
New R/W
Slope Limits
New 40' Channel
North Frontage Rd.
Ramp 'B'
New 5 Wire Fence
2" Gas Line To Be Removed Within R/W Med. ℄ P.O.C. 1522+74.41
Survey ℄ P.O.C. 1522+91.87
New Chain Link Fence
1530
Approx. 1/16 Line
Exist. 4 B.W. Fence

Click here for I-10 Index

BENSON - STEINS PASS HWY.
BENSON INTERSTATE FREEWAY UNIT II
COCHISE COUNTY

CHECKED BY JFT.O. for Consultant

HARD COPY 6863 MI

REVISIONS			
C.O. No.	DATE	BY	DESCRIPTION
2578	4-7-70	P.Todd	Add Turnout & New Type I Gate Lt. Sta. 1561+00.
2607	5-29-70	C.M.F.	Changed Sheet No. to 21. Added Constr.
"	"	"	Projects.
2743	20-10-70	D.J.M.	Changed Location of Begin Constr. Proj. I-10-6(66) From P.O.T. 1550+00 To Sta. 1539-00
2801	1-5-71	Marsh	Revised Construction Project Termini.
3117	10-14-71	D.G.M.	Changed Interchange & Fencing for Constr.
"	"	"	Plan. Added T.O.L.P. Sta. 1535+.
3476	12-29-72	P. Todd	Revised New Drain. Channel to conform to Constr. Plans.
"	"	"	Add. New Drain. Ease. 1972 as Parcel No. E-218-A
3493	1-22-73	R.L.M.	Changed Blank Soil Cement Reinforced Ramps
"	"	"	"D" to match C.S.B. Plans. Added Inv. Pipes at
"	"	"	begin. of Sheet.
3785	1-21-74	D.G.M.	Removed 12" & 18" Tra. Lines & Cell Outs N.F.S. 1935+00
4862	4-25-77	R.M.M.	Finalized

PROJECT NO.	I-10-6 (52) 306
DRAWING NO.	D-2-7-430
SHEET NO.	9 of 21
DRAWN BY	Gromer
DATE COMP.	9-30-69
SCALE	1" = 100'
Consultant	O'Brien & Speer

Registered Professional Engineer — Arizona, U.S.A.

T. 17 S. — R. 20 E.

11 — 12 — 1/4 Cor. Fd. 2" B.C. 12" above gnd.

NW 1/4 SE 1/4 — NE 1/4 SE 1/4 — NW 1/4 SW 1/4 — NE 1/4 SW 1/4 — SW 1/4 SE 1/4 — SE 1/4 SW 1/4 — SW 1/4 SW 1/4

CURVE DATA

E.B. Office ℄	Office Med. ℄	W.B. Office ℄	Survey ℄
Δ = 41°08'20" Lt.	Δ = 41°08'20" Lt.	Δ = 41°08'20" Lt.	Δ = 41°08'20" Lt.
D: 0°39'45.01"	D = 0°40'00"	D = 0°40'15.17"	D = 0°40'00"
R = 8,648.37'	R = 8,594.37'	R = 8,540.37'	R = 8,594.37'
T = 3,245.45'	T = 3,225.18'	T = 3,204.92'	T = 3,225.18'
L = 6,209.61'	L = 6,170.83'	L = 6,132.06'	L = 6,170.83'

Note: Remove Existing Fence Within R/W Unless Noted.

Approx. 1/16 line

Existing 5 B.W. Fence (Fence within R/W)

Benson Canal

New Type I Gate

New R/W

New 4-Wire Fence

S 79°31'36" E 573.09'(R)

1535

1540

380' Lt. Med ℄ Sta. 1540+00

2-212

2-213

2-213-A

EQUATION
P.T. Off. Med ℄ 1547+14.91 Bk. =
P.T. E.B. ℄ 1547+53.69 Bk. =
P.T. W.B. ℄ 1546+76.14 Bk. =
P.O.T. 1547+34.42 Ahd.

New Drain. Ease. 1972

P.T. Survey ℄ 1547+93.95 Bk. =
P.O.T. Med ℄ 1547+93.95 Ahd.

S 87°22'25" E

S 87°22'25" E 848.57'(R)

S 2°37'35" W. P.O.T.

380' Lt. Med ℄ Sta. 1549+00

N. 0°05'20" W. 2012.59' 2593.95'

SE 1/4 SE 1/4
390.12' Lt. Med ℄ Sta. 1544+50

New 4.10'x4' Conc. Box Culv.

Slope Limits

New 40' Channel

New Bank Protection

New 5 Wire Fence

SW 1/4 SE 1/4 Ramp "B"

Underground Irrigation Line To Be Removed Within R/W

New 48" R.G.R.C.P.

26' No. Fr. Rd.

W.B. Off. ℄ Constr. ℄

Off. Med ℄

Survey ℄

Exist. R/W Ramp "D"

Match

14' Fr. ℄ Wire Gate Remove

E.B. Off. ℄ Constr. ℄

Survey ℄ P.O.T. 1549+73.48

A.T. & T. Underground Cable

U.G.C.M.

Exist R/W

Exist 48" R.G.R.C.P. To Remain

U.G. Cable Ease. (1 Rod Wide) Book 60, Page 270 Misc.

Airport Rd.

Approx. 1/16 line

Southern Pacific Railroad

Sta. 1539-00 E.B. & W.B. Constr. ℄

End Constr. Proj. I-10-6(67)108 Begin Constr. Proj. at W.B. Sta. 1206+07.61 & E.B. Sta. 1213+00.00

Begin Constr. Proj. I-10-6 (66)

581.36'

5200'

Med. ℄ P.O.T. 1549+72.76

S 89°17'30" E

250' Lt. Med ℄ Sta. 1553+50

S 73°10'42" E 468.40'

397.89' (R)

360.46'

Conc. Ftgs. & Floor (Remove)

Remove Excess Pav't.

M.P. 295

M.P. 296

℄ 26' So. Fr. Rd.

New 5 Wire Fence

R/W Mkr. 154' Rt. Sta. 1559+90.75

Exist. R/W

Match

Approx. 1/16 line

P.C. Off. Med ℄ 1562+24.52
P.C. E.B. 1562+24.52
P.C. W.B. 1562+24.52

New Type I Gate

4 Wire Fence

874.52'(R)

318.15'(R)

1560

1555

1565

P.C. Survey ℄ 1565+44.62

300'(R)

R = 8344.37'
L = 461.65'

417.42'(R)

New R/W

Slope Limits

94'

102'

54'

U.G.C.M.

Signs

Remove

4' Rt. Sta. 1559+90.71

Sec. Cor. Fd. 2" B.C. 3" und/gnd. in Airport Runway

11 — 12 — 14 — 13

2-213 — 2-214 — 2-212 — 2-213A

New R/W — Med. ℄ — Exist. R/W

REDUCED SIZE DO NOT SCALE

FINALIZED

Click here for I-10 Index

BENSON – STEINS PASS HIGHWAY
BENSON INTERSTATE FREEWAY UNIT II
COCHISE COUNTY

CHECKED BY R.T.O. For Consultant

HARD COPY 6863 MI

REVISIONS				PROJECT NO.	I-10-6 (52) 306
C.O. No.	DATE	BY	DESCRIPTION	DRAWING NO.	D-2-T-430
25178	4-7-70	P.Todd	Changed New Type I Gate Lt. Sta. 1565+44 to Type 2 Gate.	SHEET NO.	10 of 21
3607	6-29-70	L.M.F.	Changed Sheet No. to 21.	DRAWN BY	Gromer
12713	10-20-70	D.J.M.	Added 10' Channel South of Old Hwy 86 From Sta. 1576+00± to Sta. 1671+00±, New Dike at 1575+40±	DATE COMP.	9-30-69
				SCALE	1" = 100'
4842	6-29-77	R.M.M.	Finalized	Consultant	O'Brien & Speer

FINALIZED

CURVE DATA

E.B. Office: ℄	Office Med. ℄	W.B. Office. ℄	Survey ℄
Δ = 3°48'36" Lt.	Δ = 3°48'36" Lt.	Δ = 3°48'36" Lt.	Δ = 10°16'31"
D = 0°39'45.01"	D = 0°40'00"	D = 0°40'15.17"	D = 0°40'00"
R = 8648.37'	R = 8594.37'	R = 8540.37'	R = 8,594.37'
T = 287.65'	T = 285.86'	T = 284.06'	T = 772.72'
L = 575.09'	L = 571.50'	L = 567.91'	L = 1,541.29'

CURVE DATA

E.B. Office. ℄	Office Med. ℄	W.B. Office. ℄	Survey ℄
Δ = 34°00'24" Lt.	Δ = 34°00'24" Lt.	Δ = 34°00'24" Lt.	Δ = 27°32'29" Lt.
D = 0°30'15.21"	D = 0°30'23.87"	D = 0°30'32.62"	D = 0°30'09.32"
R = 11,363.16'	R = 11,309.16'	R = 11,255.16'	R = 11,400.16'
T = 3,474.80'	T = 3,458.28'	T = 3441.76'	T = 2,793.97'
L = 6,744.36'	L = 6,712.31'	L = 6680.26'	L = 5,479.92'

T. 17 S. — R. 20 E.

NW ¼ SE ¼ — NE ¼ SW ¼ — SW ¼ SE ¼ — NE ¼ SE ¼ — SE ¼ SW ¼

12 Center of Section Not Found

Approx. Mid Sec. Line — Approx. ½ Line — Approx. ¼ Line

P.C. Survey ℄ 1565+44.62 — P.C.C. Off. Med. ℄ 1567+96.02 — P.C.C. E.B. ℄ 1567+99.61 — P.C.C. W.B. ℄ 1567+92.43 — N 3°06'06" W (Radial)

Survey ℄ P.C.C. 1580+85.91 (N 80° 25' 59" E)

250' Lt. Med. ℄ Sta. 1567+00 — L.T.B. N 87° 32' 18" E

250' Lt. Med. ℄ Sta. 1571+50 — L.T.B. N 85° 06' 18" E

250' Lt. Med. ℄ Sta. 1591+50

New Drainage Easement

New 4 Wire Fence — New 5 Wire Fence — New 2-60" Pipe Culv. — New Type 1 Gate — New Type 2 Gate

N 86° 15' 32" E 432.95' (R) — N 2° 27' 42" W (Radial) — N 14° 53' 42" W (Radial)

R = 8344.37' — L = 461.65' — L = 346.15' — R = 11059.16' — L = 1955.79' — L = 93.23'

P.I.C. BENSON

UG. Cable Ease. (1 Rod Wide) Book 60, Page 294 Misc. (Abandoned Cable)

R = 10,959.30'(R) — R = 11,359.30'(R) — R = 11,559.30'(R) — R = 10909.16' — R = 11059.16'

New Drainage Easement — New R/W — Exist. R/W — New 10' Channel — Remove Excess Pav't

26' No. Fr. Rd. — 26' So. Fr. Rd. — N.B. Office ℄ Constr. ℄ — E.B. Office ℄ Constr. ℄ — Off. Med. ℄ — Survey ℄

Flood Gate — 14' Ft Wire — 4 B.W. Fence — Exist 4 B.W. Fence — Exist. 4 B.N. Fence — New 4 Wire Fence

New 30" Dike — 10'x6' Conc. Culv. & Cattle Pass (Floored) — Remove Exist. Maint. Road for S.P.R.R. Co. — Begin New 4 Wire Fence

Slope Limits — Remove Traveler Houses — Remove Trees — Remove Signs — Remove Conc. Slab — Remove Wood Fence — Remove Wire Fence — Remove Mail Box — Remove Wood Fence — Remove Wire Fence

6" Wall & 4" Pres. Tank — 4 Conc. — Mail Box — Wood Fence — Conc. Slab — Wire Fence — Mail Box

Southern Pacific Railroad — ℄ Track — Match — Match — ℄ Southern Pacific Railroad R/W

See S.P.R.R. Map Note On Prev. Sheet.

Exist. 4 B.W. Fence Remove

Note: Remove Existing Fence Within R/W Unless Noted.

N 89° 54' 31" W (R) — N 89° 54' 31" W — N 89° 54' 31" W 2642.97' (R)

North 104208' (R) — 100.04' (R) — 100'

30	31	32	33	34
400.05' (R)	"	"	"	400.05' (R)
400.00' (R)	"	"	"	400.00' (R)

ACRES — ST. — COLTRANE

13 ¼ Cor. (Also S.W. Cor. P.I.C. Benson Acres) Not Found

To Section Corner

REDUCED SIZE DO NOT SCALE

Click here for I-10 Index

BENSON - STEINS PASS HIGHWAY
BENSON INTERSTATE FREEWAY UNIT II
COCHISE COUNTY

REVISIONS			
C.O. No.	DATE	BY	DESCRIPTION
2807	5-29-70	L.M.F.	Changed Sheet No. to 21.
2743	10-20-70	D.J.M.	Added 10' Channel South of Old Hwy 86 From Sta. 1576+00± to 1671+00±
4842	6-29-77	R.M.M.	Finalized

PROJECT NO.	I-10-6(52)306
DRAWING NO.	D-2-T-430
SHEET NO.	11 of 21
DRAWN BY	Gromer
DATE COMP.	9-30-69
SCALE	1" = 100'
Consultant	O'Brien & Speer

CURVE DATA

E.B. Office ℄	Office Med ℄	W.B. Office ℄	Survey ℄
Δ = 34°00'24" Lt.	Δ = 34°00'24" Lt.	Δ = 34°00'24" Lt.	Δ = 27°32'29" Lt.
D = 0°30'15.21"	D = 0°30'23.87"	D = 0°30'32.62"	D = 0°30'09.32"
R = 11,363.16'	R = 11,309.16'	R = 11,255.16'	R = 11,400.16'
T = 3,474.80'	T = 3,458.28'	T = 3,441.76'	T = 2,793.97'
L = 6,744.36'	L = 6,712.31'	L = 6,680.26'	L = 5,479.92'

T.17S. R.20E. — T.17S. R.21E.

12 — 7 1/4 Cor. Fd. 1½" Open Pipe

NE¼ SE¼ — SE¼ NW¼ — SE¼ SW¼ — NE¼ SW¼ — SE¼ SE¼

Note: Remove Existing Fence Within R/W Unless Noted.

Range Line — N0°29'38"W 5332.26' — 2897.53'(R) — N1°06'00"W (R) 1063.03' (R)

N18°49'39"W (Radial) — N20°36'02"W (Radial) — N21°06'26"W (Radial)

1595 — 1600 — 1605 — 1610 — 1615 — 1620 — 1625

2-215 — 2-217 — 2-218 — 2-219 — 2-221 — 2-221-L-1

LOT 2 — LOT 3 — LOT 4

New Drainage Easement — Exist. 4 B.W. Fence — New 5 Wire Fence — New 4 Wire Fence

400' Lt. Med ℄ Sta. 1599+00 — 250' Lt. Med ℄ Sta. 1599+00 — 250' Lt. Med ℄ Sta. 1602+50 — 250' Lt. Med ℄ Sta. 1621+80

P.I.C. BENSON — L.T.B. N68°16'50"E

R=10909.16' L=723.47' — R=11059.16' L=733.42' — R=10959.30'(R) L=2727.04'(R) L=270.82'(R) L=271.94'(R) L=133.26'(R) L=342.23'(R) — R=10959.16' L=96.91' L=97.79' L=118.17' — R=11059.16' L=1671.37' — R=10959.16' L=96.91' L=97.79' L=312.98'

(Abandoned) U.G. Cable Ease. (1 Rod Wide) Book 60, Page 294 Misc.

New R/W — New R/W — Approx. Lot Line — Approx. Mid-sec. Line — Approx. ¼ ¼ Line — Slope Limits — 26' No. Fr. Rd. — ℄ 26' So. Fr. Rd.

(Abandoned) A.T.&T. Underground Cable — U.G.C.M. — W.B. Off. ℄ Constr. ℄ — Off. Med. ℄ — E.B. Off. ℄ Constr. ℄ — Survey ℄ — Exist. R/W — New 10' Channel — Remove Excess Pav't

℄ Exist. Hwy. 86 — 30' Ord. Survey — R=11,559.30'(R) — POST Sta. 1603+16.49 Section Tie — 97.51' — 106.78'(R) — 231.02'

Exist. 14"ø Gate Rt. Sta. 1619+14 (Sur. ℄) Remove — (Elec. Lighted) (2 Lights)

Exist. R/W — Exist. 4 B.W. Fence Remove — Exist. 4 B.W. Fence Remove — New 4 Wire Fence — Approx. Lot Line — AT&T Buried Cable on R/W Line — New Type 2 Gate

Match — Match

N 80°25'59"E — Survey ℄ P.I. — N 52°53'30"E

T.17S. R.20E. — T.17S. R.21E. — 12 — 7 — 13 — 18 — 13 ACRES — Sec. Cor. (Also S.E. Cor. P.I.C. Benson Acres) Not Found — ¼ Cor. Fd. 1½" O.P. & Stone Pile

SE¼ SE¼ — N 89°54'31"W (R) — N 89°54'31"W (R) — ℄ S.P. RR. R/W — 100' — 100'

FINALIZED

REDUCED SIZE DO NOT SCALE

Approx. ¼ ¼ Line — SE¼ SW¼

CHECKED BY: R.T.O. For Consultant

HARD COPY 6863 MI

Click here for I-10 Index

BENSON - STEINS PASS HIGHWAY
BENSON INTERSTATE FREEWAY UNIT II
COCHISE COUNTY

REVISIONS			
C.O. No	DATE	BY	DESCRIPTION
2607	5-29-70	L.M.F.	Changed Sheet No. to 21
2743	10-20-70	D.J.M.	Added 10' Channel South of Old Hwy 86 From Sta. 1576+00± To 1671+00±.
4862	4-29-71	R.M.M.	Finalized

PROJECT NO.	I-10-6(52)306
DRAWING NO.	D-2-T-430
SHEET NO.	12 of 21
DRAWN BY	Gromer
DATE COMP.	9-30-69
SCALE	1" = 100'
Consultant	O'Brien & Speer

CHECKED BY. R.J.O. For Consultant

HARD COPY 6863 M1

LOT 2

SE¼ NW¼

N 32° 30' 23" W (Radial)

2-219

2-221

2-221-L-1

625 Line

300' Lt. Med. ℄ Sta. 1626+00

250' Lt. Med. ℄ Sta. 1625+00

(Abandoned) U.G. Cable Ease. (1 Rod Wide) Book 60, Page 294 Misc.

1630

New R/W

R = 11009.16'

L = 884.23'

EQUATION
P.I. N. Fr. Rd. ℄ 1634+05.97 Bk.
P.T. Off. Med. ℄ 1635+08.33 Bk.
P.T. E.B. 1635+43.97 Bk.
P.T. W.B. 1634+72.89 Bk.
P.T. Survey ℄ 1635+65.83 Bk.
P.O.T. 1635+65.83 Ahd.

1635

Vertical Clear W. B. 24' E. B. 33'

434.17'

Note: Remove Existing Fence Within R/W Unless Noted.

1640

300' Lt. Med. ℄ Sta. 1640+00

250' Lt. Med. ℄ Sta. 1640+00

New 4 Wire Fence

SW¼ NE¼

1645

1935.29'

Approx. 1/16 Line

1650

NW¼ NE¼

T. 17 S.

R. 21 E.

1655 Line

New R/W

NE¼ NE¼

94'

Fill & Compact

New 10' Channel

26' No. Fr. Rd.

Slope Limits

102'

54'

U.G.C.M. A.T.&T. (Abandoned) Underground Cable

W.B. Office & Constr. ℄

Office Med. ℄

Exist. R/W

N. 52°53'30" E.

E.B. Office & Constr. ℄

Sign 2. Remove

Remove Excess Pav't.

Survey ℄

℄ Exist. Hwy 86

Exist. 38' Bit. Surf.

℄ 26' So. Fr. Rd.

New 10' Channel

10'

Match

Sign

Approx. Sta. 170+00 on Exist. Hwy. 86 ℄

Exist. 4 B.W. Fence Remove

Exist. 4 B.W. Fence Remove

New 4 Wire Fence

A.T.&T. Buried Cable on R/W Line

New 5 Wire Fence

Exist. R/W

Transformer Yard encl. by Chain-link Fence (4 Lge & Small Transformers)

Exist Chain Link Fence To Remain

A.T.&T. Buried Cable

New 14' Gate Type 2

Exist. 4 B.W. Fence Remove

New 4 Wire Fence

Match

NE¼ SW¼

Approx. Mid-sec. Line

NW¼ SE¼

Approx. 1/16 Line

P.C. Survey ℄ 1650+41.33

SE¼ NE¼

R/W Lease #4103 to Sulphur Springs Valley Electric Coop. For 69 KV. Power Transmission Ease.

2-219

2-220

2-221

2-221-L-1

1 2 3 4

New R/W

Exist R/W

Med ℄

REDUCED SIZE DO NOT SCALE

FINALIZED

Click here for I-10 Index

BENSON - STEINS PASS HIGHWAY
BENSON INTERSTATE FREEWAY UNIT II
COCHISE COUNTY

REVISIONS			
C.O. No.	DATE	BY	DESCRIPTION
2607	5-20-70	L.M.F.	Changed Sheet No. to 21
2793	10-20-70	D.J.M.	Added 10' Channel South of Old Hwy 86 From Sta. 1576+00± To Sta 1671+00±
2841	2-4-70	R.L.R.	Added Rdwy Clear of Bridges
4862	4-5-77	R.M.M.	Finalized

PROJECT NO.	I-10-6(52) 306
DRAWING NO.	D-2-T-430
SHEET NO.	13 of 21
DRAWN BY	Gromer
DATE COMP.	9-30-69
SCALE	1" = 100'
Consultant	O'Brien & Speer

HARD COPY 6863 M1 CHECKED BY R.T.D. For Consultant

Note: Remove Existing Fence Within R/W Unless Noted.

SE¼ SE¼ | SW¼ SW¼ | NE¼ NE¼ | SE¼ NE¼ | SW¼ NW¼ | NW¼ NW¼ | SE¼ SW¼

T. 17 S. R. 21 E.

Sec. 6 | Sec. 7 | Sec. 8

Approx. Section Line

Sec. Cor. Fd. Mk'd. Stone

North (Assumed) 233.32'

519.67'

L.T.B. N61°49'57"E

R = 5979.58'

L = 933.10'

L = 700.22'

New Bank Protection

New 4 Wire Fence

New 5 Wire Fence

New 4 Unit Cattle Guard With Gate

N89°57'23"E(C) 635.21

L.T.B. N68°32'31"E

L = 609.63'

New R/W

1935.29'

Line

1655

1660

1665

1670

1675

1680

1685

New 10' Channel

26' No. Fr. Rd.

Slope Limits

No Access

End New 4 B.W. Fence Continue New 5 B.W. Fence

815.57'

250

65.54'

(Abandoned) AT&T Buried Cable

Med. & POT. 1682+61.53

Approx. Section Line

W.B. Off. & Constr. ℄

75°05'20"

N52°53'30"E

Off. Med. ℄

(Abandoned) A.T.&T. Underground Cable

N52°53'30"E Survey ℄ P.I.

N73°53'00"E

E.B. Off. & Constr. ℄

A.T.&T. Building 10'×12' Brick

94'

102'

54'

100'

40'

U.G.C.M.

Survey ℄

Exist. R/W

14' Ft. & Wire Gate

Aband. Cattle Guard

Remove Excess Pavement

Exist. Hwy 86

M.P. 297

38' B.T. Surf.

New 10' Channel

℄ 26' So. Fr. Rd.

Exist. R/W

U.G. Cable Ease. (1 Rod Wide) Book 60, Page 294 Misc. (Abandoned)

New Type I Gate

Exist. 24" C.M.P. Remove

New 5 Wire Fence

Exist. 4 B.W. Fence Remove

New 4 Wire Fence

A.T.&T. Buried Cable

2-New 3 Span Cont. C.I.P. R.C. Tee Girder Bridges 42' Clear Roadways

Exist. 4 B.W. Fence Remove

Match

Approx. Section Line

Approx. 1/16 Line

P.C. Office Med. ℄ 1659+35.29
P.C. E.B. ℄ 1659+35.29
P.C. W.B. ℄ 1659+35.29

SE¼ NE¼

SW¼ NW¼

NW¼ NW¼

NE¼ NW¼

SOUTHERN PACIFIC RAILROAD

100'

100'

100'

2-220

2-221

2-221-LI

2-222

2-222-LI

2-223

2-223-LI

To San Pedro Ranch

New Drainage Easement See Sheet 15 For Detail

N14°23'00"E 750.00'

N15°37'00"W 300.00'

280' U.L. Mark & Sta 1681+50

(Junked Car Bodies At Edge of Bank) Adams Peak Wash

300.00'

N74°23'00"E 300.00'

842.83' N14°23'00"E

219.82' N15°37'00"W

1750.00'

New Rail Bank Protection

Exist. R/W

Exist. Type I Gate To Remain

Exist. 5-25' span Bridge
Exist. Rip-rap (B.P.) East Bank
To Remain
34' Clear Rdwy.

End New 4 B.W. Fence
Start New 5 B.W. Fence

Office ℄ N. 74°23'00"E

U.G.C.M.

EQUATION
P.T. Office Med. ℄ 1680+84.68 Bk. =
P.T. E.B. 1680+64.20 Bk. =
P.T. W.B. 1681+04.71 Bk. =
P.O.T. Office 1680+84.68 Ahd.

FINALIZED

REDUCED SIZE DO NOT SCALE

CURVE DATA

E.B. Office ℄	Office Med. ℄	W.B. Office ℄	Survey ℄
Δ = 21°29'30" Rt.	Δ = 21°29'30" Rt.	Δ = 21°29'30" Rt.	Δ = 20°59'30" Rt.
D = 1°00'34.25"	D = 1°00'00"	D = 0°59'26.39"	D = 0°29'50.78"
R = 5,675.58'	R = 5,729.58'	R = 5,783.58'	R = 11,518.16'
T = 1,077.11'	T = 1,087.36'	T = 1,097.61'	T = 2,133.90'
L = 2,128.91'	L = 2,149.17'	L = 2,169.42'	L = 4,219.95'

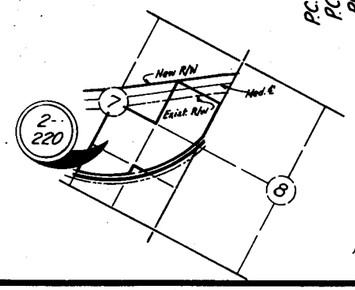

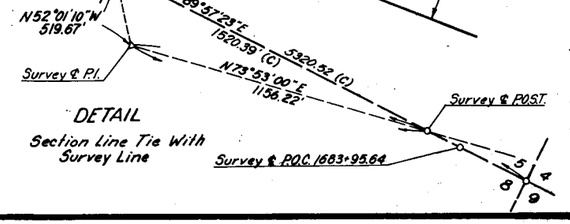

DETAIL
Section Line Tie With Survey Line

Click here for I-10 Index

BENSON - STEINS PASS HIGHWAY
BENSON INTERSTATE FREEWAY UNIT II
COCHISE COUNTY

REVISIONS			
C.O. No.	DATE	BY	DESCRIPTION
2607	5-29-70	L.M.F.	Changed Sheet No. to 21. Revised Const. Limits & Number
4882	4-29-71	R.M.M.	Finalized

PROJECT NO.	I-10-6(52)306
DRAWING NO.	D-2-T-430
SHEET NO.	14 of 21
DRAWN BY	Gramer
DATE COMP.	9-30-69
SCALE	1" = 100'
Consultant	O'Brien & Speer

CHECKED BY R.I.O. For Consultant

HARD COPY 6863 M1

Junked Car Bodies
Adams Peak Wash
842.83'
N 14°23'00" E
New Drainage Easement
See Sheet 15 For Detail
SE 1/4 SW 1/4
Approx. Mid Section Line
T. 17 S.
R. 21 E.
NW 1/4 SE 1/4
Approx. 1/16 Line
NE 1/4 SE 1/4
2-223
2-223-L-1
1685
1690
1695
1700
N 15°37'00" W
219.62'
Line
New R/W
New Rail Bank Protection
N 74°23'00" E 1750.00'
New 4 Wire Fence
150' Lt. Med. ℄ Sta. 1702+00
250' Lt. Med. ℄ Sta. 1702+00
EQUATION
P.I. Office Med ℄ 1704+69.64 Bk. (± 0°30'00" Lt.)
P.I. E.B. ℄ 1704+69.80 Bk. (± 0°30'00" Lt.)
P.I. W.B. ℄ 1704+69.40 Bk. (± 0°30'00" Lt.)
P.O.T. Survey ℄ 1704+24.74 Bk=
P.O.T. Med. ℄ 236+00 Ahd.
P.O.T. E.B. ℄ 235+99.76
P.O.T. W.B. ℄ 236+00.24
As Built Proj I-10-6(8)310
N 74°23'00" E 268.99'
N 16°07'00" W 109'
New R/W Acquired Under R/W Project I-10-6(8)310
New 20' Channel
(Apandoned) A.T. & T. Underground Cable
U.G. Cable Easе. (1 Rod Wide) Book 60, Page 294 Misc. (Abandoned)
Slope Limits
W.B. ℄
Office ℄ N. 74°23'00" E. ℄
Survey ℄ N. 73°53'00" E. ℄
E.B. ℄
Exist. R/W
Exist. Hwy 86
To BENSON
To WILLCOX
L.E. Williams Survey ℄ - 1955
N 73°55'00" E
Exist. 4 B.W. Fence Remove to Sta. 1704+70
New 5 Wire Fence
A.T. & T. Buried Cable
BEARING EQUATION
Office Med ℄ N 74°23'00" E Bk. ℄
Survey ℄ N 73°53'00" E Bk. ℄
Med. ℄ N 73°55'00" E Ahd.
Med. ℄ Sta. 1704+69.64 Bk. - Sta. 236+00 Ahd.
Approx. 1/16 Line
Match
NE 1/4 NW 1/4
2-222
2-222-L-1
P.T. Survey ℄ 1692+61.28
1/4 Corner Not Found
SW 1/4 SE 1/4
2-223
2-223-L-1
SE 1/4 SE 1/4
NW 1/4 NE 1/4

Note: Remove Existing Fence Within R/W Unless Noted.

CURVE DATA
Survey Med. ℄

Δ = 20°59'30" Rt.
D = 0°29'50.78"
R = 11,518.16'
T = 2,133.90'
L = 4,219.95

REDUCED SIZE DO NOT SCALE

FINALIZED

END CONSTR. PROJ. I-10-6(66) | BEGIN CONSTR. PROJ. I-10-6(9)

END R/W PROJ. I-10-6(52)306 | BEGIN R/W PROJ. I-10-6(8)
R/W MAP # A-2-T-374

BENSON - STEINS PASS HIGHWAY
BENSON INTERSTATE FREEWAY UNIT II
COCHISE COUNTY

Click here for I-10 Index

REVISIONS				PROJECT NO.	I-10-8(52) 306
C.O. No.	DATE	BY	DESCRIPTION	DRAWING NO.	D-2-T-430
2580	4-4-70	Roth	Revised Parcels E-206 & E-207. Deleted Parcel E-209.	SHEET NO.	15 of 21
2607	6-29-70	L.M.F.	Changed Sheet No. to 21.	DRAWN BY	Gromer
2901	1-4-71	Marsh	Added Gas & Water Line.	DATE COMP.	9-30-69
3477	10-18-72	D.G.M.	Changed Interchange Per Consth. Plans.	SCALE	1" = 100'
3795	1-21-74	D.G.M.	Removed Water Line. Added 24" C.M.P. C.I.P. & R.C.B.	Consultant	O'Brien & Speer
4842	6-29-77	R.M.M.	Finalized		

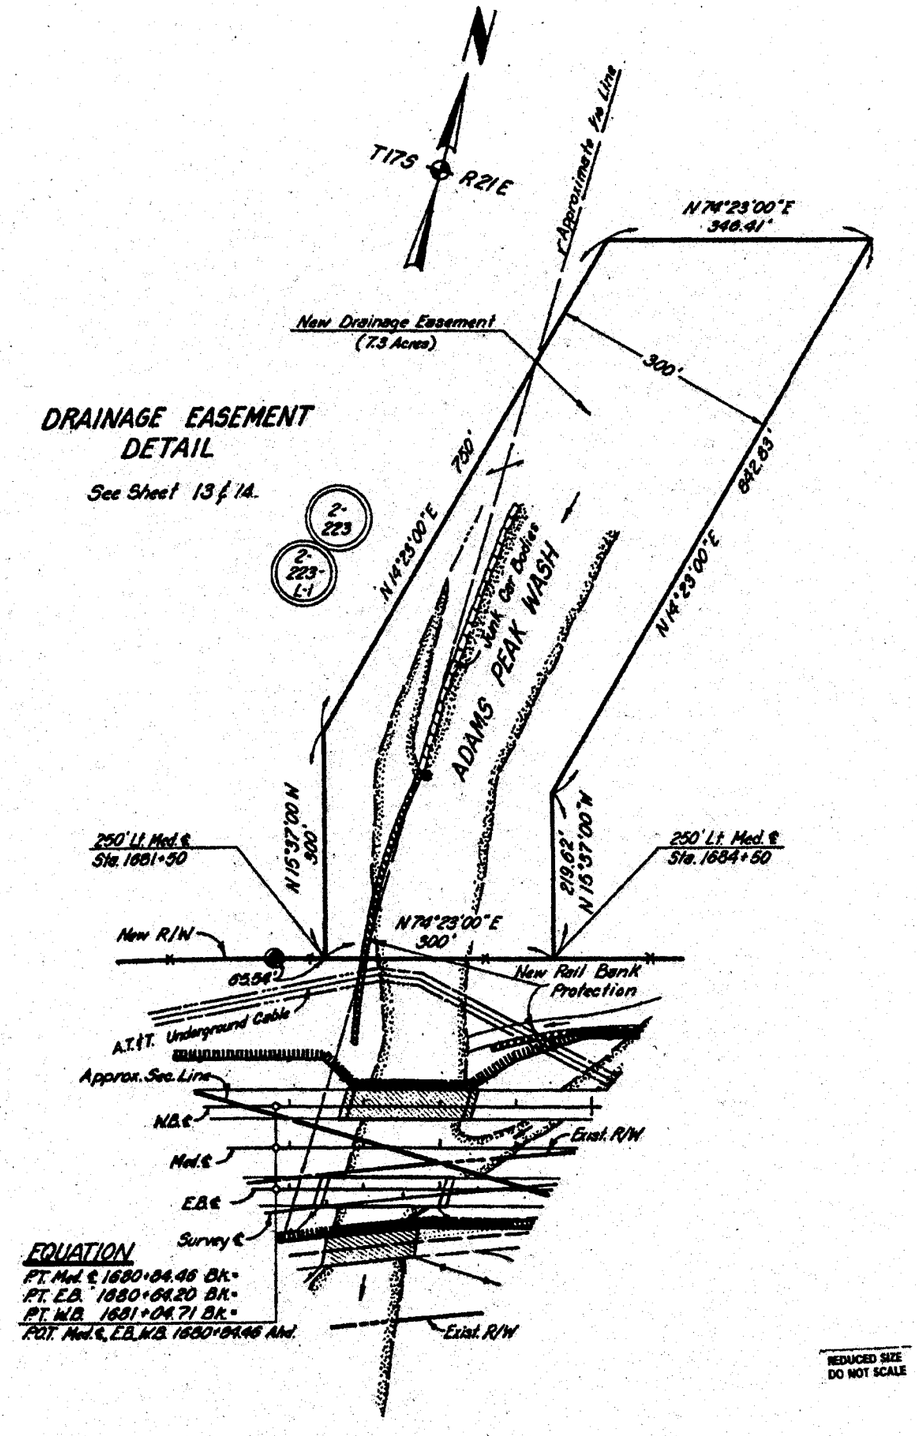

REDUCED SIZE
DO NOT SCALE

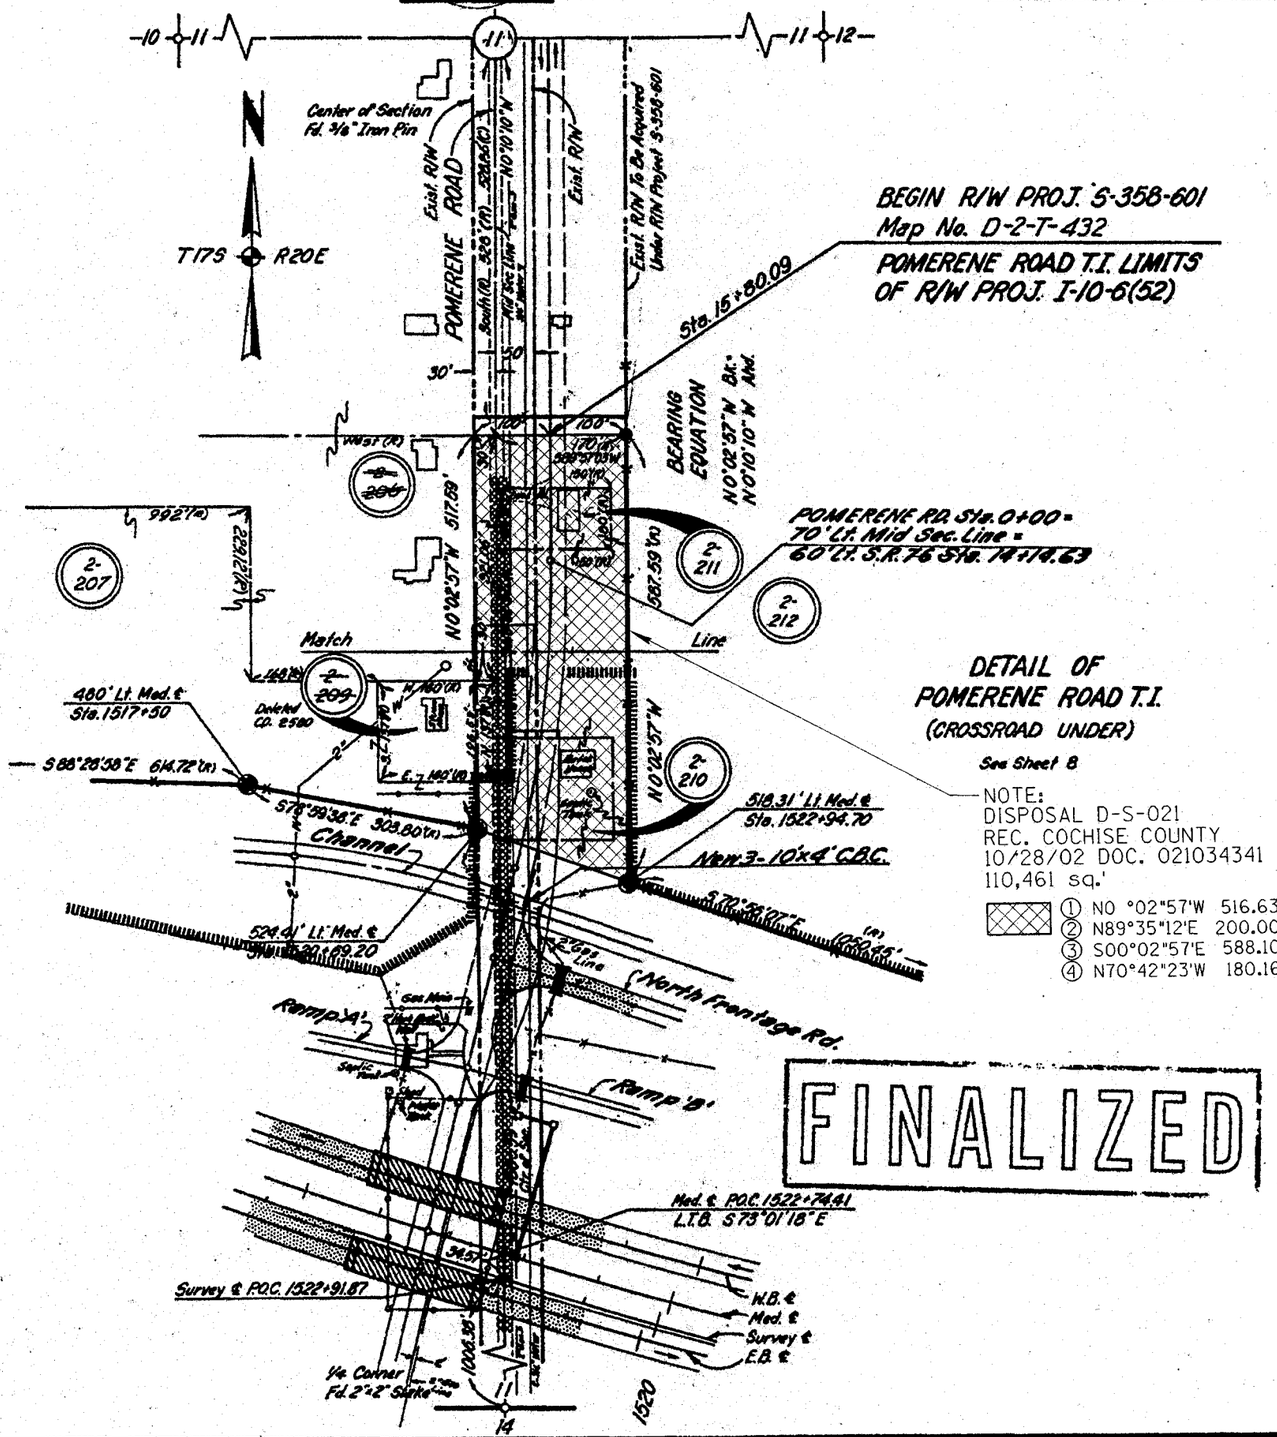

DETAIL OF POMERENE ROAD T.I.
(CROSSROAD UNDER)
See Sheet 8

FINALIZED

Click here for I-10 Index

BENSON-STEINS PASS HWY.
BENSON INTERSTATE FREEWAY UNIT II
COCHISE COUNTY

REVISIONS				PROJECT NO.	I-10-6(52)306
C.O. No.	DATE	BY	DESCRIPTION	DRAWING NO.	D-2-T-490
2907	5-24-70	L.M.F.	Added This Detail Sheet.	SHEET NO.	16 of 21
2901	1-5-71	Marsh	Added Construction Project Termini.	DRAWN BY	L.M.F.
2998	3-18-71	TEK	Added Parcel 2-134-1	DATE COMP.	9-30-69
2909	4-7-71	TEK	Deleted Parcel 2-134-1, Rev'd New R/W 1971	SCALE	1"=200'
4842	4-29-77	R.M.M.	Finalized		

FINALIZED

CHECKED BY:

HARD COPY: 6569 M11

BEGIN CONSTR. PROJ.
I-10-6(46) Unit II

END CONSTR. PROJ.
I-10-6(46) Unit II

Found 1/4 Cor. 3" Iron Pipe

GAGE AVE.

RANCHITOS LOS ALAMOS UNIT NO. 2

OCOTILLO ST. STEVEN ST. SONORA ST.

DARBY AVE.

2639.30' S89°56'30"W

Approx. 1/16 Line

2640.00'

Found 1/16 Cor. 1/2" Iron Pipe

DELETED

NOTE: Area to be acquired under Project I-10-6(40)

T.17S. R.20E.

Exist. R/W

100' Rt. Cr. Rd. Sta. 8+00

100' Lt. Cr. Rd. Sta. 8+00

Dedicated for Public Roadway

Exist. 20' Dirt Road

New 6 Unit Cattle Guard with Gate

SW1/4 SE1/4

SE1/4 SE1/4

Dkt. 683 Pg. 3

New R/W (1971)

Exist. 16' Dirt Road

154' Lt. Median ℄ Sta. 1414+50

154' Lt. Median ℄ Sta. 1430+30.31

SE1/4 SW1/4

100' Rt. Cr. Rd. Sta. 12+50

100' Lt. Cr. Rd. Sta. 12+25

N00°08'47"W 2650.00'

S00°08'47"E 2640.00'

U.S.B.R. Easement

967.33'

New R/W

N78°54'19"E 1164.17'

Ramp "C"

Ramp "D"

S82°30'41"E 1580.31'

W.B. Constr. ℄

Survey ℄ Median ℄

E.B. Constr. ℄

S89°59'17"E

Ramp "B"

Sec. Line

Ramp "A"

New R/W

2640.13'

S89°58'14"E

Found Sec. Corner 3/4" Iron Pipe with 2" Brass Cap.

Found 1/4 Corner 2" Brass Cap Set in Concrete

Approx. 1/16 Line

Found 1/4 Corner 3/4" I.P. with 2" Brass Cap.

20 Ocotillo Rd. T.I. Cross Road Under

N.E. 20 CO.

P.I. 1400+92.35

NE1/4 NW1/4

NW1/4 NE1/4

NE1/4 NE1/4

Approx. Mid-Sec. Line

CURVE DATA

	E.B. ℄	Med. ℄	W.B. ℄
Δ	41°47'50" Rt.	41°47'50" Rt.	41°47'50" Rt.
D	1°15'54"	1°19'00"	1°14'08"
R	4529.66'	4583.66'	4637.66'
T	1728.58'	1750.20'	1770.82'
L	3304.38'	3343.77'	3383.17'

P.O.C. 1430+80.64

DETAIL SHEET

END R/W PROJ. I-10-6(40)

BEGIN R/W PROJ. I-10-6(52)

REDUCED SIZE DO NOT SCALE

BRUNING 44-912