BENSON – STEINS PASS HWY.
SAN SIMON WEIGH & INSPECTION STATION
COCHISE COUNTY

Click here for I-10 Index

REVISIONS					
C.O. No.	DATE	BY	DESCRIPTION	PROJECT NO.	I-10-G-887
5884	9-15-81	R.L.R.	Added exist N. Frt. Rd. & new access control & lt. etc. C.E.S. (87)	DRAWING NO.	D-2-T-459
"	"	"		SHEET NO.	1 of 1
5989	4-8-82	R.C.O.	Rev. New R/W; Add Exist House	DRAWN BY	Rene
6029	6-23-82	R.L.R.	Added Gate & Grader Rd. Fence on new R/W. Changed descript. B/d (87)	DATE COMP.	8-31-81
"	"	"		SCALE	1" = 100'
6118	1-6-83	R.C.O.	Rev. Owner Name Per 2-628		

OWNERSHIP RECORD										ACQUISITION RECORD				
PARCEL NUMBER	OWNER	DESCRIPTION	TOTAL AREA	AREA GROSS INCLUDING EXISTING R/W	REQUIRED - NET EXCLUDING EXISTING R/W	EASEMENT AREA	REMAINDER LEFT	REMAINDER RIGHT	SHEET NUMBER	BOARD APPROVAL	TYPE & DATE OF INSTRUMENTS	RECORDED DATE	RECORDED BOOK	RECORDED PAGE
2-628	Johnnie Dunagan	Pt. NW4 SE4 Sec. 33, T.13S. R.31E.	25.50Ac.		~~0.55 Ac.~~ 0.78 Ac.		~~24.95 Ac.~~ 24.72 Ac.		1					

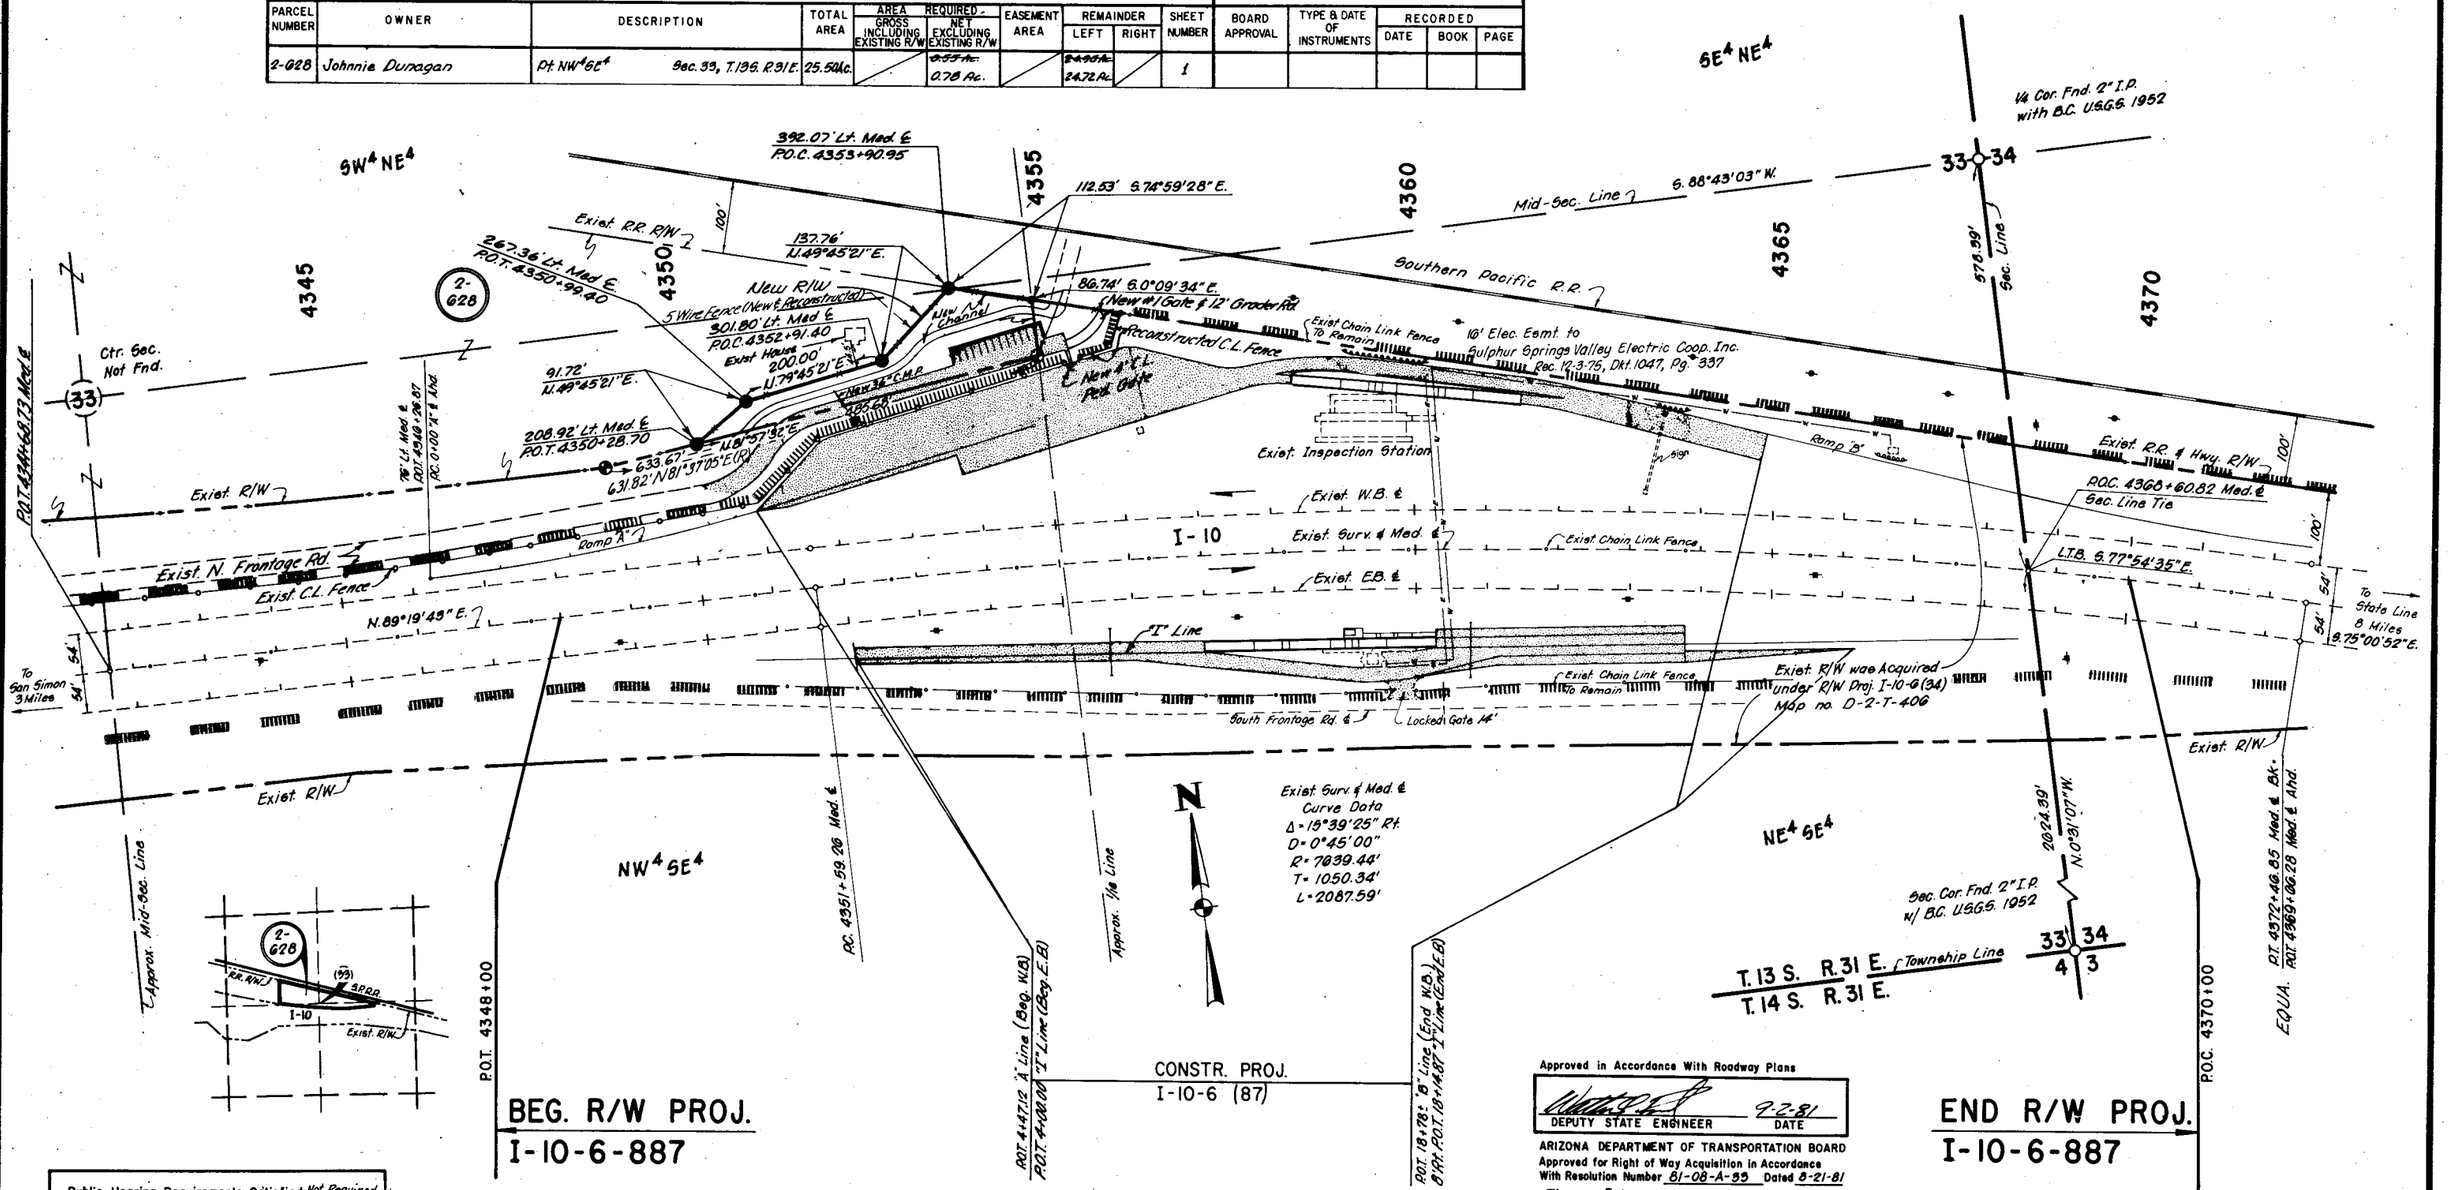

Public Hearing Requirements Satisfied *Not Required*
Environmental Impact Statement Requirements Satisfied 3-31-80.

REDUCED SIZE DO NOT SCALE

Approved in Accordance With Roadway Plans

DEPUTY STATE ENGINEER — DATE 9-2-81

ARIZONA DEPARTMENT OF TRANSPORTATION BOARD
Approved for Right of Way Acquisition in Accordance With Resolution Number 81-08-A-55 Dated 8-21-81
Thomas R. Lammers State Engineer

CHIEF DEPUTY STATE ENGINEER — DATE 9/3/81

Special Surv. dated 8-18-81
HARD COPY 8002 M1
CHECKED BY