OWNERSHIP RECORD										ACQUISITION RECORD				
PARCEL NUMBER	OWNER	DESCRIPTION	TOTAL AREA	AREA REQUIRED: GROSS INCLUDING EXISTING R/W	AREA REQUIRED: NET EXCLUDING EXISTING R/W	EASEMENT AREA	REMAINDER: LEFT	REMAINDER: RIGHT	SHEET NO.	CHIEF R/W AGENT APPROVAL	INSTRUMENT: TYPE	INSTRUMENT: DATE	RECORDED: DATE	RECORDED: DOCUMENT
~~10-874~~	~~DISQUE D. DEANE, et al~~	~~PT. LOT 1, BLK. 3, BROADWAY OF AMERICA ADDITION~~	~~4722Φ~~	DELETED	7-26-90			~~4491Φ~~	~~1~~					
10-875	CABOT SEDGWICK, et al	PT. NW4 NE4, SEC. 31, T.14 S. R. 14 E.	34,310Φ		179Φ		34,131Φ		1					

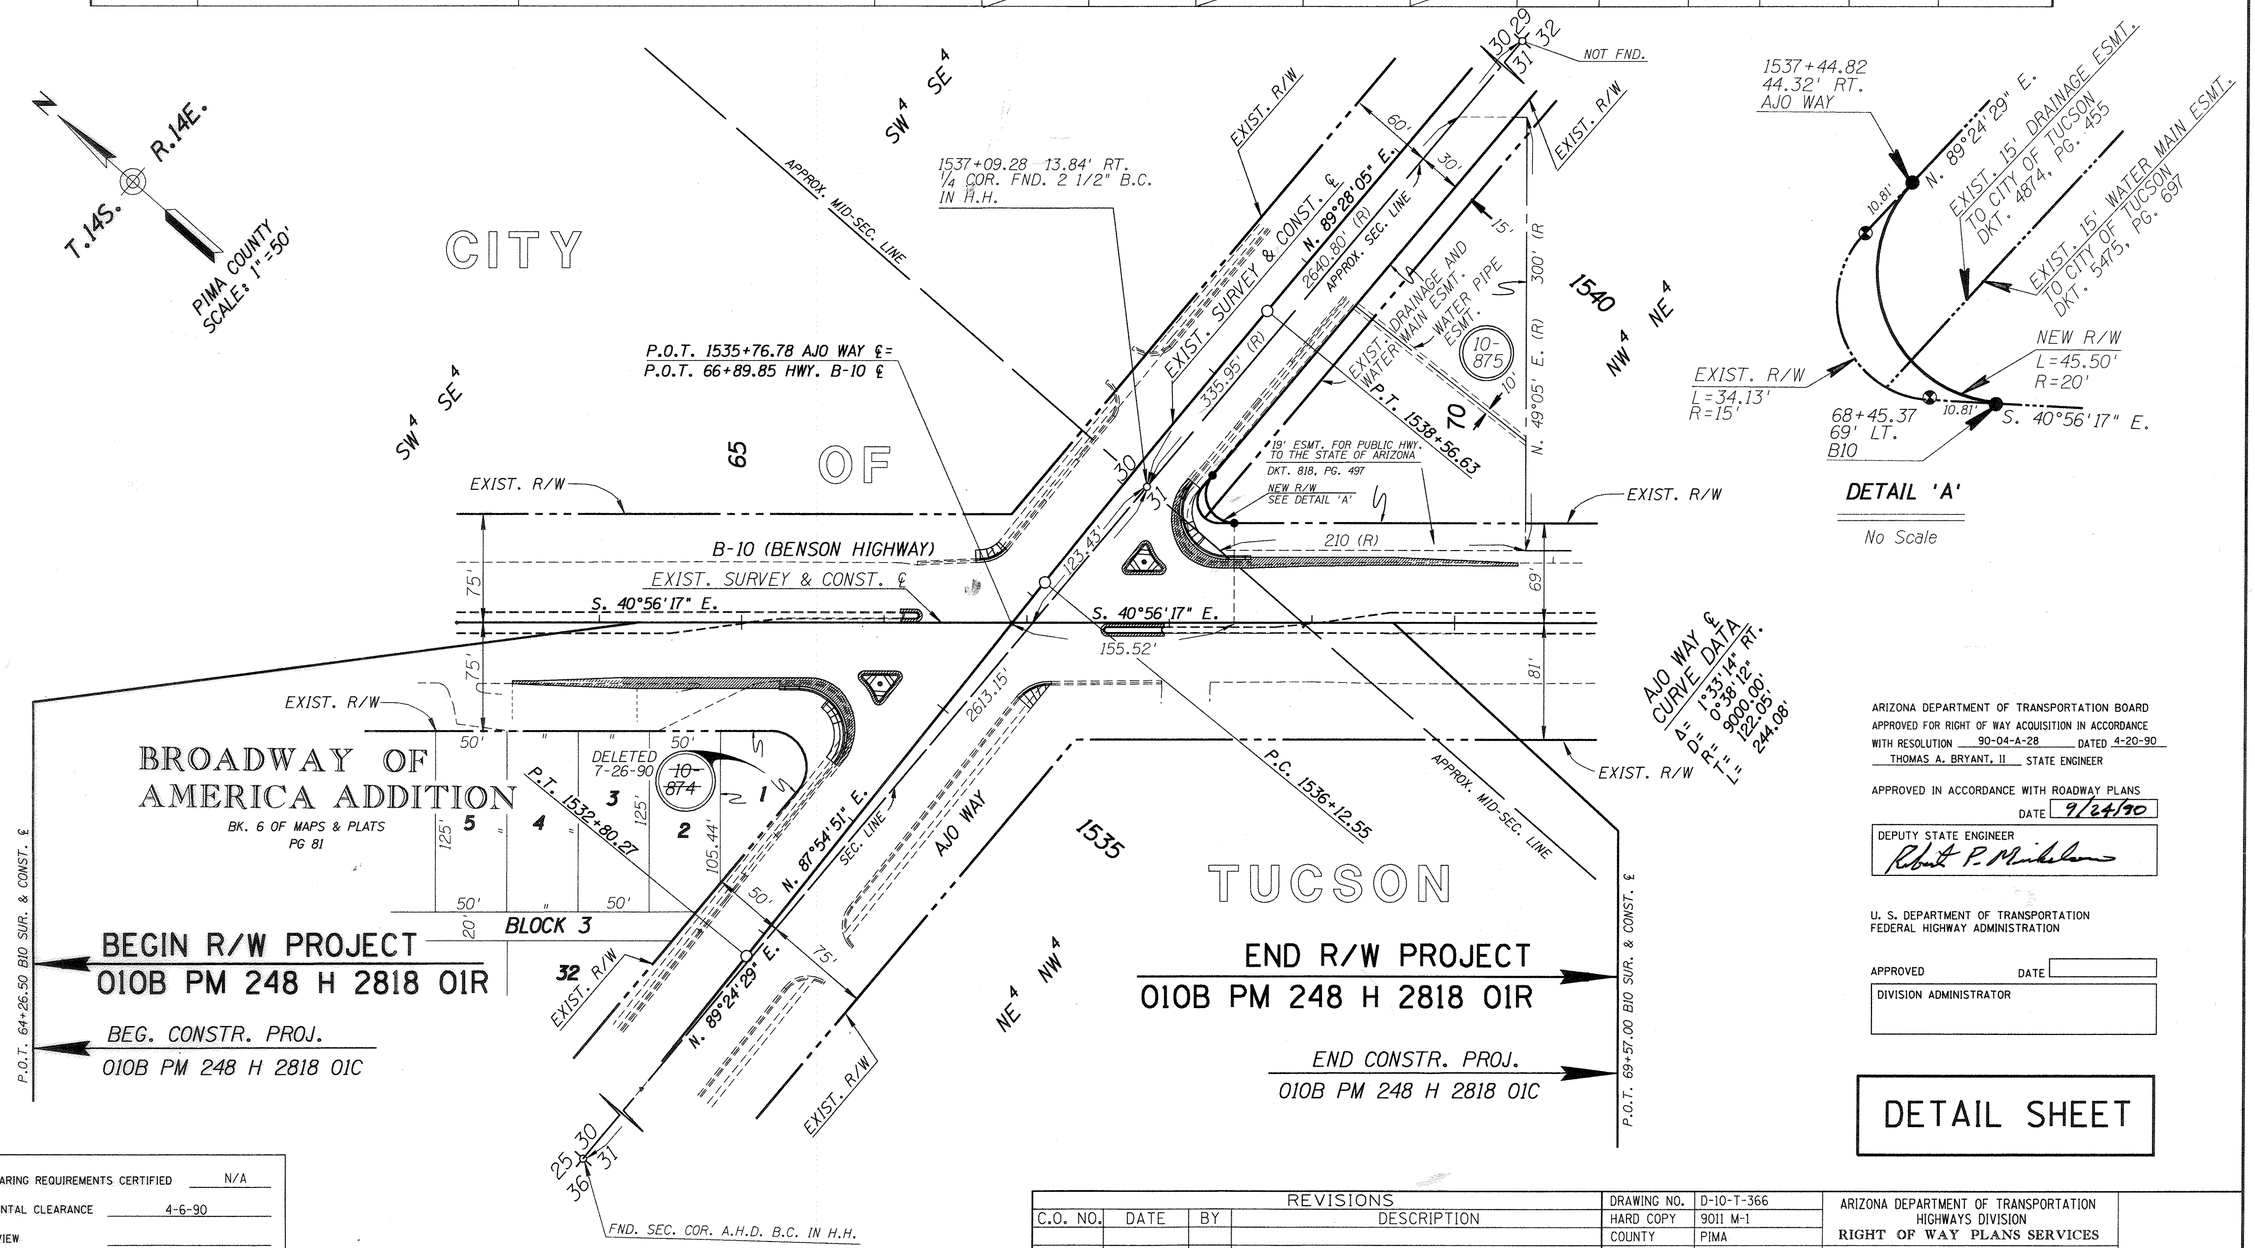

ARIZONA DEPARTMENT OF TRANSPORTATION BOARD
APPROVED FOR RIGHT OF WAY ACQUISITION IN ACCORDANCE WITH RESOLUTION 90-04-A-28 DATED 4-20-90
THOMAS A. BRYANT, II STATE ENGINEER

APPROVED IN ACCORDANCE WITH ROADWAY PLANS
DATE 9/24/90

DEPUTY STATE ENGINEER
Robert P. Mikelson

U. S. DEPARTMENT OF TRANSPORTATION
FEDERAL HIGHWAY ADMINISTRATION

APPROVED DATE

DIVISION ADMINISTRATOR

DETAIL SHEET

PUBLIC HEARING REQUIREMENTS CERTIFIED	N/A
ENVIRONMENTAL CLEARANCE	4-6-90
C & S REVIEW	
BID SET REVIEW	

REVISIONS			
C.O. NO.	DATE	BY	DESCRIPTION

DRAWING NO.	D-10-T-366
HARD COPY	9011 M-1
COUNTY	PIMA
DRAWN	G. JIRON/LMF
CHECKED	L. FURUBOTTEN
SCALE	1"=50'
ROUTE	B-10
LOCATION	B-10 AT AJO WAY

ARIZONA DEPARTMENT OF TRANSPORTATION
HIGHWAYS DIVISION
RIGHT OF WAY PLANS SERVICES

HIGHWAY: BENSON HIGHWAY
PROJECT NO. M-951-1

SHEET 1 OF 1

Click here for I-10 Index

ZF1:[45,53]B10RW248.DGN;1 VIEW NAME:
21-SEP-1998 19:36

TRACS NO. 0B10 PM 248 H 2818 01R

___ OF ___