Click here for I 17 Index

Revisions		
DATE	INITIALS	DESCRIPTION
10-5-62	DR/WC	Revised dates of acquisition & areas of take;
		Added ownership names to Item A-450
5-10-65	R.L.C.	Added Bearing & Angle Point at Sta. 152+50.79; Changed Bearing & Dist. Line (Un-Even) To read N09°41'05"E

OWNERSHIP RECORD			
DATE REQ.	AREA OF TAKE	ITEM	OWNER / DESCRIPTION
8-19-59	36,615 sf	A-449	FRANK H. & OVA ANN BARR — LOT 7 BLK 2 CHRISTY ACRES
1-25-61	1306 sf	A-450	JULIUS & ANNA MORRISON, H/W — LOT 10 BLK 2 CHRISTY ACRES
			SARAH SEGMAN FINGOLD, ADAM H SEGMAN & ETHLYE L, H/W, SAM & SARA FISHMAN, H/W

GREENWOOD MEMORIAL (CEMETERY) PARK

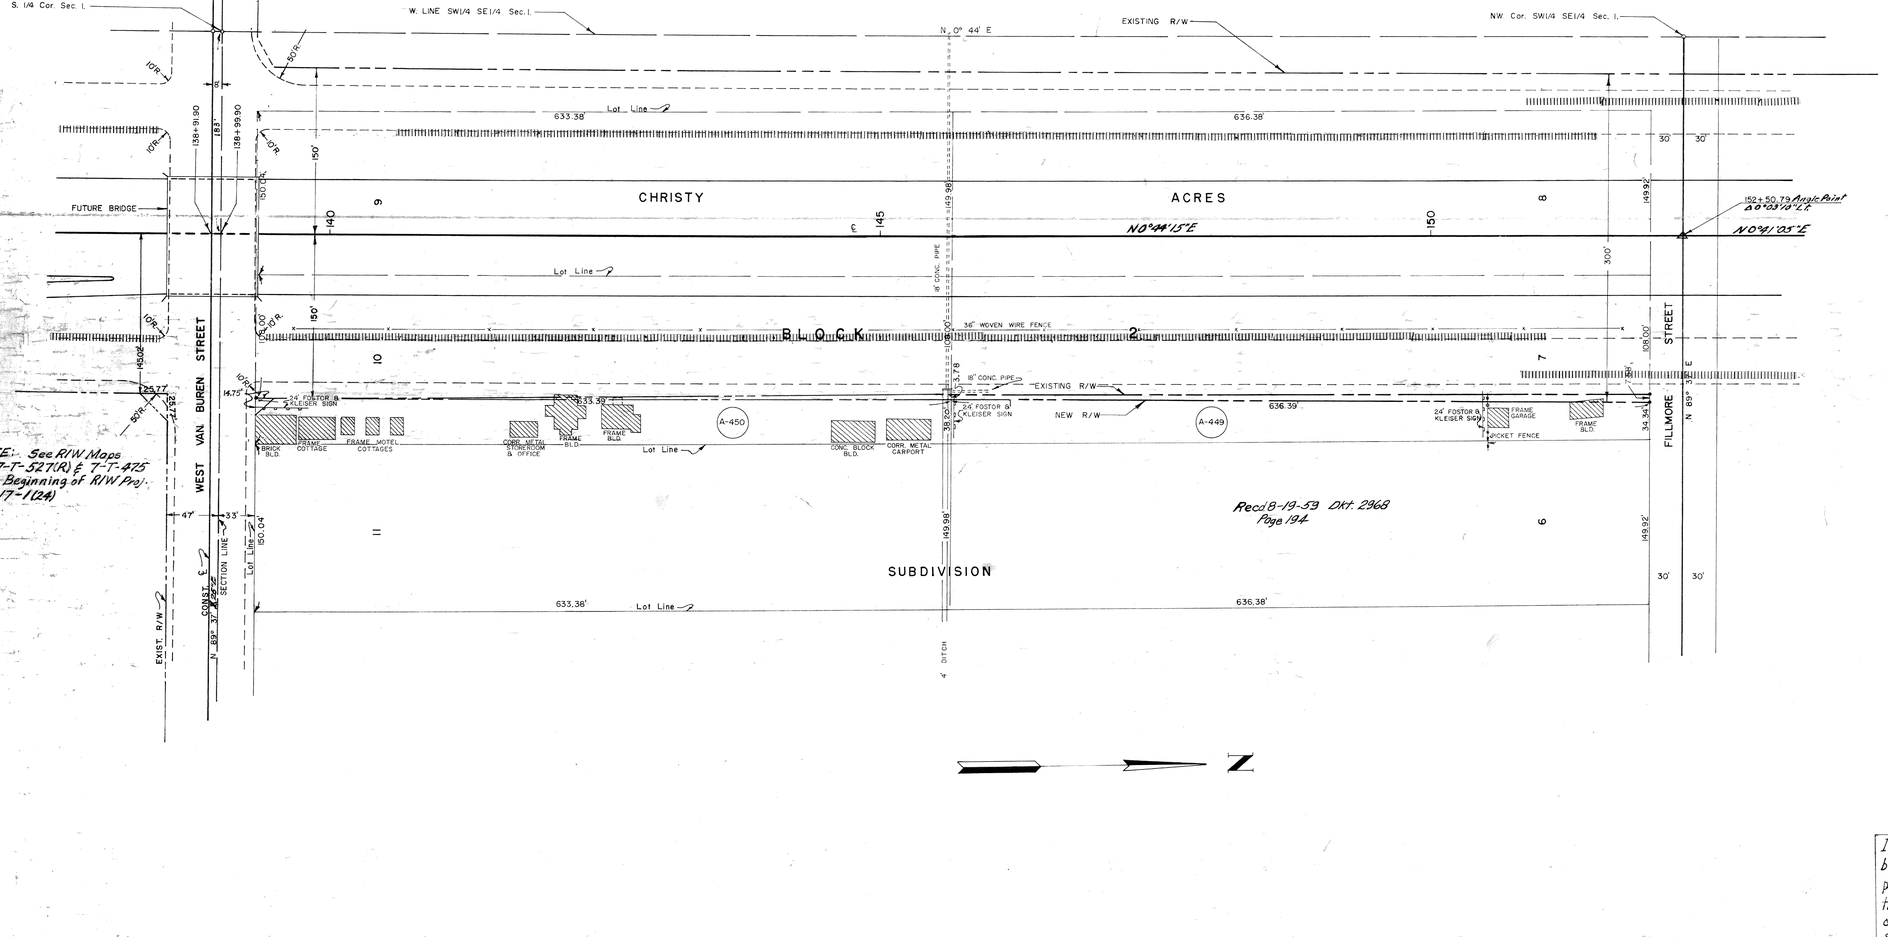

I certify that these R/W plans have been compared with the ASBUILT plans of project I-17-1(24) and that the STATE of ARIZONA has good and sufficient title to the R/W as shown. 9-15-66 John M. Lorman
DO NOT REVISE OR ALTER

ARIZONA HIGHWAY DEPARTMENT
RIGHT OF WAY DIVISION

RIGHT OF WAY MAP OF
PHOENIX — INTERSTATE — FREEWAY
INTERSTATE HIGHWAY 17
FEDERAL AID PROJECT I-17-1
VAN BUREN ST. to FILLMORE STREET
FROM STA: 138+91.90 TO STA: 152+50.79
MARICOPA COUNTY

ALIGNMENT, RIGHT OF WAY WIDTHS, AND CONTROL OF ACCESS APPROVED IN ACCORDANCE WITH HIGHWAY PLANS.
DATE: 6-7-67
ASS'T STATE ENGINEER

APPROVED IN ACCORDANCE WITH RESOLUTION DATED: JUNE 2 1959, MINUTES OF THE ARIZONA HIGHWAY COMMISSION.

DRAWN BY	DATE	SCALE	CHECKED BY	FILE NO.
JON GROFF	5-21-59	1" = 50'		D-7-T-617

I-17-1

D-7-T-617