Click here for I 40 Index

KINGMAN - ASHFORK HIGHWAY
ROUND VALLEY T.I.
MOHAVE COUNTY

OWNERSHIP RECORD / ACQUISITION RECORD

PARCEL NUMBER	OWNER	DESCRIPTION	TOTAL AREA	AREA REQUIRED GROSS INCLUDING EXISTING R/W	AREA REQUIRED NET EXCLUDING EXISTING R/W	EASEMENT AREA	REMAINDER LEFT	REMAINDER RIGHT	SHEET NUMBER	COMMISSION APPROVAL	TYPE & DATE OF INSTRUMENT	RECORDED DATE	RECORDED BOOK	RECORDED PAGE
8-434	Blake Cattle Co., et al	Pt. SE 1/4 NE 1/4 Sec.31, T.21N., R.13W.	(A) 594.6ac.	0.70 ac.	0.24 ac.		(B)	(B)	1	12-23-76	WD 9-28-76	1-18-77	372	407-8

(A) CATTLE CO. INCLUDING SEC. 31. TOTAL OPERATIONS ARE APPROX. 70,000 ACRES.

(B) TOTAL REMAINDER IN SEC. 31 = 593.9 ACRES.

REVISIONS			
C.O. No.	DATE	BY	DESCRIPTION
4652	9-29-76	R.E.F.	ADDED CATTLE GUARD.
4786	3-3-77	R.L.R.	See C.O. For Bid Set Revisions.
5853	7-23-81	P.J.W.	FINALIZED

PROJECT NO.	I-40-2 (83)
DRAWING NO.	D-8-T-313
SHEET NO.	1 of 1
DRAWN BY	R.E. FINN
DATE COMP.	JULY 22, 1976
SCALE	1" = 100'

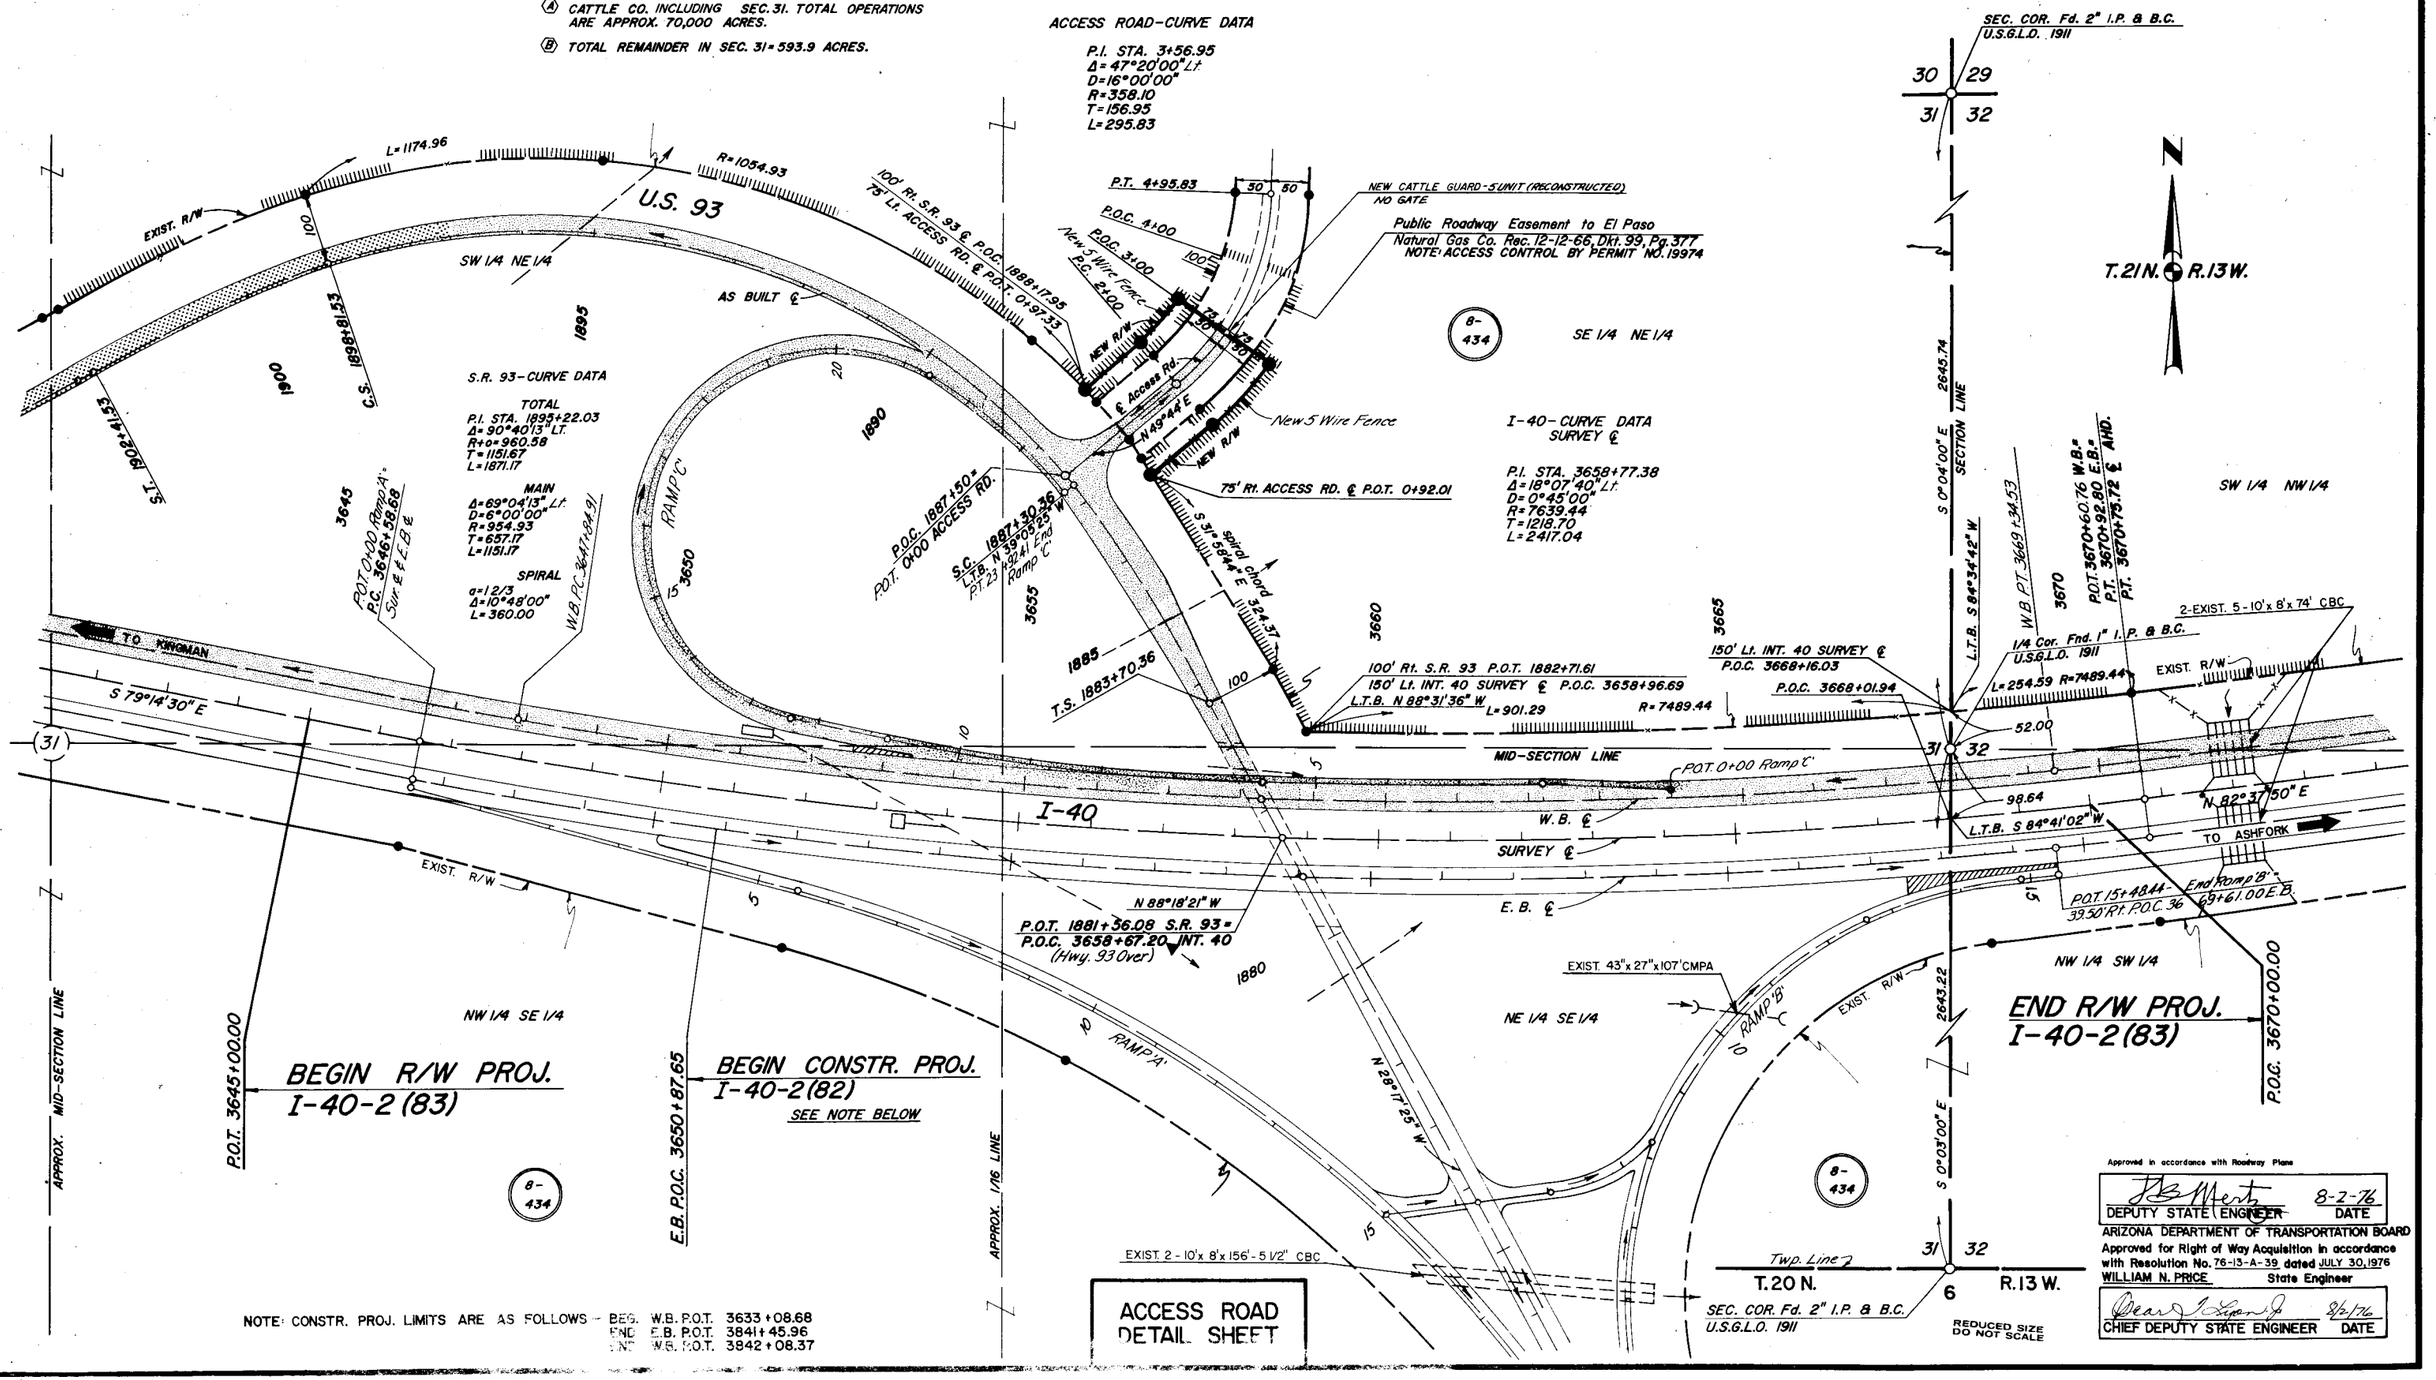

AS BUILT PLANS I-40-2 (49)
FINALIZED PLANS I-40-2 (IQ)
CHECKED BY
HARD COPY
BRUNING 44-512