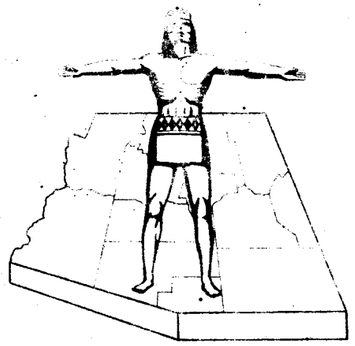

STATE OF ARIZONA
STATE HIGHWAY DEPARTMENT

RIGHT OF WAY PLAN OF THE

HOLBROOK–LUPTON

STATE HIGHWAY

PROJECT NO. I-40-5 (24) 335

APACHE

COUNTY

FED.ROAD DIV. NO.	STATE	PROJECT NO.	SHEET NO.	TOTAL SHEETS
7	ARIZ.	I-40-5 (24) 335	1	18

RIGHT OF WAY MAP NO. D-I-T-222

ALIGNMENT, RIGHT OF WAY, AND CONTROL OF ACCESS APPROVED IN ACCORDANCE WITH HIGHWAY PLANS.

DATE 12/27/61 — H.H. Gladwick, ASSISTANT STATE ENGINEER

APPROVED IN ACCORDANCE WITH RESOLUTION DATED: 3-23-1962, MINUTES OF THE ARIZONA HIGHWAY COMMISSION BY RES. No. 62-96

A.F.E. NO. 64160

Click here for I 40 Index

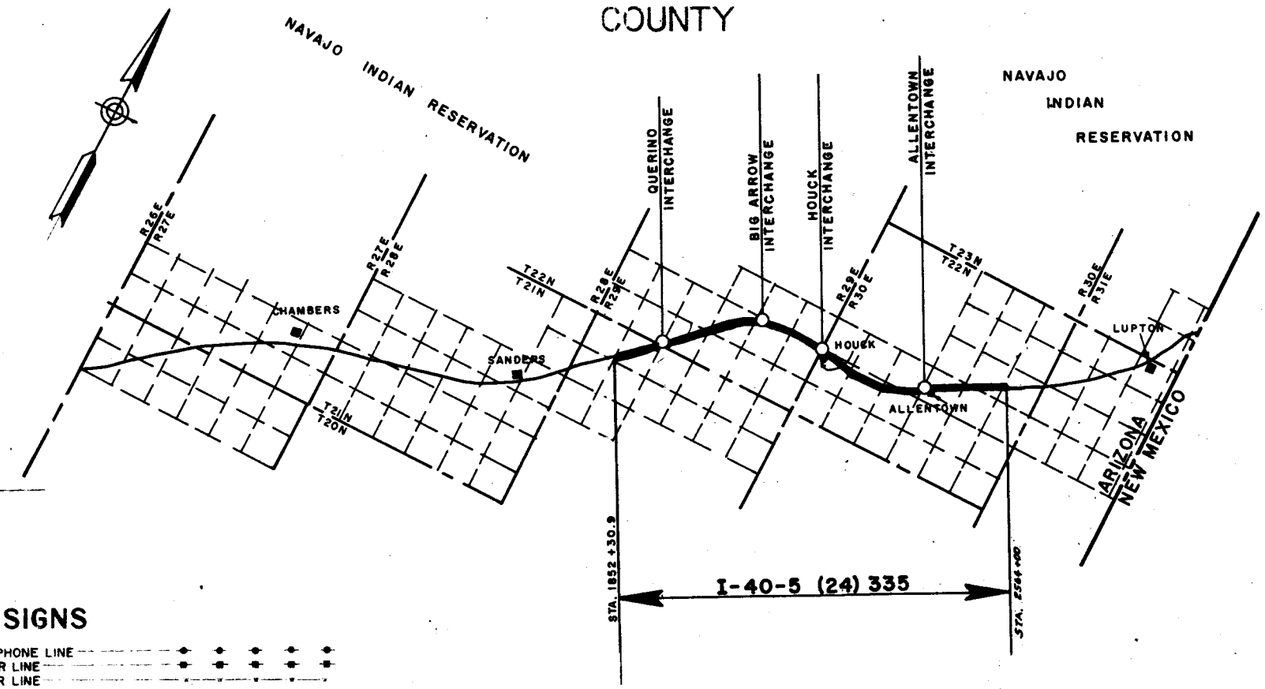

NOTE:

THE SOLID DOT, AS SHOWN BELOW, DOES NOT DESIGNATE A R/W MARKER BUT REPRESENTS AN ANGLE POINT OR CHANGE OF DIRECTION IN THE R/W LINE & IS FOR OFFICE USE ONLY

CONVENTIONAL SIGNS

- HIGHWAY CENTER LINE
- STATE AND NATIONAL LINES
- CITY LIMITS
- COUNTY LINE
- TOWNSHIP AND RANGE LINES
- SECTION LINE
- HIGHWAY R/W LINE
- RAILROAD R/W LINE
- PROPERTY LINE
- LOT AND PROPERTY LINE (WITHIN EXISTING R/W)
- RAILROAD
- COMMON R.R. AND HWY. R/W LINE
- ACCESS TO BE DENIED
- ACCESS OPEN
- PARCEL ITEM No's (A-105)
- FOREST, NAT'L. MONUMENTS, AND INDIAN BOUDARIES
- LAND GRANT BOUNDARY
- R/W MARKER

- TELEPHONE LINE
- POWER LINE
- WATER LINE
- GAS LINE
- SEWER LINE
- STORM DRAIN
- UNDERGROUND TEL. CABLE
- CHAIN LINK FENCE
- BARBED WIRE OR ANY OTHER FENCE. (CALL OUT TYPE)
- POWER POLE WITH TRANSFORMER
- DOWN GUY
- LIGHT POLE
- FIRE HYDRANT
- WATER METER
- WATER VALVE
- MANHOLE
- EXIST. ROAD OR TRAVELED WAY
- GAS METER
- GAS VALVE

ARIZONA HIGHWAY COMMISSION
APPROVED:
STATE HIGHWAY ENGINEER
DEPUTY STATE ENGINEER — Oct. 8, 1962 DATE

DEPARTMENT OF COMMERCE
BUREAU OF PUBLIC ROADS
APPROVED:
DIVISION ENGINEER — DATE

MAP REVISIONS

C.O.#	DATE	NAME	DESCRIPTION
	10-31-62	Rogers	Eliminated area taken from item D-181.
3082	9-30-71	DWS	FINALIZED - CHANGES IN ORANGE

REDUCED SIZE DO NOT SCALE

MAP REVISIONS

DATE	NAME	DESCRIPTION
9-7-61	ROGERS	PLATTED OWNERSHIP & ALIGNMENT CHANGES AT INTERCHANGES.
2-8-62	P. Julian	Checked Map, Made corrections on bearings, Right of ways
11/1/1	1/1/1/1/1	Added Ditch & dykes, & Culverts, corrected Par & RC. & Corrected EQUA.
4-20-62	Rogers	Changed R/W 1837 RT. & 1822+50 LT. & 2566. Added drain. 6056. Sta. 1330 LT.
" " "	"	1974 LT, 2330 RT., 2345 RT., 2370 RT., 2401 LT, 2483 LT & RT., 2462 LT. & 2478 RT.
4-20-62	"	Added drain. 6056 areas.
7-27-62	Jongers, J.H.	Added Archeology site 13 to Sheet 10
8-7-62	CHILDERS	Added The Slope Limits To All Sheets
10-2-62	J.N.J & RW	Corrected Sec. Tins & Areas

HOLBROOK — LUPTON HWY.
CEDAR PT. - THREE HOGANS
APACHE COUNTY

Click here for I 40 Index

OWNERSHIP RECORD SHEET

REVISIONS			
C.O.	DATE	BY	DESCRIPTION
3082	9-30-71	DWS	FINALIZED - CHANGES IN ORANGE.
5080	6-20-78	LG	Added Par. 1-218, 1-219

REVISIONS			
CO No.	DATE	BY	DESCRIPTION
	10-31-62	Rogers	Eliminated area taken from D-181
	4-24-63	J.H.J.	Revised Areas D-165 & Added D-165-1
	6-19-63	J.H.J.	Indicated Parcel where access only is to be acquired.
	7-25-63	Nowicki	R/W take D-176 was 2.00 is 2.44c.
323	5/64	E.T.E.	ADDED D-165-A
330	6/64	E.T.E.	Added New Acreage Taken Shown as D-161-A, D-177-A, D-178-A, D-183-A, D-184-A
448	9/24/64	Nowicki	Add Ease Area Item D-178-B
681	5-28-65	E.T.E.	Added New C/M Take Shown As Parcels D-161-B & D-170-A
1074	8-6-66	E.L.R.	Chg'd Area on D-165 and boar S.E of Guerino Int'chg.
1079	5-10-66	Nowicki	Revised Parcel D-165-A
1355	11-14-66	L.C.K.	Revised ownership of parcels D-170 & D-170-A.
1652	7-27-67	E. Ross	Added Parcel D-176-A new R/W take.

PROJECT NO.	I-40-5 (24) 335
DRAWING NO.	D-1-T-222
SHEET NO.	2 OF 18
DRAWN BY	E.L. ROGERS
DATE	12-28-61
SCALE	1" = 100'

ITEM	OWNER	DESCRIPTION	ACREAGE TAKEN	ACREAGE REMAINING		SHEET NUMBER	ACREAGE OF DRAIN. EASE.	ACQUISITION RECORD				
								COMM. APPR.	TYPE AND DATE OF INST.	RECORD DATE	DK'T	PAGE
D-161	NAVAJO INDIAN RESERVATION	PT. S½ SEC. 5 T21N R29E	2.94			3	329 sq. ft.	1-31-64	APPLICATION LETTER APPR.	(A-1-T-222A) MAP DATED DATED 5-15-64	4-26-66	
		SE¼ SE¼ SEC. 32 T22N R29E	10.05			4	0.344					
		SEC. 23. T22N R29E	Access			10 & 11						
		NW¼ NE¼ NW¼ SEC. 25 T22N R29E	0.86			11						
		N½ SE¼ SE¼ SW¼; N½ S½ SW¼ SE¼; N½ NE¼ SW¼ SE¼; SE¼ SE¼ SEC. 24 T22N R29E.	7.43			12						
		NW¼ SEC. 28 T22N R30E	6.50			14						
		SEC. 21 T22N R30E	13.23			14, 15, 16	0.172					
		SEC. 23 T22N R30E	5.109			17						
		SEC. 13 T22N R30E	3.16			18	0.115					
D-161-A	NAVAJO INDIAN RESERVATION	SE¼ SW¼ SEC. 21 T22N R29E, NW¼ & NW¼ SEC. 28 T22N R30E	1.3 A			12, 14		7-24-64	SAME AS	D-161		
D-162	GAI. ALL'T. #027972	LOTS 3 & 4; S½ NW¼ SEC. 5 T21N R29E	2.23			3-4	2.296	1-31-64	SAME AS	D-161		
D-163	HOSKA LA PAH ET. AL. ALL'T. #021964	LOTS 1 & 2 S½ NE¼ SEC. 5 T21N R29E	7.76			3 & 4	1.584	1-31-64	SAME AS	D-161		
D-164	GRACE CAVIGGIA, a widow, et al.	SE¼ SEC. 28 T22N R29E	52.56			6 & 7,		3-20-64	FOC. 5-24-66	6-16-66	80	390-2
D-165	A.T. & S.F. R.R.	SEC. 33 & S½ S½ SEC. 27 T22N R29E	~~80.66~~ 52.6			4, 5 & 6, 7	~~2.344~~ None	12-12-67	Q.C.D. 8-18-71	1-16-68	101	188-92
D-166	CLAUDE & CLARA LEE H/W.	N½; N½ S½ SEC. 27 T22N R29E	~~41.64~~ 454.0			7, 8 & 9		4-14-64	W.D. 3-23-64	5-25-64	67	150-51
D-167	FRANK CLARK ET. AL. ALL'T. #010109	W½ NW¼ SEC. 26 T22N R29E	11.60			9, 10		1-31-64	SAME AS	D-161		
D-168	JOHN & LULU LOREN H/W.	W½ NE¼; E½ NW¼ SEC. 26 T22N R29E.	15.96			10, 11	0.344	11-8-63	W.D. AND D.R.D. 8-20-63	12-17-63	63 63	487-88 489-90
D-169	JI AS BA, ALL'T. 049127	NE¼ NE¼ SEC. 26 T22N R29E	1.852			11		1-31-64	SAME AS	D-161		
D-170	YE NEU BAH, ALL'T. # 011061	S½ S½ SW¼ SE¼ SEC. 24 T22N R29E.	Access			11		1-31-64	SAME AS	D-161		
D-171	ALTH KA NES BAH ET. AL., ALL'T # 011059	S½ SW¼ SE¼ SW¼ SEC. 24 T22N R29E.	Access			11		1-31-64	SAME AS	D-161		
D-172	JOHN MORGAN, ALL'T # 011060	S½ SE¼ SE¼ SW¼ SEC. 24 T22N R29E.	Access			11		1-31-64	SAME AS	D-161		
D-173	CHARLIE JOE ET. AL., ALL'T # 011040	SW¼ SW¼ SEC. 24 T22N R29E	Access			11		1-31-64	SAME AS	D-161		
D-174	ELEANORA ASHLEY, ALL'T # 057103	W½ W½ SEC. 25 T22N R29E	1.73			11		1-31-64	SAME AS	D-161		
D-175	YINL NUZ BAH, ALL'T. # 055252	E½ E½ W½ SEC. 25 T22N R29E	0.86			11		1-31-64	SAME AS	D-161		
D-175-1	ARIZONA SILICA SAND CO.	6.585 AC. OF E½ E½ W½ SEC. 25 T22N R29E.				* 12	ACCESS RIGHTS TO EXIST. ACCESS ROAD.	1-31-64	Q.C.D. 9-20-63	3-4-64	65	123
D-176	NAKI L CHEE EST. ALL'T # 027976	W½ E½ SEC. 25 (EXCEPT 6.09 Ac) T22N R29E	~~3.00~~ 2.40			11		1-31-64	SAME AS	D-161		
D-177	NAKI L. CHEE, ALL'T # 027974	E½ E½ SEC. 25 T22N R29E	12.54			12		1-31-64	SAME AS	D-161		
D-178	DOUBLE L-W RANCHES INC., et al	ALL SEC. 13; PT. SEC. 29 & PT SEC. 30 T22N R30E	15.94			12, 13 & 14	0.141	1-31-64	W.D. 6-28-64 D&D 12-4-63	10-26-64 5-10-64	69 65	461-62 187-88
D-179	CHON E YAZHIE, ALL'T # 010161	LOTS 1, 2 E½ NW¼ SEC. 30 T22N R30E	12.121			12, 13		1-31-64	SAME AS	D-161		
D-180	KE A ANY ET. AL., ALL'T # 010163	NE¼ SEC. 30 T22N R30E	13.14			13		1-31-64	SAME AS	D-161		
D-181	TZAHN BAH ET. AL., ALL'T # 010159	NE¼ SEC. 28 T22N R30E	Access			15		1-31-64	SAME AS	D-161		
D-182	NA YAH ET. AL., ALL'T # 010149	SW¼ SEC. 22 T22N R30E	13.56			16, 17	0.719	1-31-64	SAME AS	D-161		
D-183	DANEL BAHE ET. AL., ALL'T # 010150	NE¼ SEC. 22 T22N R30E	7.624			17	1.493	1-31-64	SAME AS	D-161		
D-184	DINE I BAHE, ALL'T # 027977	NW¼ SEC. 22 T22N R30E	1.78			16, 17	0.387	1-31-64	SAME AS	D-161		
D-185	YE NEUP BAH HRS., ALL'T # 068374	SE¼ SEC. 14 T22N R30E	15.52			18		1-31-64	SAME AS	D-161		
D-186	YE NEU BAH HRS., ALL'T # 010142	SW¼ SEC. 14 T22N R30E	2.99			17 18		1-31-64	SAME AS	D-161		
D-165-1	Chester E. & Mary H. Lewis H/W	Pt. Sec. 33 T.22 N. R.29 E. lying N. of Hwy. 66	76.84			5, 6, 7	0.344	6-30-66	F.O.C. 8-8-66	9-27-67	89	474-7
D-165-A	A.T. & S.F. R.R.	Section 33 T22N R29E	2.3 A			5		12-12-67	Q.C.D. 8-18-67	1-16-68	101	188-92
D-177-A	NAKI L CHEE, ALL'T # 027974	NE¼ NE¼ SEC. 25, T22N R29E	0.9 A			12		7-24-64	SAME AS	D-161		
D-178-A	DOUBLE L-W RANCHES INC., et al	S½ NE¼, NE¼ NE¼ SEC. 29, T22N R30E	1.1 A			14		1-31-64	W.D. 8-28-64	10-26-64	69	461-2
D-183-A	DANEL BAHE ET. AL., ALL'T # 010150	S½ NW¼ NE¼ SEC. 22 T22N, R30E	0.7 A			17		7-24-64	SAME AS	D-161		
D-184-A	DINE I. BAHE, ALL'T # 027977	S½ W¼ NW¼ SEC. 22, T22N R30E	0.2 A			17		7-24-64	SAME AS	D-161		
D-178-B	DOUBLE L-W RANCHES INC., et al.	N½ N½ W¼ Sec. 29, T22N, R30E.				13 & 14	1.1 A	1-20-65	D&D 10-16-64	3-15-65	72	429-30
D-161-B	Navajo Indian Reservation	N½ S½ SW¼ SE¼ Sec. 21 T22N R29E. NW¼ SW¼ Sec. 28 T22N R30E	0.4 A			12, 14		7-24-64	SAME AS	D-161		
D-170-A	Ye Neu Bah, ALL'T # 011061	W½ S½ SW¼ SE¼ Sec. 21 T22N. R29E.	0.2 A			12		1-31-64	SAME AS	D-161		
D-176-A	Naki L. Chee Est., ALL'T # 027976	W½ E½ Sec. 25 (Except 6.09 A.) T.22 N. R.29 E.	0.4 A			12		1-31-64	SAME AS	D-161		
1-218	Santa Fe Pacific Railroad Co.	Pt. Sec. 19, T.22 N., R.30 E. ①	0.1 Ac.			12						
		Pt. Sec. 27, T.22 N., R.29 E. ①	84.7 Ac.			7, 8, 9						
		Pt. Sec. 29, T.22 N., R.30 E. ①	39.5 Ac.			13, 14						
1-219	Atchison, Topeka & Santa Fe Railroad Co.	Pt. Sec. 19, T.22 N., R.30 E. ①	0.1 Ac.			12						
		Pt. Sec. 27, T.22 N., R.29 E. ①	87.9 Ac.			7, 8, 9						
		Pt. Sec. 29, T.22 N., R.30 E. ①	39.5 Ac.			13, 14						
		Pt. Sec. 33, T.22 N., R.29 E. ①	124.9 Ac.			5, 6, 7						

① All Railroad Rights lying within the boundaries of Interstate 40 and Rest Areas in Apache, Navajo, Coconino, Yavapai Counties will be acquired simultaneously.

HOLBROOK - LUPTON HWY.
CEDAR PT. - THREE HOGANS
APACHE COUNTY

REVISIONS			
C.O.	Date	By	Description
217	7/14/64	Draper	At Sta. 1879 + Both North & South Side Of Hwy. Added Remove gate Callouts.
323	3/64	E.T.E.	ADDED NEW RD. CHANGED ACCESS CONTROL LINE
336	5-27-64	J.B.	Insert Centerline Distance & Found Corner in place of Unfound.
3082	9-30-71	DWS	FINALIZED - CHANGES IN ORANGE

PROJECT NO.	I-40-5(24)335
DRAWING NO.	D-1-T-222
SHEET NO.	3 OF 18
DRAWN BY.	E.L. ROGERS
DATE	12-28-61
SCALE	1" = 100'

T21N R29E

SEC. 6 / SEC. 7

SW1/4 SE1/4 | SE1/4 SE1/4 | NE1/4 SE1/4

NW1/4 NE1/4 | NE1/4 NE1/4 | SW1/4 SW1/4

1830 | 1835 | 1840 | 1850 | 1855 | 1860

1/16 LINE

NEW R/W

EXIST. R/W

W.B. SURV. & CONST. ℄ — N46° 14' E

E.B. CONST. & EXIST. ℄ — N46° 14' E

Sta. 1833+20

N 0° 11' 59" E (Comp'd.) 750.71'

S 89° 22' 47" E 323.89'

43.75' | 108.78' | 137.38' | 214.31' | 1249.32' → SEC. COR.

P.O.T. 1834+22

P.O.T. 1837+14.5E

P.O.T. 1845+00 110' Rt. W.B.

P.C. 0+00 ROAD CONN.

P.T. 2+11.34

P.C. 1+11.34

P.O.T. 1853+35.25 SEC. LINE

(North 5281.52 USGLO)

1417.32'

Slope Limits

TEMP. ROAD CONN.

P.C. 7+89.72

EQUA 1852+12.80 P.O.T. BK = 1852+15.80 P.O.T. AHD.

P.T. 11+83.72 RD. CONN. BK = P.O.T. 1856+83.33 W.B. EQUA.

P.O.T. 1852+32.46

STA. 1852+32.46 E

P.O.T. 1852+32.46 SEC. LINE

BEGIN GRADER RD.

NEW 20' GRADER RD.

EXIST. R/W

2-10'x6' C.B. CULVS.

CEDAR POINT TRADING POST — Frame & Stucco

Found Corner - Cedar Post Marked

END PROJ. I-40-5(22)325 R/W

BEG. PROJ. I-40-5(24)335 R/W

BEG. CONST. I-40-5(26)337

Sec. Cor. Found 4" dia. Cedar Post Marked 5 grooves East, 1 groove West I.A. 2' above ground.

N 0° 09' 40" E 2634.0

1/4 Cor. Found - 5" dia. Cedar Post. Marked 1/4 W.F. 28" Above ground.

3-UNIT CATTLE GD.

20' Gravel Rd.

D-161

EXIST. FENCE

NEW STOCK FENCE

NEW R/W

EXIST. R/W

NW1/4 SW1/4

SW1/4 SW1/4

D-161

D-162

SW1/4 NW1/4

NW1/4 SW1/4

D-161

SE1/4 NW1/4

D-162

NE1/4 SW1/4

D-161

SW1/4 NE1/4

D-163

1860 | 1865 | 1870 | 1875 | 1880 | 1885 | 1890

W.B. CURVE
Δ = 7° 43' 05" Lt.
D = 0° 15' 00"
T = 1545.95'
R = 22918.32'

E.B. CURVE.
Δ = 2° 58' 00" Lt.
D = 0° 15' 00"
T = 593.5'
R = 22918.32'

1886+38.7 P.C.

MATCH LINE

MID SEC. LINE

1/16 LINE

New 200' x 500' Drainage Easement.

500'

200'

Box Culv. 3-14'x12' 1905.38 in 1:0% 1911.38

P.C. 1876+06.34

PINE SPRINGS RD. ℄ 2.1% 1ST. RD.

No Access No. 2 Gate (Remove)

R = 22818.32' L = 2867.44'

REMOVE 4 B/W FENCE

Slope Limits

NEW R/W

EXIST. R/W

No. 2 Gate, Remove

3 Tables

W.B. SURVEY & CONST. ℄ — N46° 14' 00" E

E.B. CONST. & EXIST. ℄ — N 46° 14' E

NEW 20' GRADER RD.

EXIST. R/W

No Access

EXIST. FENCE REMOVE

ACCESS CONTROL

NEW 20' GRADER ROAD

No. 2 Gate, ~~Remove~~

EXIST. FENCE

~~END GRADER RD STA. 1865+42~~

Cedar Point Wash

~~Remove Gate~~

REDUCED SIZE DO NOT SCALE

Click here for I 40 Index

HOLBROOK – LUPTON HWY.
CEDAR PT. – THREE HOGANS
APACHE COUNTY

Click here for I 40 Index

REVISIONS				PROJECT NO.	I-40-5(24)335
C.O	Date	BY	Description	DRAWING NO.	D-1-T-222
217	3/14	L. Draper	At 57a. 1907 Approx. South Side Of Hwy Added Remove Gate Callout	SHEET NO.	4 OF 18
323	5/64	E.T.E.	ADDED NEW RD. CHANGED ACCESS CONTROL LINE	DRAWN BY	E.L. ROGERS
3082	9-3071	DWS	FINALIZED-CHANGES IN ORANGE	DATE	12-28-61
				SCALE	1" = 100'

LOT 3

LOT 2

LOT 1

SW 1/4 SE 1/4

SE 1/4 SE 1/4

SW 1/4 NE 1/4

SW 1/4 SW 1/4

T22N R29E

T.22N. R.29E.
T.21N. R.29E.

MID SEC. LINE

1/16 LINE

MATCH LINE

W.B. CURVE
Δ = 7° 43' 05" Lt.
D = 0° 15' 00"
T = 1545.95'
R = 22918.32'

E.B. CURVE.
Δ = 2° 58' 00" Lt.
D = 0° 15' 00"
T = 593.5'
R = 22918.32'

1660.77'
N 25° 38' 05" W
(Calc 5280 U.S.G.L.O.)

704.33'
N. 0° 04' 40" W.
(North 5280 U.S.G.L.O.)

1890 1895 1900 1905 1910 1915 1920

300' x 250' Drainage Easement

Borrow pit.

POT 1907+23.57 P.C.

POT 1908+54.12 W.B.

POT 1910+39.76

POT 1912+94.25

E.B. 10' RT. 1918+00 P.O.T. = 0+00 RAMP "A"

1898+45.4 P.T.

NEW R/W — Slope Limits — R = 22818.32' L = 2867.44'

W.B. SURV. & CONST. ℄

EXIST. R/W

REMOVE FENCE

No. 2 Gate, Removed No Access

E.B. CONST. & EXIST. ℄

No Access

No. 2 Gate

ACCESS CONTROL

78" C.M.P.

NEW STOCK FENCE

NEW 20' GRADER ROAD

No. 2 GATE

GW TEL.

RAMP D — W.B. SURV & CONST. ℄ — N 38° 30' 55" E

84" C.M.P.

SW TEL.

E.B. CONST. & EXIST ℄ — N 43° 16' 00" E

RAMP A

Sec. Cor. Found 3"x12"x12" Sandstone Marked 2 notches West 4 Notches East I.A, N.F. 8' above ground.

REDUCED SIZE DO NOT SCALE

D-162 D-163 D-161 D-165

Click here for I 40 Index

HOLBROOK – LUPTON HWY.
CEDAR PT. – THREE HOGANS
APACHE COUNTY

QUERINO INTERCHANGE

REVISIONS			
C.O.	DATE	BY	DESCRIPTION
	4-24-63	J.M.I.	Changed Parcel No. on M. Sec. 33 N. of U.S. Hwy. 66 from D-165 to D-165-1
	5-16-63	FW	Added Brgs., dists. & Cattle Guard D-165-1
217	2-10-64	Draper	Added Fencing & Cattle Guards At Querino Interchange
323	3/6/64	E.T.E.	ADDED NEW R/W TAKE JOHNNIES D-165-A, ADDED NEW ROAD CHANGED ACCESS CONTROL LINE
330	6/64	E.T.E.	COMPUTED DISTANCES ALONG ACCESS CONTROL LINE CHANGED BEARINGS AND DIST. ON D-165
1076	6-6-66	E.L.R.	Chg'd Bear. & Area on D-165
1074	5/9/66	Nawacz	Revised B & D. Par. D-165-A & Ex R/W
3082	9-1971	DWS	FINALIZED – CHANGES IN ORANGE
5080	6-20-78	K.G.	Added Par. 1-219

PROJECT NO.	I-40-5 (24) 335
DRAWING NO.	D-1-T-222
SHEET NO	5 OF 18
DRAWN BY	E. L. ROGERS
DATE	12-28-61
SCALE	1" = 100'

Sec. Cor. Found 6" dia. Cedar Post Marked 4 grooves East, 1 groove South I-A, 2.5' above ground.

T22N R29E

MID SEC. LINE

SE 1/4 SE 1/4 | NE 1/4 SE 1/4 | NW 1/4 SW 1/4 | SW 1/4 NW 1/4 | SE 1/4 NW 1/4 | SW 1/4 SW 1/4 | NE 1/4 SW 1/4

1/16 LINE

MATCH LINE

3+50.0 P.O.T. — 5+66.67 P.C. — R=1004.93' — R=302.93' NEW R/W — CR-1 L=552.72' — L=613.88' NEW R/W

5272.65' (North 5280 (Rec.) M)

11+50.00 P.T. — 1933+25 P.O.T. 200' LT. — New 4 Unit C.G. 16 gate — P.O.T. 1934+25 200' LT.

459.67'(R) — N34° 11' 57" E 1328.77' — RAMP "D" 11+53.19 P.O.T. — P.C. D-03.36 — P.T. 1+57.24 — 704.75' — NEW R/W — Slope Limits — N34° 17' 31" E — RAMP "D" — D-1

New 3 Unit C.G. No. Gate W.B. 1933+75 P.O.T. — P.O.T. 1926+45.93 — W.B. SURV. & CONST. ℄

P.O.T. 12+80 CROSS ROAD — P.O.T. 0+00 RAMP "C" — N 41° 44' 23" E 1777.81' (TTS)(R) — N 41° 43' 35" E — RAMP "C" — NEW R/W — Slope Limits — STOCK FENCE

New 3 Unit C.G. No. Gate — P.O.T. 14+00 CROSS RD. — N 38° 30' 55" E — W.B. SURV. & CONST. ℄

3-SPAN R.C. X-ROAD UNDER — 2 84" C.M.P. — 2 30" C.M.P. — 2 54" C.M.P.

S 0° 03' 18" E 576.62' — 16+89.24 P.C. — CR-2 CROSSROAD — N 31° 29' 05" W

17+84.27 P.T. — E.B. 1934+00 P.O.T. — 3 SPAN STEEL BRIDGE X-ROAD OVER — P.O.T. 18+55.61 CROSS RD. — 84" C.M.P.

R.O.T. 1922+39.86 SEC. TIE — E.B. CONST. & EXIST. ℄ — 30" C.M.P. — N 43° 16' 00" E — E.B. CONST. & EXIST. ℄

RAMP "A" — ACCESS CONTROL 910.17' — N 33° 24' 00" E — P.C. 11+02.94 — P.T. 14+94.11 — 155.85' — 3+33.35 P.C. — 30° 05' 18" (R) — 32 — 5 — 4

Sta. 1921+00 150' Rt. — NEW 20' GRADER ROAD (1961) — N 53° 36' 56" E — 285.72' — 1922+00 E.B. 250' RT. — 1933+52.62 250' RT. — 1451.92'(R) ADD. NEW R/W (1964)

Sec. Cor. Found 3"x12"x18" Stone Marked 2 notches West & notches East I-A, N.E. 6" above ground.

Sta. 1935+23.72 434.73' Rt. E.B.

NEW 20' GRADER RD. P.I. 1922+39.21 Δ=10°08'00" D=3°00'00" R=1909.86' T=169.33' L=337.78'

B-1 — B-2 — RAMP "B" — N 33° 08' 00" E — NEW R/W — Slope Limits — N 33° 29' 25" E — 199.45' — P.C. 20+75.01 455.00' — N 38° 51' 18" E — 196.90' — 45.26' — New 4 Unit C.G. Gate — N 11° 46' E — CR-3 — CR-4 — P.C. 24+81.15 — P.T. 23+31.15 — R=93.24' L=134.67' — R=180.22' NEW R/W (1961) L=317.42' — LOCAL TANGENT BRG. N 53° 30' 33" W — N 46° 00' E (R) 118.06' — P.O.T. 1940+00 E.B. 250' RT. — N 31° 57' 24" E 309.90'(R) — N 36° 34' 05" W 129.93'(R) — P.T. 27+80.53 — C.S. 3+57.03 — 14+06.47 P.A.T. — 130' — 33

704.33' — 216.60' — 319.86' — 485.75'(R) — 1935

CURVE	Δ	D	T
CR-4	119° 30' 00"	40°	245.62'
A-1	5° 15' 50"	3° 00'	87.73'
A-2	10° 08' 00"	3° 00'	169.33'
B-1	10° 08' 00"	3° 00'	169.33'
B-2	6° 59' 15"	2° 00'	225.16'
D-1	3° 04' 39"	2° 00'	76.96'
CR-1	35° 00' 00"	6° 00'	301.03'
CR-2	4° 45' 05"	5° 00	47.34'
CR-3	121° 30' 00"	44°	232.52'

CR-4 LEFT 100'(R) — CR-4 RIGHT 100'(R) — N 14° 16' 00" E 100'(R) — STA. 30+00

REDUCED SIZE DO NOT SCALE

Click here for I 40 Index

HOLBROOK - LUPTON HWY.
CEDAR PT. - THREE HOGANS
APACHE COUNTY

REVISIONS			
C.O.	DATE	BY	DESCRIPTION
	4-24-68	J.H.J.	Changed Parcel No. on Pt. Sec. 33 N. of U.S. Hwy 66 from D-165 to D-165-1
3082	9-30-74	DW.S	FINALIZED - CHANGES IN ORANGE.
5080	4-20-78	KS	Added Par. I-219

PROJECT NO.	I-40-5(24)335
DRAWING NO.	D-1-T. 222
SHEET NO.	6 OF 18
DRAWN BY	E.L. ROGERS
DATE	12-28-61
SCALE	1" = 100'

T22N R29E

Sec. Cor. Found .6" dia. Cedar Post Marked 4 grooves East, 1 groove South I-A, 2.5' above ground.

1/4 Cor. Found 4"x9"x11" Sandstone Marked 1/4 I-A, W.F. 1/4.

N 89°30'55" E 5294.20'

SEC. LINE

NE 1/4 NW 1/4

SW 1/4 SE 1/4

SE 1/4 NW 1/4

NW 1/4 NE 1/4

SW 1/4 NE 1/4

NE 1/4 NE 1/4

1/16 SEC. LINE

MATCH LINE

1950 1955 1960 1965 1970 1975 1980

D-165-1

D-164

D-165

I-219

33

28

NEW STOCK FENCE

Slope Limits 1200'(R)

NEW R/W

N 38° 30' 55" E

W. B. SURV. & CONST. ℄

600'(R)

715.72'(R)

213.72'

100' ℄ P.O.T. 1977+15.72

100'x150' Drain. Easy.

N.S.(R) 100'

N.S.(R) 100'

N.S.(R) 100'

HOLBROOK – LUPTON HWY.
CEDAR PT. – THREE HOGANS
APACHE COUNTY

REVISIONS		
DATE	BY	DESCRIPTION
4-MAY-3	J.H.J	Changed Parcel No. on Pt Sec. 33 N. of U.S. Hwy 66 from D-165 to D-165-1
9-Sept	D.W.S	FINALIZED – CHANGES IN ORANGE.
11-72	K.S	Added New R/W Rt. 2010
5-80	K.B.	Added Par. 1-218, 1-219

PROJECT NO.	I-40-5 (24) 335
DRAWING NO.	D-I-T. 222
SHEET NO.	7 OF 18
DRAWN BY	E.L. ROGERS
DATE	12-28-61
SCALE	1" = 100'

T22N R29E

SW 1/4 SE 1/4 | NE 1/4 SE 1/4 | SE 1/4 SE 1/4 | SW 1/4 SW 1/4 | NW 1/4 SW 1/4 | NE 1/4 NE 1/4

1980 1985 1990 1995 2000 2005 2010

D-164 D-165 D-165-1 I-218 I-219

SPECIAL STOCK FENCE

NEW R/W — Slope Limits

N38° 30' 55" E

24" C.M.P.

W.B. SURV. & CONST. ℄

24" C.M.P.

1116 SEC. LINE

1116 SEC. LINE (Approx.)

1324+86.12 P.C.

R = 4683.66'

L = 2037.81'

2294'

1/4 Cor. Not Found

BOX CANYON

W.B. CURVE
Δ = 30° 09' 15" Rt.
D = 1° 15' 00"
T = 1234.80'
R = 4583.66'

N. 0° 03' 38" W. 5289.06' (North 5280' U.S.G.L.O.) to section corner
N. 0° 03' 38" W. 1372.52'
(1649.9' Rec.)

MATCH LINE

EXIST. R/W

POT 1985 + 65.91 SEC. LINE

548' P.C.

E.B. CONST. & EXIST. ℄

N 43° 16' 00" E

1999+46.79 P.O.T. SEC. LINE.

207.66'

150' Rt. E.B. & P.O.T. 1987+08.91

947.97' SEC. LINE

997.61' 772.00'

RIO PUERCO

150' Rt. Sta. P.O.T. 1997+87.76

150' Rt. P.O.T. 2009+25

300' Rt. P.O.T. 2009+25

400' New R/W

REDUCED SIZE DO NOT SCALE

Sec. Cor. Found 3"x18"x22" Sandstone & Mound of stone Marked 1 groove South, 3 grooves East I-A, 18" above ground.

(To N¼ corner – 1701.5' Rec.)

Sec. Cor. 1133.48

(East 5285.18 S. 89° 56' 55" W. 5294.20' U.S.G.L.O.)

34 35 26 27

Click here for I 40 Index

HOLBROOK – LUPTON HWY.
CEDAR PT. – THREE HOGANS
APACHE COUNTY

REVISIONS			
CO.	DATE	BY	DESCRIPTION
3082	9-30-11	DWS	FINALIZED - CHANGES IN ORANGE
4672	10-8-76	K.S.	Added New R/W Rt. 2010±
5080	6-19-78	K.S.	Added Par. 1-218, 1-219

PROJECT NO.	I-40-5(24)335
DRAWING NO.	D-I-T-222
SHEET NO	8 OF 18
DRAWN · BY	E.L. ROGERS
DATE	12-28-61
SCALE	1" = 100'

SW¼ NW¼

T22N R29E

D-166

LTB = N.63°41'20"E.

N26°18'40"W

NEW STOCK FENCE

R = 4783.66'
L = 415.83'

NEW 3-SPAN 46 I BEAM BR.

NEW R/W

L = 2067.81'
R = 4683.66'

Slope Limits

W.B. SURV. & CONST. ℄

N68°40'10"E

EXIST. R/W

(TO BE REMOVED)

E.B. SURV. & CONST. ℄

CANYON

BOX

NW¼ SW¼

1-218

1-219

2018+98.45 P.T.

W.B. CURVE
Δ = 30°09'15" RT.
D = 1°15'00"
T = 1234.80'
R = 4683.66'

MATCH LINE

EXIST. R/W

2-New 144" Struct. Steel Plate Pipe

BRIDGE IN PLACE

N43°16'00"E

150'

2010

400'
New R/W

150' Rt. Rt. 2000.26

92.26 Rt. Rt. 2000.26

300' Rt. Rt. 2013+25

150' Rt. Rt. 2013+25

(APPROX.) 1/16 SEC. LINE

2014+88.62 P.C.C.

2014+89.23 T.S.

2017+89.23 S.C.

N43°45'41"E 296.04'
a = 1/3
Δs = 1°30'
Ls = 300'

Chord Brg. & Dist. of Spiral

Init. Tang. Brg. N44°46'00"E

R = 5579.58' L = 743.21'

NEW STOCK FENCE

2020

2025

2030

2035

2040

1/16 LINE

MID SEC. LINE

MATCH LINE

E.B. CURVE
Δ = 28°15'00" RT.
D = 1°15'00"
T = 1153.46'

EXIST. CURVE
Δ = 25°25' RT.
D = 1°
T_s = 1442.22'
L_c = 2241.67'

NE¼ SW¼

NW¼ SE¼

SW¼ NE¼

27

D-164

EXCESS

Excess Land
Parcel D-166
(L-4-4A)
Area = 182 ± Acres
See Ros II
88-02-14-08

Excess Land
Parcel D-166
(L-4-4B)
Area = 171.4 ± Acres

Init. Tang. Brg. N56°36'59"E

R = 4483.66' L = 1166.02'

No. 2 Gate (Remove)

N71°31'00"E

2037+48.62 P.T.

REDUCED SIZE DO NOT SCALE

Click here for I 40 Index

HOLBROOK - LUPTON HWY.
CEDAR PT. - THREE HOGANS
APACHE COUNTY

REVISIONS			
C.O.	DATE	BY	DESCRIPTION
3028	9-30-70	DWS	FINALIZED - CHANGES IN ORANGE
3080	6-19-78	KS	Added For. 1-218, 1-219.

PROJECT NO	I-40-3 (24)335
DRAWING NO	D-1-T-222
SHEET NO	9 OF 18
DRAWN BY	E.L. ROGERS
DATE	12-28-61
SCALE	1" = 100'

Sec. Cor. 6" x 14" x 18" Sandstone & Mound of Stone Not Marked 6" above ground.

T22N R29E

22 23 27 26

NW 1/4 NE 1/4

NE 1/4 NE 1/4

NW 1/4 NW 1/4

SW 1/4 NE 1/4

SE 1/4 NE 1/4

SW 1/4 NW 1/4

D-166 D-167

MATCH LINE

1/16 LINE

2040 2045 2050 2055 2060 2065 2070 2075

G.S. 2040+30.80 EXIST. RD.

S.T. 2043+30.80 EXIST. Rd. BK. = EQUA. P.O.T. 2045+47.70 AHD.

END W.B. CONST. 2051+00

Access By Exist. Dirt Road Only.

P.O.T. 2057+35.40 BK. = P.O.T. 2061+00 EXIST. RD. AHD. EQUA.

BIG ARROW TRADING POST

conc. block bldg.

No Access

3-gas pumps

Parking

Lot

REMOVE

NEW R/W

EXIST. R/W

NEW SPL. STOCK FENCE

EXIST. 8'X7'x62'6" Box Cul. Ext. Lt. 15 Rt. 9

APPROX. SEC. LINE

P.O.T. 0+00 RAMP "D"

P.C. 0+07.47 RAMP "D"

P.T. 1+35.54 RAMP "D"

T.S. 2075+09.13

RAMP "D"

N 64° 58' 34" E

Slope Limits

W.B. SURV. & CONST. ℄

W.B. CONST. ℄ EXIST. ℄

2069+49.22

BEAR EQUA. N 68° 40' 10" E BK. = N 68° 41' 00" E AHD.

I-218 I-219

E.B. SURV. & CONST. ℄

N 71° 31' 00" E

2061+81.19

325.76'

FRONTAGE RD.

RAMP-A

FRONTAGE RD. "A"

NEW R/W

N 76° 53' 43" E

904.00'

New Gate

New Type 1 Gate

NEW STOCK FENCE

NEW 8'X7'x55'6" Box Cul.

67' R E.B. STA. 2065+19.10 BEG. FRONTAGE RD. "A"

12' Rt. Sta. 2066+00 = Sta. 0+00 RAMP "A"

N. 1°28'15" E. 2631.40' (North 2640' I.S. G.L.O.)

N. McGee Co.

SPIRAL
d = 1/3
Δ_s = 1°30'
L_s = 300'

REDUCED SIZE DO NOT SCALE

Click here for I 40 Index

Click here for I 40 Index

HOLBROOK - LUPTON HWY.
CEDAR PT. - THREE HOGANS
APACHE COUNTY

REVISIONS			
C.O.	Date	By	Description
217	5-1964	Draper	Added Fencing of Cattle Guards At Big Arrow Interchange.
336	5-27-64	J.B.	Added FA-3 to drawing & Curve Data to Insert. Added Sec 23 & 26 on Exist. Road.
336	5-27-64	J.B.	Changed Bearings on Cross Road
3032	9-30-64	DWS	FINALIZED - CHANGES IN ORANGE.

PROJECT NO.	I-40-5(24)335
DRAWING NO.	D-I-T-222
SHEET NO.	10 OF 18
DRAWN BY	E.L. ROGERS
DATE	12-28-61
SCALE	1" = 100'

SW¼ SW¼

BIG ARROW INTERCHANGE

T22N R29E

23

SE¼ SW¼

SW¼ SE¼

D-161

ACCESS RIGHTS ONLY

EXIST. R/W

NEW R/W

NW¼ NW¼

D-167

MATCH LINE

T.S. 2075+09.19 150' Lt.

2083+50 W.B. 150' Lt.

N75°04'59"E

to sec. cor. S.89°53'40"E 5285.20' (East 5258.88' U.S.G.L.O.) to sec. cor.

APPROX. Sec. Line Sec 23 Sec. 26

New 4 Unit C.G.'s & Gates

3-UNIT C.G. TO REMAIN

EXIST. 4 B/W FENCE - TO REMAIN

MID SEC. LINE

POC 15+11.5 2099+50.37 W.B. POT 14+32.18 RAMP "C"

2100

D-2

C-1

RAMP "D"

N64°36'34"E

D-1

N68°41'00"E

New 3 Unit C.G.'s No Gates

P.O.C. 2084+75

W.B. CONST. & EXIST. ℄

RAMP "C"

N 86°08'56" E

OBLITERATE

BEG. NEW 20' GRADER RD.

2075

2080

2085

2090

2095

2100

2105

2070

CR-1

2078+00 P.O.T.

E.B. SURV. & CONST. ℄

N71°31'00"E

2075+09.19 T.S.

2077+34.13 S.C.

New 3 Unit C.G.'s No Gates

N76°39'34"E New 4 Unit C.G. & Gate

RAMP "A"

N70°21'47"E

B-1

Sign Buried Tanks 2 Gas Pumps Trailer Shop Signs

FA-3 N76°33'43"E 304.00' NEW R/W

F.R. "A" Slope Limits

FA-2

NEW R/W N88°31'14"E 613.08'

FB-1

NEW R/W N35°38'02"E 360.40'(R)

F.R. "B" NEW R/W N71°20'10"E 929.11'(R)

Slope Limits

FB-2

FB-3

NEW STOCK FENCE

N 76°30'23"E 358.42'(R)

NEW R/W

BEG. 20' GRADER RD.

New Gate Std C-16-TR-1

E.B. 2074+00 200' RT.

2078+00 E.B. 325' RT.

E.B. 2081+50 225' RT.

2080+30.72 P.C.

2091+00 E.B. 130' RT.

RAINBOW TRADING POST

Archaeology Site is

2103+58.18 C.S.

2103+83.18 S.T.

2096+63.34 E.B. 2ND F.R. 18°

2098+65.34 C.B. 100' Rt.

SPIRAL
a = 1/3
Δs = 0°50'37"
Ls = 225.00'

SPIRAL
a = 1/3
Δs = 0°50'37"
Ls = 225'

1/16 LINE

1/16 LINE

D-168

50'X300' DRAIN EASE

300'

+25

D-186

NE¼ NW¼
Sec. 26

NW¼ NE¼

SW¼ NW¼

SE¼ NW¼

REDUCED SIZE DO NOT SCALE

FA-3	5°08'34"	6°	954.93'	85.72'	42.88'
	Δ	D	R	L	T
FA-1	24°08'34"		63.00'	26.55	13.47
FA-2	19°00'00"	6°	954.93	316.67	159.80
FB-1	17°09'13"		60.88	18.23	9.18
FB-2	16°00'00"	6°	954.93	266.67	134.21
FB-3	5°01'40"	2°	2817.73	443.98	222.45
FB-4	3°00'00"	0°45'4"	7569.44	396.34	198.21
B-1	8°00'00"	2°	2864.79	400.00	200.32
C-1	11°03'39"	4°	1432.40	276.63	138.75
CR-1	5°35'59"	2°	2864.79	178.32	89.20
D-1	2°33'41"	2°	2864.79	128.07	64.04
D-2	10°06'26"	4°	1432.40	252.67	126.66
E.B.	18°31'20"	0°45'00"	7639.44	2469.63	1245.68
W.B.	21°22'00"	0°45'00"	7639.44	2825.99	1423.74

Click here for I 40 Index

HOLBROOK – LUPTON HWY.
CEDAR PT. – THREE HOGANS
APACHE COUNTY

REVISIONS				PROJECT NO.	I-40-5-(24)335
CO.	DATE	BY	DESCRIPTION	DRAWING NO.	D-1-T-222
	4-1965	J.H.J.	Clarified bearings on W.B. Const'l. Exist ℄	SHEET NO.	11 OF 18
	7-1967	Hansen	Changed New R/W Sts 2'+28' to 150'	DRAWN BY	E.L. ROGERS
3082	9-3031	DWS	FINALIZED - CHANGES IN ORANGE.	DATE	12-28-61
				SCALE	1" = 100'

T22N — R29E

SE¼ SE¼ — NE¼ NE¼ — NW¼ NE¼ — NW¼ NW¼ — SW¼ SW¼

P.O.T. 2107+13.26 BK = P.O.T. 2101+09.7 AHD. EQUA.

2- 8'X5'x472 Box Cul. Sta. 2102+00

New 2- 8'X5'x47'6" Box Cul. Sta. 2100+75

Match Line 0012

S.89°57'E. Bk = S.89°55'E Ahd. As built

S 89°55'00"E As built = S 89°57'40"E.

APPROX. SEC. LINE

to sec.cor. S89°53'40"E 5284.20' (East 5298.88 U.S.G.L.O.)

S 89°57'40"E 4942.05' (East 5301.78') to sec. cor.

2117+58.72 W.B. P.O.T.

SEC. LINE

P.O.T. 2116+26.45

S 89°57'40"E

30" P.C.

R = 7539.44 L = 823.82'

EXIST. R/W

NEW 20' GRADER RD.

NEW R/W

NEW Type 1 GATE

Hogan

shed

Sign

2105+00.35 P.T.

1/16 LINE

(North 26.40 U.S.G.L.O.) 2608.25'

1/4 Cor. Fd. Marked Stone

E.B. SURV. & CONST. ℄

W.B. CONST. & EXIST. ℄

Rest Area

Access Rights Only

No. 2 Gate to Remain

New Stock Fence

No. 2 Gate To Remain

Type 2 Gate To Remain

New No 1 Gate

D-161 D-163 D-173 D-171 D-174

S½ SW¼ SE¼ SW¼ — S½ SE¼ SE¼ SW¼ — S½ S½ SW¼ SE¼ — NW¼ NE¼ — E½ E½ W½ — NW¼ NE¼ NW¼

D-171 D-172 D-170 D-175 D-181

Access Rights Only

END NEW 20' GRADER RD. 2137+40

EXIST. 20' GRADER RD.

NEW R/W 2136+00 END NEW GRADER RD.

No 2 Gate to Remove

New Type 1 Gate

Exist 4 B/W Fence To Remain

MID. SEC. LINE

MATCH LINE

E.B. STA. 2140+00

4-40' steel Girder span Sta. 108 E.

CREEK

P.O.T. 2132+56.20 BK = P.O.T. 2138+26.00 AHD. EQUA.

Rest Area

BLACK

EQUA. 2151+40.57 P.O.T. = 2138+26.00 P.O.T. AHD.

S 89° 57' 40" E. BK. = N 89° 43' 00" E. AHD. EQUA.

S 89° 57' 40" E BK. = N 89° 43' 00" E AHD. EQUA.

1/16 LINE

END PROJ. I-40-5-(26)337 CONST.

BEG. PROJ. I-40-5(27)343 CONST.

REDUCED SIZE DO NOT SCALE

HOLBROOK — LUPTON HWY.
CEDAR PT. — THREE HOGANS
APACHE COUNTY

HOUCK INTERCHANGE

PROJECT NO.	I-40-5(24)335
DRAWING NO.	D-1-T. 222
SHEET NO.	12 OF 18
DRAWN BY.	E.L. ROGERS
DATE	12-28-61
SCALE	1"=100'

REVISIONS

C.O.	Date	By	Description
217	2-1-64	Draper	Added Fencing & Cattle Guards At Houck Interchange.
332	5/6/64	E.T.E.	ADDED D-151-A, D-177-A, AS NEW R/W TAKE ADDED NEW ROADS (EXIST)
359	6/22/64	J.B.	Changed Cross Rd. Sta. from P.O.T 11+97.00 to P.O.T 12+00.00.
1652	7/27/67	E.Ross	Added D-176-A as new R/W take.
3782	9/30/71	DWS	FINALIZED - CHANGES IN DRAINAGE

NAVAJO COMMUNITY CENTER

SW¼ SE¼ — SE¼ SE¼ — NE¼ NE¼ — NW¼ NE¼ — LOT-4 SW¼ SW¼ — LOT-1. NW¼ NW¼

WHITE MOUNDS TRADING POST

RAMP "A" — RAMP "B" — RAMP "C" — RAMP "D"

FR.B-1 — FR.B-2 — FR.C-1 — FR.C-2 — FR.RD.B

CR-1 — CR-2

W.B. SURV. & CONST. ℄ OF EXIST. 38' BIT. SURF. RD.

E.B. SURV. & CONST. ℄

EXIST. R/W

NEW R/W

NEW 20' GRADER RD.

BEG. NEW 20' GRADER RD.

CREEK — BLACK

MATCH LINE — 1/16 LINE

EQUA.

Slope Limits

Sec. Cor. Not Found

Sec. Cor. Fd. 1¼" Iron Pipe Possible Sec. Cor.

Conc. Blk. Bldg.

Frame

Well

New Stock Fence

Access Rights Only

Join Exist Fence Remove Fence Within R/W

Join to Exist. Fence End New Fence

Join Exist Fence End New Fence

(Access Rights & Use of Exist. Access Road.)

Exist. Fence ℄

New & Unit C.G. Gate

Exist. Fence & Join Exist. Fence Beg. New Fence

New Fence

Tank

D-161 — D-161-A — D-161-B — D-170 — D-170-A — D-176 — D-176-A — D-177 — D-177-A — D-178 — D-178-A — D-179 — D-179-A — D-179-B — D-179-C — D-179-D — D-179-E — D-179-F — D-179-G — D-179-H — D-179-I — D-179-L1 — D-173

I-218 — I-219

T22N R29E — T22N R30E

CURVE DATA

CURVE	Δ	D	R	L	T
A-1	48°20'14"	8°	716.20'	604.22'	321.20'
A-2	46°40'54"		100.00'	81.48'	43.15'
B-1	5°47'54"	1°15'	4583.66'	463.87'	232.20'
C-1	35°40'18"		100.00'	62.26'	32.17'
C-2	33°50'42"	6°00'	954.93'	564.08'	290.54'
D-1	45°53'49"	8°00'	716.20'	573.71'	303.25'
D-2	47°15'37"		64.00'	52.79'	28.00'
FR-B-1	37°00'00"		150.00'	96.87'	50.19'
FR-B2	33°30'00"	6°00'	954.93'	558.33'	287.40'
FR-C-1	35°40'18"		63.00'	39.22'	20.27'
FR-C-2	33°50'42"	6.2832°	911.93'	538.68'	277.46'
CR-1	35°00'00"	16°00'	358.10	218.75'	112.91'
CR-2	53°30'00"		318.31	297.22'	160.44'

W.B. CURVE
Δ = 7° 03' 00" RT
D = 0° 11'
T = 1925.14'
R = 31,232.00'

E.B. CURVE
Δ = 7° 03' 00" RT.
D = 0° 11' 02.23"
T = 1318.49'
R = 31,144.00'

REDUCED SIZE DO NOT SCALE

5000 I-8(9) FAP Added Parcels 1-218 & 1-219.

Click here for I 40 Index

HOLBROOK - LUPTON HWY.
CEDAR PT. - THREE HOGANS
APACHE COUNTY

Click here for I 40 Index

REVISIONS			
CO.	DATE	BY	DESCRIPTION
359	10-4-71	J.B.	Added Sec. Cor. not Found.
473	9-24-74	L.H.	Add Easements from D-178-2
473	9-25-74	L.H.	Changed Drainage Co. @ 2330+79
500	6-30-75	D.N.S.	FINALIZED - CHANGES IN ORANGE.
500	6-9-78	K.G.	Added Dr. I-218 & I-219.

PROJECT	NO.	I-40-5(24)335
DRAWING	NO.	D-1-T-222
SHEET	NO.	13 OF 18
DRAWN	BY.	E.L. ROGERS
DATE		12-28-61
SCALE		1" = 100'

T22N R30E

NW¼ NE¼

NE¼ NW¼

NE¼ NE¼

NW¼ NW¼

NE¼ NW¼

Conc. Block Bldg.

Frame

EXIST. R/W

NEW 20' GRADER RD.

NEW STOCK FENCE

W.B. SURV. ℄

W.B. CONST. ℄

E.B. SURV. & CONST.

S 83° 14' 00" E

24° P.C.

36° P.C.

R= 23,844' L= 392.83'

S 79° 25' 45" E

N 84° 49' 53" E 303.66'

NEW R/W

434.83'

REST AREA

D-180

D-178

D-179

D-178-A

I-218

I-219

30

MATCH LINE

1/16 LINE

E.B. 2227+68.98 P.T.

P.T. W.B. 2237+83.25 BK. = P.T. W.B. & E.B. 2237+48.98 AHD. EQUA.

E.B. 2230+00 POT 240' R.T.

E.B. 2285+00 P.O.C. 130' RT.

E.B. 2294+05.53 E.B. P.O.C. 0500 RAMP 12' RT.

Sec. Cor. Found 4"x12"x16" Sandstone Marked 5 Grooves E, 2 grooves South 1-A, W.F. 9" above ground.

N 89° 36' 00" W 5282.00' (USGLO)

19 20 29 30

2322+16.98

2322+30.97

END NEW GRADER RD.

New Type 1 Gate

Sec. Corner not found.

Hogan

Stand

New 2-8'x4' C.B. CULVS.

Slope Limits

ADDITIONAL DRAIN. CASE. ACQ. 10-16-64, DKT. 72, PG. 429-30.

New 2-84"ø 89'6" Box Cul. STA. 2330+79

36"ø 60' Drain Exc. ACQUIRED 12-4-63 DKT. 65, PG. 187-88.

2330+79 C.L. 100' RT.

REDUCED SIZE DO NOT SCALE

2280 2285 2290 2295 2300 2305 2310 2315 2320 2325 2330 2335 2340

HOLBROOK – LUPTON HWY.
CEDAR PT. – THREE HOGANS
APACHE COUNTY

PROJECT	NO.	I-40-5(24)335
DRAWING	NO.	D-1-T. 222
SHEET	NO.	14 OF 18
DRAWN	BY	E.L. ROGERS
DATE		12-28-61
SCALE		1" = 100'

Revisions: Block on Lower Left Hand Corner Ctr.

T22N R30E

NW¼ NE¼ | NE¼ NW¼ | NE¼ NE¼ | SW¼ NE¼ | SE¼ NW¼ | SE¼ NE¼

W.B. CURVE TOTAL
I = 34° 25' 00" Lt.
T_s = 1304.25'
MAIN
Δ = 29° 39' 04"
D = 1° 32' 37"
R = 3711.72'
T = 995.53'
SPIRAL
Q = ½
L_s = 308.72'
$Δ_s$ = 2° 22' 58" Lt.

E.B. CURVE TOTAL
I = 34° 25' 00" Lt.
T_s = 1393.30'
MAIN
Δ = 29° 55' 00"
D = 1° 30' 00"
R = 3819.72'
T = 1033.30'
SPIRAL
Q = ½
L_s = 300'

P.O.T. W.B. 2356+09.35 BK. = EQUA.
T.S. W.B. 2356+23.32 AHD.
T.S. E.B. 2356+14.30
S.C. 2359+14.30 E.B.
S.C. 2359+32.04 W.B.
L.T.B. = S 88°56'58" E.
T.S. 2359+46.5 AS BUILT.
S 84°01'20" E. 304.54'
L = 358.05'
L.T.B. = S 85°29'00" E.
S 83°14'00" E
N 59°38'33" E 216.31'
N 29°05'45" E
L = 589.22'
R = 3611.72'
Sta 2363+00 W.B. 100' Lt. P.O.C.
Sta 2365+00 W.B. 200' Lt. P.O.C.
N 64°30'42" E
Sta 2366+00 W.B. 200' Lt. P.O.C.
Sta 2369+00 W.B. 100' Lt. P.O.C.
Sta 2371+36 W.B.
L.T.B. = N 79°36'32" E
30.60'
30 & 65'
D-178 A
D-178 B
D-178 C
I-218
I-219
Hogan
stand
Frame House
EXIST. R/W
NEW 20' GRADER RD.
NEW 30' GRADER ROAD
W.B. SURV. ℄
W.B. CONST. ℄
E.B. CONST. ℄
℄ AS BUILT HWY.
Slope Limits
NEW R/W
NEW R/W (1964)
ADDITIONAL DRAIN. EASE. ACQ. 10-16-64, DKT. 72, 429-50.
50'x50 Drain Ease. ACQUIRED 12-4-63 DKT. 65, PG. 187-88
2-8'x4' C.B. CULVS.
30'x80' DRAIN. EASE.
Tie Ball
S.C. 2365+42.50
MATCH LINE
1/16 LINE
SEC. LINE
2340 2345 2350 2355 2360 2365 2370

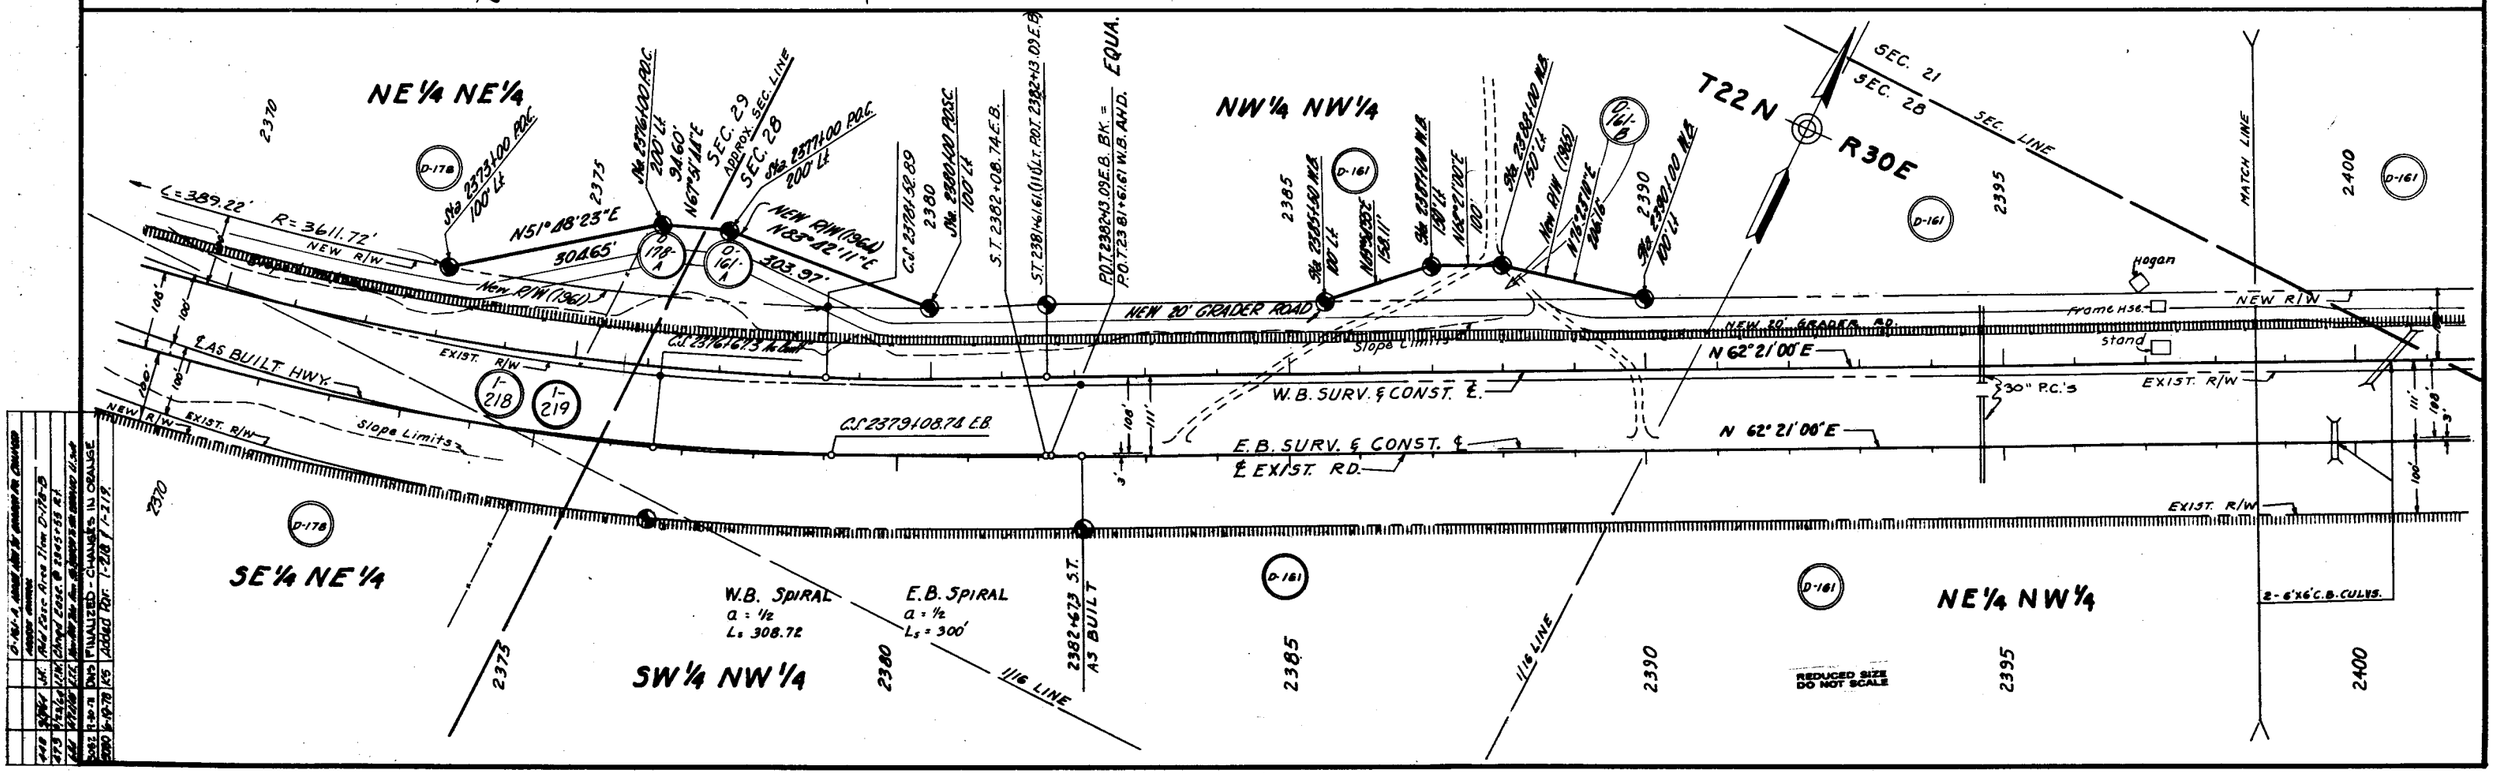


Click here for I 40 Index

HOLBROOK-LUPTON HWY.
CEDAR PT.-THREE HOGANS
APACHE COUNTY

REVISIONS			
C.O.	DATE	BY	DESCRIPTION
[illegible]	[illegible]	[illegible]	FINAL PSL - CHANGES IN "HANGE

PROJECT NO.	I-40-5-(24) 335
DRAWING NO.	D-1-T-222
SHEET NO.	15 OF 18
DRAWN BY	E.L. ROGERS
DATE	12-28-61
SCALE	1" = 100'

SE¼ SW¼ | SW¼ SE¼ | NW¼ SE¼ | NE¼ SE¼

D-161

MATCH LINE

MID. SEC. LINE

1/16 LINE

T22N R30E

2400 2405 2410 2415 2420 2425 2430

50'x150' DRAIN EASE.

NEW R/W

EXIST. R/W

N62° 21' 00" E

℄ OF W.B. SURV. & CONST.

12° LT. 2414+43.00

2428+00 W.B.
P.C. 0-00 RAMP D

N 34° 45' 15" E

605.28'

P.T. 2+20

RAMP D

RAMP A

EXIST. 38' RD.

℄ OF EXIST. 38' RD.

2-10'x8' C.B. CULVS.

12° RT. 2422+26.06
0+00 RAMP A

Slope Limits

New R/W

TO FALLENTOWN - 20.02

APPROX. SEC. LINE

SEC. 21
SEC. 28

D-161

NE¼ NW¼

D-161

ACCESS RIGHTS ONLY

NW¼ NE¼

D-161

SE¼ SE¼

D-161

NE¼ NE¼

28

CURVE DATA

CURVE	Δ	D	T
D-1	6° 14' 00"	2° 50'	110.11'

REDUCED SIZE
DO NOT SCALE

Click here for I 40 Index

HOLBROOK - LUPTON HWY.
CEDAR PT. - THREE HOGANS
APACHE COUNTY

REVISIONS			
C.O.	Date	By	Description
217	5-10-61	Draper	Added Fencing & Cattle Guards At Allentown Interchange.
3596	12/64	J.B.	Removed Sta. Call-out P.O.T. 2438+00 W.B. & added 50' width to Drainage Ease.
3952	9-30-71	DWS	FINAL AS-BUILT CHANGES IN ORANGE.

PROJECT NO.	I-40-5 (24)335
DRAWING NO.	D-1-T-222
SHEET NO.	16 OF 18
DRAWN BY.	E.L. ROGERS
DATE	12-28-61
SCALE	1" = 100'

ALLENTOWN INTERCHANGE

T22N R30E

MID SEC. LINE

SW¼ NW¼ | NE¼ SE¼ | NW¼ SW¼ | SE¼ NW¼ | SE¼ SE¼ | SW¼ SW¼ | NE¼ SW¼

1/16 LINE

MATCH LINE

RAMP D | D-2 | RAMP-C | C-1 | RAMP-A | RAMP-B | B-1 | B-2 | CR-1 | CR-2

NEW R/W | EXIST. R/W | NEW 20' GRADER RD. | NEW STOCK FENCE | Slope Limits

P.O.T. 2433+00 RAMP-C | P.O.T. 2434+00 | P.O.T. 2436+00 | P.O.T. 2437+00 | P.O.T. 1400 CROSS RD. | P.O.T. 2438+00 W.B. | P.O.T. 2439+00 | P.O.T. 2440+00 | P.O.T. 2450+00 | P.O.T. 12°-03' RAMP-C | P.O.T. 15°-03' RAMP-C

E.B. 2438+00 P.O.T. = C.R. B+08.00 POT. | P.O.T. 5+00 CROSS RD. = P.O.T. 2438+00 W.B. | 2435+35.12 | 2434+77.89 | 6+96.60 P.C. | 10+04.35 P.T. | 5+58.60 P.C. | 7+82.38 P.T. | 9+29.46 P.C. | 11+80.32 P.T.

New 4 Unit C.G. & Gates | New 3 Unit C.Gs, No Gates | New 3 Unit C.Gs, No Fence | New 4 Unit C.G. & Gates

N 64° 38' 26" E 1000.73' | N 64° 22' 11" E | N 62° 21' 00" E | N 54° 45' 19" E 302.65' | N 67° 24' 56" E | N 57° 57' 57" E 2827.32' | N 68° 15' 39" E 1303.04' | N 71° 40' 30" E 47.80' | N 36° 40' 50" E 618.90' | N 32° 11' 00" E | N 47° 33' 00" W

NEW 10'x8' C.B. CULV. | 50'x200' DRAIN. EASE. | 50' DRAIN. EASE.

2440+00 E.B. 21.5' RT. | P.C. 7+31 C.R. RD. 15+91.25 RAMP-A 0+00 RAMP-B | P.T. 22+66.03 | P.C. 14+34.92 | R.T. 12+23.96

Sec. Cor. Found 2"ø 8" BC. Sandstone Marked 3 grooves East 2 grooves South

(North 5280' U.S.L.O.) N 02°21'15" W 5276.20 = 1534.94 in SEC. Cor.

CURVE DATA					
	Δ	D	R	L	T
B-1	6°42'48"	3°00'	1909.86'	223.70'	111.98'
B-2	7°31'55"	3°00'	1909.86'	251.06'	125.71'
C-1	3°04'39"	1°00'	5729.58'	307.75'	153.93'
CR-1	79°50'00"	16°00"	358.10'	498.96'	299.60'
CR-2	59°44'00"	12°00"	477.46'	831.11'	566.33'
D-2	7°22'45"	3°00'	1909.86'	245.97'	123.16'

REDUCED SIZE DO NOT SCALE

Click here for I 40 Index

HOLBROOK – LUPTON HWY.
CEDAR PT. – THREE HOGANS
APACHE COUNTY

REVISIONS			
CO.&G.	DATE	BY	DESCRIPTION
338	6/68	E.T.E.	ADDED NEW R/W TAKE SHOWN AS D-182-A & D-188-A
308E	9-30-71	DWS	FINALIZED - CHANGES IN ORANGE.

PROJECT NO.	I-40-5(24)335
DRAWING NO.	D-1-T-222
SHEET NO.	17 OF 18
DRAWN BY	E.L. ROGERS
DATE	12-28-61
SCALE	1" = 100'

W.B. CURVE
Δ = 0°41'40" LT.
D = 0°12'00
T = 173.61'

E.B. CURVE
Δ = 0°41'40" LT.
D = 0°11'59.95"
T = 174.28'

P.T. 2471+31.28 E.B. Bk. = P.O.T. 2471+23.94 Ahd.

T22N R30E

SE¼ NW¼ | SW¼ NE¼ | NE¼ NE¼ | NE¼ SW¼ | NW¼ SE¼ | SE¼ NE¼

Sta. 2464+00 W.B. 100' Lt.
Sta. 2466+00 W.B. 200' Lt.
Mid Section Line
N62°21'00"W 100'
N35°17'06"E 223.60'
382.72'
N62°21'00"W 223.06'
Sta. 2467+00 W.B. 200' Lt. New R/W (1964)
Sta. 2469+00 W.B. 200' Lt.
10'+1'x500' Type "A" Std. C-4 Dyke
50' Easement
NEW STOCK FENCE
10'+1'x300' Type "A" Std. C-4 Dyke
50'x100' DRAIN EASE
30'x300' Drain. Ease.
1/16 LINE
Stucco Hse.
Creek
NEW 20' GRADER RD.
℄ W.B.
℄ E.B. EXIST. RD.
EXIST. R/W
NEW R/W
N62°21'00"E
N61°39'20"E
Frame Res.
Stand
MID SEC. LINE
2-10'x8' C.B. CULVS.
NEW 2-10'x8' C.B. CULVS.
50'x100' DRAIN. EASE
MATCH LINE
2460 2465 2470 2475 2480 2485 2490

NE¼ NE¼ | NW¼ NW¼ | SE¼ NE¼ | SW¼ SW¼ | SE¼ SW¼ | NE¼ NW¼

Sec. Cor. Found 3"I.P. 14" Sandstone Not Marked, 8" above Ground.
N89°30'50"E 5292.60' (East 5267.46' U.S.G.L.O.) To Sec. Cor. 1890.33'
T22N R30E
923.40' N35°30'W. 2644.20' (2644' Meas. 15 G.L.O.)
2495+10.15
125.68
2494+51.40
NEW STOCK FENCE
NEW 20' GRADER RD.
℄ W.B.
℄ E.B. EXIST. RD.
Hogans sales stand
36° P.C.'s
N61°39'20"E
2515+81.67
236.37
2517+90.40
STUCCO HSE.
NEW 6'x6' C.B. CULV.
EXIST. 6'x6' C.B. CULV.
1/16 LINE
1/4 Cor. Not Fd.
MATCH LINE
2490 2495 2500 2505 2510 2515 2520

REDUCED SIZE DO NOT SCALE

Click here for I 40 Index

HOLBROOK — LUPTON HWY.
CEDAR PT. — THREE HOGANS
APACHE — COUNTY

PROJECT NO.	I-40-5(24) 335
DRAWING NO	D-1-T-222
SHEET NO.	18 OF 18
DRAWN BY	E.L. ROGERS
DATE	12-28-61
SCALE	1" = 100'

SE¼ SW¼ | SW¼ SE¼ | NW¼ SE¼ | NE¼ SE¼ | SE¼ SE¼ | NE¼ NW¼

T22N R30E

MID SEC. LINE — 1/16 LINE

D-186 | D-185 | D-183 | D-161

2520 | 2525 | 2530 | 2535 | 2540 | 2545

POT 12' LT. 2524+89

MATCH LINE

NEW R/W — NEW STOCK FENCE — NEW 20' GRADER RD. — NEW 10'X8' C.B. CULV.

℄ W.B. — N61° 39' 20" E — EXIST. R/W

℄ E.B. EXIST. RD. — N61° 39' 20" E

NEW 20' GRADER RD. — EXIST. R/W

EXIST. 6'X6' C.B. CULV. REMOVE

NEW 10'X8' C.B. CULV.

Spring Box 4'X5'X6'

Hand pump

New 12'x12'x52'6" Box Cul. Sta. 2524+05

N16° 33' 20" E 419.17' NEW R/W

P.C. 6+31.40 — P.T. 6+41.40 — R-2

P.C. 3+38.37 — R-3

WEST BOUND REST AREA

SAME — 373° 52' 12" E 378.36' — 12+18.30 P.T. — P.C. 13+23.81

+50 — 425' — 435'

REST AREA CURVE DATA

CURVE	Δ	D	R	T	L
R-1	9° 21' 15"	3°	1909.86'	156.25	311.81'
R-2	10° 30' 00"	5°	1145.92'	105.30	210.00'
R-3	10° 40' 00"	5°	1145.92'	106.98	213.33
R-4	5° 40' 00"	3°	1909.86'	94.52	189.09

REVISIONS			
C.O.	DATE	BY	DESCRIPTION
3028	9-20-71	DWS	FINALIZED - CHANGES IN ORANGE

NE¼ SE¼ | NW¼ SW¼ | SW¼ NW¼ | SE¼ NW | NE¼ SW¼

T22N R30E

1/4 COR.

¼ Cor. Found 5" dia. Cedar Post Marked ¼ T.A., N.F. 2' above gr.

373° 52' 12" E 378.36'

18+18.30 P.C.

P.T. 15+18.30

N 0° 28' 10" W 2642.30' 805.62

18+23.34 END RAMP

NEW STOCK FENCE — NEW R/W — 150' A.C. Ford — Exist. R/W

EXIST. 20' GRADER RD.

R-4 — N 19° 01' — sales stand

℄ W.B. — N61° 39' 20" E

EXIST. R/W

2554+99.91

EXIST. CHANNEL

℄ E.B. EXIST. RD. — N 61° 39' 20" E

2554+41.12

NEW 20' GRADER RD.

EXIST. R/W

EXIST. GRADER RD. Road to Hogan

EXIST. 2-10'x6' C.B. CULVS.

100' A.C. Ford

NEW 50'x 100' DRAIN. EASE.

Exist. R/W

NEW 10'X8' C.B. CULV.

P.O.T. 2569+44.08 BK. N.B.F.E.A. = P.O.T. 2570+00 W.B. AHD.

N61° 39' 20" E W.B. BK. N 61° 40' 00" E AHD. AS BUILT.

BEAR. EQUA.

MID SEC. LINE — 1/16 LINE

EQUA.

96' — 108' — 103'

Sec. Cor. Found 5" dia. Cedar Post, Split, Marked Sec. Cor. 1 grave East 18" above ground

14 23 13 24

END PROJ. I-40-5(24)335 R/W
P.O.T. STA. 2564+00

END PROJ I-40-5 (27) 342 CONST.
STA. 2569+44.08 BK. =
STA. 2570+00 AHD.

REDUCED SIZE DO NOT SCALE

13

Click here for I 40 Index