ARIZONA HIGHWAY DEPARTMENT
RIGHT OF WAY SECTION

Project I-40-5-601	Highway HOLBROOK-LUPTON	Drawn By C. PEPPER	Date 1-29-73
Section CRAZY CREEK DRAINAGE EASEMENT		Checked By P.R. Emo	Date 2-15-73

REMARKS: Acquisition as outlined in E.F. Gentsch's memo to C.A. Clark, dated 12-28-72, with subsequent approval from A.L. Chadwick, dated 1-16-73.

ARIZONA HIGHWAY COMMISSION

Approved for acquisition of Parcel 1-182

STATE HIGHWAY ENGINEER

Chief Deputy State Engineer — Date 2-23-73

Gross area includes existing R/W
Net area excludes existing R/W

OWNERSHIP RECORD

Parcel	OWNER	DESCRIPTION	TOTAL AREA	GROSS AREA	NET AREA	ESM'T AREA	REMAIN LEFT	REMAIN RIGHT
~~1-182~~	~~Minnesota Title Co.~~ * ~~an Arizona corp.~~ ~~Trust No. 320~~	~~Pt. of N.E.4 of Sec. 29~~ ~~T. 20 N. R. 26 E.~~				~~0.40 Ac.~~		

* Formerly Spurlock Ranch

NOTE: Parcel No. 1-182 Was Deleted By P.C.O. Dated 11-5-73

LIST OF TANGENTS

No.	Distance	Bearing
1.	100'	N. 22° 51' 00" W.
2.	175'	N. 67° 09' 00" E.
3.	100'	N. 22° 51' 00" W.
4.	175'	S. 67° 09' 00" W.

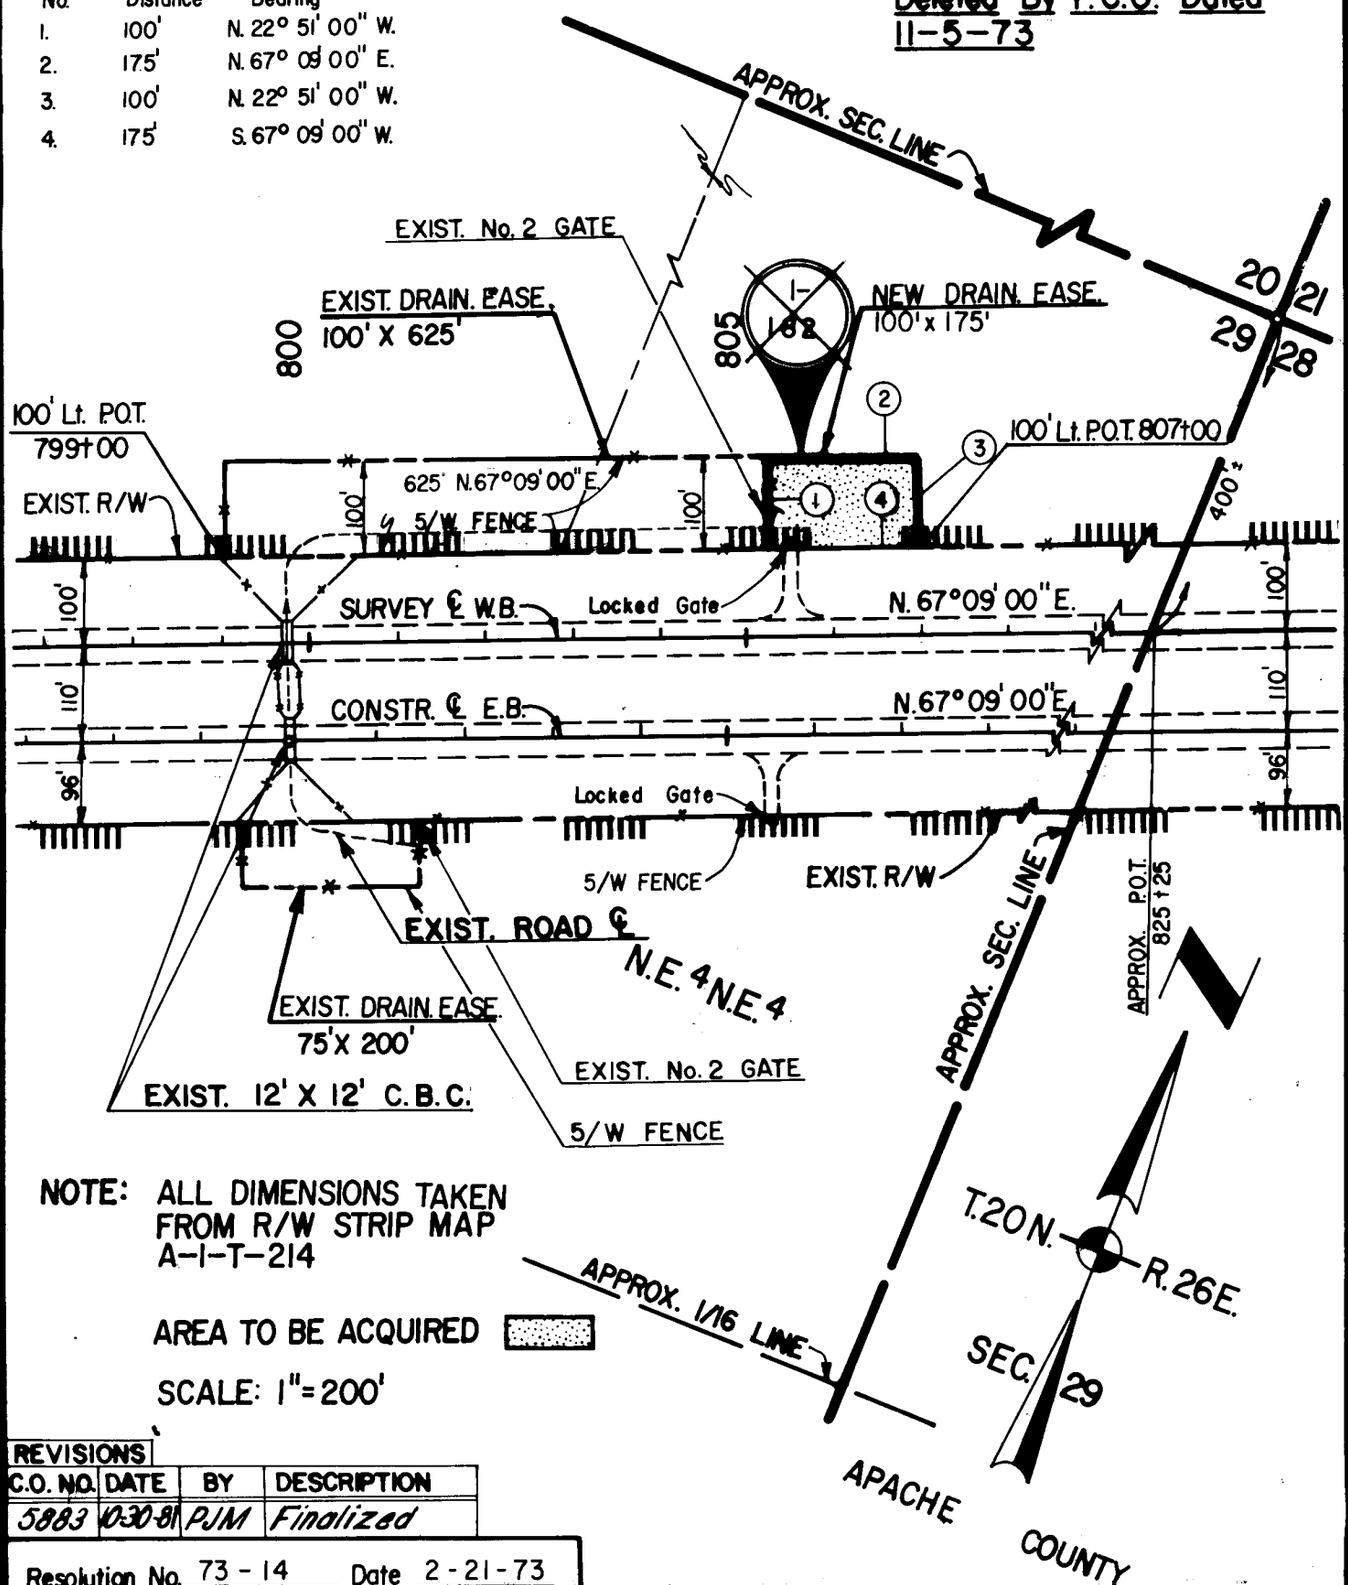

NOTE: ALL DIMENSIONS TAKEN FROM R/W STRIP MAP A-1-T-214

AREA TO BE ACQUIRED

SCALE: 1"=200'

REVISIONS			
C.O. NO.	DATE	BY	DESCRIPTION
5883	10-30-81	PJM	Finalized

Resolution No. 73-14 Date 2-21-73

A.H.D. 60-431 9-66 (.5M 11-67) J.M.K.

Click here for I 40 Index