HOLBROOK - LUPTON HWY.
ADAMANA T.I. DRAINAGE AREA
NAVAJO COUNTY

Click here for I 40 Index

REVISIONS				
C.O. No.	DATE	BY	DESCRIPTION	
5942	5-30-79	R.C.O.	Revised access control north of Adamana T.I.	PROJECT NO. I-40-5-602
5580	5-15-80	J.Mc.	Changed owners, Total Area & Rem. Rt.	DRAWING NO. 0-9-T-289
"	"	"	Per. 9-602E & 9-602-L1	SHEET NO. 1 of 1
				DRAWN BY BOB OLBINSKI
				DATE COMP. 8-10-78
				SCALE 1" = 100'

OWNERSHIP RECORD										ACQUISITION RECORD				
PARCEL NUMBER	OWNER	DESCRIPTION	TOTAL AREA	AREA CROSS INCLUDING EXISTING R/W	REQUIRED NET EXCLUDING EXISTING R/W	EASEMENT AREA	REMAINDER LEFT	REMAINDER RIGHT	SHEET NUMBER	BOARD APPROVAL	TYPE OF INSTRUMENT	DATE	RECORDED DATE	RECORDED BOOK	RECORDED PAGE
9-602	First American Title Insurance & Trust Co. of Ariz. Trust No. 6157	Pt. 9ª Sec. 33, T.19N., R.23E.	~~37.8 Ac.~~ 17.5 Ac.		4.1 Ac.			~~33.7 Ac.~~ 13.4 Ac.	1						
-L1	A.D. Ranch, Inc.	Pt. 5ª Sec. 33, T.19N., R.23E.	~~33.8 Ac.~~ 17.5 Ac.		4.1 Ac.			~~33.7 Ac.~~ 13.4 Ac.	1						

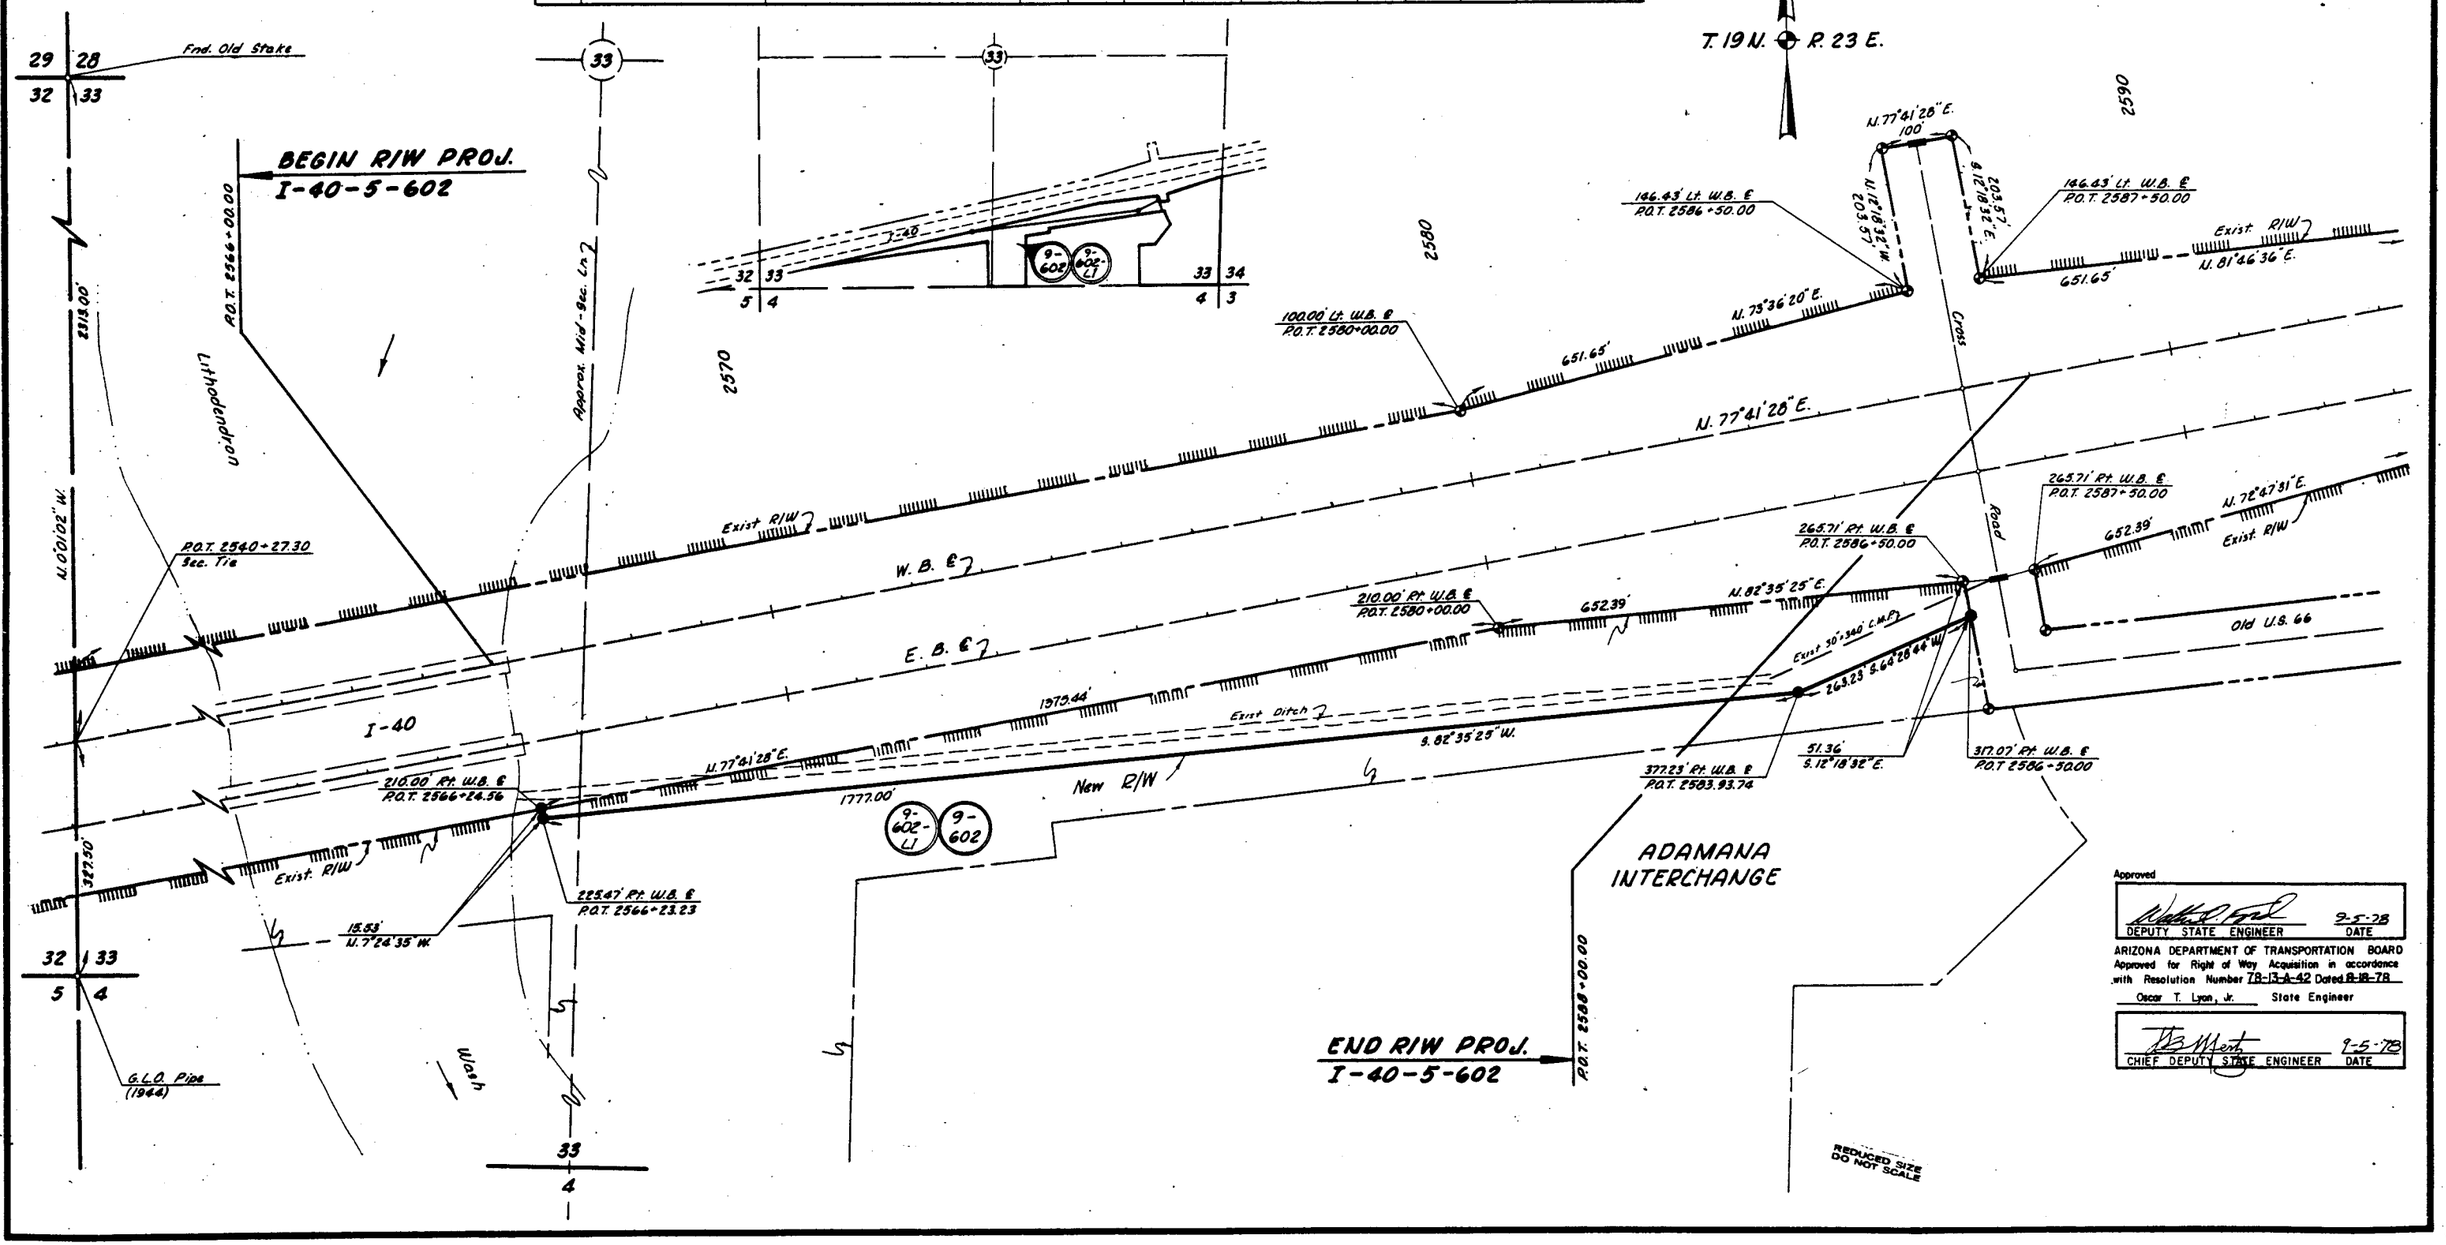

Approved

DEPUTY STATE ENGINEER — DATE 9-5-78

ARIZONA DEPARTMENT OF TRANSPORTATION BOARD
Approved for Right of Way Acquisition in accordance with Resolution Number 78-13-A-42 Dated 8-18-78

Oscar T. Lyon, Jr. — State Engineer

CHIEF DEPUTY STATE ENGINEER — DATE 9-5-78

REDUCED SIZE DO NOT SCALE

CHECKED BY

HARD COPY

BRUNING 44-512