Click here for I 8 Index

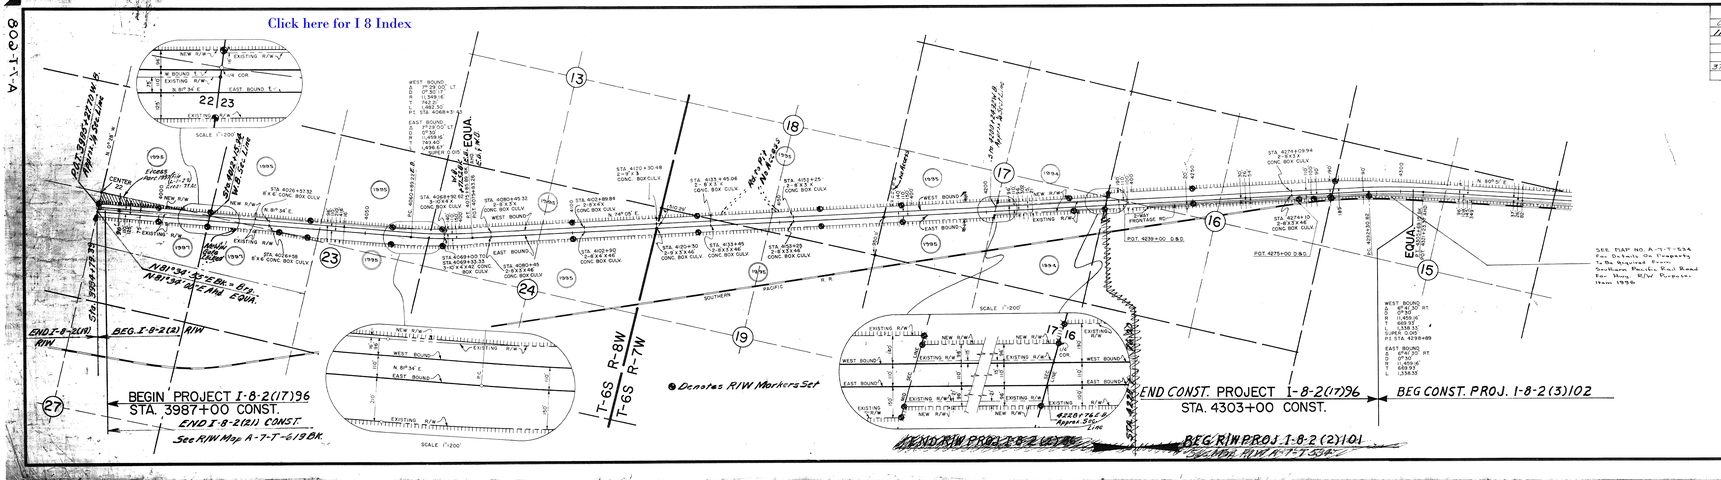

REVISIONS			
CO	Date	By	Descp.
1153	6-2-66	R.L.R.	Mods. Complete C.E. with As-Builts Added Est. Bdys. of Rec. Subdivisions Rev. Matrices 2 & 3 and R/W Tabs. Corr. Numbers at Acquisition
3125	10-9-75	H. Mills	Denotes Bdys. Found Rev. 1997

ACQUISITION RECORD					
Item No.	Owner	Instr.	Date	Docket	Page
1994	State	State Land Dept. Patent	1-29-58	N.R.	
1995	U.S.	U.S. Patent	6-18-58	N.R.	
1996	Southern Pacific R.R.				
1997	G.P. Stoltze	Final Order of Condem.	8-8-60	3446	573

OWNERSHIP TABLE		
ITEM NO.	OWNER	DESCRIPTION
1994	State Land	Etc. Sec. 17, T.6S., R.7W.
1995	U.S. Land	Sec. 18, 19, 20, Sec. 17, T.6S., R.7W.; NE¼, Sec. 22, S½, Sec. 23, Sec. 24, T.6S., R.8W.
1996	Southern Pacific R.R.	See A-7-T-534
1997	Gerald R. Stoltze	NW¼ SW¼, Sec. 22, NW¼ SW¼, Sec. 23, T.6S., R.8W.

A.F.E. 8075

ARIZONA HIGHWAY DEPARTMENT
RIGHT OF WAY DIVISION

RIGHT OF WAY MAP OF
YUMA-CASA GRANDE
INTERSTATE HIGHWAY
FEDERAL PROJECT I-8-2(17)
THEBA WEST SECTION
STA. 3987+00 TO STA. 4296+25
MARICOPA COUNTY

Abutter's rights, including access rights to be acquired.
Date _____ Asst. State Engineer

ALIGNMENT, RIGHT OF WAY, AND CONTROL OF ACCESS APPROVED IN ACCORDANCE WITH RESOLUTION DATED _____ OF THE ARIZONA HIGHWAY COMMISSION

Access rights required shown thus: _____

I CERTIFY THAT THESE R/W MAPS HAVE BEEN COMPARED WITH THE "AS-BUILT" PLANS FOR PROJECT I-8-2(3) AND THAT THE STATE OF ARIZONA HAS GOOD AND SUFFICIENT TITLE TO THE R/W AS SHOWN HEREON. DO NOT REVISE OR ALTER

DRAWN BY	DATE	SCALE	CHECKED BY	FILE NO.
BILL BOURNE	FEB 6, 1958	1"=1000'		A-7T-608
REVISION	DATE		REVISED BY:	

A-7T-608