YUMA—CASA GRANDE HIGHWAY
BORDER PATROL INSPECTION FACILITY
YUMA COUNTY

REVISIONS

C.O. No.	DATE	BY	DESCRIPTION
6073	9-20-82	L.B.	Del. Par. 14-368-1, Rev. Owner & Area Par. 14-368.
6203	7-26-83	L.B.	Added Par. 14-1A-2
5840	6-30-81	R.L.R.	Added Frt. Rd. & Revised Access Control R/W. Exist. E.B. & Sta. 4.551. Changed Ramp & D/W's P.C. 24+84.47, etc.
"	"	"	
"	"	"	
5856	8-26-81	H.E.R.T.	Add Par. 14-368-1; Rev. Name, Areas & Ownership of Par. 14-368.
5875	8-28-81	R.L.R.	Showed dist. of S.30.33(R) as being defin. S.C. 477+66.79 & P.O.C. 483+06.69, exist. E.B.&, etc. Bid (77)
"	"	"	

Project	I-8-1(78)
Drawing No.	D-14-T-359
Sheet No.	1 OF 1
Drawn by	LMF.
Date	5-29-81
Scale	1" = 100'

CHECKED BY: Gary Hoppes

Special Survey Dated Jan. 1981
24H 245, G225 M1.
R/W Plans I-8-1(37)

HARD COPY

OWNERSHIP RECORD										ACQUISITION RECORD				
PARCEL NUMBER	OWNER	DESCRIPTION	TOTAL AREA	AREA REQUIRED: GROSS INCLUDING EXISTING R/W	AREA REQUIRED: NET EXCLUDING EXISTING R/W	EASEMENT AREA	REMAINDER LEFT	REMAINDER RIGHT	SHEET NUMBER	BOARD APPROVAL	TYPE & DATE OF INSTRUMENT	RECORDED DATE	RECORDED BOOK	RECORDED PAGE
14-367	LAWYERS TITLE OF AZ., TRUSTEE, TRUST # 410	PT. SW4 SEC. 12, T.9S. R.21W.	379.85Ac.		0.55Ac.			379.30Ac.	1	10-22-81	W.D. 10-7-81	11-18-81	1255	320-321
14-368	ROY R. YOUNG, ET. AL.	PT. SE4 SEC. 12, T.9S. R.21W.	~~5.00~~ 89.05 Ac.	~~6.47~~ 14.48Ac.	~~6.34~~ 8.44Ac.			~~80.58~~ 74.57Ac.	1	2-23-82	F.O.C.	7-3-84	1391	545-548
~~14-368-1~~	~~S. WILLIAM ALLRED, ET UX.~~	~~PT. SE 4 SEC. 12, T.9S. R.21W.~~	~~84.05 Ac.~~	~~13.81 Ac.~~	~~8.10 Ac.~~			~~70.24 Ac.~~	~~1~~					
						Deleted	9-20-82							
14-1A-2	Roy R. Young, et al	Pt. SE4, Sec. 12, T.9S., R.21W.	89.05 Ac.	14.48 Ac.	8.44 Ac.			74.57 Ac.						

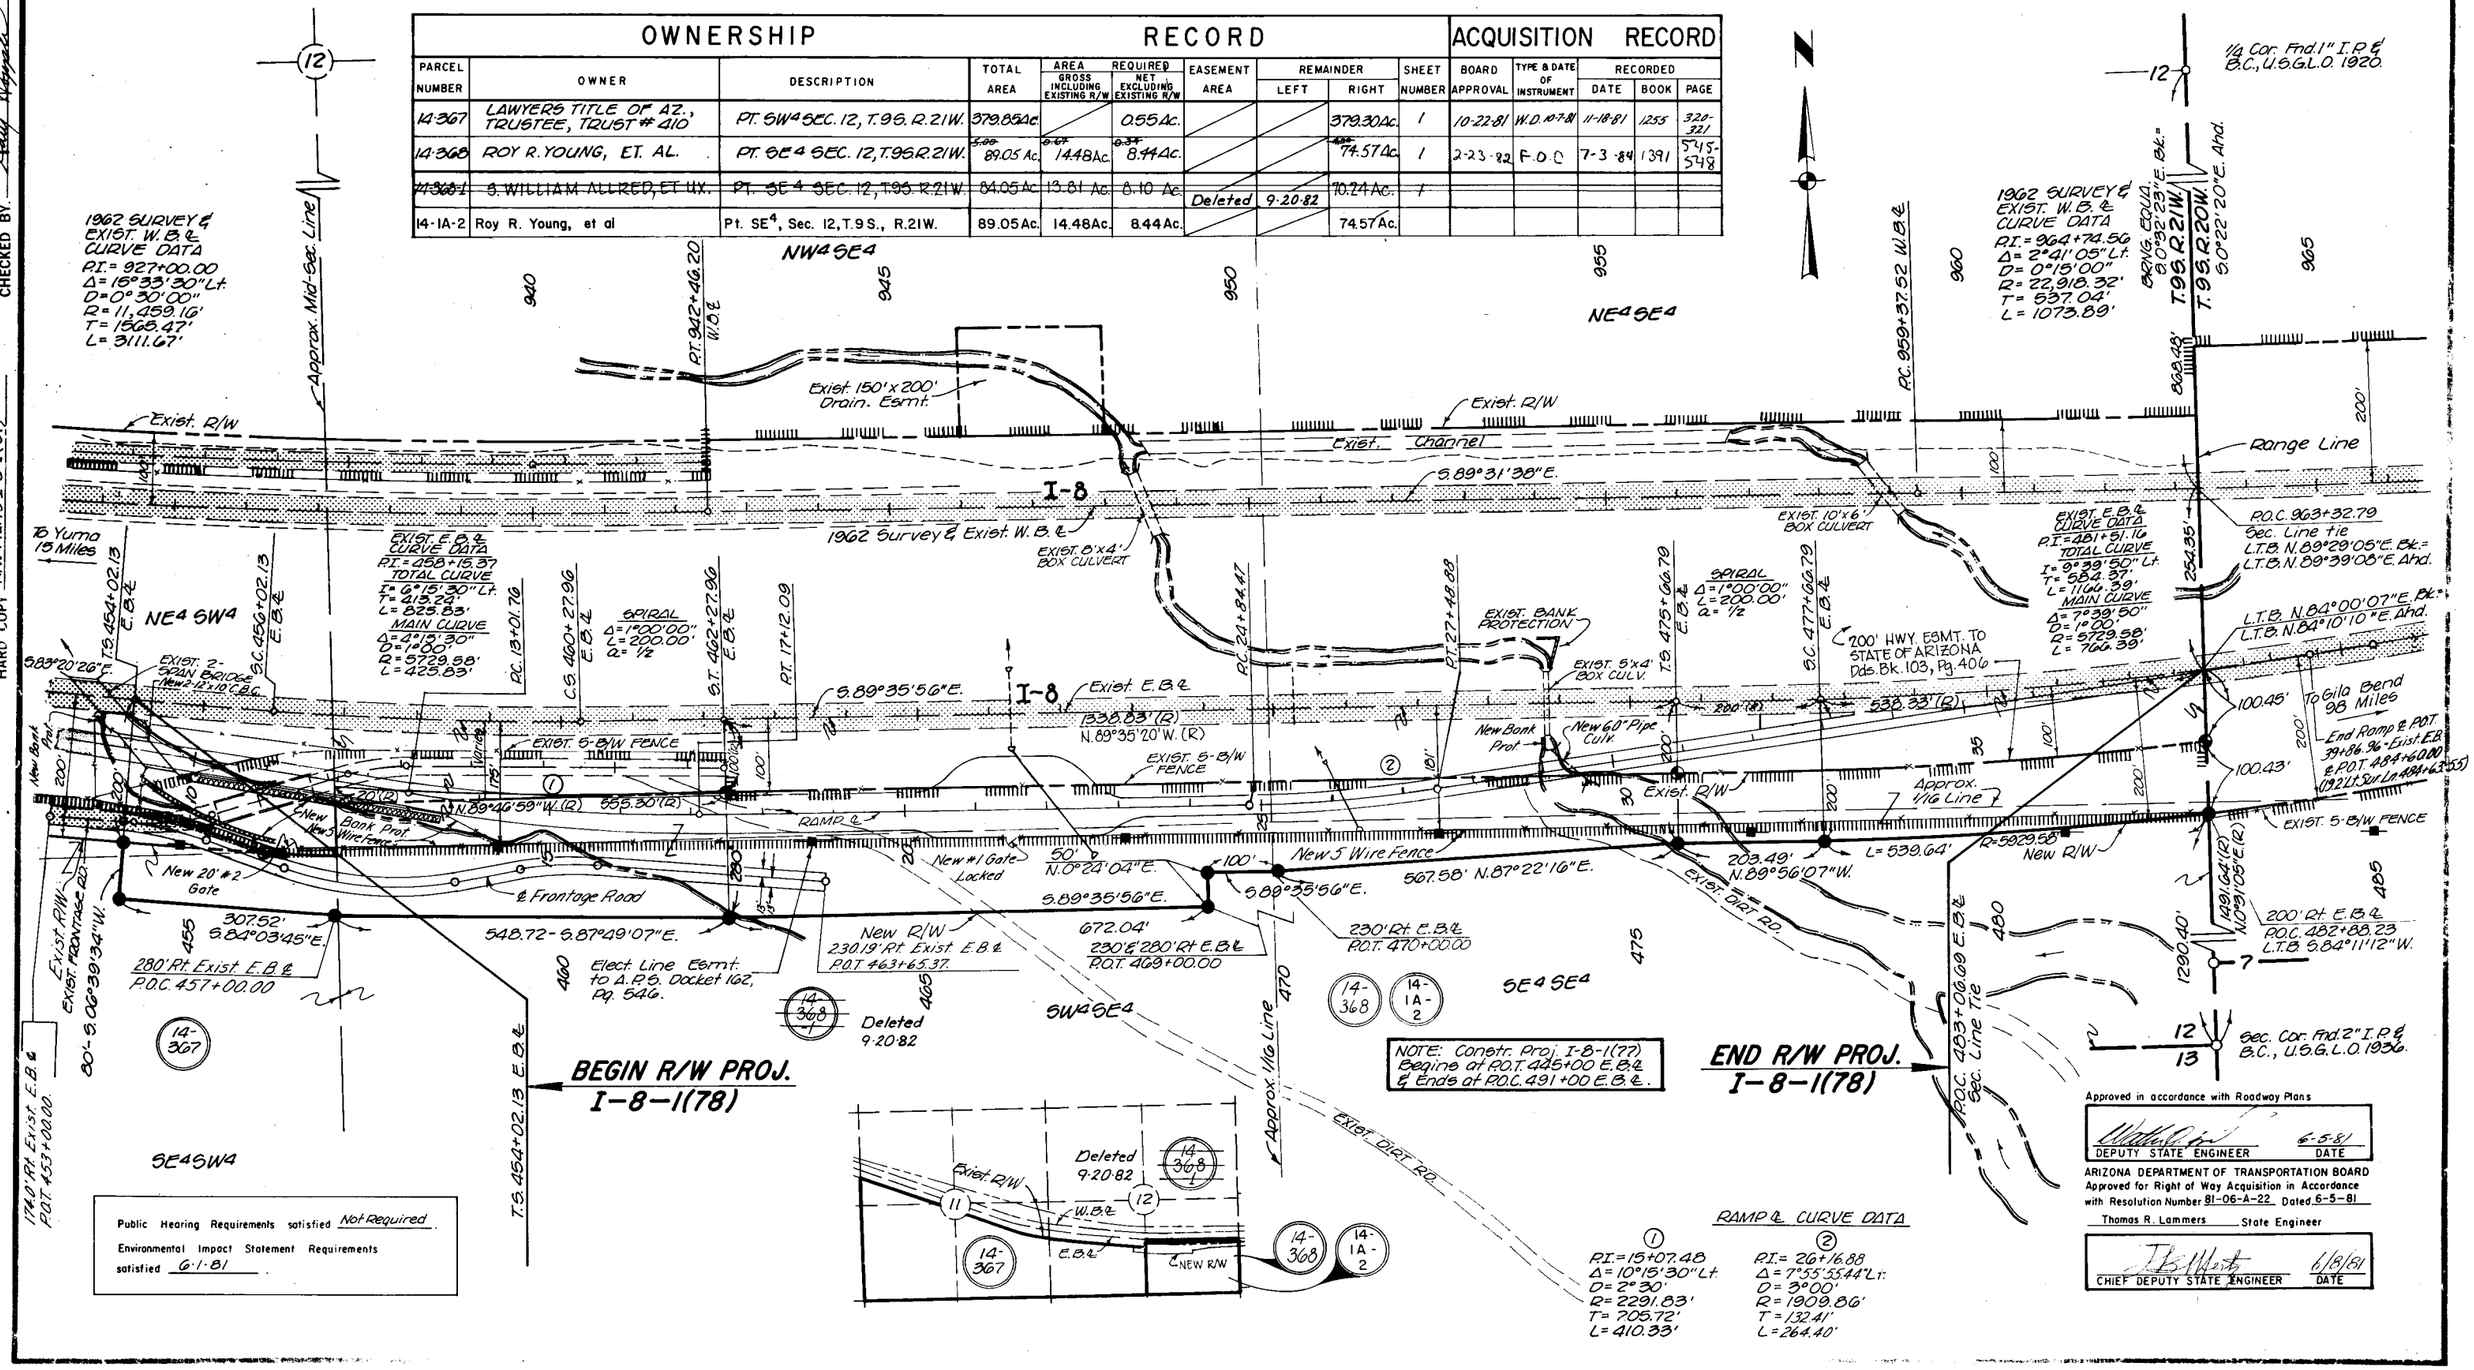

Click here for I-8 Index