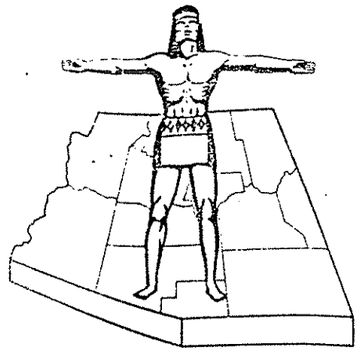

Click here for SR 186 Index

STATE OF ARIZONA
STATE HIGHWAY DEPARTMENT

RIGHT OF WAY PLAN OF THE

*WILLCOX-DOS CABEZAS-CHIRICAHUA*

# STATE HIGHWAY

PROJECT NO. S-273-701

COCHISE
COUNTY

| FED ROAD DIV NO | STATE | PROJECT NO. | SHEET NO. | TOTAL SHEETS |
|---|---|---|---|---|
| 7 | ARIZ | S273-701 | 1 | 13 |

RIGHT OF WAY MAP NO. D 2 T 407

ALIGNMENT, RIGHT OF WAY, APPROVED IN ACCORDANCE WITH HIGHWAY PLANS.
SHEET 1 THRU 13
DATE 5 Feb 68 ASSISTANT STATE ENGINEER

APPROVED IN ACCORDANCE WITH RESOLUTION DATED: 5 Aug 1966 MINUTES OF THE ARIZONA HIGHWAY COMMISSION R.L.S. NO: 66-61

A.F.E. NO. 18620

**RW/PLANS FILE SET**

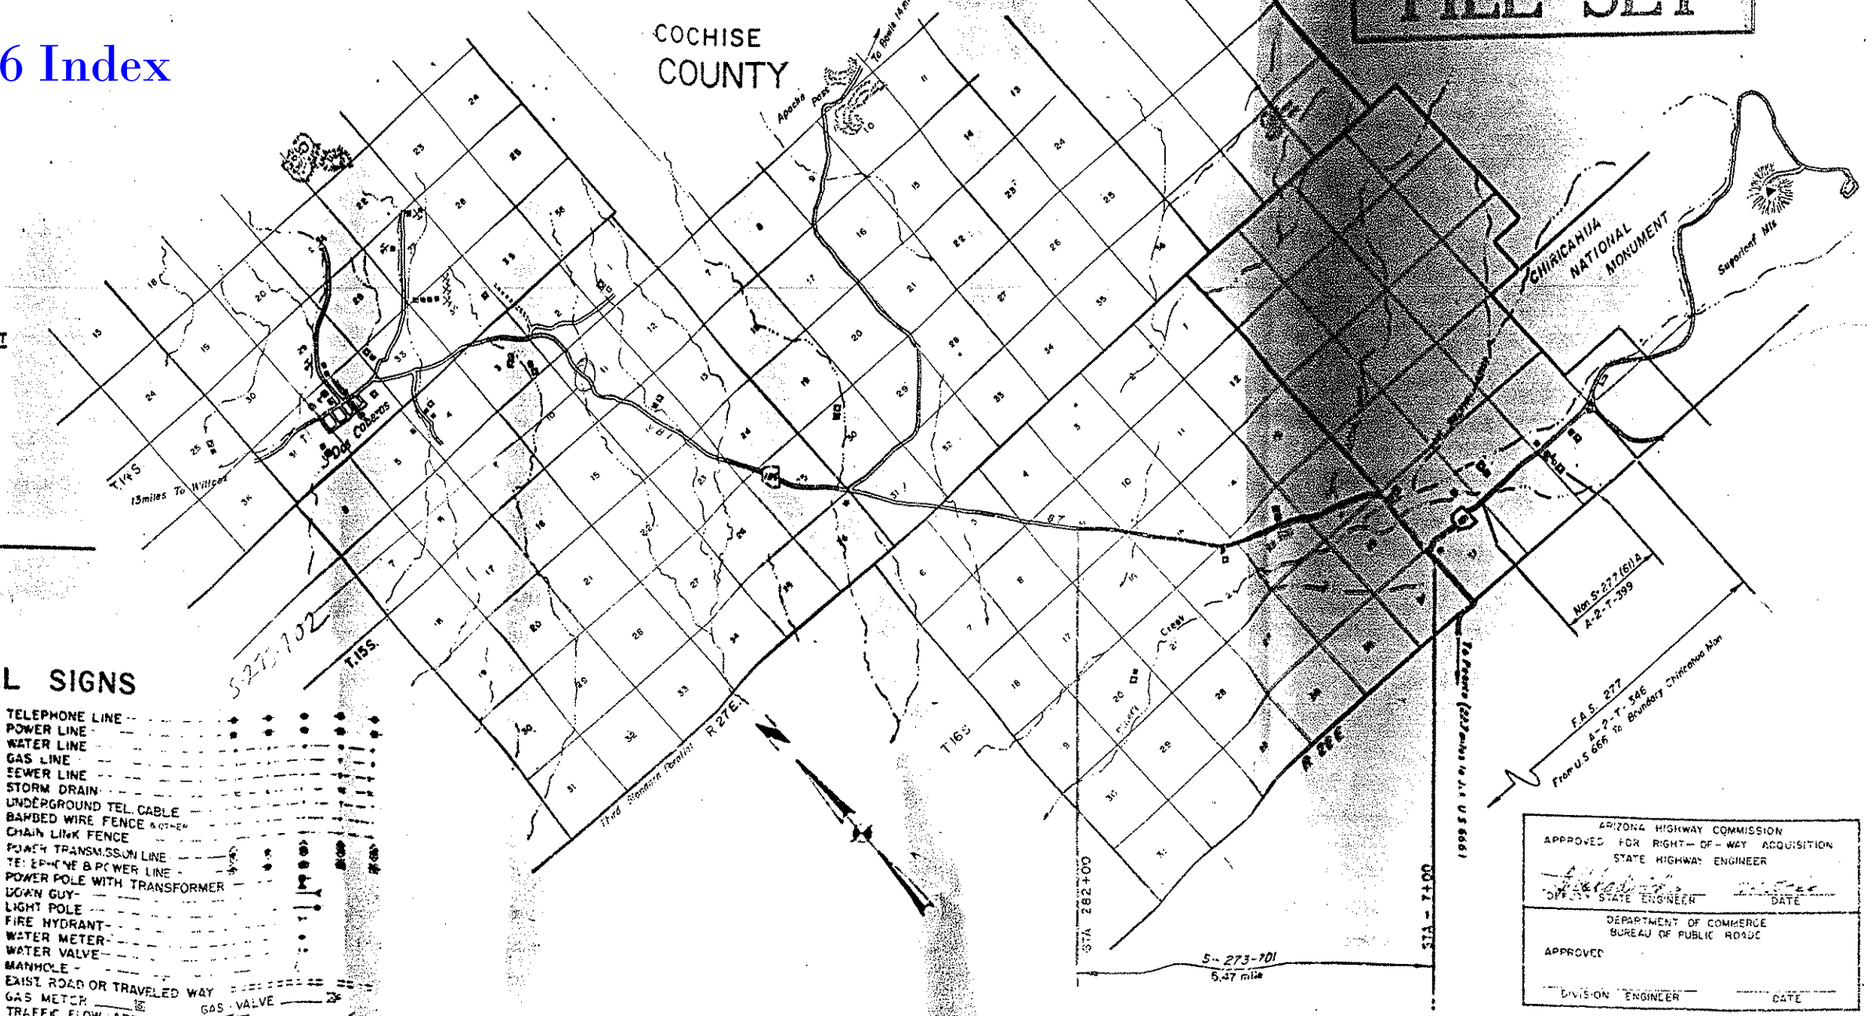


## NOTE:

THE SOLID DOT, AS SHOWN BELOW, DOES **NOT** DESIGNATE A R/W MARKER BUT REPRESENTS AN ANGLE POINT OR CHANGE OF DIRECTION IN THE R/W LINE. IS FOR OFFICE USE ONLY.

## CONVENTIONAL SIGNS

- HIGHWAY CENTER LINES
- STATE AND NATIONAL LINES
- CITY LIMITS
- COUNTY LINE
- TOWNSHIP AND RANGE LINES
- SECTION LINES
- HIGHWAY R/W LINE (NEW)
- RAILROAD R/W LINE
- PROPERTY LINE
- LOT AND PROPERTY LINE (WITHIN EXISTING R/W)
- RAILROAD
- COMMON R.P. AND EXIST HWY R/W
- ACCESS TO BE DENIED
- ACCESS OPEN
- PARCEL ITEM NO's
- FOREST, NAT'L MONUMENTS AND INDIAN BOUNDARIES
- GRANT BOUNDARY
- R/W MARKER (EXISTING)
- HWY R/W LINE (EXISTING)
- LOT OR LOT LINE
- LIMITED ACCESS CONTROLLED R/W

- TELEPHONE LINE
- POWER LINE
- WATER LINE
- GAS LINE
- SEWER LINE
- STORM DRAIN
- UNDERGROUND TEL. CABLE
- BARBED WIRE FENCE
- CHAIN LINK FENCE
- POWER TRANSMISSION LINE
- TELEPHONE & POWER LINE
- POWER POLE WITH TRANSFORMER
- DOWN GUY
- LIGHT POLE
- FIRE HYDRANT
- WATER METER
- WATER VALVE
- MANHOLE
- EXIST. ROAD OR TRAVELED WAY
- GAS METER
- GAS VALVE
- TRAFFIC FLOW ARROW
- PROPERTY CUT ARROW
- PROPERTY ANCHOR SIGN

ARIZONA HIGHWAY COMMISSION
APPROVED FOR RIGHT-OF-WAY ACQUISITION
STATE HIGHWAY ENGINEER

DEPUTY STATE ENGINEER — DATE

DEPARTMENT OF COMMERCE
BUREAU OF PUBLIC ROADS
APPROVED

DIVISION ENGINEER — DATE

WILLCOX - DOS CABEZAS - CHIRICAHUA HWY
JCT. 181 - NORTH
COCHISE COUNTY

Click here for SR 186 Index

| REVISIONS | | | |
|---|---|---|---|
| C.O. No. | DATE | BY | DESCRIPTION |
| 1379 | 12-7-66 | Nowaca | Revised Par.# D-546-1 & D-547-1 |

| | |
|---|---|
| JCT NO. | S-273-701 |
| DRAWING NO. | D-2-7407 |
| SHEET NO. | 2 of 13 |
| DRAWN BY | Nowaca |
| DATE COMP. | 7-21-66 |
| SCALE | |

CHECKED BY. John Stringer

HARD COPY

Robert G. Robotka

# OWNERSHIP RECORD

| PARCEL NUMBER | OWNER | DESCRIPTION | TOTAL AREA | AREA REQUIRED GROSS INCLUDING EXISTING R/W | AREA REQUIRED NET EXCLUDING EXISTING R/W | EASEMENT AREA | REMAINDER LEFT | REMAINDER RIGHT | SHEET NUMBER | DATE ACQ. |
|---|---|---|---|---|---|---|---|---|---|---|
| D-544 | E.L. & Martha Lamberson H&W | All Sec. 10 T 16 S. R. 28 E. | 640 ac. | 0.1 ac. | 0.1 ac | | | 639.9 ac | 12 | 3-8-67 |
| | | All Sec. 15 " " | 640 ac. | 31.8 ac | 21.3 ac | | 253.3 ac | 354.9 ac | 10-11-12 | |
| | | N 1/2 Sec. 23 " " | 320 ac | 20.7 ac | 13.8 ac | | 70.4 ac | 228.9 ac | 8 & 9 | |
| | | NW 1/4 SW 1/4, NE 1/4 SW 1/4 Sec. 24 " " | 80. ac | 11.6 ac | 7.7 ac | 1.0 | 16.2 ac | 51.2 ac | 6 & 7 | |
| D-545 | ~~Emilio T. & Alda D. Berry H&W~~ | N 1/2 N 1/2 Sec. 22 " " | 160. ac | 4.5 ac | 3.3 ac | | 141.1 ac | 14.4 ac | 9&10 | 12-5-67 |
| D-546 | Cora Riggs S & S. | N 1/2 SE 1/4 Sec. 23 (ex. 4 ac) " " | 76. ac | 6.4 ac | 4.3 ac | | 65.5 ac | 4.1 ac | 7 & 8 | 3-29-67 |
| D-546-1 | Cora Riggs S & S. | SE 1/4 SW 1/4 Sec. 24 " " | 40. ac | 1.4 ac | 0.9 ac | 0.6 | ~~38 ac.~~ | | 5 & 6 | 3-29-67 |
| D-547 | Mary E. Riggs Widow | Lot 1 Sec. 3 T. 16 S. R. 29 E. | 36.35 ac | 1.7 ac | 1.3 ac | | | 34.65 ac | 5 | 3-28-67 |
| D-547-1 | Herbert R. & Norma Lee Riggs H&W | SE 1/4 Sec. 13 T. 16 S. R. 28 E. | 160. ac | | | | 160 | | | 3-28-67 |
| | | NW 1/4 SE 1/4, S 1/2 SE 1/4 Sec. 24 " " | 120. ac | ~~12.3 ac.~~ | ~~9.4 ac~~ | | ~~35.2 ac.~~ | 72.3 ac | 5, 6 & 7 | |
| | | NE 1/4 & E 1/2 SE 1/4 Sec. 25 " " | 240. ac | ~~13.8 ac.~~ | ~~9.2 ac~~ | | 225.0 ac | 1.2 ac | 4 & 6 | |
| | | Sec 36 (ex E 1/2 E 1/2 & S 1/2 E 1/2 & ~~250 x 385'~~) " " | 599.6 ac | 1.2 ac | 0.4 ac | | 598.4 ac | | 4 | |
| | | Lot 2 Sec. 30 T. 16 S. R. 29 E. | 36.26 | 2.8 ac | 1.9 ac | | | 33.46 ac | 5 | |
| D-548 | Steve Allen Amalong Single Etal | Lot 3 & 4 Sec. 30 " " | 72.8 ac | .7.4 | 5.0 | | | 65.4 ac | 4 & 5 | 3-22-67 |
| D-769 | Ellarbe & Pera C. Riggs H/W | Sec 9 T. 16 S. R. 28 E | 640 ac | 16.1 | 10.8 | | 63.7 ac | 558.2 ac | 12 & 13 | 3-29-67 |
| | | E 1/2 E 1/2 NE 1/4 Sec 16 " " | 40. ac | 0.8 | 0.4 | | 39.4 ac | | 12 | |

AS BUILT PLANS FILE SET

12-19-66

# WILLCOX-DOS CABEZAS-CHIRICAHUA HWY.
# JCT. 181 - NORTH
# COCHISE COUNTY

| REVISIONS | | | PROJECT NO. | S-273701 |
|---|---|---|---|---|
| DATE | BY | DESCRIPTION | DRAWING NO. | D 27407 |
| | | | SHEET NO. | 3 of 13 |
| | | | DRAWN BY | Kowacz |
| | | | DATE COMP. | 7-21-66 |
| | | | SCALE | 1"=1000' |

HARD COPY 6197 M.F. #2 CHECKED BY, Jack Stevenson

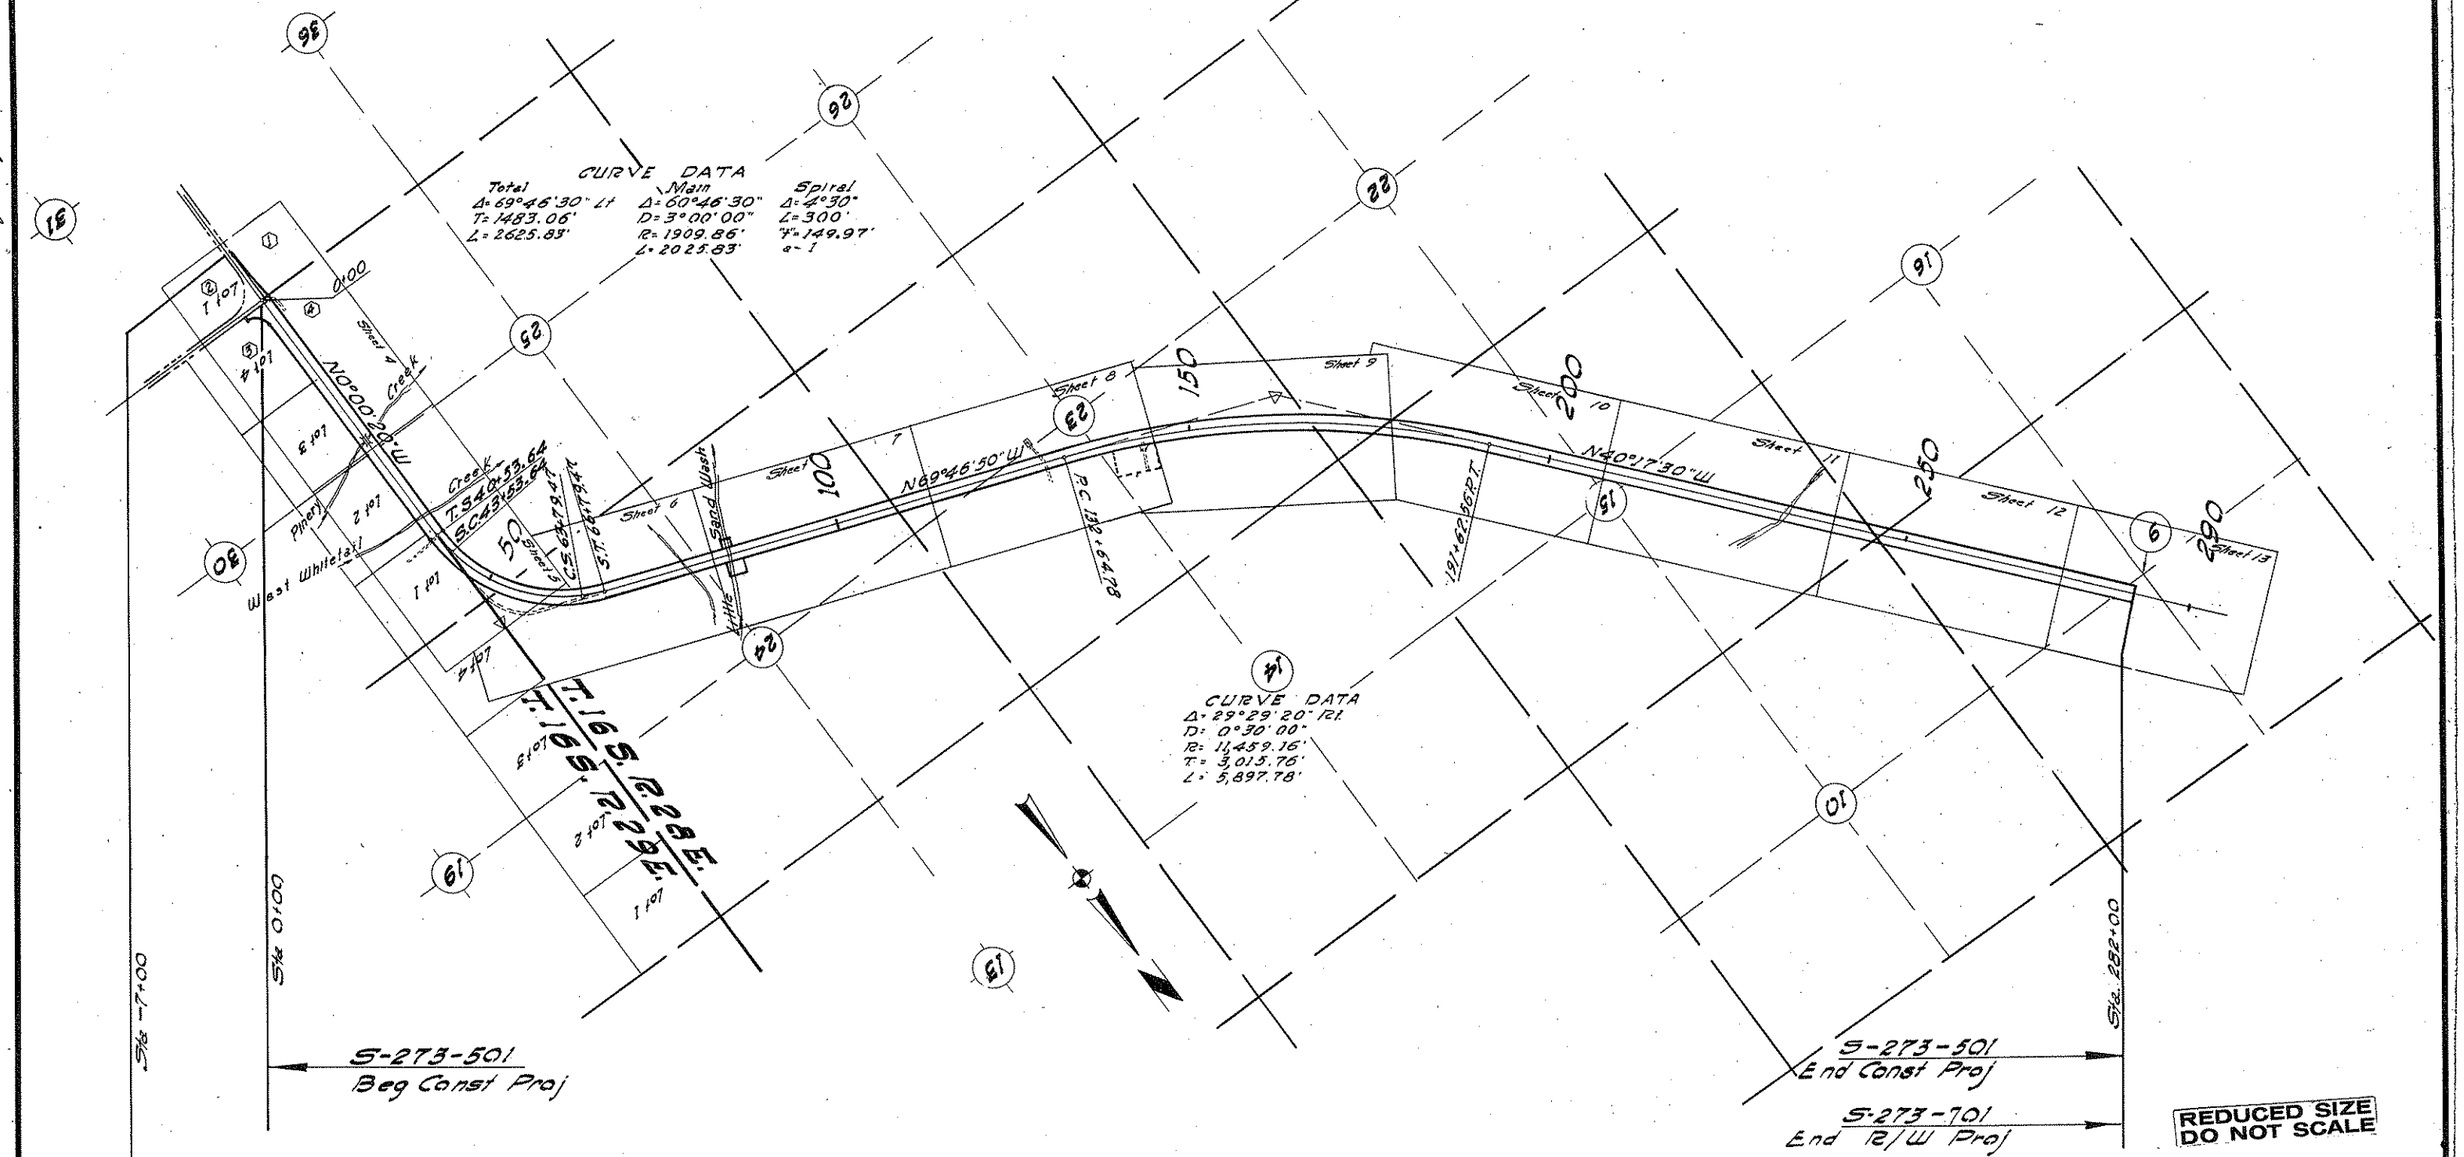


## VICINITY MAP
SCALE 1"=1000'

REDUCED SIZE
DO NOT SCALE

## INDEX TO EXISTING R/W

| INDEX | SUBDIVISION | SEC. | TOWNSHIP | RANGE | ACQ. FROM | TYPE | BOOK | PAGE | WIDTH | YEAR | PARCEL |
|---|---|---|---|---|---|---|---|---|---|---|---|
| (1) | All | 36 | 16 S | 28 E | B.K. Riggs et ux | Ease | 81 | 71-72 | 50' | 1953 | 2997 |
| (2) | Lot 1, E½ NW¼ & E½ NE¼ | 31 | 16 S | 29 E | G. Amalong et ux | Ease | 81 | 73-74 | 50' | 1953 | 2998 |
| (5) | Lot 4, E½ SW¼, SE¼ | 30 | 16 S | 29 E | U. Amalong et ux | Ease | 81 | 75-76 | 50' | 1953 | 2999 |
| (4) | SE¼ SE¼ | 25 | 16 S | 28 E | - No. Record | — | — | — | — | — | — |

In that the R/W for SR 186 was declared as a County Road 7-17-05, Book 6, Page 22&23 it is assumed, that if Alignment is the same, there is 66' of Exist. R/W (33 Each Side of ℄) based on A.R.S. 18-152

Click here for SR 186 Index

DIETZGEN 135 IMPERIAL 400 3-63

WILLCOX-DOS CABEZAS - CHIRICAHUA HWY.
JCT. 181 - NORTH
COCHISE COUNTY

Click here for SR 186 Index

| REVISIONS | | | | |
|---|---|---|---|---|
| DATE | BY | DESCRIPTION | PROJECT NO. | S-273-701 |
| | | | DRAWING NO. | D 2T 407 |
| | | | SHEET NO. | 4 of 13 |
| | | | DRAWN BY | Kowacz |
| | | | DATE COMP. | 7-21-66 |
| | | | SCALE | 1"=100' |

HARD COPY: 6197 M.F. #2 CHECKED BY: John T. Flanagan

1/16 Cor. Found Mound of Stone

T. 16 S. R. 22 E.

Sta 0+05.76
100.00 Ft.

Sec. Cor. Fd. R.R. Spike in Rd.
New Survey Monument &
Cover Sta 0+06.03

Found Mound of Stone
Sec. Cor. 36

New 24" x 48' Pipe Culv.

S 89°53'10"E 2,189.5' to E. Line Sec. 36

Sta 7+00

S 89°58'26"E 695.78'

Exist. R/W

50°08'50"W Hwy. ℄

N 0°00'20"W 693.9'

Sec. Line
N 0°00'20"W
5194.71'

M.P. 61

Ramp "C"

Sta 4+68.14 "B" =
P.C. 0+00 "C"

New 24" x 68' Pipe Culv.

New 2-10'-6" x 7'-0" Box Culv.

CURVE DATA "C"
Δ = 90°05'50"
D = 12°40'
R = 452.34'
T = 453.11'
L = 711.29'

P.T. 7+11.29 "C" =
Sta. 4+68.14 "A"

Lot 1

Sta -7+00

S-273-701
Beg. R/W Proj

Sta 0+00

Approx. Sec Line

Exist. R/W

Exist. R/W

S-273-701
Beg. Constr. Proj

Ramp "B"

N 89°53'20"W 1315.56'

400' x 65' Constr. Easement
New ℄ G.

New C.B.℄ Gate

C.B.℄ 15' Gate
Remove

NEW R/W

Remove Exist. R/W Fence

Remove Exist. R/W Fence

NEW R/W

P.T. 4+98.61 "B" =
Sta. 3+31.83 ℄

P.C. 0+00 "B" =
Sta. 3+38.86 "A" - 93' Rt.

43'

N 0°14'40"E 100' to S. Line Sec. 30

R=240.31' L=376.43'

CURVE DATA "B"
Δ = 89°45'00"
D = 18°00'00"
R = 318.31'
T = 316.92'
L = 498.61'

Lot 4

T. 16 S. R. 22 E.

Approx. 1st Line

Lot 3

New 5 Wire Fence

New 1 Gate

New 5 Wire Fence

New 1 Gate

New 10'-5'-6" Box Culv.

Sta. 24+18.00
New 10'-5'-6" Box Culv.

Remove 15' Gate

Remove 15' Gate

Pinery Creek

North Line

Sheet 5

T. 16 S. R. 22 E.

T. 16 S. R. 23 E.

REDUCED SIZE
DO NOT SCALE

WILLCOX - DOS-CABEZA-CHIRICAHUA HWY.
JCT. 181 - NORTH
COCHISE COUNTY

Click here for SR 186 Index

| REVISIONS | | | PROJECT NO. | S-279-701 |
|---|---|---|---|---|
| DATE | BY | DESCRIPTION | DRAWING NO. | D-27-407 |
| | | | SHEET NO. | 5 of 13 |
| | | | DRAWN BY | Kowacz |
| | | | DATE COMP. | 7-21-66 |
| | | | SCALE | 1"=100' |

HARD COPY 6197 M1 f2 CHECKED BY John Stiffungers

CURVE DATA

| Spiral | Main | Total |
|---|---|---|
| a = 1 | Δ = 60°46'30" Lt. | Δ = 69°46'30" Lt. |
| Δ = 4°30'00" | Di = 5°00'00" | R = 1911.82' |
| L = 300.00' | R = 1909.86' | T = 1483.06' |
| t = 149.97' | L = 2025.83 | L = 2625.83' |
| o = 1.96' | | E = 420.84' |

T.16S. R.22E.

Sec. Line

Approx Mid Sec Line

3-3' Dyke

Sta. 35+59.17 to Sta. 36+88.83
New 4 Span Cont. R.C. Slab Bridge

Creek

Gabeox Mfg Line 2

T.S 40+53.64

S.C. 43+53.64

New 8"x70' C.M.P. Used as conduit.

New 8"x128' C.M.P. Used as conduit.

Water Tank 138' Lt. 45+65.

Line

Match Line

New R/W

New 5 Wire Fence

Remove Exist R/W Fence

N0°00'20"W

Remove Exist. R/W Fence

Remove 15' Field Gate

Remove C.G.

New Gate

15' Field Gate Remove

25' Dirt Rd.

Exist State Hwy. 186

New C.G. & Gate

New R/W

New 5 Wire Fence

Pantry

Creek

Approx Property Line

12% R/W Fence

Match Line

West Whitetail

To B.K.F. Navy Home Ranch 35' Dirt Drive

Match

No Marker Found

Approx Sec. Line

T.16S. R.22E.

REDUCED SIZE
DO NOT SCALE

# WILLCOX - DOS CABEZAS CHIRICAHUA HWY.
# JCT. 181 - NORTH
# COCHISE COUNTY

| REVISIONS | | | |
|---|---|---|---|
| DATE | BY | DESCRIPTION | |
| | | | |

| | |
|---|---|
| PROJECT NO. | S-273-701 |
| DRAWING NO. | D2T407 |
| SHEET NO. | 6 of 13 |
| DRAWN BY | Kowacz |
| DATE COMP. | 7-21-66 |
| SCALE | 1"=100' |

CHECKED BY: John Ellinger

HARD COPY: 6197 MI. & M2

CURVE DATA

| Spiral | Main | Total |
|---|---|---|
| d = 1 | Δ=60°46'30" Lt. | Δ=69°46'30" Lt. |
| Δ = 4°30'00" | D=3°00'00" | R=0+1911.82' |
| L = 300.00' | R=1909.85' | T= 1483.06' |
| T = 149.97' | L=2025.83' | L= 2623.83' |
| O=1.96' | | E=420.84' |

Approx Sec. Line

Approx Mid Sec. Line

Approx 1/16 Line

Match Line

22' Dirt Rd.

Exist State Hwy. 186

No Marker Found

C.S. 63+79.47

S.T. 66+79.47

New 3 Wire Fence

New R/W

M.P. 358

Exist R/W Fence

27' Dirt Rd.

Exist. 27' Dirt Road

N89°46'30"W

15' Gate Remove

Dirt Tank

New #2 Gate

STA. 75+00

New 48"x80' Pipe Culv.

New 48"x68' P.C. Sta 72+32

Match

1/4 Cor. Found Mound of Stone

T.16S. R.28E.

NE 1/4 NE 1/4

SE 1/4 SE 1/4

SW 1/4 SE 1/4

NW 1/4 SE 1/4

Click here for SR 186 Index

REDUCED SIZE
DO NOT SCALE

# WILLCOX-DOS CABEZAS-CHIRICAHUA HWY.
# JCT. 181 - NORTH
# COCHISE COUNTY

| REVISIONS | | | | |
|---|---|---|---|---|
| DATE | BY | DESCRIPTION | PROJECT NO. | S-273-701 |
| | | | DRAWING NO. | D2T407 |
| | | | SHEET NO. | 7 of 13 |
| | | | DRAWN BY | Kowacz |
| | | | DATE COMP. | 7-21-66 |
| | | | SCALE | 1" = 100' |

HARD COPY 6917 M/ ft 2. CHECKED BY. John Stephens

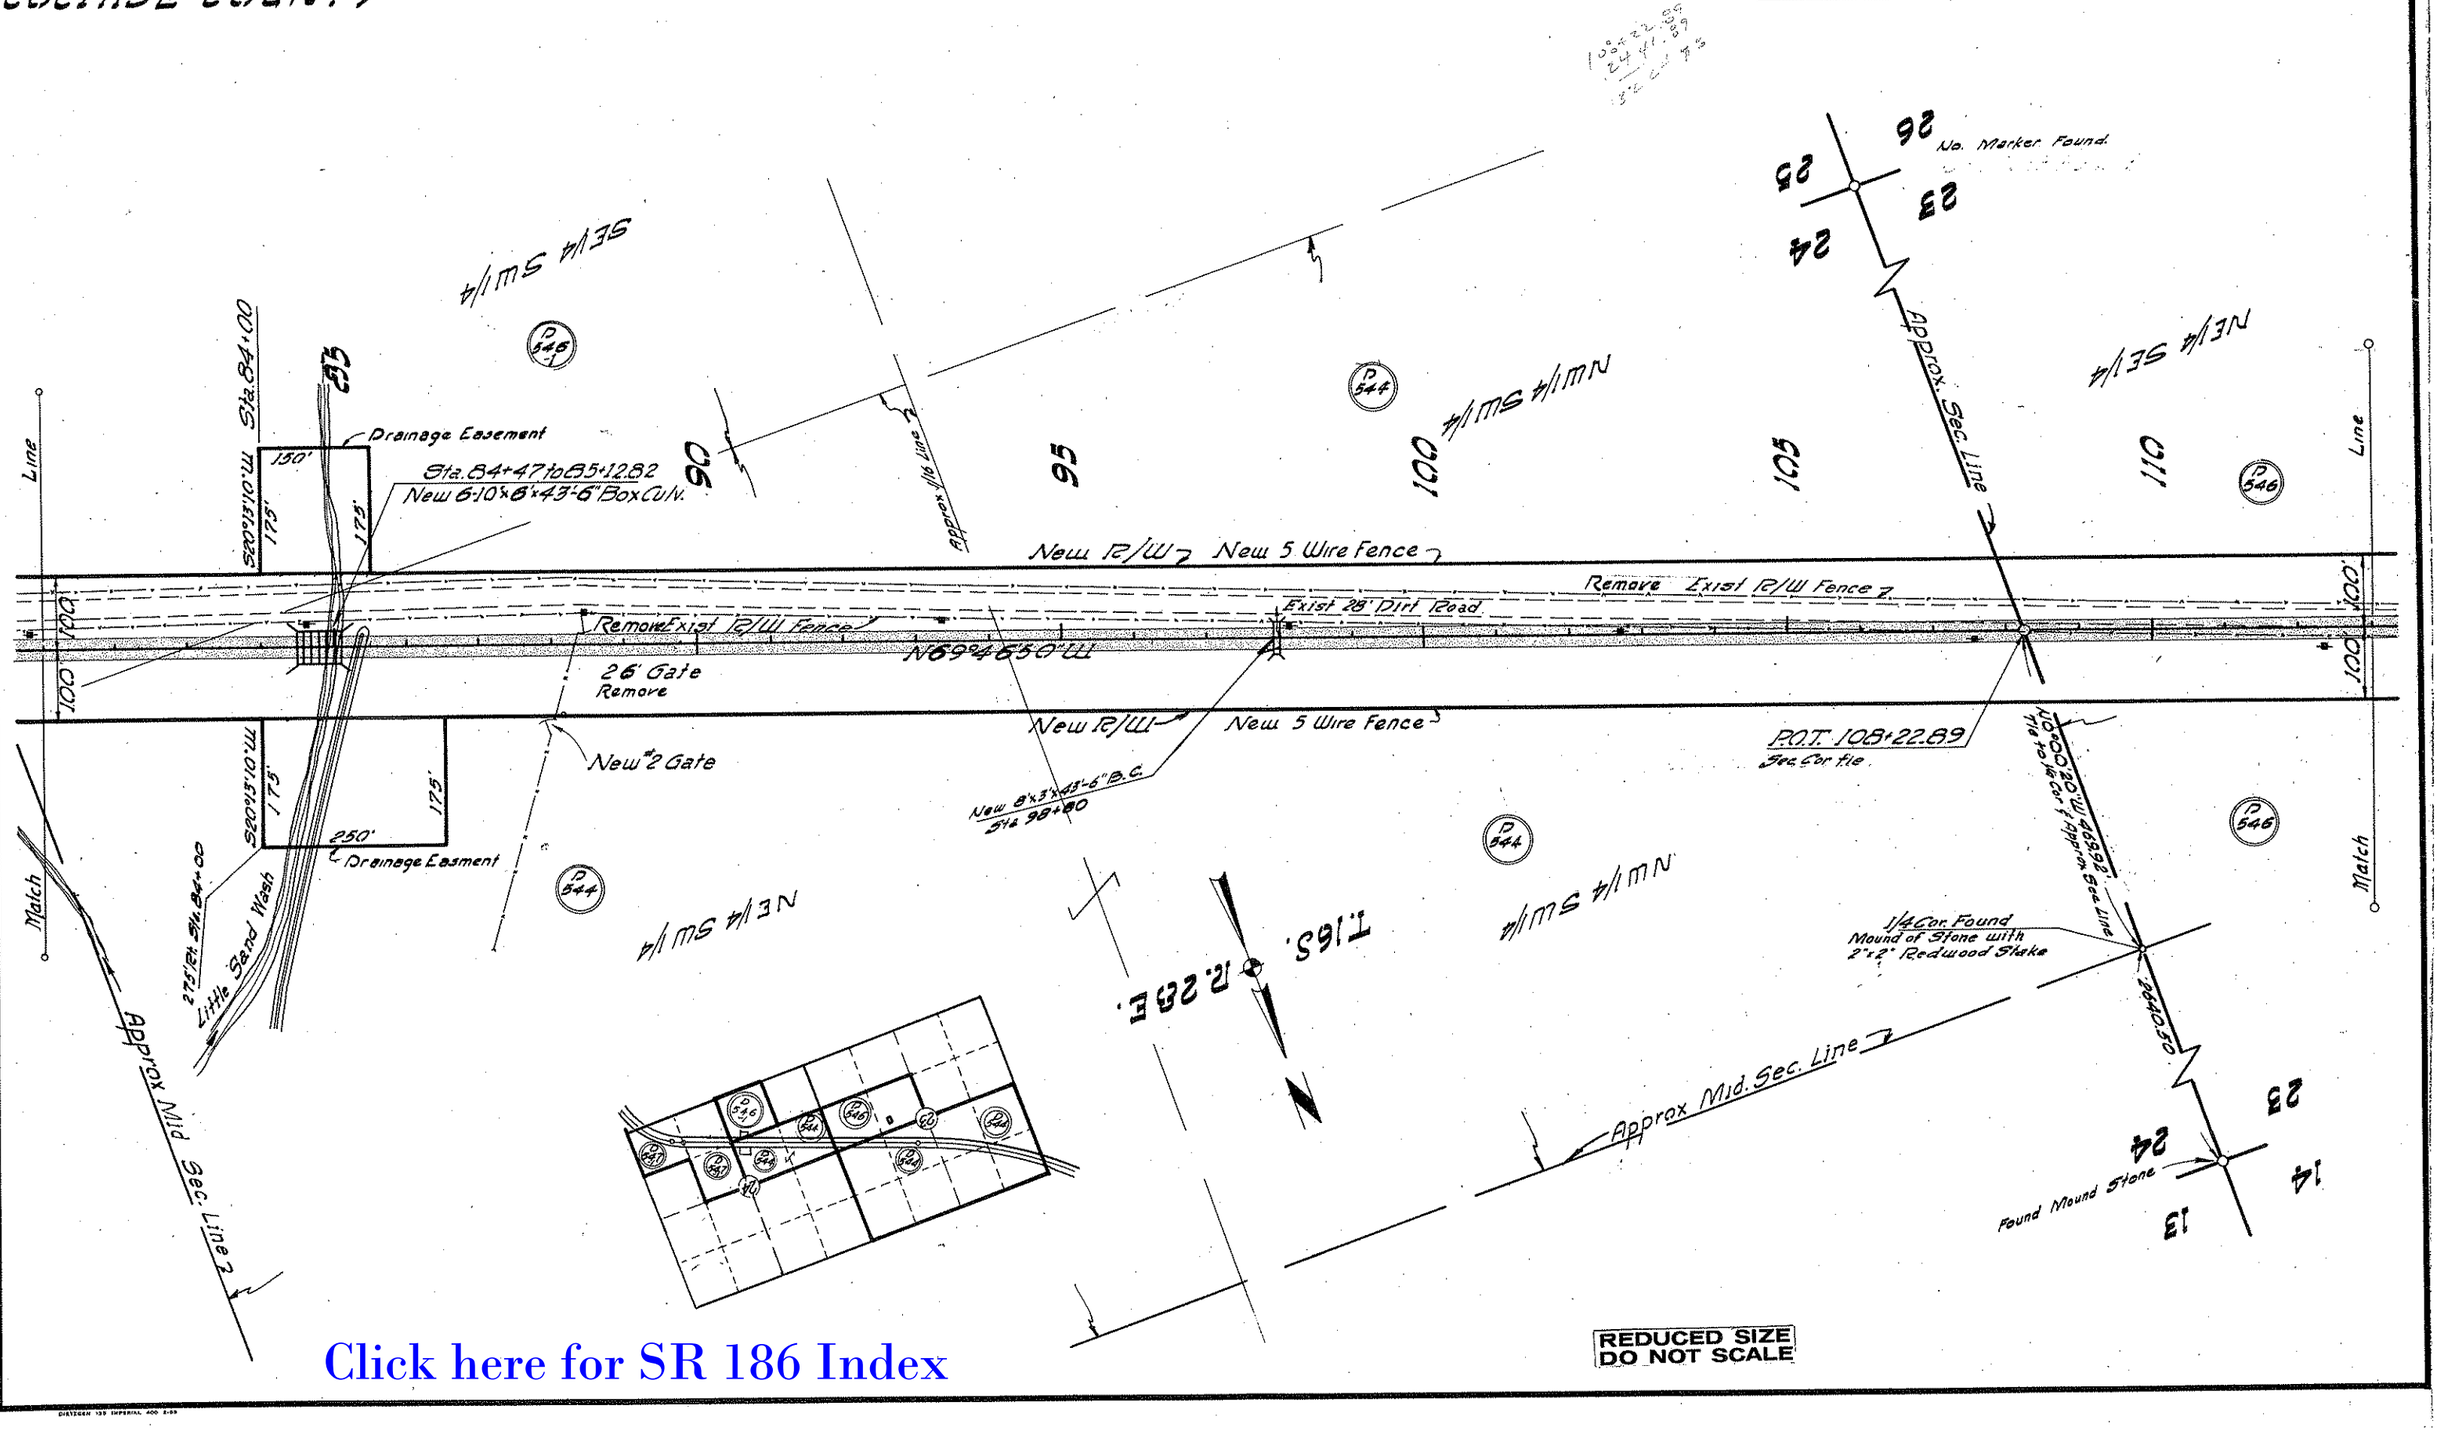


Click here for SR 186 Index

REDUCED SIZE
DO NOT SCALE

# WILLCOX-DOS CABEZAS-CHIRICAHUA HWY.
# JCT. 181 -NORTH
# COCHISE COUNTY

| REVISIONS | | | |
|---|---|---|---|
| DATE | BY | DESCRIPTION | |
| | | | PROJECT NO. S-273-701 |
| | | | DRAWING NO. D2T407 |
| | | | SHEET NO. 8 of 13 |
| | | | DRAWN BY Howacz |
| | | | DATE COMP. 7-21-66 |
| | | | SCALE 1"=100' |

HARD COPY 6197 NR LINE 2 CHECKED BY John Stephens

Approx 1/16 Line

NE 1/4 SE 1/4

NW 1/4 SE 1/4

Approx Mid. Sec. Line

SE 1/4 NW 1/4

Cemetery

12' Dirt Rd.

New R/W & New 5 Wire Fence

New #2 Gate

M.P. # 357
Sta. 125+97.0

Remove C.G.

Exist 27' Dirt Road

N69°46'50"W

Sta. 117+00
New 6'x3'x43'-6" Box Cul v.

New R/W & New 5 Wire Fence

Rf Sta. 126+78
New 29"x18"x26 C.M.P. Arch

Cattle Guard in Pl. to Remain

To Lamberson Ranch
12' Dirt Road

15' Wire Mesh Gate Remain

15' Gates Remove

Remove Exist R/W Fence

Exist. R/W Fence Remove Inside R/W

132'+64.79 P.C.

Sta 137+89.0 to 138+11.5
New 2-10'x8'x49'-0" Box Cul v.

New C.G., w/ Gate

Approx. Mid. Sec. Line

New 16'x700' Grader Pit

500' Rt. Sta 139+00

700'x400' Temp Constr Easement

Match

Match

Line

Line

100'

100'

100'

100'

100'

100'

C21

C21

C21

C21

115

135

145

T. 16S. R. 28E.

SW 1/4 NE 1/4

SE 1/4 NE 1/4

CURVE DATA
Δ = 29°29'20" Rt.
D = 0°30'00"
R = 11,459.16'
T = 3,015.76'
L = 5,897.78'
E = 390.19'

Click here for SR 186 Index

REDUCED SIZE
DO NOT SCALE

DIETZGEN 128 IMPERIAL 400 3-62

# WILLCOX - DOS CABEZAS CHIRICAHUA HWY.
# JCT. 181 - NORTH
# COCHISE COUNTY

| REVISIONS | | | |
|---|---|---|---|
| DATE | BY | DESCRIPTION | |
| | | | |

| | |
|---|---|
| PROJECT NO. | S-273-701 |
| DRAWING NO. | D2T407 |
| SHEET NO. | 9 of 13 |
| DRAWN BY | Howell |
| DATE COMP. | 7-21-66 |
| SCALE | 1"=100' |

HARD COPY 6197 M.1.f.2 CHECKED BY John Stephens

No Marker Found

27 26 22 23

N1/4 NW1/4 Sec. 35

S1/4 N1/4 Sec. 26

NE1/4 NE1/4 Sec. 27

New 6'-5"x62'-0" Box Culv. Sta. 154+68

New 2-36"x76' Pipe Culv. Sta. 170+50

New 12' Gate

New 12' Gate

15' Field Gate, Remove 4/in R/W, Remove Exist R/W Fence

4/in R/W, Remove Exist R/W Fence

Remove 12' Field Gate

100'

100'

Line

Line

30' Dirt Rd.

State Hwy 186

15' Wire Mesh Gate, & C.G. to Remain.

145

150

155

160

165

170

175

Approx 1/16 Line

Approx Sec. Line

Match

500' Rt. Sta. 146+00

400'x700' Temp Constr. Easement

E.U. Lumberyard

T. 16 S., R. 28 E.

NE1/4 NW1/4

NW1/4 NW1/4

CURVE DATA
Δ = 29°29'20" Rt.
D = 0°30'00"
R = 11,459.16'
T = 3015.76'
L = 5897.78'

Tie to Sec. Cor. & Approx. Sec. Line, S89°58'30"E 5290.90' to P.O.S.T.

Found Mound of Stone & Steel Post.

176+69.50 P.O.C. Approx Sec. Line

5290.90'
S89°58'30"E

23 24 14 13

Found Mound of Stone

REDUCED SIZE
DO NOT SCALE

Click here for SR 186 Index

DIETZGEN 139 IMPERIAL 400 8-65

WILLCOX - DOS-CABEZAS-CHIRICAHUA HWY.
JCT. 181 - NORTH
COCHISE COUNTY

| REVISIONS | | | | |
|---|---|---|---|---|
| DATE | BY | DESCRIPTION | PROJECT NO. | S-273-701 |
| | | | DRAWING NO. | D 2T407 |
| | | | SHEET NO. | 10 of 13 |
| | | | DRAWN BY | Howacz |
| | | | DATE COMP. | 7-21-66 |
| | | | SCALE | 1"=100' |

CHECKED BY: John Stevenson

HARD COPY 6197 M 142

22 15 21 — 1/4 Cor. Not Found

Approx. Sec. Line

SW 1/4 SE 1/4

NW 1/4

T. 16 S., R. 23 E.

NE 1/4 SW 1/4

NE 1/4

Approx. 1/16 Line

Approx. Mid Sec. Line

1609.40 P.O.S.T. And P.I.

Mile Post #350
178 M. Sta. 179+90

New #2 Gate

New 5 Wire Fence

Remove Exist. R/W Fence

Exist. 27' Dirt Road

N 40°17'30" W

100'

Remove Exist R/W Fence

New 5 Wire Fence

Approx 1/16 Line

Approx 1/16 Line

New 2-8'x4'x43'-6" Box Culv.
Sta 202+00

191+62.56 P.T.

176+69.50 P.O.C.
Sec. Line Approx.

S 76.21
S 59°58'30" E

Fd. Mound of Stone & Steel Post

Match

Match

180 185 190 195 200 205

SE 1/4 SE 1/4

NW 1/4 SE 1/4

D 545 D 544 D 544 D 544 D 544

CURVE DATA
Δ = 29°29'20" Rt.
D = 0°30'00"
R = 11,459.16'
T = 3,015.76'
L = 5,897.78'

Click here for SR 186 Index

REDUCED SIZE
DO NOT SCALE

DIETZGEN 139 IMPERIAL 400 3-63

# WILLCOX-DOS CABEZAS-CHIRICAHUA HWY.
# JCT. 181 - NORTH
# COCHISE COUNTY

| REVISIONS | | | |
|---|---|---|---|
| DATE | BY | DESCRIPTION | |
| | | | |

| | |
|---|---|
| PROJECT NO. | S-273-701 |
| DRAWING NO. | D2T407 |
| SHEET NO. | 11 of 13 |
| DRAWN BY | Kowacz |
| DATE COMP. | 7-21-66 |
| SCALE | 1"=100' |

CHECKED BY: John S. Thompson

HARD COPY 6197 M.I. 12

Line

210

SW 1/4 NE 1/4

215

Approx Mid Sec. Line

220

225

S. 16° E. 2,382'

NW 1/4 NW 1/4

230

235

240

Line

New C.G. with Gate

Cattle Guard in Place Remove

New 5 Wire Fence

Exist. 27' Dirt Rd

Remove Exist R/W Fence

N 40°17'30" W

Remove Exist R/W Fence

Remove 12' Gates

New #2 Gate

New 5 Wire Fence

Remove Exist 31.6' Timber Bridge
New 3-10'x10'x30'-6" Box Culv.
Sta. 232+26 to 232+64.5

Mile Post #355
13.2' Sta 232+03

100'

100'

100'

100'

P 544

Match

Match

NW 1/4 NE 1/4

Approx 1/16 Line

NW 1/4 NW 1/4

REDUCED SIZE
DO NOT SCALE

Click here for SR 186 Index

DIETZGEN 139 IMPERIAL 400 2-69

WILLCOX - DOS-CABEZAS-CHIRICAHUA HWY.
JCT. 181 - NORTH
COCHISE COUNTY

| REVISIONS | | | |
|---|---|---|---|
| DATE | BY | DESCRIPTION | |
| | | | |
| | | | |
| | | | |
| | | | |
| | | | |
| | | | |

| | |
|---|---|
| PROJECT NO. | S-273-701 |
| DRAWING NO. | D2T407 |
| SHEET NO. | 12 of 13 |
| DRAWN BY | Howacz |
| DATE COMP. | 7-21-66 |
| SCALE | 1"=100' |

HARD COPY 619.2 M.L.E.M.P. CHECKED BY: John B. Summers

Fd ¾" Iron Pipe

No Marker Fd.

Approx. Sec. Line

240 Line

245

247+05.39 Sec. Line

New #2 Gate

N1/4 N1/4 N1/4

5209.23'
S89°43'30"E
5288.45'

250

S1/4 S1/4 S1/4

255

260

265

270 Line

Approx. R/G Line

T. 16 S.

R. 28 E.

New 5 Wire Fence

C.G. #5 Field Gate, Remove

Exist. R/W Fence, Remove

N40°17'30"W

26' Field Gate, Remove.

25' Field Gate, Remove

Exist R/W Fence, Remove

100'

100'

New #2 Gate

New 5 Wire Fence

Exist 10'x7'x24' Box Culv., Remove.
New 8'x7'x48' Box Culv.
Sta 257+30

Found Mound of Stone & #2 Redwood Stake

Approx. Sec. Line

N1/4 N1/4 N1/4

S1/4 S1/4 S1/4

Approx. Sec. Line

Approx. R/G Line

Match

Match

Click here for SR 186 Index

REDUCED SIZE
DO NOT SCALE

WILLCOX - DOS CABEZAS - CHIRICAHUA HWY.
JCT. 181 - NORTH
COCHISE COUNTY

| REVISIONS | | | | |
|---|---|---|---|---|
| DATE | BY | DESCRIPTION | PROJECT NO. | S-273-701 |
| | | | DRAWING NO. | D-2-T-407 |
| | | | SHEET NO. | 13 of 15 |
| | | | DRAWN BY | Howacz |
| | | | DATE COMP. | 7-21-66 |
| | | | SCALE | 1"=100' |

Click here for SR 186 Index

HARD COPY 6197 M.L.&M.2 CHECKED BY John Thompson

T.16S., R.28E.

NE1/4 SE1/4

SE1/4 NW1/4

SW1/4 NE1/4

Approx. Mid. Sec. Line

275 270 265 290 295 300

D 769

6

225' Lt. Sta. 285+82.
Mile Post 154

N40°17'30"W

Exist. R/W Fence

New 5 Wire Fence

Exist. R/W Fence Remove

New 5 Wire Fence

New 2-8'x5'x47'-6" Box. Culv.
Sta 277+00

Line

Match

100'

100'

STA. 282+00

S-273-501
END CONSTR. PROJ.

S-273-701
END R/W PROJ.

REDUCED SIZE
DO NOT SCALE

DIETZGEN 139 IMPERIAL 400 5-63