F-053-2 (MISC.)

# PAYSON - SHOW LOW HWY.
## PAYSON - MOGOLLON RIM SEC.
## GILA COUNTY

| REVISIONS | | | | | |
|---|---|---|---|---|---|
| C.O. No. | DATE | BY | DESCRIPTION | PROJECT NO. | F-053-2 (MISC.) |
| 5934 | 1-28-81 | M.R.R. | ADD OWNERSHIP REC. BLOCK, ADD PAR. NO. 4-230, PARCEL INSERT & RECORD EASEMENTS | DRAWING NO. | D-4-T-364 |
| | | | | SHEET NO. | 1 OF 1 |
| | | | | DRAWN BY | J.F.R. (LOCATION) |
| | | | | DATE COMP. | 6-3-80 |
| | | | | SCALE : | 1" = 100' |

Click here for SR 260 Index

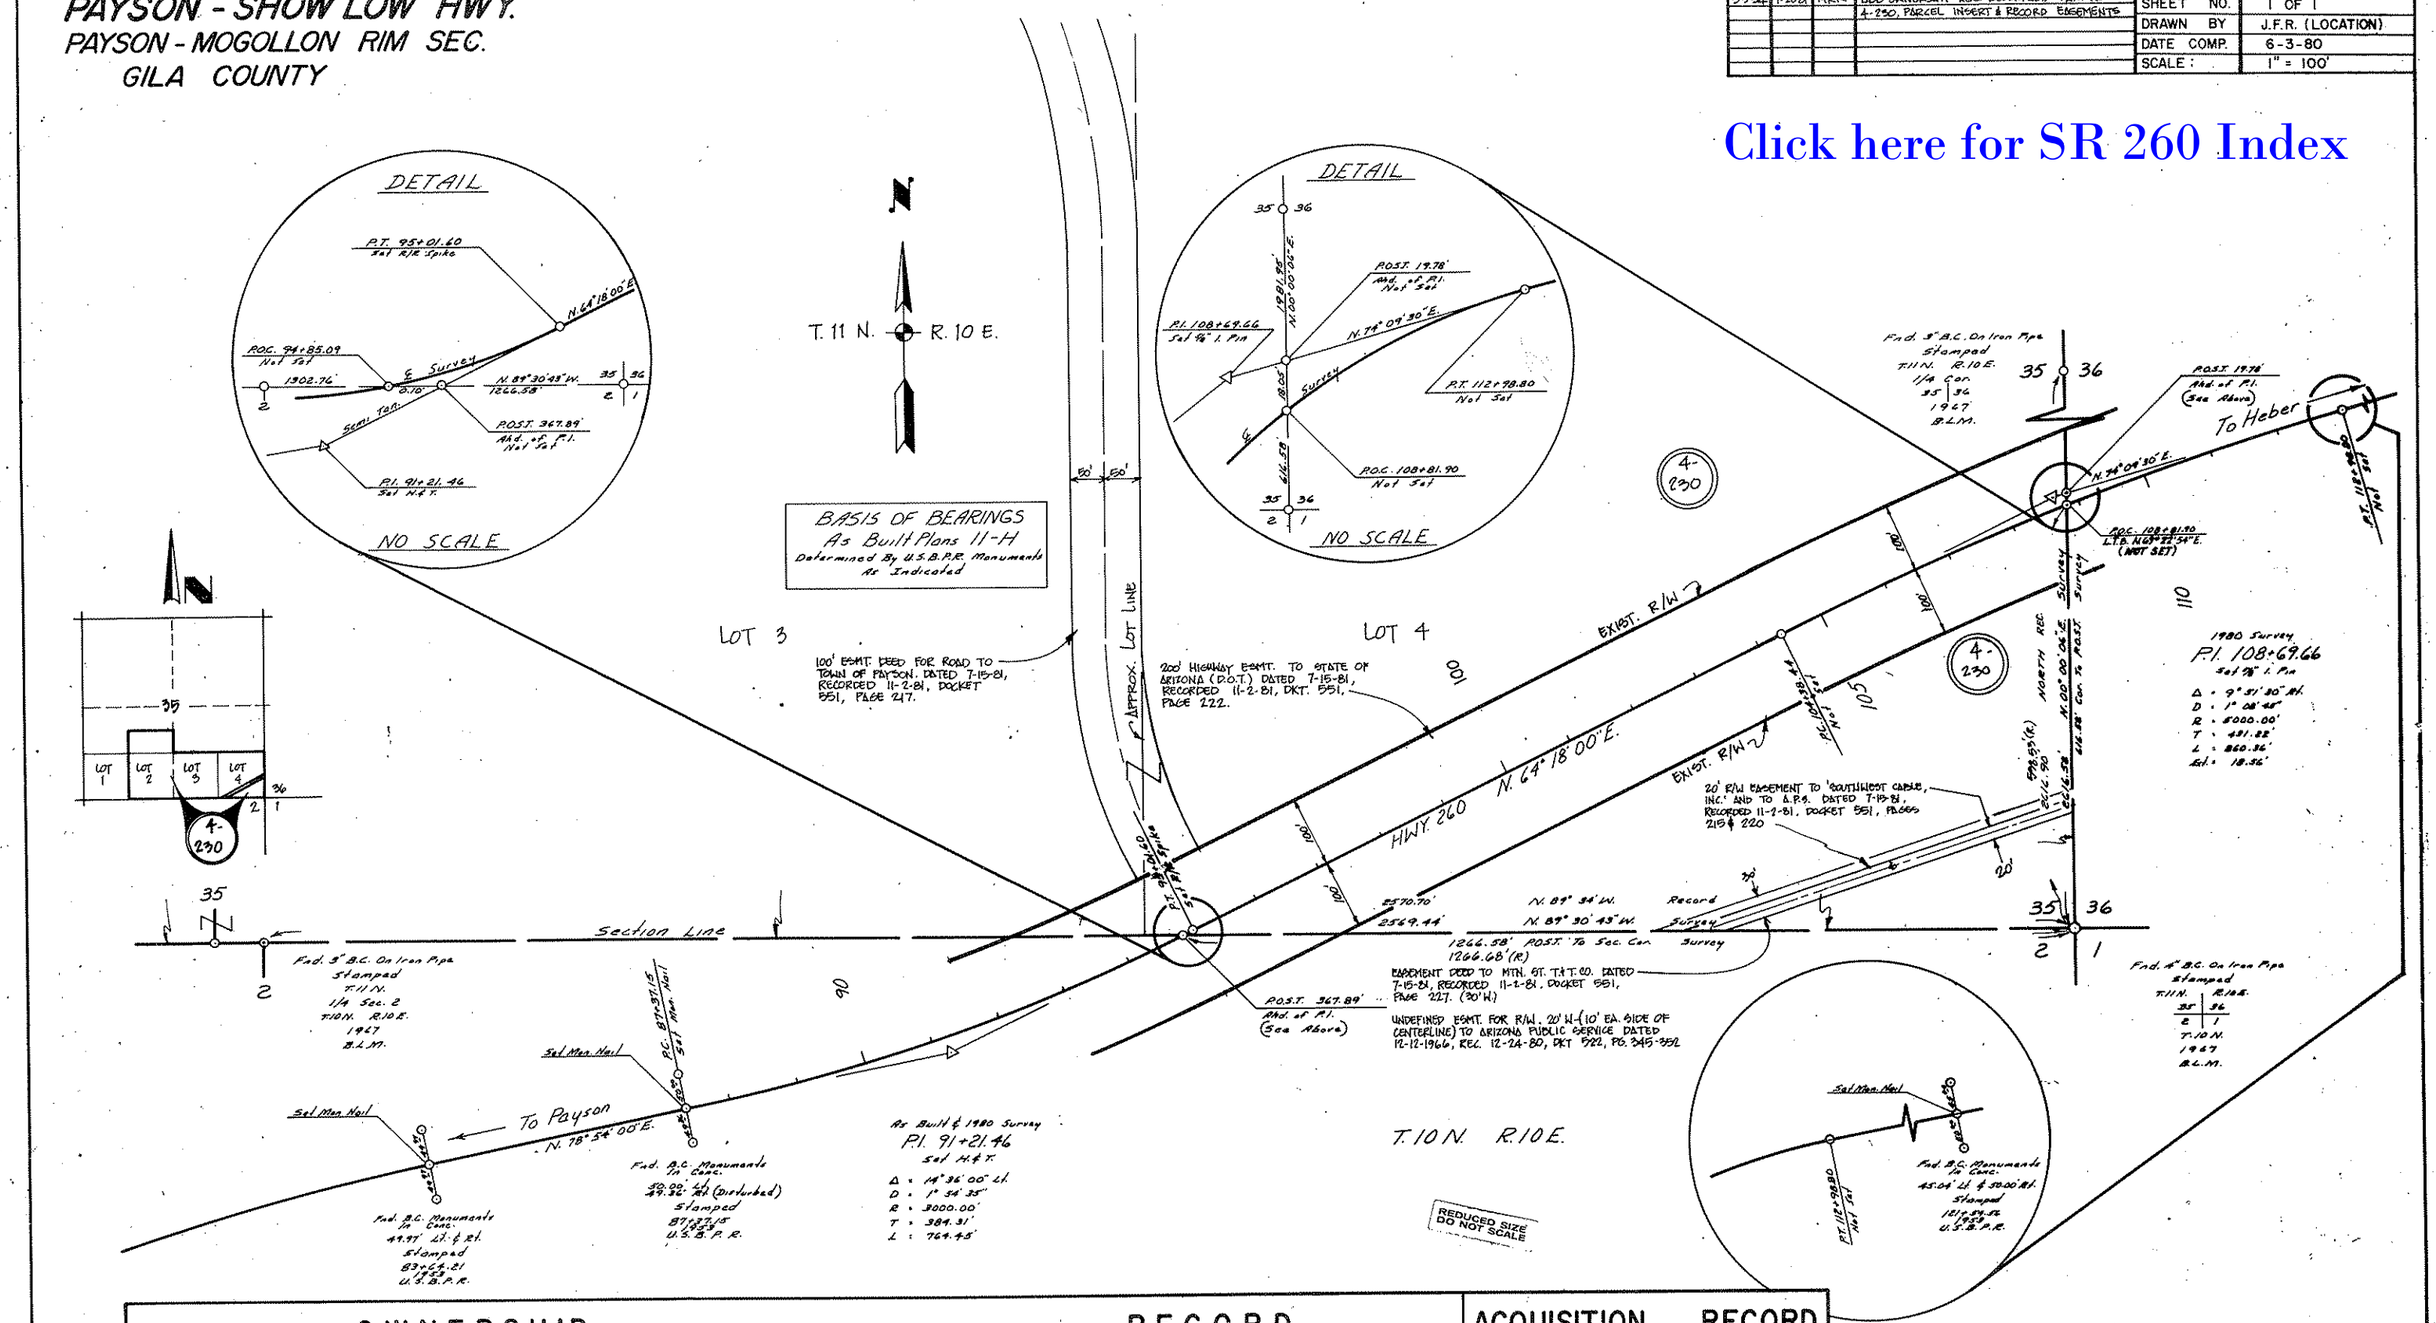


| OWNERSHIP RECORD | | | | | | | | | | ACQUISITION RECORD | | | | |
|---|---|---|---|---|---|---|---|---|---|---|---|---|---|---|
| PARCEL NUMBER | OWNER | DESCRIPTION | TOTAL AREA | AREA REQUIRED: GROSS INCLUDING EXIST. R/W | AREA REQUIRED: NET EXCLUDING EXIST. R/W | EASEMENT AREA | REMAINDER: LEFT | REMAINDER: RIGHT | SHEET NUMBER | BOARD APPROVAL | TYPE & DATE OF INSTRUMENT | RECORDED: DATE | RECORDED: BOOK | RECORDED: PAGE |
| 4-230 | FIRST AMER. TITLE INS. CO. OF ARIZ. TR. 8801 | PT. LOT 3 & 4 SECTION 35, T.11 N., R.10 E. | 136.79 AC. | 6.43 AC. | | | 125.2 AC. | 5.10 AC. | 1 | 1-15-81 | EASEMENT JULY 15, 1981 | ~~NOV. 2, 1981~~ | ~~551~~ | ~~222~~ 226 |

946-950

7-15-81 556