DISTRICT 5 HDQTRS. (FLAGSTAFF)
COCONINO COUNTY

REVISIONS			
C.O. No.	DATE	BY	DESCRIPTION
5471	11-13-79	P. Todd	Deleted Parcels 3-175 and 3-176.

PROJECT NO.	N-810-602
DRAWING NO.	D-3-T-608
SHEET NO.	1 of 1
DRAWN BY	W. Shirley
DATE COMP.	5-26-77
SCALE	1" = 100'

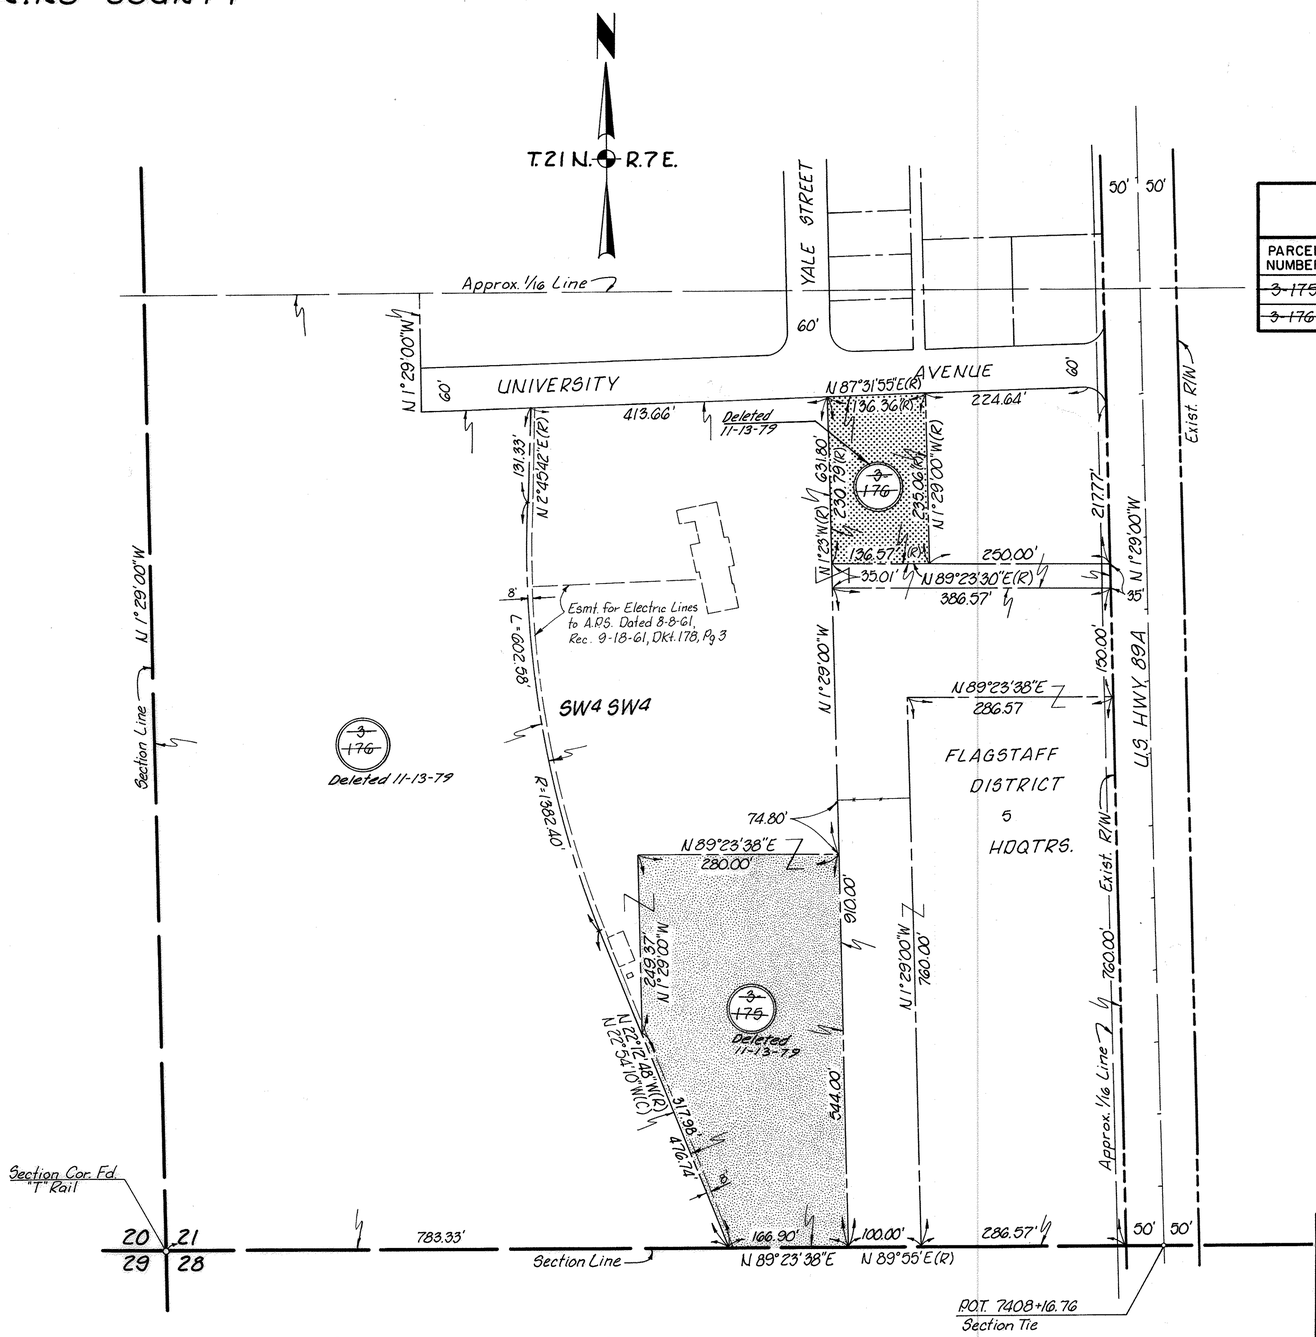

OWNERSHIP RECORD

PARCEL NUMBER	OWNER	DESCRIPTION	TOTAL AREA	AREA REQUIRED GROSS Incl. Exist. R/W	AREA REQUIRED NET Excl. Exist. R/W	ESMT. AREA	REMAINDER LEFT	REMAINDER RIGHT
~~3-175~~	~~Edward M. Fresquez, et ux~~	~~Pt. of SW4 SW4 Sec. 21, T. 21 N., R. 7 E.~~	~~405,752±~~	DELETED 11-13-79			~~269,652±~~	
~~3-176~~	~~Ariz. Lumber & Timber Co., an Az. corp.~~	~~Pt. of SW4 SW4 Sec. 21, T. 21 N., R. 7 E.~~	~~797,444±~~	DELETED 11-13-79			~~765,651±~~	

NOTE: Section Line Information Based on "As-Built" Plans Proj. No. F-103-3(1).

Parcel 3-176 To Be Acquired For Exchange With Parcel 3-175.

Parcel 3-175 To Be Acquired For District 5 Headquarters Expansion.

EXCHANGE DETAIL SHEET

Detail of Parcel 3-176 in Section 21, T. 21 N., R. 7 E., to be Exchanged for Parcel 3-175 in Section 21, T. 21 N., R. 7 E., for Expansion of Flagstaff District 5 Headquarters as requested by E.F. Gentsch on 4-5-77 with subsequent approval by J.B. Mertz.

Approved

For Walter E. Pillett 7-12-77
DEPUTY STATE ENGINEER DATE

ARIZONA DEPARTMENT OF TRANSPORTATION BOARD
Approved for Right of Way Acquisition in accordance with Resolution Number 77-11-A-27 Dated 6-24-77

Oscar T. Lyon, Jr. State Engineer

J.B. Mertz 7-12-77
CHIEF DEPUTY ~~STATE~~ ENGINEER DATE

U.S. DEPARTMENT OF TRANSPORTATION
FEDERAL HIGHWAY ADMINISTRATION

DIVISION ENGINEER DATE

Survey Information By Dist. V
HARD COPY & R/W Proj. No. F-003-3-501
CHECKED BY

BRUNING 44-512

Click here for US 89A Index