Click here for SR 90 Index

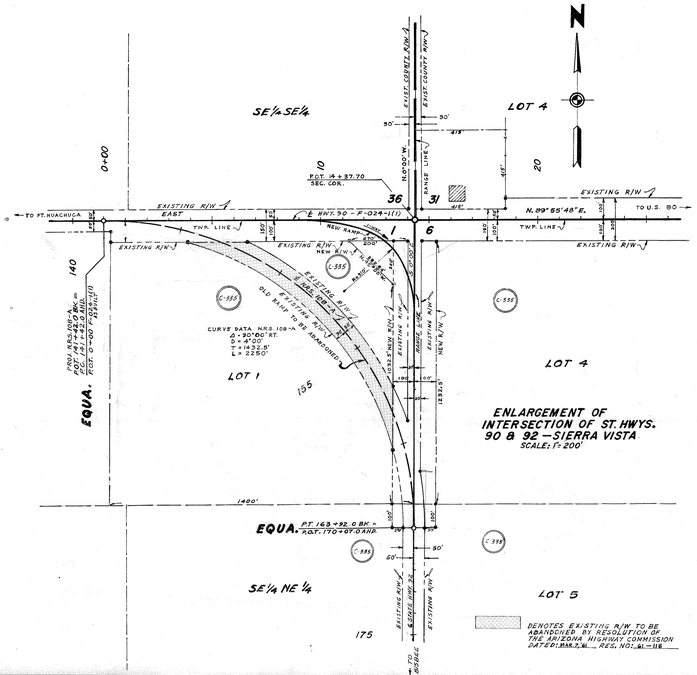

Click here for SR 90 Index

OWNERSHIP RECORD

ITEM NO	OWNER	DESCRIPTION	ACREAGE TOTAL	ACREAGE REMAINING	DATE PURCHASED
C-335	Pres. T/Ile of Trust Co.	Lot 11 SE¼ NE¼ Sec. 1 T.22S. R.20E.	1.52	69.01	
		Lots 4 & 5 Sec. 6 T.22S. R.21E.	1.53	67.59	
		Area to be Abandoned	2.87		

ARIZONA HIGHWAY DEPARTMENT
RIGHT OF WAY DIVISION

RIGHT OF WAY MAP OF
FORT HUACHUCA – BISBEE
STATE HIGHWAY 90 & 92
INTERSECTION OF 90 & 92 SEC.
FEDERAL AID PROJECT F-024-1(11) REVISED
FROM STATION 0+00 TO STATION 70+00
COCHISE COUNTY

ALIGNMENT AND RIGHT OF WAY WIDTHS APPROVED IN ACCORDANCE WITH "AS BUILT" PLANS
DATE 3-2-1961 R. C. Brunson ASSISTANT STATE ENGINEER

APPROVED MAR. 7, 1961 PER RESOLUTION DATED MINUTES OF THE ARIZONA HIGHWAY COMMISSION

SCALE	DRAWN	CHECKED
	G.G.H.	
	1-31-61	
	1"=200'	
	1"=800'	
	NONE	

DRAWING NUMBER C-2-T-380A