PARKER-TOPOCK HIGHWAY
OSBORNE WASH BRIDGE SECTION
YUMA COUNTY

B.I.A. APPLICATION

RW/PLANS FILE SET

Click here for SR 95 Index

REVISIONS			
C.O. No	DATE	BY	DESCRIPTION
2147	2-10-69	E.J.T.	Sheet drawn on this C.O.
2710	9-14-70	B.J.N.	Numerous Changes per Const Plans
2736	10-28-70	W.H.I.	Added Descriptions for Parcels 14-294 & D-987-A
3306	7-7-72	WDS	Added T.C.E.'s left & right Sta. 153+50 Par. 14-294-A
"	"	"	
4364	9-24-75	R.L.R.	As Built Finalization.
4409	12-1-75	R.C.O.	Deleted Par. 14-294-A. Removed T.C.E.'s

PROJECT NO.	S-405-713
DRAWING NO.	D-14-T-348
SHEET NO.	1 of 1
DRAWN BY	E. L. toscano
DATE COMP.	2-21-69
SCALE	1" = 200'

FINALIZED

NOTE: Ex. R/W previously acquired under Project S-405-702, Parcel Nos. D-987 and D-987-A, R/W Map. No. A-14-T-317.

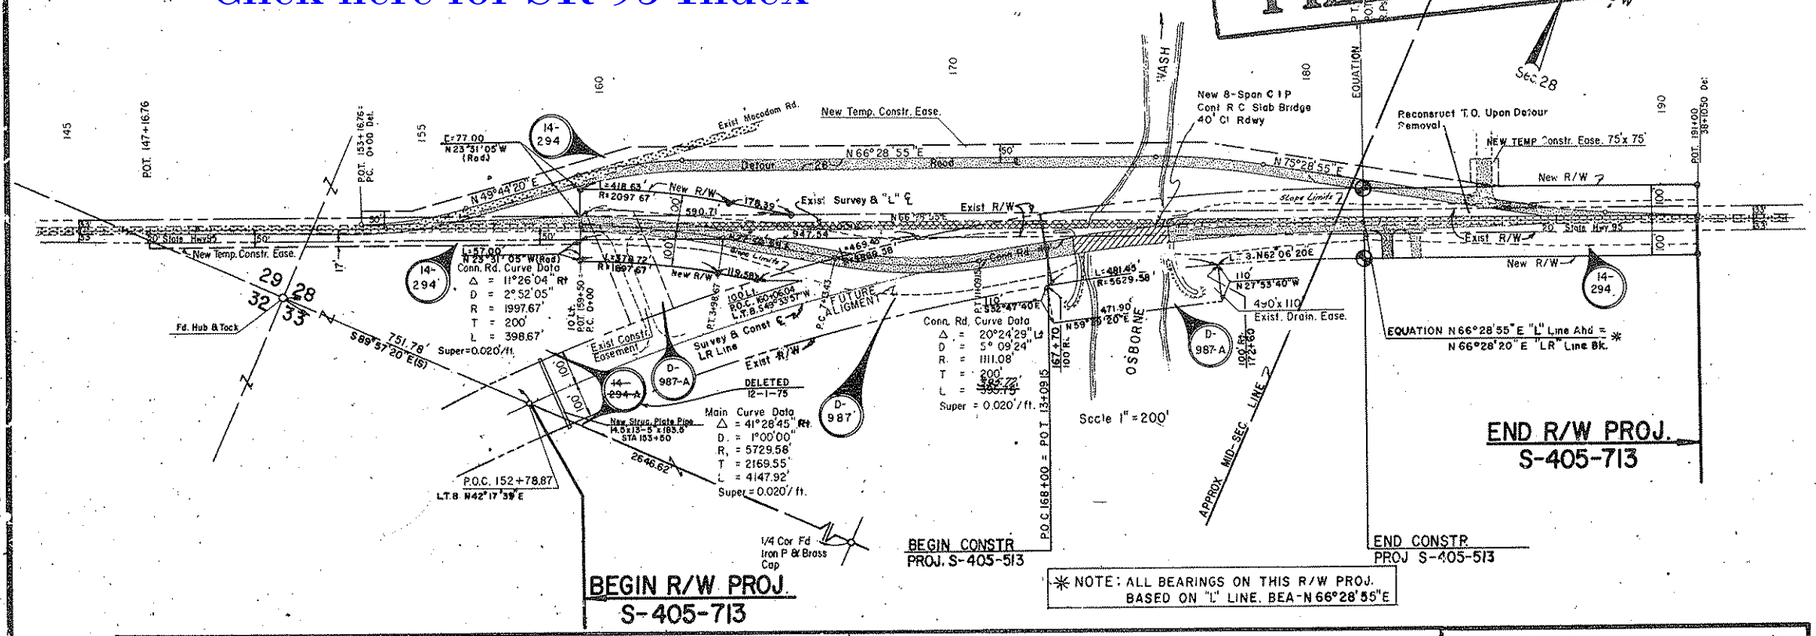

* NOTE: ALL BEARINGS ON THIS R/W PROJ. BASED ON "L" LINE. BEA-N 66°28'55"E

U.S. DEPARTMENT OF INTERIOR
BUREAU OF INDIAN AFFAIRS
Colorado River INDIAN AGENCY OFFICE
Parker, ARIZONA

These plans are hereby approved pursuant to the provisions of the act of February 5, 1948, (62 Stat. 17) and Departmental Regulations 25 CFR 161, subject to any prior valid existing right of adverse claim, and also subject to any and all conditions stated in Resolution No. _____ adopted by the _____ Tribal Council on _____, 19__.

_____ _____
Date

ARIZONA HIGHWAY DEPARTMENT
Parker — Topock HIGHWAY
PROJECT S-405-713
R/W MAP D-14-T-348

Application is hereby made for highway right of way from 152+~~72.87~~ 78.87 to 191+00, as shown hereon.

ARIZONA HIGHWAY DEPARTMENT
4/15/69 — State Highway Engineer
Date

OWNERSHIP RECORD / ACQUISITION RECORD

PARCEL NUMBER	OWNER	DESCRIPTION	TOTAL AREA	AREA REQUIRED: GROSS INCLUDING EXISTING R/W	AREA REQUIRED: NET EXCLUDING EXISTING R/W	EASEMENT AREA	REMAINDER: LEFT	REMAINDER: RIGHT	SHEET NUMBER	COMMISSION APPROVAL	TYPE & DATE OF INSTRUMENT	RECORDED: DATE	RECORDED: BOOK	RECORDED: PAGE
14-294	Colorado River Indian Reservation Agency	Part of Sec 28,29,32, T10N, R19W.	unknown	7.58 Ac	4.96 Ac				1	8-7-1970	Easement Right 1-8-71	~~of Entry~~	~~Only~~	
~~14-294-A~~	~~Colorado River Indian Reservation Agency~~	~~Part of Sec. 28,33 T10N, R19W~~	~~unknown~~		DELETED				1					

ENGINEER'S AFFIDAVIT

STATE OF ARIZONA
COUNTY OF MARICOPA } SS.

A. L. Chadwick being first duly sworn, deposes and states that he is the Deputy State Engineer for the State of Arizona; that the survey of the highway center line was made and that these plans were prepared from field notes of said survey; that the right of way is 0.638 miles in length, beginning at Station 152+~~72.87~~ 78.87 and ending at Station 191+00, and said right of way is accurately delineated on the plan attached.

A. L. Chadwick
Deputy State Engineer

Subscribed and sworn to before me this 15th day of April, 1969.

Arline S. Kozel
Notary Public. My Commission expires Sept. 28, 1971.

APPLICANT'S CERTIFICATE

I, William N. Price, do hereby certify that I am the State Highway Engineer for the State of Arizona, hereinafter designated the applicant; that A. L. Chadwick who subscribed to the foregoing affidavit, is employed by the applicant as Deputy State Engineer and that he was directed by the applicant to survey the location of a highway center line and to prepare these plans; that the location of said center line, 0.638 miles in length beginning at Station 152+~~72.87~~ 78.87 and ending at Station 191+00, is accurately represented on this plan; that such survey as represented on this plan has been adopted by the applicant as the definite location of the highway center line and right of way thereby shown; and that this plan has been prepared to be filed for the approval of the Secretary of the Interior or his duly authorized representative as part of the application for said right of way to be granted the applicant, its successors and assigns, with the right to construct, maintain, and repair improvements, thereon and thereover, for such purposes, and with the further right in the applicant, its successors and assigns, to transfer this right of way by assignment, grant or other act.

4/15/69
Date

State Highway Engineer

RW/PLANS FILE SET

REDUCED SIZE DO NOT SCALE

Approved in accordance with Roadway Plans.
W. L. Thomas 4-18-69
ASSISTANT STATE ENGINEER — DATE

ARIZONA STATE HIGHWAY COMMISSION
Approved for Right of Way Acquisition in accordance with Resolution No. 69-20 dated 3-21-69
WILLIAM N. PRICE — State Highway Engineer

A. L. Chadwick 4-14-69
DEPUTY STATE ENGINEER — DATE

PARCEL NO. 14-294 NAME Colorado River Indian Reservation Agency
Part of Section 28,29,32, T10N, R19W.

CHECKED BY: R.L.E.
HARD COPY 6247 M-1