Click here for SR 77 Index

ITEM	OWNER	DATE ACQUIRED	DESCRIPTION
B-649	Roy F. Verdugo & Helen Verdugo		Lot 2 Blk 7 and Part of Lot 15 Blk 8 Childs Sub.
B-650	Gilberto S. Loaiza & Enrequita Villanuevo Loaiza		East 20' of Lot. 15 Blk 8. Childs Sub.

ITEM NO.	OWNER	ACQUISITION RECORD	DESCRIPTION
B-518	U. S. Land AZ 026230	7-18-60	E½ NW¼ Sec. 7 T8S R17E; SE1/4 SW1/4 SE1/4 Sec. 19 " "
②	Albert J. & Ruth Hetzel	7-18-60	SW¼ SE¼ " " "
B-483	ARIZONA WATER COMPANY	Ease. 286/8 6-27-60	Lot 10, Blk. 5 Mammoth Add. Sec. 19 " "
B-485	NICK GONZALES	Ease. 272/252 6-4-60	Pt. Lot 15, Blk 8 Childs Add. " " "
1439	Annie Lyle Childs, etux	Ease. 142/432 1/13/56	Lot 1, Blk 7; Lot 2, Blk 6 " " " " "
1440	Isaac Lee Cook, etux	" 149/112 3/31/56	Lot 1, Blk 6 " " " " "
1441	Mattie Young	" 144/597 2/3/56	Lot 5, Blk 5 " " " " "
1442	Earl Piper, etux	" 153/30 5/17/56	Lot 1, Blk 3 " " " " "
1436	Lee Eugene Johnson, etux	Deed 153/394 5/29/56	S½ Lot 2, Blk 3 " " " " "
1443	Fred L. Clark, etux	Ease. 142/434 1/13/56	Lot 1, Blk 2 " " " " "
B-486	L. A. & C. B. Peart, etux	W.D. 272/122 6-1-60	Lot 2, Blk 2 " " " " "
1444	Manual Molina, etux	Ease 142/436 1/13/56	N½ Lot 3, Blk 2 " " " " "
1445	Ariz Baptist Convention, a Corp.	" 142/438 1/13/56	S½ Lot 3, Blk 2 " " " " "
B-487 1446	St. Anthony Minning & Devel. Co. Ltd. (Tiger Corp.)	Ease 153/32 5/17/56	W½ NE¼, NE¼ NW¼ " " "
B-488	Hardy H. Wesson, etux.	W.D. 271/223 7-8-60	Tract A Dungan Add. Sec. 18 " "
592A	Charles H. Allen, etux	Ease 174/291 3/30/57	Lot 1 & 2, Blk. 2 " " " " "
1447	Ralph C. Wigley, etux	" 142/440 1/13/56	Lot 3, Blk 2 " " " " "
1448	Tony Banaglio & L.E. Dicus	" 149/144 3/31/56	Lot 15 & 16, Blk 3 " " " " "
B-489	T. C. Kinsey, etux	Ease. 270/234 6-1-60	Lot 17 & 18, Blk 3 " " " " "
B-490 1449	W. E. Hughes, etux	Ease 149/116 3/31/56	Lot 2, Blk 3 " " " " "
5020	Myrtle Branch	" 148/64 3/16/56	Lot 1, Blk 3 " " " " "
5021	Mario & Margaret De Ochoa	" 148/66 3/16/56	Lot 1 & 2 Blk 2 New Mammoth Townsite " " "
B-491	W. H. and V. L. Evans	Ease. 272/245 1-2-60	Lot 5, Blk 2 Dungan Annex Add. " " "
1431	Aldert L & Lillian J. Heck	Deed 160/266 8/23/56	N 1/2 Lot 2 Blk. 3 Childs Add. Sec. 19 " "
B-516	Charles H. & Elizabeth Allen H/W	W.D. 272/247 5-20-60	Lots 1 2 & 5 Dungan Add to Mammoth
B-520	Louis & Carmen Yubeta H/W	Ease 272/250 6-3-60	E 75' of tract "A" " " " "

ITEM NO.	OWNER	ACQUISITION RECORD	DESCRIPTION
1450	John C. Carnighan	Ease 149/118 3/31/56	Lot 5, Blk 6 Dungan Annex Add. Sec. 18 T8S R17E
B-492	P. J. Huerta	Ease 272/567 5-24-60	Lot 1, Blk 2 " " " " " "
1451	Vincent Varquez	Ease 149/120 3/31/56	Lot 4, Blk 6 " " " " " "
1452	James Wood	Ease 149/122 3/31/56	Lot 5, Blk 1 " " " " " "
B-484	Silvano Aceves (single man)	W.D. 272/127 6-3-60	W 100' of the S 140 Lot 15 Blk. 8 Childs Sub
1453	Jose M. Gamez, etux.	Ease 159/372 8/15/56	Lot 1, Blk 1 Dungan Annex Add. Sec. 18 T. 8 S. R. 17 E.
1454	Frances L. Jacobson	" 149/124 3/31/56	Part of N½ N½ SW¼ " " "
B-519	Arthur H. Dungan	" 149/126 3/31/56	Part of NW¼ NE¼ SW¼ " " "
1456	San Manuel Copper Co.	" 139/163 12/3/55	E½ SW¼ - SW¼ SE¼ Sec. 7 T8S - R17E; E½ NW¼ Sec. 18 T8S - R17E
.	~~Dave Miller, etux~~	Not Required	NW¼ NW¼ Lot 1 Sec. 7 T8S - R-17E; SW¼ SW¼ Sec. 6 T8S - R-17E; SE¼ SE¼ Sec. 1 T8S - R-16E
.	~~E.S. Mauldin etux~~	Not Required	S½ NE¼, NE¼ SE¼ Sec. 1 T8S - R-16E
1457	State	Permit 11/23/55	NW¼ SE¼ Sec. 7 T8S - R-17E
1433	Eliodoro & Celia Romo	Ease 157/587 7/20/56	S1/2 Lot 3 Blk. 2 Dungan Annex. Add.
1434	Carlos & Natividad Montano	" 157/585 7/20/56	N1/2 " " " " " " "
1435	Rafael C. & Rosario M. Herrera	" 157/583 7/20/56	Pt. Lot 4 Blk. 1 " " "
1437	Angel B. & Celia S. Campa	Deed 153/200 5/23/56	Pt. " " " " " " "
B-517	Pauline Pinson	D&D 274/477 6-24-60	Lot 4 Blk 2 Dungan Add. to Mammoth

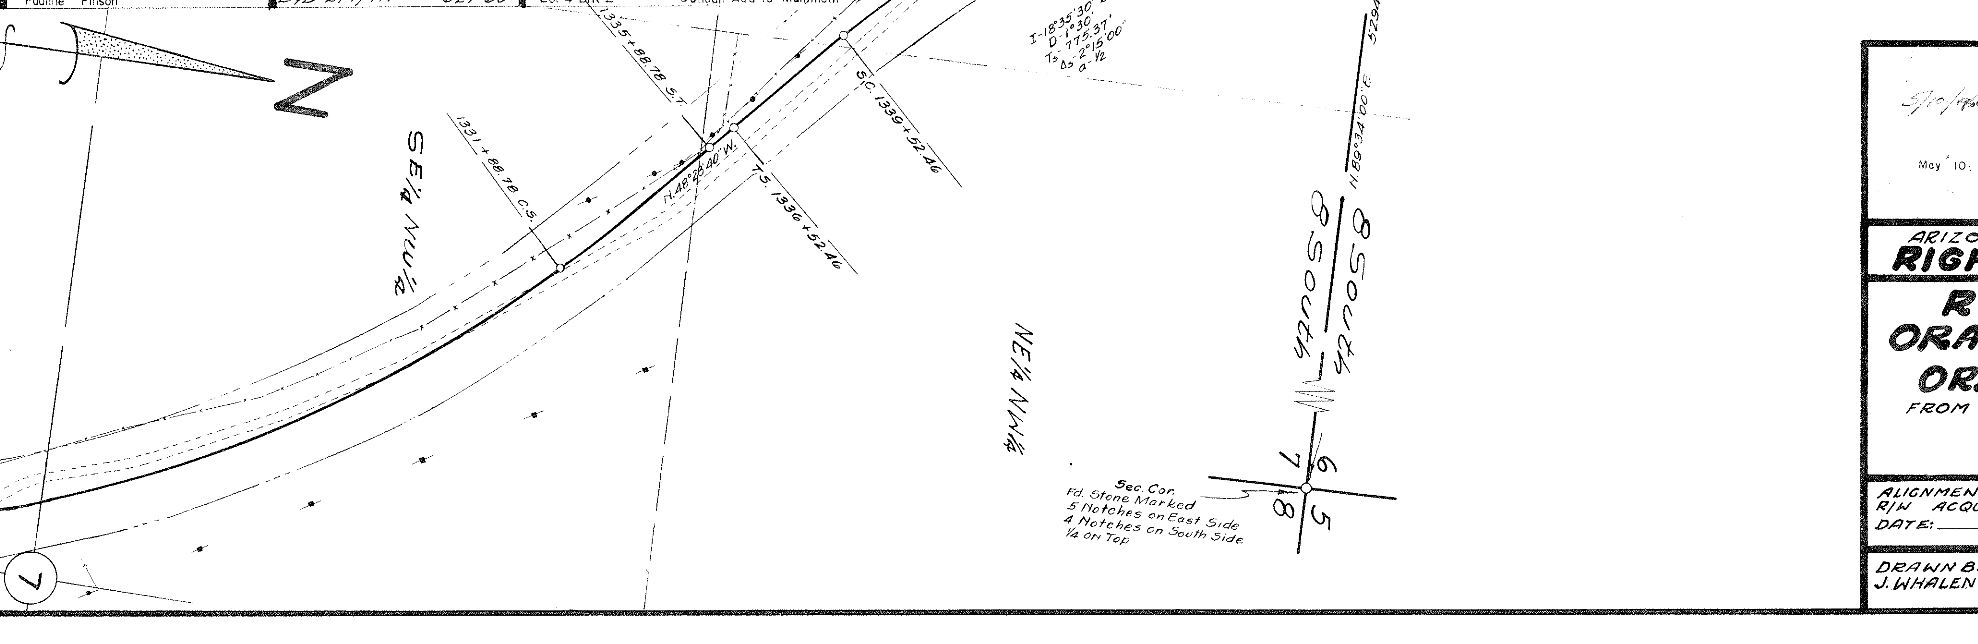

MAP REVISIONS

DATE	REVISED BY	DESCRIPTION
4/21/60	Kovacy	Added Drainage Easements & Changed ITEM numbers
5-3-6	Kodkery	Corrected ITEMS 452 to 461 to B483 to B492
7-18-60	T. Woody Meegan	Corrected R/W across Item 592 A & Removed Drainage Easement B 649 A
C.O. 3765 11-21-73	Laing	Added exchange areas & note.
C.O. 3893 3-13-74	H. MILLS	Denoted Excess Land Parcel 1431 (L-2-1A)
"	"	Area = 5531± Sq. Ft., Lt. Sta: 1207 & 1208.

May 10, 60

ARIZONA HIGHWAY DEPARTMENT
RIGHT OF WAY DIVISION

RIGHT OF WAY MAP
ORACLE JCT. GLOBE HWY.
ORACLE - MAMMOTH SEC.
FROM STA. 1170+00 TO STA. P.O.T. 1353+00.00
S. 253 (502)
PINAL CO.

ALIGNMENT APPROVED FOR R/W ACQUISITION
DATE: ______ ______ PLANS ENGINEER

DRAWN BY	DATE:	SCALE:	FILE NO
J. WHALEN	3-23-55	1" = 200'	11-T-319