OWNERSHIP RECORD / ACQUISITION RECORD

PARCEL NUMBER	OWNER	DESCRIPTION	TOTAL AREA	AREA REQUIRED GROSS INCLUDING EXISTING R/W	AREA REQUIRED NET EXCLUDING EXISTING R/W	EASEMENT AREA	REMAINDER LEFT	REMAINDER RIGHT	SHEET NO.	CHIEF R/W AGENT APPROVAL	INSTRUMENT TYPE	INSTRUMENT DATE	RECORDED DATE	RECORDED DOCUMENT
2-907	PHELPS DODGE CORPORATION	PT. BRUCE LODE MINERAL SURVEY	814246 SF	~~275 13~~ 26749 SF	~~25499~~ 24694 SF			~~786703~~ 787497 SF	1					
~~2-908~~	~~KATHERINE VOLKER ET AL~~	~~PT. HORSESHOE LODE MINERAL SURVEY~~	~~1386718 SF~~	DELETED		5-11-99			~~1~~					

NOTE:

MINERAL CLAIM BOUNDARY LINES ARE APPROXIMATE. LOCATION OF CLAIMS WERE BASED ON RECORD INFORMATION.

SEE RESULTS OF SURVEY (SHEET NO. 2) FOR ADDITIONAL CENTERLINE CONTROL

NOTE: CONSTRUCTION PROJECT 080 CH 342 H4229 01C, 016-1-534 BEGINS AT M.P. 342.93 AND ENDS AT M.P. 347.42

BEGIN R/W PROJECT
080 CH 345 H4229 01R
F-016-1-716

END R/W PROJECT
080 CH 345 H4229 01R
F-016-1-716

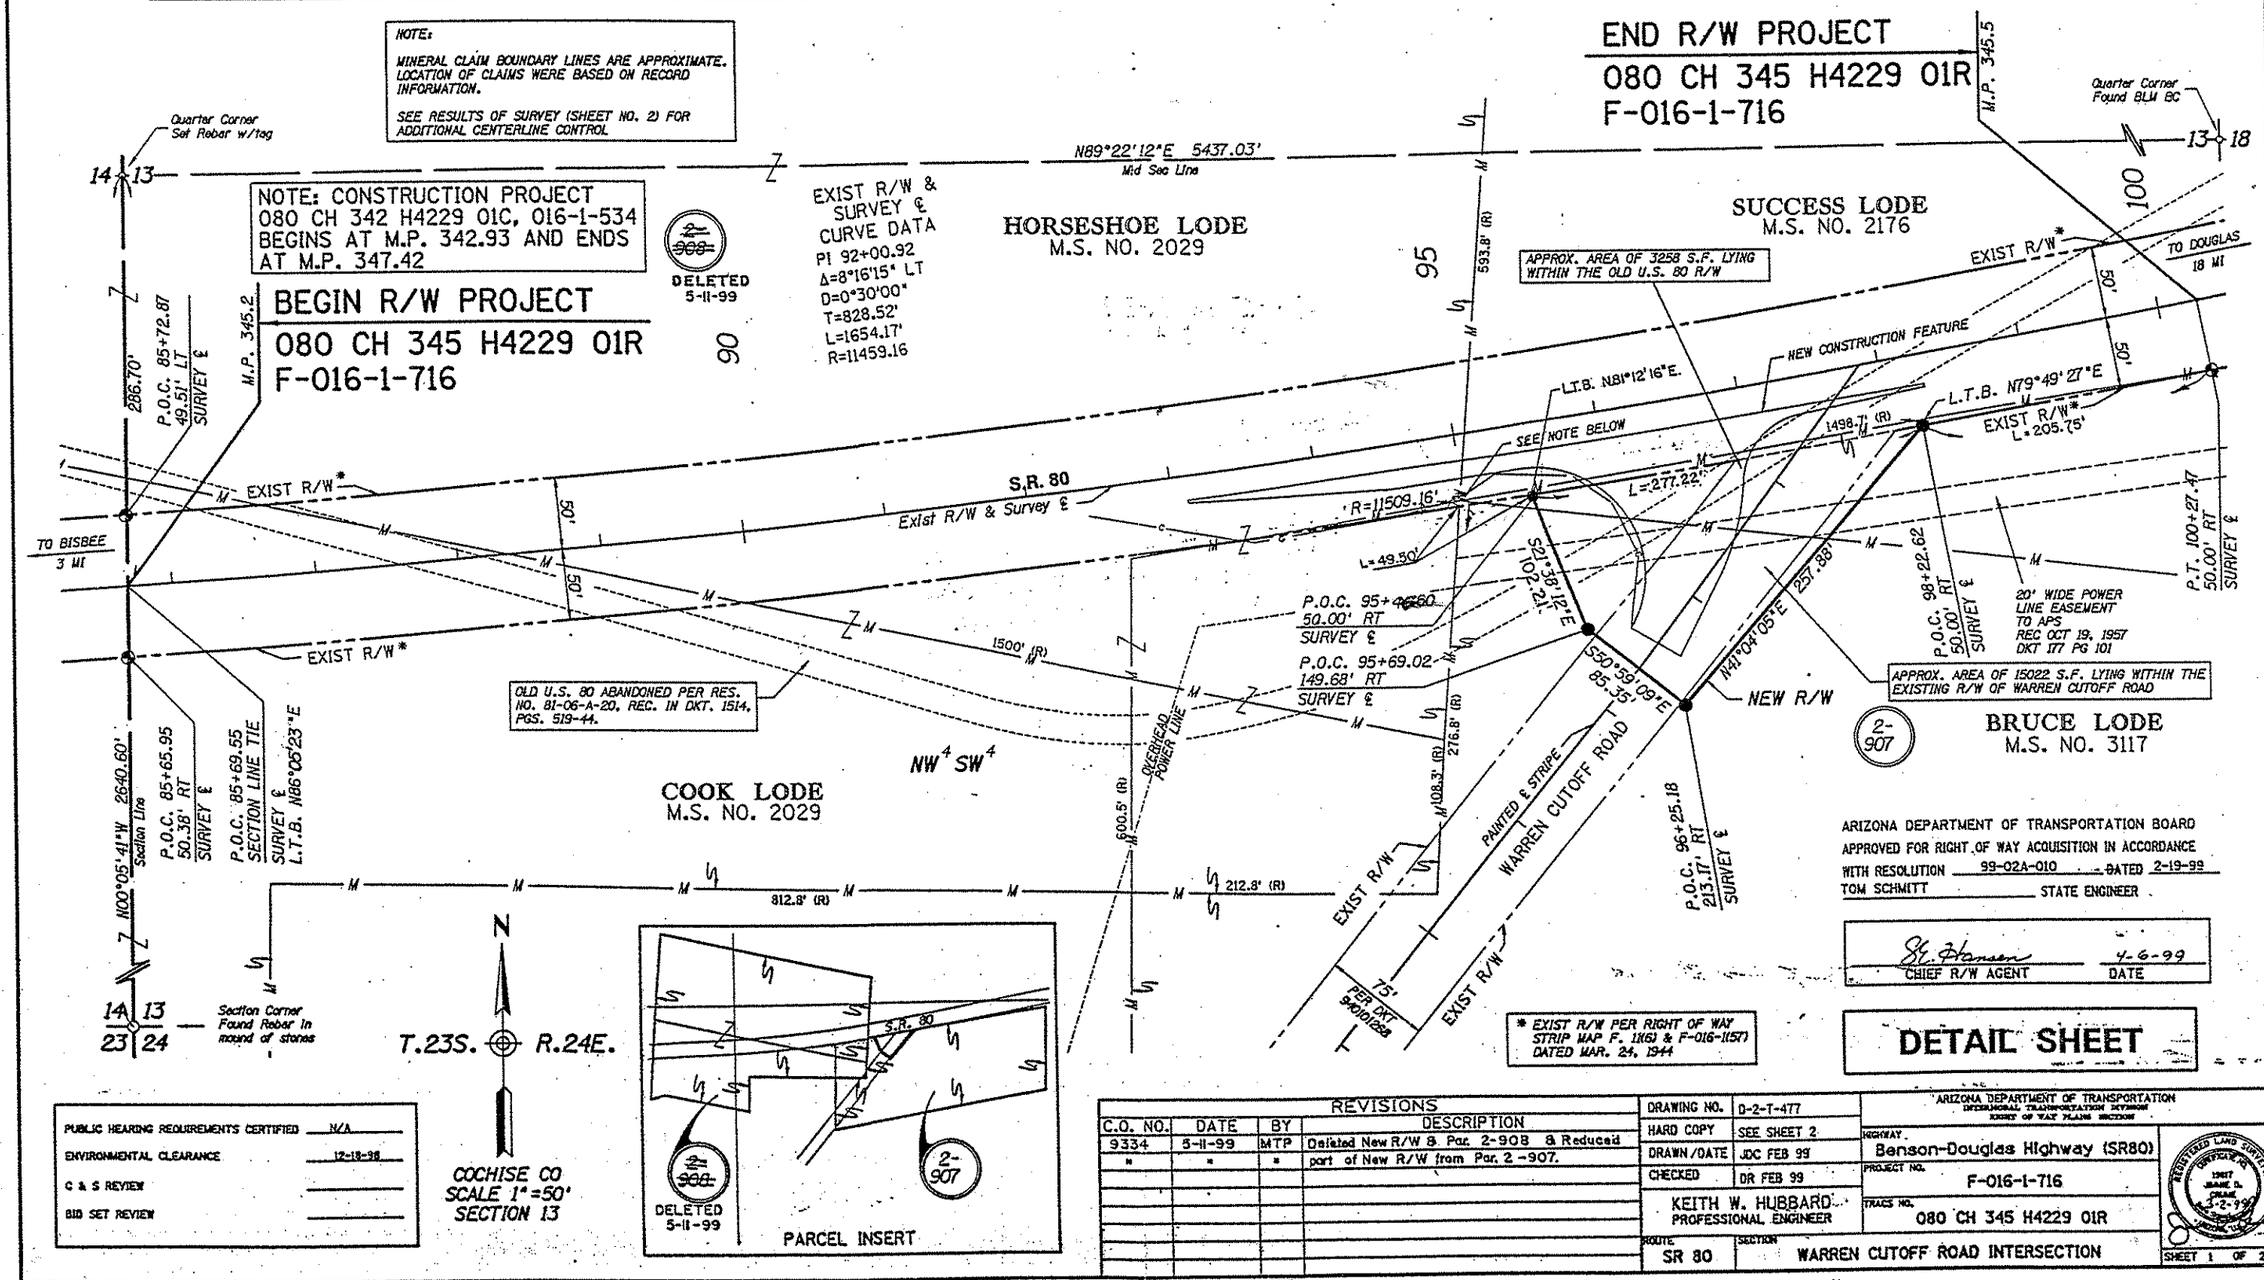

ARIZONA DEPARTMENT OF TRANSPORTATION BOARD APPROVED FOR RIGHT OF WAY ACQUISITION IN ACCORDANCE WITH RESOLUTION 99-02A-010 DATED 2-19-99
TOM SCHMITT STATE ENGINEER

S.L. Hansen 4-6-99
CHIEF R/W AGENT DATE

DETAIL SHEET

PUBLIC HEARING REQUIREMENTS CERTIFIED	N/A
ENVIRONMENTAL CLEARANCE	12-13-98
C & S REVIEW	
BID SET REVIEW	

REVISIONS

C.O. NO.	DATE	BY	DESCRIPTION
9334	5-11-99	MTP	Deleted New R/W & Par. 2-908 & Reduced
"	"	"	part of New R/W from Par. 2-907.

DRAWING NO.	D-2-T-477
HARD COPY	SEE SHEET 2
DRAWN/DATE	JDC FEB 99
CHECKED	DR FEB 99
KEITH W. HUBBARD PROFESSIONAL ENGINEER	
ROUTE	SR 80
SECTION	WARREN CUTOFF ROAD INTERSECTION

ARIZONA DEPARTMENT OF TRANSPORTATION
INTERMODAL TRANSPORTATION DIVISION
RIGHT OF WAY PLANS SECTION

HIGHWAY: Benson-Douglas Highway (SR80)
PROJECT NO. F-016-1-716
TRACS NO. 080 CH 345 H4229 01R
SHEET 1 OF 2

eeeeeSYSTEMEeeeee eeeeeDGNeSPECIFICATIONeeeee

Click here for SR 80 Index

Click here for SR 80 Index

RESULTS OF SURVEY

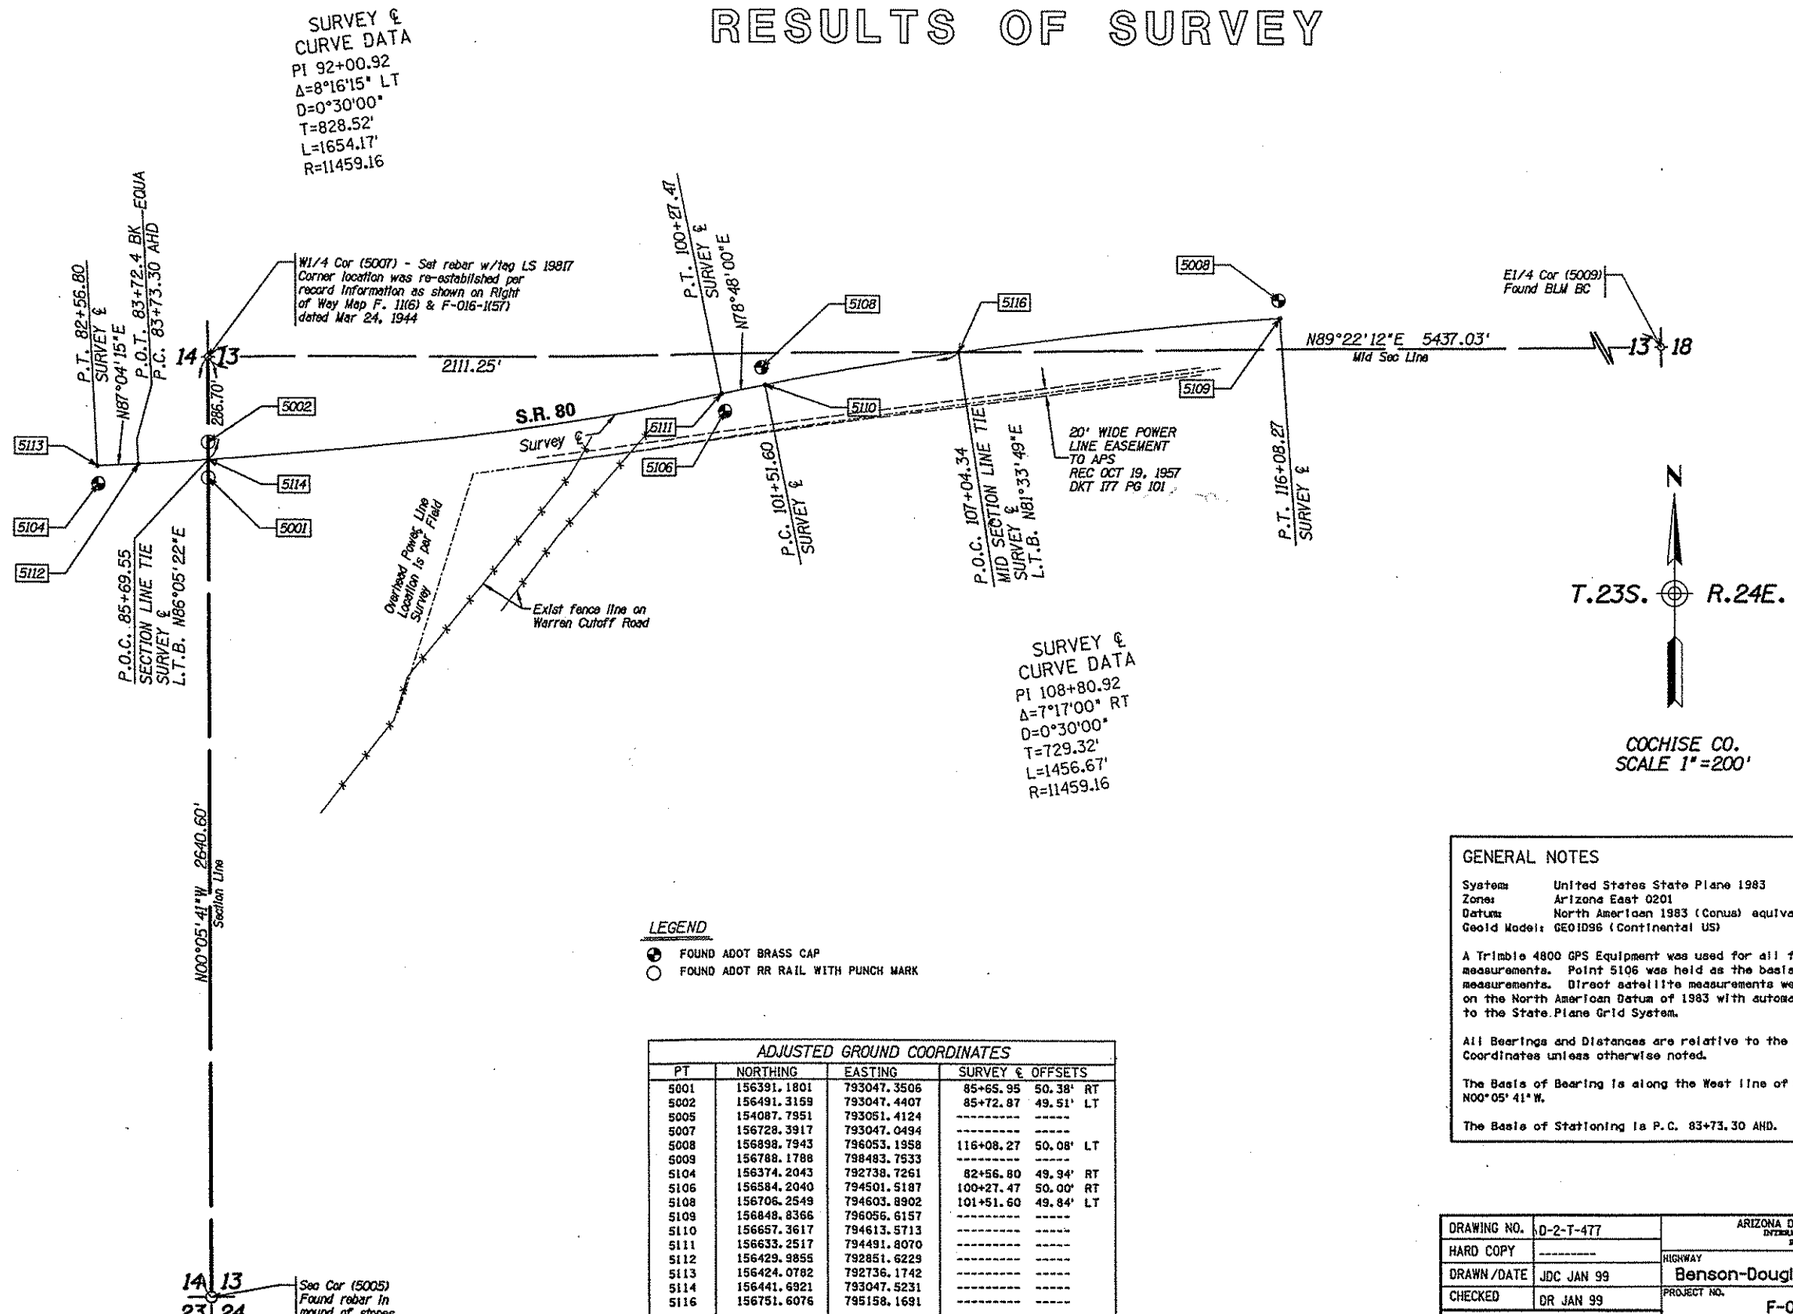

LEGEND

- FOUND ADOT BRASS CAP
- FOUND ADOT RR RAIL WITH PUNCH MARK

ADJUSTED GROUND COORDINATES

PT	NORTHING	EASTING	SURVEY ℄ OFFSETS	
5001	156391.1801	793047.3506	85+65.95	50.38' RT
5002	156491.3159	793047.4407	85+72.87	49.51' LT
5005	154087.7951	793051.4124	---------	-----
5007	156728.3917	793047.0494	---------	-----
5008	156898.7943	796053.1958	116+08.27	50.08' LT
5009	156788.1788	798483.7533	---------	-----
5104	156374.2043	792738.7261	82+56.80	49.94' RT
5106	156584.2040	794501.5187	100+27.47	50.00' RT
5108	156706.2549	794603.8902	101+51.60	49.84' LT
5109	156848.8366	796056.6157	---------	-----
5110	156657.3617	794613.5713	---------	-----
5111	156633.2517	794491.8070	---------	-----
5112	156429.9855	792851.6229	---------	-----
5113	156424.0782	792736.1742	---------	-----
5114	156441.6921	793047.5231	---------	-----
5116	156751.6076	795158.1691	---------	-----

GENERAL NOTES

System: United States State Plane 1983
Zone: Arizona East 0201
Datum: North American 1983 (Conus) equivalent to WGS-84
Geoid Model: GEOID96 (Continental US)

A Trimble 4800 GPS Equipment was used for all field survey measurements. Point 5106 was held as the basis for all measurements. Direct satellite measurements were made on each point on the North American Datum of 1983 with automatic translations made to the State Plane Grid System.

All Bearings and Distances are relative to the Adjusted Ground Coordinates unless otherwise noted.

The Basis of Bearing is along the West line of Section 13, T.23S., R.24E. N00°05'41"W.

The Basis of Stationing is P.C. 83+73.30 AHD.

DRAWING NO.	D-2-T-477	ARIZONA DEPARTMENT OF TRANSPORTATION INTERMODAL TRANSPORTATION DIVISION RIGHT OF WAY PLANS SECTION
HARD COPY	---------	HIGHWAY Benson-Douglas Highway (SR80)
DRAWN/DATE	JDC JAN 99	PROJECT NO. F-016-1-716
CHECKED	DR JAN 99	TRACS NO. 080 CH 345 H4220 01R
KEITH W. HUBBARD PROFESSIONAL ENGINEER		
ROUTE S.R. 80	SECTION Warren Cutoff Road Intersection	SHEET 2 OF 2

REGISTERED LAND SURVEYOR CERTIFICATE NO. 19817 JIMMIE D. CRUME 3-2-99 ARIZONA, U.S.A.

ccccc SYSTIMEccccc cccccDGNcSPECIFICATIONccccc