FHWA REGION	STATE	PROJECT NUMBER	SHEET NUMBER	TOTAL SHEETS	FINALIZED PLANS
9	ARIZ.	F-051-2-803	1	26	

DRAWING NUMBER	D-6-T-121

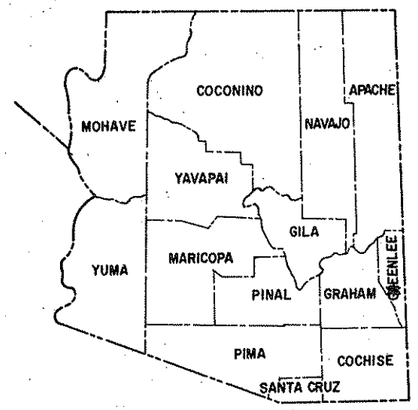

STATE OF ARIZONA
DEPARTMENT OF TRANSPORTATION

HIGHWAYS DIVISION
RIGHT OF WAY PLAN OF THE

SAFFORD - SPRINGERVILLE HIGHWAY
THREE WAY - SMELTER HILL
U.S. 666
PROJECT NO. F-051-2-803

GREENLEE COUNTY DISTRICT 3
LENGTH OF PROJECT = 5.434 MILES

PRINTED
JAN 22 1979
R/W PLANS
PHOENIX, ARIZONA

RELOCATION

Click here for US 191 Index

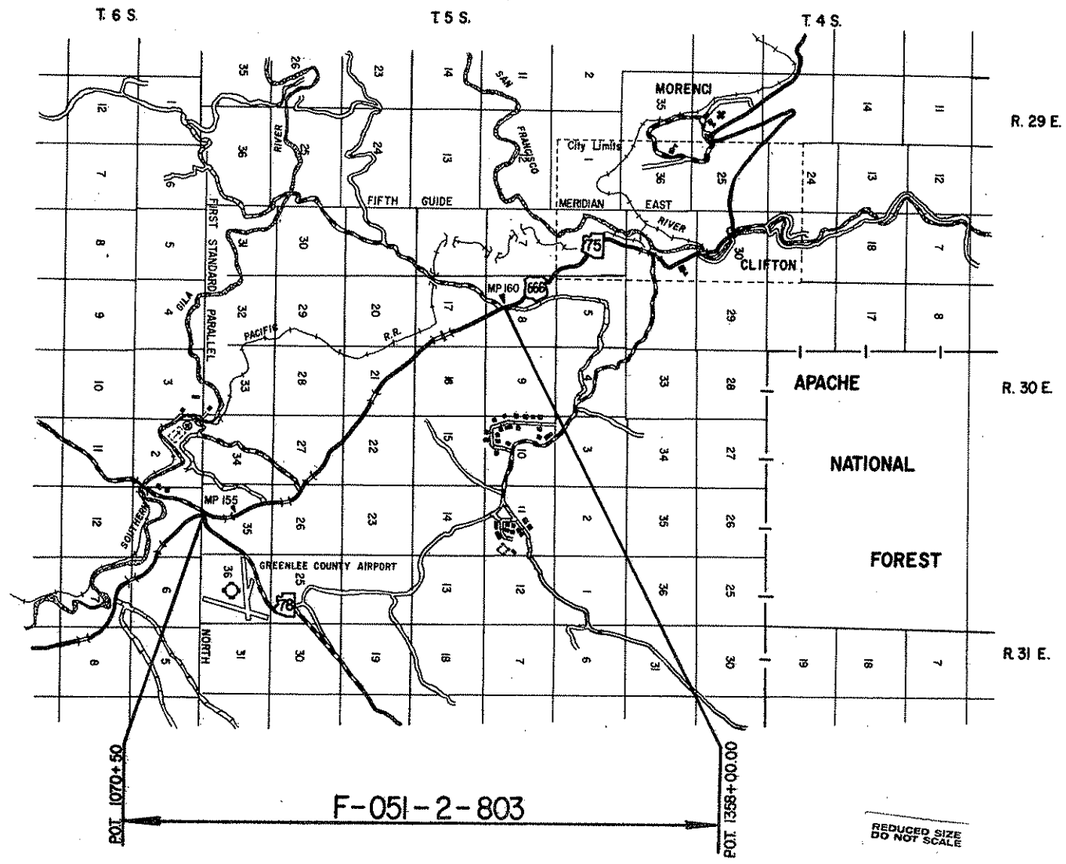

REDUCED SIZE
DO NOT SCALE

Approved in accordance with Roadway Plans

DEPUTY STATE ENGINEER — DATE 1-10-79

ARIZONA DEPARTMENT OF TRANSPORTATION BOARD
Approved for Right of Way Acquisition in accordance with Resolution Number 78-20-A-67 Dated 12-15-78

Oscar T. Lyon, Jr. State Engineer

CHIEF DEPUTY STATE ENGINEER — DATE 1/15/79

U.S. DEPARTMENT OF TRANSPORTATION
FEDERAL HIGHWAY ADMINISTRATION

DIVISION ENGINEER — DATE

DRAWING 44513

Click here for US 191 Index

SAFFORD-SPRINGERVILLE HWY.
THREE WAY - SMELTER HILL
GREENLEE COUNTY

REVISIONS				PROJECT NO.	F-051-2-803
C.O No	DATE	BY	DESCRIPTION	DRAWING NO.	D-6-T-121
				SHEET NO.	2 of 26
				DRAWN BY	NICO MORENO
				DATE COMP.	12-28-78
				SCALE	

A

Acres	Ac.
Ahead	Ahd
And	&
And Wife	et ux
And Others	et al
And Husband	et vir
Angle	∠
Approximate	Approx.
Arbitrary	Arb.
Asphalt	Asph.
At	@
Avenue	Ave.

B

Back	Bk.
Bank Protection	B.P.
Barbed Wire	B.W.
Bearing	Brng.
Beginning	Beg.
Book	Bk
Borrow	Bor.
Boulevard	Blvd.
Boundary	Bndry.
Brass Cap	B.C.
Bridge	Br.
Building	Bldg.
Bureau of Indian Affairs	B.I.A.
Bureau of Land Management	B.L.M.
Bureau of Reclamation	B.R.

C

Calculated	Calc. or C.
Cattle Guard	C.G.
Center	Ctr.
Center to Center	C to C
Centerline	℄
Channel	Chan.
Concrete	Conc.
Concrete Box Culvert	C.B.C.
Construction	Constr.
Contractor	Cont.
Corner	Cor.
Corrugated Metal Pipe	C.M.P.
County	Co.
Creek	Ck.
Cubic Yard	C.Y.
Culvert	Culv.
Curve Data	
Curve to Spiral	C.S.
Degree of Change per 100'	a
Length of Curve	L
Radius	R
Spiral to Curve	S.C.
Spiral to Tangent	S.T.
Delta	Δ
Point of Curve	P.C.
Deflection (Total Curve)	I
Point of Tangent	P.T.
Point of Compound Curve	P.C.C.
Point of Reverse Curve	P.R.C.
Point of Reverse Spiral	P.R.S.
Point of Intersection	P.I.
Degree of Curve	D
Tangent Length	T
Tangent to Spiral	T.S.

D

Deceleration	Decel.
Deflection	Defl.
Department	Dept.
Detour	Det.
Diameter	Dia.
Distance	Dist.
Ditch and Dyke	D & D
Docket	Dkt.
Drawing	Dwg.
Drive	Dr.
Dyke	Dk.
Drainage	Drn.
Drainage Easement	D.E.

E

Each	Ea.
Easement	Esmt.
East	E.
Elevation	Elev.
Embankment	Emb.
Engineer	Engr.
Equal	Eq. or =
Equation	Equa.
Excavation	Excav.
Existing	Exist.
Extend	Ext.

F

Federal	Fed.
Feet	Ft. or '
Fence	Fc.
Flowage Easement	F.E.
Forest	For.
Found	Fnd.
Frame	Fr.
Freeway	Frwy.
Future	Fut.

G

Galvanized	Galv.
Gauge	Ga.
Government	Govt.
Grader	Gr.
Guard	Gd.

H

Headwall	Hdwl.
Highway	Hwy.
House	Hse.

I

Inch	In. or "
Include	Incl.
Interchange	Intcg.
Iron Pipe	I.P.
Irrigation	Irr.

J

Joint	Jt.
Junction	Jct.

L

Left	Lf.
Length	Lgth.
Line	Ln.
Linear Feet	L.F.
Local Tangent Bearing	L.T.B.

M

Manhole	M.H.
Material	Matl.
Maximum	Max.
Median	Med.
Mile	Mi.
Mile Post	M.P.
Minimum	Min.
Minute	'
Miscellaneous	Misc.
Monument	Mon.
Mountain	Mt.

N

National	Natl.
North	N.
Number	No.

O

Opening	Opng.
Outside Diameter	O.D.
Office	Off.

P

Page	Pg.
Parcel	Par.
Parkway	Pkwy.
Per	/
Percent	%
Place	Pl.
Point on Curve	P.O.C.
Point on Tangent	P.O.T.
Point on Semi-Tangent	P.O.S.T.
Power Line	P.L.
Private	Pvt.
Project	Proj.
Property	Prop.
Proposed	Propsd.
Protection	Prot.

Q

Quadrant	Quad.

R

Railroad	R.R.
Range	Rng. or R.
Record	Rec. or (R)
Reinforced	Reinf.
Reinforced Concrete Pipe	R.C.P.
Required	Reqd.
Reservation	Res.
Right	Rt.
Right of Way	R/W
Road	Rd.
Roadway	Rdwy.

S

Second	"
Section	Sec.
Sheet	Sht.
Skew	Sk.
Slope Easement	S.E.
South	S.
Specifications	Specs.
Square	Sq.
Square Feet	ϕ
State Route	S.R.
Station	Sta.
Street	St.
Subdivision	Subdiv.
Survey	Sur.

T

Telegraph	Tlg.
Telephone	Tel.
Township	Twp. or T.
Temporary Construction Easement	T.C.E.
Traffic Interchange	T.I.
Turnout	T.O.
Typical	Typ.

U

United States General Land Office	U.S.G.L.O.
Underground	Ungnd.

V

Vertical	Vert.

W

West	W
West Bound	W.B.
Warranty Deed	W.D.

Y

Yard	Yd.

STANDARD ABBREVIATIONS

SRDSHNG 44-512

Click here for US 191 Index

SAFFORD-SPRINGERVILLE HWY.
THREE WAY-SMELTER HILL
GREENLEE COUNTY

REVISIONS				PROJECT NO.	F-051-2-803
C.O.No.	DATE	BY	DESCRIPTION	DRAWING NO.	D-6-T-121
				SHEET NO.	3 of 26
				DRAWN BY	NICO MORENO
				DATE COMP.	12-28-78
				SCALE	

ITEM	SYMBOL
HIGHWAY SURVEY CENTERLINE	
HIGHWAY CONSTRUCTION CENTERLINE	
HIGHWAY CENTERLINE (EXISTING)	
HIGHWAY RIGHT OF WAY LINE (NEW)	
HIGHWAY RIGHT OF WAY LINE (EXISTING)	
CONTROLLED ACCESS (FULL)	
CONTROLLED ACCESS (PARTIAL)	
CONTROLLED ACCESS (EXISTING)	
RAILROAD RIGHT OF WAY LINE	
RAILROAD RIGHT OF WAY LINE COMMON TO HIGHWAY RIGHT OF WAY LINE (EXISTING)	
NATIONAL OR STATE BOUNDARY LINE	
FOREST, NATIONAL MONUMENT, MILITARY OR INDIAN RESERVATION	
COUNTY LINE	
TOWNSHIP OR RANGE LINE	
SECTION LINE	
QUARTER OR MID SECTION LINE	
SIXTEENTH OR GOVERNMENT LOT LINE	
LAND GRANT BOUNDARY LINE	
CITY LIMITS BOUNDARY LINE	
SUBDIVISION OR LOT BOUNDARY LINE	
PROPERTY OWNERSHIP BOUNDARY LINE	
PROPERTY LEASE BOUNDARY LINE	L L
SURVEY MEANDER LINE	
POWER LINE	
POWER TRANSMISSION LINE	
TELEPHONE OR TELEGRAPH LINE	
TELEPHONE AND POWER LINE (COMBINATION)	
UNDERGROUND TELEPHONE CABLE	T T T T
WATER UTILITY LINE	W 6" W 6" W
NATURAL GAS UTILITY LINE	G 2" G 2" G
SANITARY SEWER LINE	S 8" S 8" S
STORM SEWER LINE	SS 36" SS 36" SS

ITEM	SYMBOL
HIGHWAY SLOPE OR DRAINAGE EASEMENT (NEW)	
HIGHWAY SLOPE OR DRAINAGE EASEMENT (EXISTING)	
TEMPORARY CONSTRUCTION EASEMENT (NEW)	
ROAD (NEW) (SHOULDER TO SHOULDER WIDTH)	
ROAD (EXISTING) (SHOULDER TO SHOULDER WIDTH)	
RAILROAD TRACK	
RIVER OR CREEK (CONTINUOUS FLOW)	
RIVER OR CREEK (INTERMITTENT FLOW)	
NATURAL DRAINAGE OR A WASH	
CANAL, CHANNEL, OR DITCH (NEW)	
CANAL, CHANNEL, OR DITCH (EXISTING)	
IRRIGATION DITCH OR LINE (NEW)	IRR IRR
IRRIGATION DITCH OR LINE (EXISTING)	IRR IRR
DYKE OR LEVEE (NEW)	
DYKE OR LEVEE (EXISTING)	
BANK PROTECTION	
RETAINING WALL	
CONSTRUCTION OR SLOPE LIMITS	
WIRE OR BARBED WIRE FENCE	
CHAIN LINK FENCE	
WOOD FENCE	
STONE FENCE	
ROAD GUARD (NEW)	
ROAD GUARD (EXISTING)	
CURB	
CURB AND GUTTER	
DEPRESSED CURB WITH GUTTER (NEW)	
DEPRESSED CURB WITH GUTTER (EXISTING)	
TREES (DECIDUOUS)	
TREES (CONIFEROUS)	
HEDGE OR SHRUBBERY	
EXIST. PAVEMENT	
NEW PAVEMENT	
NEW STRUCTURES (BRIDGES, ETC. NOT COVERED BY PAVEMENT)	
EXIST. PAVEMENT, TO BE OBLITERATED	
EXCESS TAKE	

STANDARD SYMBOLS

ITEM	SYMBOL
BRIDGE (NEW)	
BRIDGE (EXISTING)	
PIPE CULVERT (NEW)	
PIPE CULVERT (EXISTING)	
BOX CULVERT (NEW)	
BOX CULVERT (EXISTING)	
CATTLE GUARD (NEW)	
CATTLE GUARD (EXISTING)	
GATE (NEW)	
GATE (EXISTING)	
FORD (NEW)	
FORD (EXISTING)	
TRAFFIC DIRECTIONAL FLOW ARROWS	
DRAINAGE DIRECTIONAL FLOW ARROWS	
PROPERTY LIMIT ARROWS	
LEASE LIMIT ARROWS	L L
PROPERTY TIE BARS	
SURVEY MONUMENT, NEW	
SURVEY MONUMENT, EXISTING	
NEW RIGHT OF WAY CONTROL POINT	
RIGHT OF WAY MARKER, EXISTING	
NORTH ARROW	
FOUND SEC. COR. or 1/4 COR.	
UNFOUND SEC. COR. or 1/4 COR.	
FOUND CENTER SEC.	3
UNFOUND CENTER SEC.	3

5/32" Diameter Circle. No.1 Rapidograph Pen, Or Equal.

1/2" Diameter Circle. No.1 Rapidograph Pen, Or Equal.

5/32" Diameter Circle. No.1 Rapidograph Pen, Or Equal.

SECTION CORNER — CENTER OF SECTION — 1/4 CORNER

7-614 PARCEL BUBBLE Size 3/4" 7-614 7-614-L1

ESULING 44-512

SAFFORD-SPRINGERVILLE HWY.
THREE WAY-SMELTER HILL
GREENLEE COUNTY

Click here for US 191 Index

REVISIONS				PROJECT NO.	F-051-2-803
C.O. No.	DATE	BY	DESCRIPTION	DRAWING NO.	D-6-T-121
5404	6/17/77	R.L.R.	Chgd. T.A. in L.3, Sec. 21 to 407 Ac. C.E.(D)	SHEET NO.	4 of 26
				DRAWN BY	G.K.
				DATE COMP.	12-28-78
				SCALE	"

OWNERSHIP RECORD

ACQUISITION RECORD

PARCEL NUMBER	OWNER	DESCRIPTION	TOTAL AREA	AREA REQUIRED GROSS INCLUDING EXISTING R/W	AREA REQUIRED NET EXCLUDING EXISTING R/W	EASEMENT AREA	REMAINDER LEFT	REMAINDER RIGHT	SHEET NUMBER	BOARD APPROVAL	TYPE & DATE OF INSTRUMENT	RECORDED DATE	RECORDED BOOK	RECORDED PAGE
6-104	STATE OF ARIZONA (S.L.D.)	Pt. of Sec. 35 T5S R30E	640.0 Ac.	38.4 Ac.	9.2 Ac.		233.8 Ac.	① 367.8 Ac.	6, 7, 8	1-3-80	GRANT 1-17-80	NOT RECORDED		
		Pt of Sec. 26 T5S R30E	640.0 Ac.	26.4 Ac.	12.5 Ac.		51.6 Ac.	562.0 Ac.	8, 9					
		Pt. of Sec. 27 T5S R30E	640.0 Ac.	45.9 Ac.	25.0 Ac.	1.0 Ac. T.C.E.	517.0 Ac.	72.1 Ac.	9, 10					
		Pt. of Sec. 22 T5S R30E	640.0 Ac.	16.9 Ac.	5.9 Ac.		22.6 Ac.	600.5 Ac.	10, 11					
		Pt. of Sec. 21 T5S R30E	640.0 Ac.	45.4 Ac.	16.6 Ac.		375.0 Ac.	219.6 Ac.	11, 12, 13					
		Pt. of Sec. 16 T5S R30E	640.0 Ac.	7.6 Ac.	2.2 Ac.		3.1 Ac.	629.3 Ac.	13					
		Pt. of Sec. 17 T5S R30E	640.0 Ac.	36.1 Ac.	13.1 Ac.	0.8 Ac. T.C.E.	497.8 Ac.	106.1 Ac.	14, 15					
		Pt. of Sec. 8 T5S R30E	640.0 Ac.	② 50.0 Ac.	2.8 Ac.	0.4 Ac. T.C.E.	103.3 Ac.	426.7 Ac.	15, 16					
L-1	ROBERT DAVIS, et al Comm. Lease # 1481-L	Pt. of Sec. 35 T5S R30E	623.4 Ac.	29.3 Ac.	9.2 Ac.		228.7 Ac.	① 365.4 Ac.	6, 7, 8	1-3-80	GRANT 1-17-80	NOT RECORDED		
L-2	ELNO J. LUNT, et ux. Grazing Lease #416-01	Pt. of Sec. 26 T5S R30E	640.0 Ac.	26.4 Ac.	12.5 Ac.		51.6 Ac.	562.0 Ac.	8, 9	1-3-80	R/W 10-31-79	NOT RECORDED		
		Pt. of Sec. 27 T5S R30E	640.0 Ac.	45.9 Ac.	25.0 Ac.	1.0 Ac. T.C.E.	517.0 Ac.	77.1 Ac.	9, 10					
		Pt. of Sec. 22 T5S R30E	640.0 Ac.	16.9 Ac.	5.9 Ac.		22.6 Ac.	600.5 Ac.	10, 11					
		Pt. of Sec 16 T5S R30E	640.0 Ac.	7.6 Ac.	2.2 Ac.		3.1 Ac.	629.3 Ac.	13					
L-3	LEE K. UDALL, et ux Grazing Lease #30489-02	Pt. of Sec. 21 (W. of Hwy.) T5S R30E	403 Ac.	45.4 Ac.	16.6 Ac.		357.6 Ac.		11, 12, 13	1-3-80	GRANT 1-17-80	NOT RECORDED		
		Pt. of Sec. 17 (W. of Hwy.) T5S R30E	521.0 Ac.	36.1 Ac.	13.1 Ac	0.8 Ac. T.C.E.	484.9 Ac.		14, 15					
		Pt. of Sec. 8 (W. of Hwy.) T5S R30E	41.3 Ac.	0.3 Ac.	2.8 Ac.	0.4 Ac. T.C.E.	35.0 Ac.		15, 16					

① Remainder Rt. includes Exist R/W on SR. 78.

② Gross Area includes 40.3 Ac. Exist. R/W previously acquired under R/W Project 9-218-903

SAFFORD-SPRINGERVILLE HWY.
THREE WAY-SMELTER HILL
GREENLEE COUNTY

Click here for US 191 Index

REVISIONS			
C.O. No.	DATE	BY	DESCRIPTION
5336	3-20-79	RGHE	SPLIT UNMTR. PROJ. LIMITS INTO TWO UNITS
5404	6-27-79	R.L.R.	See C.O. For Revisions. C.E.S. (3)
5841	7-1-81	R.L.R.	Added new stock tank at 1141 C.E.S. (23)
5873	9-25-81	R.L.R.	Added disposal area & channel L.F. 1159±
"	"	"	Bid (23)

PROJECT NO.	F-051-2-803
DRAWING NO.	D-6-T-121
SHEET NO.	5 of 26
DRAWN BY	G.K.
DATE COMP.	12-28-78
SCALE	1"=1000'

HARD COPY 7657 M15A-M20A CHECKED BY Paul Cutshaw

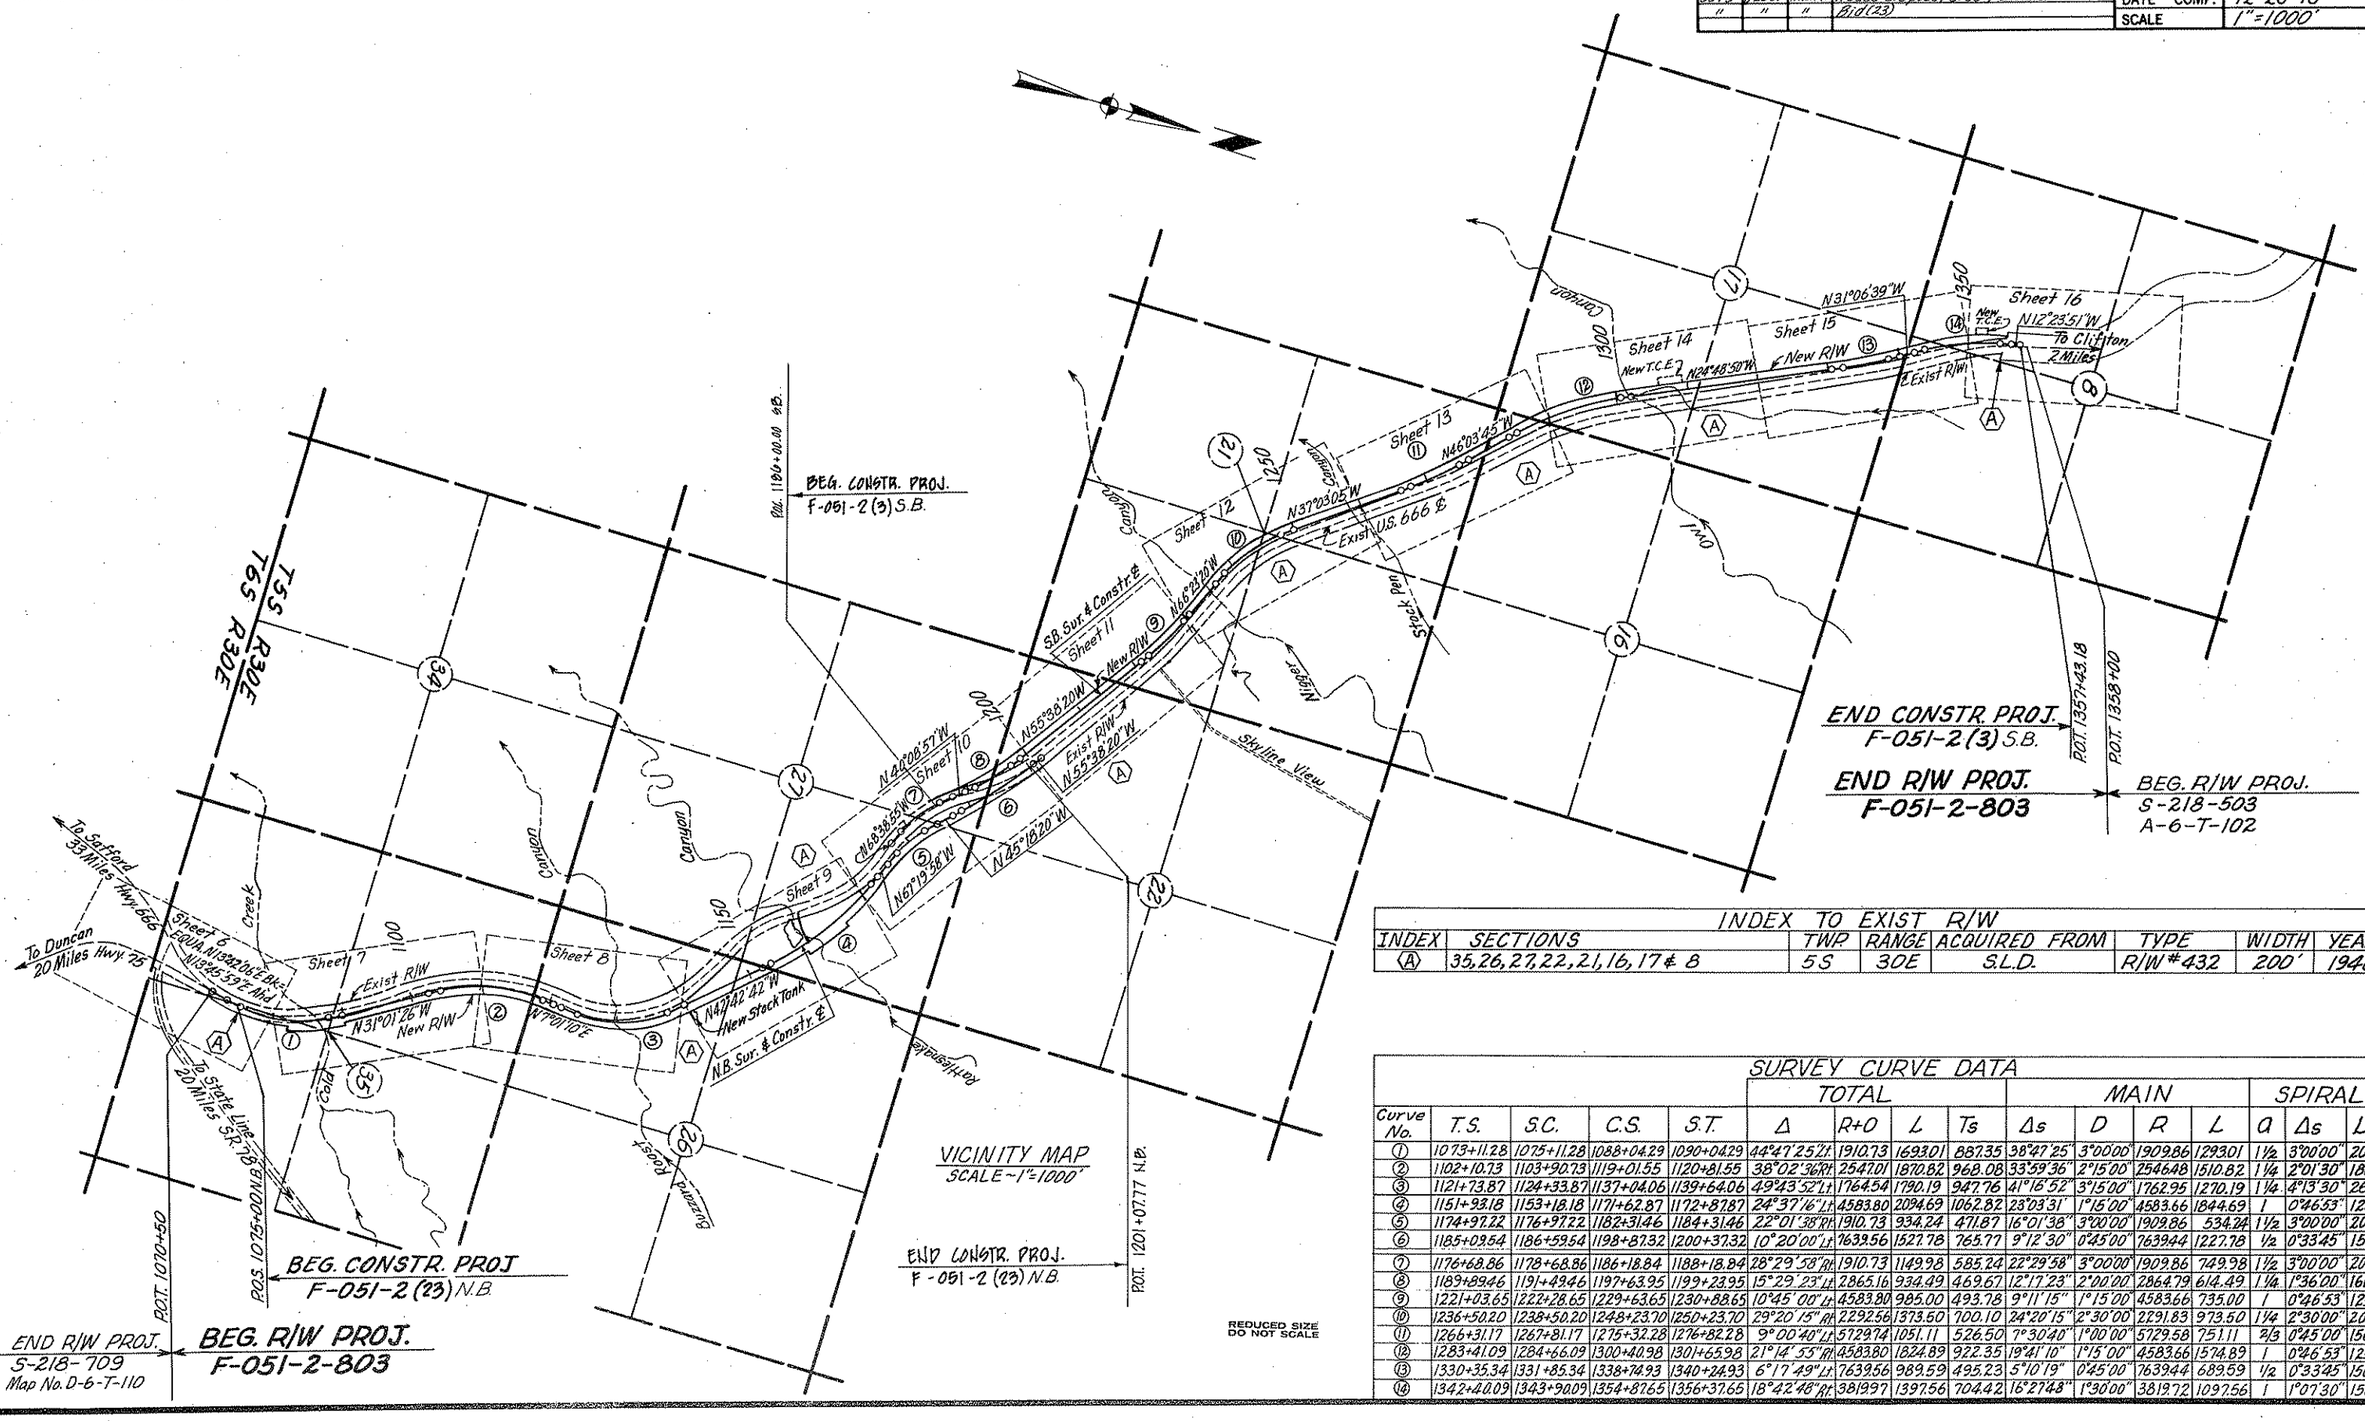

INDEX TO EXIST R/W

INDEX	SECTIONS	TWP	RANGE	ACQUIRED FROM	TYPE	WIDTH	YEAR
Ⓐ	35, 26, 27, 22, 21, 16, 17 & 8	5S	30E	S.L.D.	R/W #432	200'	1940

SURVEY CURVE DATA

	TOTAL								MAIN				SPIRAL		
Curve No.	T.S.	S.C.	C.S.	S.T.	Δ	R+O	L	Ts	Δs	D	R	L	a	Δs	Ls
①	1073+11.28	1075+11.28	1088+04.29	1090+04.29	44°47'25"Lt	1910.73	1693.01	887.35	38°47'25"	3°00'00"	1909.86	1293.01	1½	3°00'00"	200.0
②	1102+10.73	1103+90.73	1119+01.55	1120+81.55	38°02'36"Rt	2547.01	1870.82	968.08	33°59'36"	2°15'00"	2546.48	1510.82	1¼	2°01'30"	180.0
③	1121+73.87	1124+33.87	1137+04.06	1139+64.06	49°43'52"Lt	1764.54	1790.19	947.76	41°18'52"	3°15'00"	1762.95	1270.19	1¼	4°13'30"	260.0
④	1151+98.18	1153+18.18	1171+62.87	1172+87.87	24°37'16"Lt	4583.80	2094.69	1062.82	23°03'31"	1°15'00"	4583.66	1844.69	1	0°46'53"	125.0
⑤	1174+91.22	1176+97.22	1182+31.46	1184+31.46	22°01'38"Rt	1910.73	934.24	471.87	16°01'36"	3°00'00"	1909.86	534.24	1½	3°00'00"	200.0
⑥	1185+09.54	1186+59.54	1198+87.32	1200+37.32	10°20'00"Lt	7639.56	1527.78	765.77	9°12'30"	0°45'00"	7639.44	1227.78	½	0°33'45"	150.0
⑦	1176+68.86	1178+68.86	1186+18.84	1188+18.84	28°29'58"Rt	1910.73	1149.98	585.24	22°29'58"	3°00'00"	1909.86	749.98	1½	3°00'00"	200.0
⑧	1189+89.46	1191+49.46	1197+63.95	1199+23.95	15°29'23"Lt	2865.16	934.49	469.67	12°17'23"	2°00'00"	2864.79	614.49	1¼	1°36'00"	160.0
⑨	1221+03.65	1222+28.65	1229+63.65	1230+88.65	10°45'00"Lt	4583.80	905.00	493.78	9°11'15"	1°15'00"	4583.66	735.00	1	0°46'53"	125.0
⑩	1236+50.20	1238+50.20	1248+23.70	1250+23.70	29°20'15"Rt	2292.56	1373.60	700.10	24°20'15"	2°30'00"	2291.83	973.50	1¼	2°30'00"	200.0
⑪	1266+31.17	1267+81.17	1275+32.28	1276+82.28	9°00'40"Lt	5729.14	1051.11	526.50	7°30'40"	1°00'00"	5729.58	751.11	¾	0°45'00"	150.0
⑫	1283+41.09	1284+66.09	1300+40.98	1301+65.98	21°14'55"Rt	4583.80	1824.89	922.35	19°41'10"	1°15'00"	4583.66	1574.89	1	0°46'53"	125.0
⑬	1330+35.34	1331+85.34	1338+74.93	1340+24.93	6°17'49"Lt	7639.56	989.59	495.23	5°10'19"	0°45'00"	7639.44	689.59	½	0°33'45"	150.0
⑭	1342+40.09	1343+90.09	1354+87.65	1356+37.65	18°42'48"Rt	3819.97	1397.56	704.42	15°27'48"	1°30'00"	3819.72	1097.56	1	1°01'30"	150.0

BRUNING 44-512

SAFFORD - SPRINGERVILLE HWY.
THREE WAY - SMELTER HILL
GREENLEE COUNTY

Click here for US 191 Index

REVISIONS				PROJECT NO.	F-051-2-803
C.O. No.	DATE	BY	DESCRIPTION	DRAWING NO.	D-6-T-121
5238	9-20-79	RENE	SPLIT LOWER TRAV. LANES INTO TWO UNITS	SHEET NO.	6 of 26
5241	7-1-81	R.L.R.	Removed Pipe Culvert Station 1082+00 (23)	DRAWN BY	G.K.
				DATE COMP.	12-28-78
				SCALE	1"=100'

HARD COPY 7657 M15A CHECKED BY

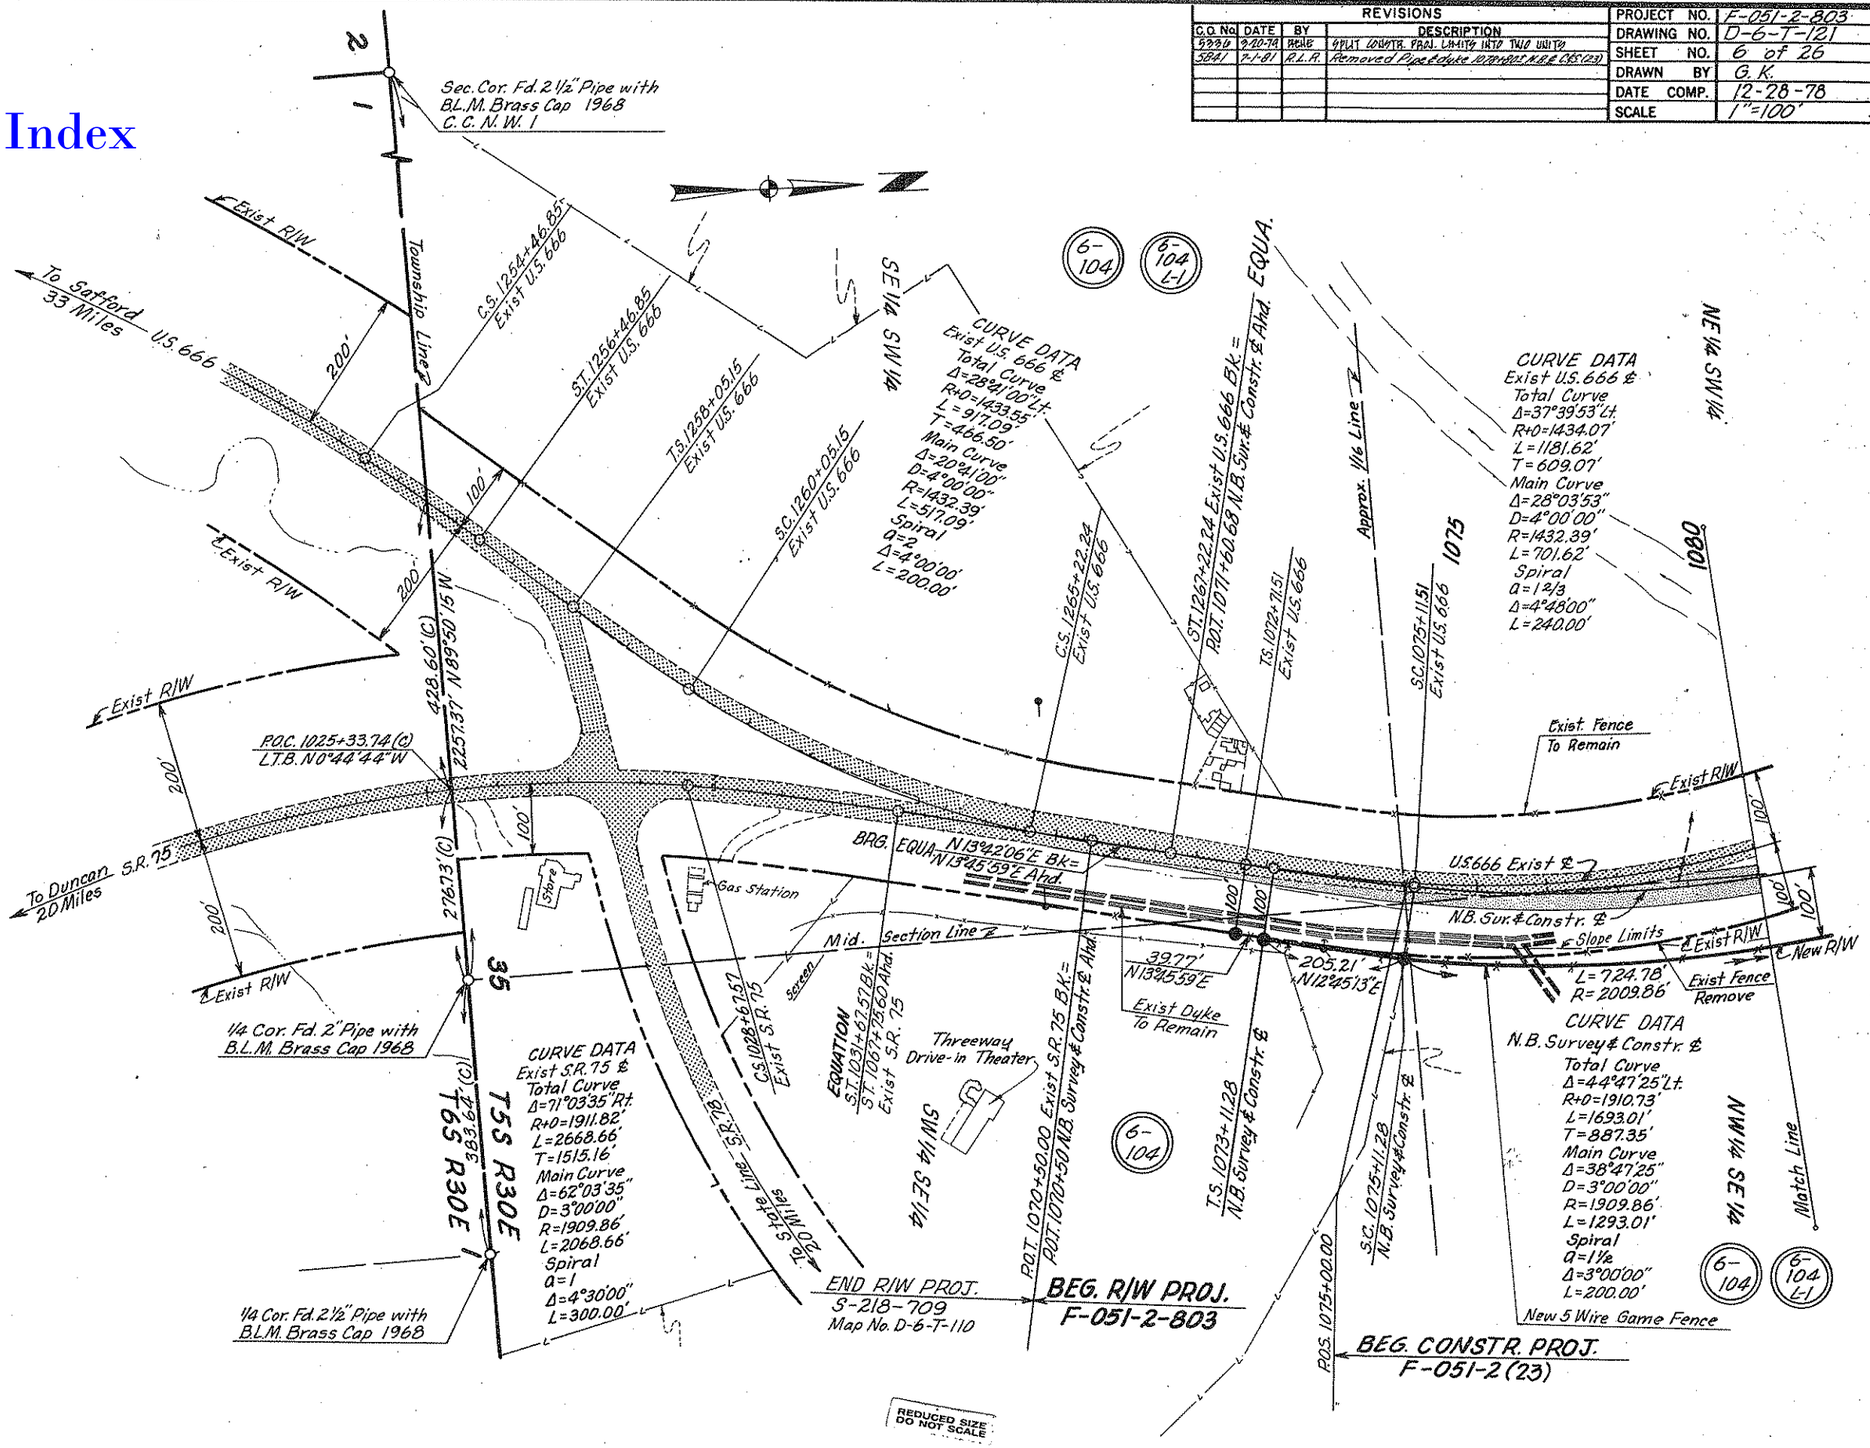

REDUCED SIZE DO NOT SCALE

BRUNING 44-512

SAFFORD-SPRINGERVILLE HWY.
THREE WAY-SMELTER HILL
GREENLEE COUNTY

REVISIONS				PROJECT NO.	F-051-2-803
G.O. No.	DATE	BY	DESCRIPTION	DRAWING NO.	D-6-T-121
5841	7-1-81	R.L.R.	See C.O. For Revisions. C.E.S. (23)	SHEET NO.	7 of 26
				DRAWN BY	G.K.
				DATE COMP.	12-28-78
				SCALE	1"=100'

HARD COPY 7657 M16A CHECKED BY

T5S R30E

CURVE DATA
Exist U.S. 666 ℄
Total Curve
Δ=9°53'00"Lt.
R+O=2292.24'
L=545.33'
T=273.19'
Main Curve
Δ=6°08'00"
D=2°30'00"
R=2291.83'
L=245.33'
Spiral
Q=12/3
Δ=1°52'30"
L=150.00'

CURVE DATA
Exist U.S. 666 ℄
Total Curve
Δ=40°48'00"Rt.
R+O=2865.37'
L=2340.00'
T=1165.62'
Main Curve
Δ=36°48'00"
D=2°00'00"
R=2864.79'
L=1840.00'
Spiral
Q=1
Δ=2°00'00"
L=200.00'

1080 1085 1090 1095 1100 1105 1110

1/4 MS 1/4 NE | 1/4 MN 1/4 SE | 1/4 MN 1/4 SE | 1/4 MN 1/4 NE | 1/4 MS 1/4 NE | 1/4 MN 1/4 NE

C.S. 1082+13.13 | S.T. 1084+53.13 | T.S. 1088+22.72 | S.C. 1089+72.72 | C.S. 1092+18.06 | S.T. 1093+68.06 Bk. = EQUA. | P.O.T. 1093+51.29 Ahd. | P.O.T. 1099+28.40 Bk. = EQUA. | T.S. 1099+34.40 Ahd. | S.C. 1101+34.40

Approx. Mid. Sec. Line ℄ | Approx. 1/16 Line ℄

6-104 | 6-104 L-1

Exist 4 Span Bridge To Remain | Exist Fence To Remain | Exist 5x4' C.B.C. To Remain | Exist Fence Remove

Exist R/W ℄ | Exist R/W | Exist Ditch Rt.

Creek

U.S. 666 Exist ℄

Mile Post 155

N.B. Survey & Constr. ℄

N31°01'26"W

176.46'

N30°21'20"W

R=2446.48'
L=1327.08'

100' | 100' | 100' | 100' | 100' | 100' | 100' | 100' | 100' | 100' | 100' | 100'

New R/W | Exist R/W | New R/W

R=2003.86'
L=724.78'
35.00'
N80°06'17"E(Rad.)

R=2044.86'
L=647.01'

135' | 100'

2 Slope Limits

N30°00'25"W
207.04'
New 16' #2 Gate.

35.00'
N58°58'34"E

N31°01'26"W 1206.44'

New 5 Wire Game Fence

New 2-48" Pipe Culv.

Cold

P.O.C. 1082+00
L.T.B. N9°33'43"W

Match Line

CURVE DATA
N.B. Survey & Constr. ℄
Total Curve
Δ=44°47'25"Lt.
R+O=1910.73'
L=1693.01'
T=887.35'
Main Curve
Δ=38°47'25"
D=3°00'00"
R=1909.86'
L=1293.01'
Spiral
Q=1 1/2
Δ=3°00'00"
L=200.00'

C.S. 1088+04.29
L.T.B. N28°01'26"W

S.T. 1090+04.29

Mid. Sec. Line ℄

Approx. 1/16 Line ℄

T.S. 1102+10.73

S.C. 1103+90.73
L.T.B. N28°59'56"W

CURVE DATA
N.B. Survey & Constr. ℄
Total Curve
Δ=38°02'36"Rt.
R+O=2547.01'
L=1870.82'
T=968.08'
Main Curve
Δ=33°59'36"
D=2°15'00"
R=2546.48'
L=1510.82'
Spiral
Q=1 1/4
Δ=2°01'30"
L=180.00'

1/4 MN 1/4 SE | 1/4 MS 1/4 NE | 1/4 MN 1/4 NE

Match Line

REDUCED SIZE DO NOT SCALE

Click here for US 191 Index

BRUNING 44-512

SAFFORD-SPRINGERVILLE HWY.
THREE WAY-SMELTER HILL
GREENLEE COUNTY

REVISIONS				PROJECT NO.	F-051-2-803
C.O. No.	DATE	BY	DESCRIPTION	DRAWING NO.	D-6-T-121
58241	7-1-81	R.L.R.	Added new bridge 1129+67.91 Ahd & 16'#2 Gate	SHEET NO.	8 of 26
"	"	"	At 1131+80 Ext. C.L. E.S. (23)	DRAWN BY	G.K.
				DATE COMP.	12-28-78
				SCALE	1"=100'

CHECKED BY. Ron Collins

HARD COPY 7657 M16A & M17A

Sec. Cor. Fd. 2½" Pipe with B.L.M. Brass Cap 1968

CURVE DATA
Exist U.S. 666 ℄
Total Curve
Δ=40°48'00"Rt.
R+O=2865.37'
L=2240.00'
T=1165.62'
Main Curve
Δ=36°48'00"
D=2°00'00"
R=2864.79'
L=1840.00'
Spiral
a=1
Δ=2°00'00"
L=200.00'

6-104 | 6-104 L-1

Exist Dirt Rd. ℄

Exist R/W ℄

Exist Fence To Remain

Exist 36" CMP Extend Rt.

7646.93'

C.S. 1119+24.40

S.T. 1121+24.40

T.S. 1122+35.00

S.C. 1124+45.00

Exist 5 Span Bridge To Remain

6-104 | 6-104 L-2

Cienega

U.S. 666 Exist ℄

Exist Fence Remove

N.B. Survey & Constr. ℄ Slope Limits

R=1762.95
L=1342.24'

New 5 Wire Game Fence

Approx. 1/16 Line

Roost

Buzzard

New 16'#2 Gate

Exist R/W

New R/W

100'

R=2446.48'
L=1327.08'

P.O.C. 1117+67.91
Section Line Tie

L.T.B. N2°04'51"E

L=124.41'

N2°01'10"E

N5°21'04"E

92.32'

267.31' N5°35'30"E

267.31' N41°17'02"W

N42°42'42"W

New R/W

Match Line

CURVE DATA
N.B. Survey & Constr. ℄
Total Curve
Δ=38°02'36"Rt.
R+O=2547.01'
L=1870.82'
T=968.08'
Main Curve
Δ=33°59'36"
D=2°15'00"
R=2546.48'
L=1510.82'
Spiral
a=1¼
Δ=2°01'30"
L=180.00'

1209.85'
Section Line
N89°42'25"E
1301.93'

C.S. 1113+01.55
L.T.B. N4°39'40"E

S.T. 1120+81.55

T.S. 1121+73.87

S.C. 1124+33.87
L.T.B. N2°47'40"E

CURVE DATA
Exist U.S. 666 ℄
Total Curve
Δ=69°21'30"Lt.
R+O=1638.41'
L=2191.67'
T=1238.41'
Main Curve
Δ=62°00'30"
D=3°30'00"
R=1637.02'
L=1771.67'
Spiral
a=12/3
Δ=3°40'30"
L=210.00'

CURVE DATA
N.B. Survey & Constr. ℄
Total Curve
Δ=49°43'52"Lt.
R+O=1764.54'
L=1790.19'
T=947.76'
Main Curve
Δ=41°16'52"
D=3°15'00"
R=1762.95'
L=1270.19'
Spiral
a=1¼
Δ=4°13'30"
L=260.00

C.S. 1137+04.06

S.T. 1139+64.06
Match Line

Mid. Sec. Line ℄

1/4 Cor. Fd. Stone with "1/4.5" on North Face

NE 1/4 NW 1/4 | NW 1/4 NW 1/4 | SW 1/4 NW 1/4 | SE 1/4 SW 1/4 | NE 1/4 SW 1/4

1110 | 1115 | 1120 | 1125 | 1130 | 1135 | 1140

T3S R20E

Sec. 34 | 27 | 35 | 26

REDUCED SIZE DO NOT SCALE

BRÜNING 44-512

Click here for US 191 Index

SAFFORD-SPRINGERVILLE HWY.
THREE WAY-SMELTER HILL
GREENLEE COUNTY

REVISIONS				PROJECT NO.	F-051-2-803
C.O. No.	DATE	BY	DESCRIPTION	DRAWING NO.	D-6-T-121
5841	7-1-81	R.L.R.	Added stock Tank at 1141 & bridge at 1159.	SHEET NO.	9 of 26
"	"	"	N.B.& str. See C.O. C-85 (23)	DRAWN BY	G. K.
5873	8-25-81	R.L.R.	Added embkt. disposal area & new 30'	DATE COMP.	12-28-78
"	"	"	Channel & Rip-rap at 1159. Bid (23)	SCALE	1"=100'

CHECKED BY: Gene Peterson

HARD COPY 7657 M17A

BRUNING 44-512

CURVE DATA
Exist U.S. 666 &
Total Curve
Δ=28°15'30"Rt
R+0=1434.07'
L=946.46'
T=480.96'
Main Curve
Δ=18°39'30"
D=4°00'00"
R=1432.39'
L=466.46'
Spiral
a=1 2/3
Δ=4°48'00"
L=240.00'

CURVE DATA
Exist U.S. 666 &
Total Curve
Δ=34°30'00"Lt.
R+0=1638.14'
L=1195.71'
T=613.64'
Main Curve
Δ=27°09'00"
D=3°30'00"
R=1637.02'
L=775.71'
Spiral
a=1 2/3
Δ=3°40'30"
L=210.00'

CURVE DATA
N.B. Survey & Constr. &
Total Curve
Δ=24°37'16"Lt.
R+0=4583.80'
L=2094.69'
T=1062.82'
Main Curve
Δ=23°03'31"
D=1°15'00"
R=4583.66'
L=1844.69'
Spiral
a=1
Δ=0°46'53"
L=125.00'

Sec. Cor. Fd. 2½" Pipe with B.L.M. Brass Cap 1968

Click here for US 191 Index

REDUCED SIZE DO NOT SCALE

SAFFORD-SPRINGERVILLE HWY.
THREE WAY-SMELTER HILL
GREENLEE COUNTY

REVISIONS				PROJECT NO.	F-051-2-803
C.O. NO.	DATE	BY	DESCRIPTION	DRAWING NO.	D-6-T-121
5330	6-20-79	Rose	Added Equita. Proj. Limits at Sta. 1150+00 & 1201+00	SHEET NO.	10 of 26
5404	6-27-79	R.L.R.	Chgd. ℄ S.B. on Sec. Line 100' Lt. 1183+43.05	DRAWN BY	G.K.
"	"	"	Called out Constr. Proj. on S.B. E.N.B. C.E.S. (5)	DATE COMP.	12-28-78
5861	7-1-81	R.L.R.	Removed & extended pipes. Added & deleted gates etc. C.E.S. (23)	SCALE	1"=100'
"	"	"			

HARD COPY 2652 M/17A & M/18A CHECKED BY Jim Eckstrom

BRUNING 44-512

Click here for US 191 Index

CURVE DATA
S.B. Survey & Constr. ℄
Total Curve
Δ=28°29'58"Rt.
R+0=1910.73'
L=1149.98'
T=585.24'
Main Curve
Δ=22°29'58"
D=3°00'00"
R=1909.86'
L=749.98'
Spiral
a=1½
Δ=3°00'00"
L=200.00'

CURVE DATA
Exist U.S.666 ℄
Total Curve
Δ=34°00'00"Rt.
R+0=1910.57'
L=1313.33'
T=674.11'
Main Curve
Δ=28°36'00"
D=3°00'00"
R=1909.86'
L=953.33'
Spiral
a=1⅔
Δ=2°42'00"
L=180.00'

CURVE DATA
S.B. Survey & Constr. ℄
Total Curve
Δ=15°29'23"Lt.
R+0=2865.16'
L=934.49'
T=469.67'
Main Curve
Δ=12°17'23"
D=2°00'00"
R=2864.79'
L=614.49'
Spiral
a=1¼
Δ=1°36'00"
L=160.00'

CURVE DATA
N.B. Survey & Constr. ℄
Total Curve
Δ=22°01'38"Rt.
R+0=1910.73'
L=934.24'
T=471.87'
Main Curve
Δ=16°01'38"
D=3°00'00"
R=1909.86'
L=534.24'
Spiral
a=1½
Δ=3°00'00"
L=200.00'

CURVE DATA
N.B. Survey & Constr. ℄
Total Curve
Δ=10°20'00"Lt.
R+0=7639.56'
L=1527.78'
T=765.77'
Main Curve
Δ=9°12'30"
D=0°45'00"
R=7639.44'
L=1227.78'
Spiral
a=½
Δ=0°33'45"
L=150.00'

CURVE DATA
Exist U.S.666 ℄
Total Curve
Δ=21°03'00"Lt.
R+0=2292.24'
L=992.00'
T=500.87'
Main Curve
Δ=17°18'00"
D=2°30'00"
R=2291.83'
L=692.00'
Spiral
a=1⅔
Δ=1°52'30"
L=150.00'

Sec. Cor. Fd. 2½" Pipe with B.L.M. Brass Cap 1968

Sec. Cor. Not Fd.

BEG. CONSTR. PROJ. F-051-2(3)S.B.

REDUCED SIZE DO NOT SCALE

7448.092

SAFFORD-SPRINGERVILLE HWY.
THREE WAY-SMELTER HILL
GREENLEE COUNTY

Click here for US 191 Index

REVISIONS				PROJECT NO.	F-051-2-803
C.O. No.	DATE	BY	DESCRIPTION	DRAWING NO.	D-6-T-121
5409	6-1979	R.L.R.	Added & Chgd. Anchor Data & Property	SHEET NO.	11 of 26
"	"	"	Arrows, Called out Cattle Passes, Added	DRAWN BY	G.K.
"	"	"	For. Bubble for L-2 in NE¼SE¼ Sec. 21.	DATE COMP.	12-28-78
"	"	"	C.E.S. (3)	SCALE	1"=100'
5541	7-1-81	R.L.R.	Added end of constr. proj. F-051-2(23) at 1201+92.77. C.E.S. (23)		
"	"	"			

Sec. Cor. Fd. 2½" Pipe with BLM Brass Cap 1968

T5S R30E

Sec. 28, 27, 22, 21

SE 1/4 SE 1/4

1153.23'

1274.49'

N 00°04'57" W.

POT 1216+74.34 Section Line Tie

1200 1205 1210 1215 1220 1225 1230

6-104 | 6-104 L-2 | 6-104 L-3

CURVE DATA
S.B. Survey & Constr. ℄

Total Curve	Main Curve	Spiral
Δ=10°45'00" Lt.	Δ=9°11'15"	Q=1
R+0=4583.80'	D=1°15'00"	Δ=0°46'53"
L=985.00'	R=4583.66'	L=125.00'
T=493.78'	L=735.00'	

T.S. 1221+03.65

S.C. 1222+28.65 L.T.B. N56°25'12"W

C.S. 1229+63.65 L.T.B. N69°36'27"W

New 5 Wire Game Fence

New 48" Pipe Culv.

New Type 2 Gate

New 6'x7' C.B.C. & Cattle Pass

¼ MS ¼ MS

New 36" Pipe Culv.

New R/W

N55°38'20"W 1081.81'

497.89'

N55°53'52"W 123.63'

L=718.96'
R=4483.66

123.64'
N66°07'48"W

Slope Limits

Exist R/W

100'

S.B. Sur. & Constr. ℄

N55°38'20"W

27' Bit. Permit U.S. 666 Exist ℄

Exist Fence Remove

Exist R/W

70.45'
N. 55°38'20"W.

℄ Exist R/W

Exist 48" C.M.P. To Remain

Exist 6'x7' C.B.C. To Remain Cattle Pass

Exist Fence To Remain

Exist Cattle Guard To Remain

Exist 36" C.M.P. To Remain

Match Line

POT 1201+01.77 Bk. N.B. Sur.
S.T. 1200+92.0 Asbuilt Ahd.

EQUA.

℄ Approx. 1/16 Line

Approx. 1/16 Line

Section Line 2653.02'

T.S. 1222+65.00

S.C. 1224+65.00

C.S. 1228+02.50

S.T. 1230+02.50 Match Line

SE 1/4 SW 1/4

SW 1/4 NW 1/4

NE 1/4 SE 1/4

CURVE DATA
Exist U.S. 666 ℄

Total Curve	
Δ=10°45'00" Lt.	
R+0=2865.37'	
L=737.50'	
T=369.59'	
Main Curve	
Δ=6°45'00"	
D=2°00'00"	
R=2864.79'	
L=337.50'	
Spiral	
Q=1	
Δ=2°00'00"	
L=200.00'	

Skyline View

21 22

¼ Cor Fd. Stone with "145" on West Face

END CONSTR. PROJ. F-051-2(23)

BEG. CONSTR. PROJ. F-051-2(3)

REDUCED SIZE DO NOT SCALE

HARD COPY 7657 M.18A CHECKED BY Yuri de Pena

BRUNING 44-512

SAFFORD-SPRINGERVILLE HWY.
THREE WAY-SMELTER HILL
GREENLEE COUNTY

REVISIONS				PROJECT NO.	F-051-2-803
C.O. No.	DATE	BY	DESCRIPTION	DRAWING NO.	D-6-T-121
5404	6-27-79	R.L.A.	See C.O. For Revisions. CFS.(3)	SHEET NO.	12 of 26
				DRAWN BY	G.K.
				DATE COMP.	12-28-78
				SCALE	1"=100'

CHECKED BY: Kim Castle Jones

HARD COPY 7657 M18A

DRUNING 44-512

CURVE DATA
S.B. Surv. & Constr. ℄
Total Curve
Δ=29°20'15"Rt.
R+0=2292.56'
L=1373.60'
T=700.10'
Main Curve
Δ=24°20'15"
D=2°30'00"
R=2291.83'
L=973.50'
Spiral
Q=1¼
Δ=2°30'00"
L=200.00'

T5S R30E

NE ¼ SW ¼

NW ¼ SE ¼

SW ¼ NE ¼

NE ¼ SE ¼

1230 1235 1240 1245 1250 1255 1260

6-104

6-104 L-3

6-104 L-2

12

22

91

S.C. 1238+50.20
L.T.B. N63°53'50"W

T.S. 1236+50.20

C.S. 1243+23.70
L.T.B. N39°33'05"W

S.T. 1250+23.70

S.T. 1230+88.65

New 5 Wire Game Fence

New 4-144" Struct. Plate Pipe-Cattle Pass.

New Type 2 Gate

Exist. Dirt Rd.

New 16' Grader Rd.
N66°23'20"W

Canyon

L=1015.98'
R=2391.83'

N65°32'48"W
204.35'

561.55'

100'

S.B. Survey & Constr. ℄

N37°53'37"W
204.35'

Slope Limits ℄

N37°03'05"W

New 42" C.M.P.
1607.47'

New 6'x6' Box Culv.
Cattle Pass

New Type 2 Gate

123.64'
N66°07'48"W
New R/W

℄ Exist R/W

Exist 4-Span 10' Conc. Bridge
To Remain
26' Clear Rdwy.

127' Bit. Pavm't.

Exist ℄ U.S. 666

M.P. 158

Exist Fence
Remove

Exist Fence
To Remain

New 36" Pipe Culv.

Assumed Mid. Section Line

Exist 42" C.M.P.
To Remain

Exist 6'x6' C.B.C.
To Remain
(Cattle Pass)

Exist R/W

New R/W

Match Line

Nigger

T.S. 1235+20.00

S.C. 1237+20.00

℄ Approx. Wig Line

Stock Pen

Exist. Dirt Rd.

CURVE DATA
Exist U.S. 666 ℄
Total Curve
Δ=29°21'00"Rt.
R+0=2865.37'
L=1667.50'
T=850.38'
Main Curve
Δ=25°21'00"
D=2°00'00"
R=2864.79'
L=1267.50'
Spiral
Q=1
Δ=2°00'00"
L=200.00'

C.S. 1249+87.50

S.T. 1251+87.50

¼ Cor. Stone with "¼S" on West Face

¼ Cor. Fd. Stone with "¼" on North Face

REDUCED SIZE
DO NOT SCALE

Click here for US 191 Index

SAFFORD-SPRINGERVILLE HWY.
THREE WAY-SMELTER HILL
GREENLEE COUNTY

REVISIONS				PROJECT NO.	F-051-2-803
C.O No.	DATE	BY	DESCRIPTION	DRAWING NO.	D-6-T-121
5404	6-3779	R.L.R.	Added Anchor bars For Par 6-104.61-2.	SHEET NO.	13 of 26
"	"	"	Called out Constr. Features as per C.S.(3)	DRAWN BY	G.K.
				DATE COMP.	12-28-78
				SCALE	1"=100'

CHECKED BY: Jim Quarles

HARD COPY, 7657 M19A

SRUKING 44-512

R30E

T5S

Sec. Cor. Fd. Stone with 4 Slashes on East Face 3 Slashes on South Face

CURVE DATA
S.B. Sur. & Constr. ℄
Total Curve
Δ=21°14'55" Rt.
R+0=4583.80'
L=1824.89'
T=922.35'
Main Curve
Δ=19°41'10"
D=1°15'00"
R=4583.66'
L=1574.89'
Spiral
a=1
Δ=0°46'53"
L=125.00'

CURVE DATA
S.B. Sur. & Constr. ℄
Total Curve
Δ=9°00'40" Lt.
R+0=5729.74'
L=1051.11'
T=526.50'
Main Curve
Δ=7°30'40"
D=1°00'00"
R=5729.58'
L=751.11'
Spiral
a=2/3
Δ=0°45'00"
L=150.00'

R/W 38979 to Ariz. Power Co-op, Inc. 7-2-76

SE 1/4 NW 1/4 | NW 1/4 NW 1/4 | SW 1/4 NW 1/4 | SE 1/4 NW 1/4

1260 | 1265 | 1270 | 1275 | 1280 | 1285 | 1290

6-104 | 6-104 L-3 | 6-104 | 6-104 L-3 | 6-104 | 6-104 L-2

New Type 2 Gate
New 16' Grader Rd.
℄ New R/W
Approx. 1/16 Line
Exist. Dirt Rd.
T.S. 1266+31.17
S.C. 1267+81.17
L.T.B. N37°48'05"W
C.S. 1275+32.28
L.T.B. N. 45°18'45" W.
S.T. 1276+82.28
P.O.T. 1279+22.02
Section Line Tie
672.68'
Section Line
528.00'
T.S. 1283+41.09
S.C. 1284+66.09
N0°07'29"W
526.69'
2645.82'
682.15'
Sec. Line
P.O.C. 1288+83.42
Section Line Tie
℄ New R/W
Exist R/W

New 6'x6' C.B.C.
Cattle Pass
New 5 Wire Game Fence

N37°03'05"W 160.747'
N37°16'01"W
148.69'
N37°03'05"W
L=738.00'
R=5629.58'
N45°48'49"W
148.69'
N46°03'45"W
344.29'
314.52'
N45°48'02"W
126.36'
L=308.75'
R=4683.66'
L.T.B. N41°30'15"W
L=1300.49'

100' | 100' | 100' | 100' | 100' | 100' | 100' | 100' | 100' | 100'

Slope Limits
Exist R/W
Exist Fence Remove
S.B. Sur. & Constr. ℄
Exist R/W

U.S. 666 Exist ℄ 27° Bit. Pvmt.
Exist 6x6' C.B.C. To Remain Cattle Pass
Exist Type 2 Gate To Remain
Exist Fence To Remain

Undefined Electric to Duncan Valley Elec. Coop Inc. R/W #57921-6 dtd 11-30-77

T.S. 1266+00.00 | S.C. 1268+00.00 | C.S. 1275+00.00 | S.T. 1277+00.00 | T.S. 1285+10.00 | S.C. 1289+10.00 | Match Line

CURVE DATA
Total Curve
Δ=9°00'00" Lt.
R+0=5729.87'
L=1100.00'
T=550.95'
Main Curve
Δ=7°00'00"
D=1°00'00"
R=5729.58'
L=700.00'
Spiral
a=1/2
Δ=1°00'00"
L=200.00'

2645.16'
N 89°47'14" W

Approx. 1/16 Line

1/4 Cor. Fd. Stone with "1/4" on North Face

1/4 Cor. Fd. Stone with "1/4" on West Face

Match Line

NE 1/4 NW 1/4 | SW 1/4 NW 1/4 | SW 1/4 NE 1/4

6-104 | 6-104-L-2

REDUCED SIZE DO NOT SCALE

Click here for US 191 Index

SAFFORD-SPRINGERVILLE HWY.
THREE WAY-SMELTER HILL
GREENLEE COUNTY

REVISIONS				PROJECT NO.	F-051-2-803
C.O. No.	DATE	BY	DESCRIPTION	DRAWING NO.	D-6-T-121
5904	6-27-79	R.L.A.	Added Constr. Features as per C.P.S. (3)	SHEET NO.	14 of 26
				DRAWN BY	G.K.
				DATE COMP.	12-28-78
				SCALE	1"=100'

HARD COPY 7657 M19A & M20A CHECKED BY Ken Stephens

T5S R30E

CURVE DATA
S.B. Sur. & Constr. ℄
Total Curve
Δ=21°14'55" Rt.
R+O=4583.80'
L=1824.89'
T=922.35'
Main Curve
Δ=19°41'10"
D=1°15'00"
R=4583.66'
L=1574.89'
Spiral
a=1
Δ=0°46'53"
L=125.00'

Exist Dirt Rd.
Exist Dirt Road
Canyon
Approx. 1/16 Line
1/4 SE 1/4 SE 1/4
1/4 SE 1/4 NW 1/4
1/4 NE 1/4 NE 1/4
1290
1295
1300
1305
1310
1315
1320
6-104
6-104 L-3
C.S. 1300+40.98
L.T.B. N 25°35'42" W 126.36
N 25°04'32" W
S.T. 1301+65.98
P.O.T. 306+00
P.O.T. 1309+50
New T.C.E.
Assumed Mid-Section Line
New 5 Wire Game Fence
Exist Dirt Rd.
L=1300.49' R=4683.66'
350'
New 24' Girder Rd.
New Cattle Guard with Gate
N 24°48'50" W
2869.36'
New R/W
Exist R/W
100'
Slope Limits ℄
S.B. Sur. & Constr. ℄
M.P. 159
New 2-10'x8' CBC. & Cattle Passes
Exist C.G. & Gate Remove
Exist Fence Remove
U.S. 666 Exist & 27' Bit. Pavm't.
Exist 6'x7' C.B.C. - Cattle Pass To Remain Extend Lt.
Exist Fence To Remain
Exist 2-10'x8' C.B.C. To Remain Cattle Pass
Exist 2-10'x8' C.B.C. To Remain Cattle Pass
C.S. 1295+72.50
S.T. 1299+72.50
Sec. Cor. Fd. Stone with 4 Slashes on East Face 3 Slashes on South Face
Match Line
1/4 MS 1/4 MS
CURVE DATA
Exist U.S. 666 ℄
Total Curve
Δ=21°15'00"
R+O=2867.12'
L=1462.50'
T=737.83'
Main Curve
Δ=13°15'00"
D=2°00'00"
R=2864.79'
L=662.50'
Spiral
a=½
Δ=4°00'00"
L=400.00'
Section Line 2645.82' N 0°07'29" W
6-104
6-104-L-2
OWL
REDUCED SIZE DO NOT SCALE
1/4 Cor. Fd. Stone with "1/4" on West Face
L1
91
20
12

Click here for US 191 Index

EXHIBIT 4-S12

SAFFORD-SPRINGERVILLE HWY.
THREE WAY-SMELTER HILL
GREENLEE COUNTY

REVISIONS				PROJECT NO.	F-051-2-803
C.O. No.	DATE	BY	DESCRIPTION	DRAWING NO.	D-6-T-121
5404	6-27-79	R.L.M.	Added Anchor Bars Pac. 6-104, Called out exist. Hwy. 27' Bit Pave. C.E.S. (3)	SHEET NO.	15 of 26
				DRAWN BY	G.K.
				DATE COMP.	12-28-78
				SCALE	1"=100'

CHECKED BY. Eric Peterson

HARD COPY 7657 M20A

ETURING 44-512

T5S R30E

Exist. Dirt Rd.

CURVE DATA
S.B. Sur. & Constr. ℄
Total Curve
Δ=18°42'48" Rt.
R+D=3819.97'
L=1397.56'
T=704.42'
Main Curve
Δ=16°27'48"
D=1°30'00"
R=3819.72'
L=1097.56'
Spiral
Q=1
Δ=1°07'30"
L=150.00'

1/4 Cor. Fd. 2½" Pipe with B.L.M. Brass Cap 1968

Assumed Mid. Section Line

CURVE DATA
S.B. Sur. & Constr. ℄
Total Curve
Δ=6°17'49" Lt.
R+D=7639.56'
L=989.59'
T=495.23'
Main Curve
Δ=5°10'19"
D=0°45'00"
R=7639.44'
L=689.59'
Spiral
Q=1/2
Δ=0°33'45"
L=150.00'

1320 1325 1330 1335 1340 1345 1350

#1 MS #1 JN

#1 MS #1 JS

6-104

6-104 L-3

New 5 Wire Game Fence

℄ Approx. 1/16 Line

℄ Exist. Dirt Rd.

T.S. 1330+33.34

S.C. 1331+85.34 L.T.B. N25°22'35"W

New 36" C.M.P.

C.S. 1338+74.93 L.T.B. N30°32'54"W

S.T. 1340+24.93

P.O.T. 1340+87.51 Section Line Tie

L1

T.S. 1342+40.09

S.C. 1343+90.09 L.T.B. N29°59'09"W

New R/W

N24°48'50"W 2869.36'

N25°00'03"W 149.02'

L=680.57'
R=7539.44'

N30°55'26"W 149.02'

284.52' 216.73' 292.26' N30°44'00"W 151.96'

L=728.47'
R=3919.72'
L=1126.78'

New R/W ℄

Exist R/W

100'

Slope Limits ℄

N24°48'50"W

S.B. Sur. & Constr. ℄

N31°06'39"W

Exist Fence Remove

U.S. 666 Exist ℄

27' Bit. Pavm't

Exist. Dirt Rd.

Exist R/W ℄

Exist Fence To Remain

Exist 36" C.M.P. To Remain

Match Line.

#1 NE #1 JS

#1 NE #1 JN

6-104

℄ Approx. 1/16 Line

EQUA. P.O.T. 1329+85.00 Bk. = P.C. 1329+90.00 Ahd.

Exist. Fence

Exist. Windmill

CURVE DATA
Exist U.S. 666 ℄
Δ=5°54'00" Lt.
D=0°30'00"
L=1180.00'
T=590.52'

Section Line 2639.04' N89°59'12"E

P.T. 1341+70.00

#1 MS #1 JS

6-104

T.S. 1348+00.00

Match Line

NE 1/4 NE 1/4

#1 NE #1 MN

Sec. Cor. Fd. 2½" Pipe with B.L.M. Brass Cap 1968

91 L1 8 6

REDUCED SIZE DO NOT SCALE

Click here for US 191 Index

SAFFORD-SPRINGERVILLE HWY.
THREE WAY-SMELTER HILL
GREENLEE COUNTY

REVISIONS				PROJECT NO.	F-051-2-803
C.O. No.	DATE	BY	DESCRIPTION	DRAWING NO.	D-6-T-121
5404	6-27-79	R.L.R.	Added Anchor Bars for E-104 & Constr.	SHEET NO.	16 of 26
"	"	"	Features as per C.O. (3).	DRAWN BY	G.K.
				DATE COMP.	12-28-78
				SCALE	1"=100'

CHECKED BY Ken Detlefsen

HARD COPY 7657 M.20A

BRUNING 44512

CURVE DATA
S.B. Sur. & Constr. ℄
Total Curve
Δ=18°42'48" Rt.
R+D=3819.97'
L=1397.56'
T=704.42'
Main Curve
Δ=16°27'48"
D=1°30'00"
R=3819.72'
L=1097.56'
Spiral
Q=1
Δ=1°07'30"
L=150.00'

6-104
6-104 L-3

℄ Approx. 1/16 Line

P.O.T. 1357+43.18 S.B. Sur. & Constr. ℄
18.00 Lt. P.O.T. 1357+10.00 Exist Ahd.
EQUA.

T5S R30E

N/E 1/4 MS 1/4

S/E 1/4 MS 1/4

Old Safford Road Dirt

1350

New 28' Grader Rd.

P.O.C. 1351+00

S 70°39'44" W (Rad) 100.00

New T.C.E. 157.84'

N 18°12'45" W

P.O.C. 1352+57

S 12°54'44" W (Rad) 100.00

New Cattle Gd. with Gate
Exist C.G. & Gate Remove

L=243.89'

R=3819.72'

C.S. 1354+87.65

1355

151.98'
N 12°46'29" W

S.T. 1356+37.65

1356

New 5 Wire Game Fence
L=728.47'
New R/W
Exist Fence Remove
Exist R/W
S.B. Sur. & Constr. ℄

Slope Limits

℄ Exist R/W

Exist Line Fence To Remain

N 12°23'51" W

2 Miles To Clifton

BRG. EQUA. N 12°23'20" W Bk. = N 12°24'00" W Ahd.

U.S. 666 Exist ℄
27' Bit. Pavmt.
M.P. 160

℄ Exist R/W

Exist Fence To Remain

Exist Dirt Rd.

℄ Exist R/W

CURVE DATA
Exist U.S. 666 ℄
Total Curve
Δ=18°18'00" Rt.
R+D=1911.82'
L=910.00'
T=457.91'
Main Curve
Δ=9°18'00"
D=3°00'00"
R=1909.86'
L=310.00'
Spiral
Q=1
Δ=4°30'00"
L=300.00'

S.C. 1351+00.00 Exist U.S. 666

C.S. 1354+10.00 Exist U.S. 666

S.T. 1357+10.00 Exist U.S. 666

Assumed Mid. Sec. Line

Match Line

SW 1/4 SE 1/4

NW 1/4 SE 1/4

END CONSTR. PROJECT
F-051-2(3) S.B.

P.O.T. 1357+43.18

P.O.T. 1358+00

END R/W PROJECT
F-051-2-803

BEG. R/W PROJ.
S-218-503
A-G-T-102

REDUCED SIZE DO NOT SCALE

℄ Exist R/W

200'

200'

Exist R/W

To Ward Canyon 1 Mile

Click here for US 191 Index