BOWIE JCT. – SAFFORD HWY.
ARTESIA DRAINAGE EASEMENT
GRAHAM COUNTY

Click here for US 191 Index

REVISIONS				PROJECT NO.	S-207-601
C.O. No.	DATE	BY	DESCRIPTION	DRAWING NO.	D-5-T-219
4660	10-1-76	R.C.O.	Deleted Par. 5-008 & 5-009, added	SHEET NO.	1 OF 1
"	"	"	Note indicating superseding project.	DRAWN BY	C. PEPPER
				DATE COMP.	10-10-75
				SCALE	1"=100'

OWNERSHIP RECORD								ACQUISITION RECORD				
PARCEL NO.	OWNER	DESCRIPTION	TOTAL	AREA REQUIRED GROSS	AREA REQUIRED NET	ESMT. AREA	REMAINDER RIGHT	REMAINDER LEFT	COMMISSION APPROVAL	TYPE & DATE OF INSTRUMENT	RECORDED DATE	RECORDED BOOK	RECORDED PAGE
~~5-008~~	~~DELBERT HARRIS, et ux~~	~~Pt. of NW¼ NE¼, Sec. 32, T.8S. R.26E.~~	~~5.95 Ac.~~	DELETED 10-1-76		~~TCE .10 Ac. DE .10 Ac.~~	~~4.95 Ac.~~						
~~5-009~~	~~LAVON PECK, et ux~~	~~Pt. of W½ NE¼, Sec. 32, T.8S. R.26E.~~	~~1.25 Ac.~~	DELETED 10-1-76		~~TCE .05 Ac. DE .05 Ac.~~	~~1.20 Ac.~~						

PRINTED
OCT 20 1976
R/W PLANS
PHOENIX, ARIZONA

R/W PLANS FILE SET

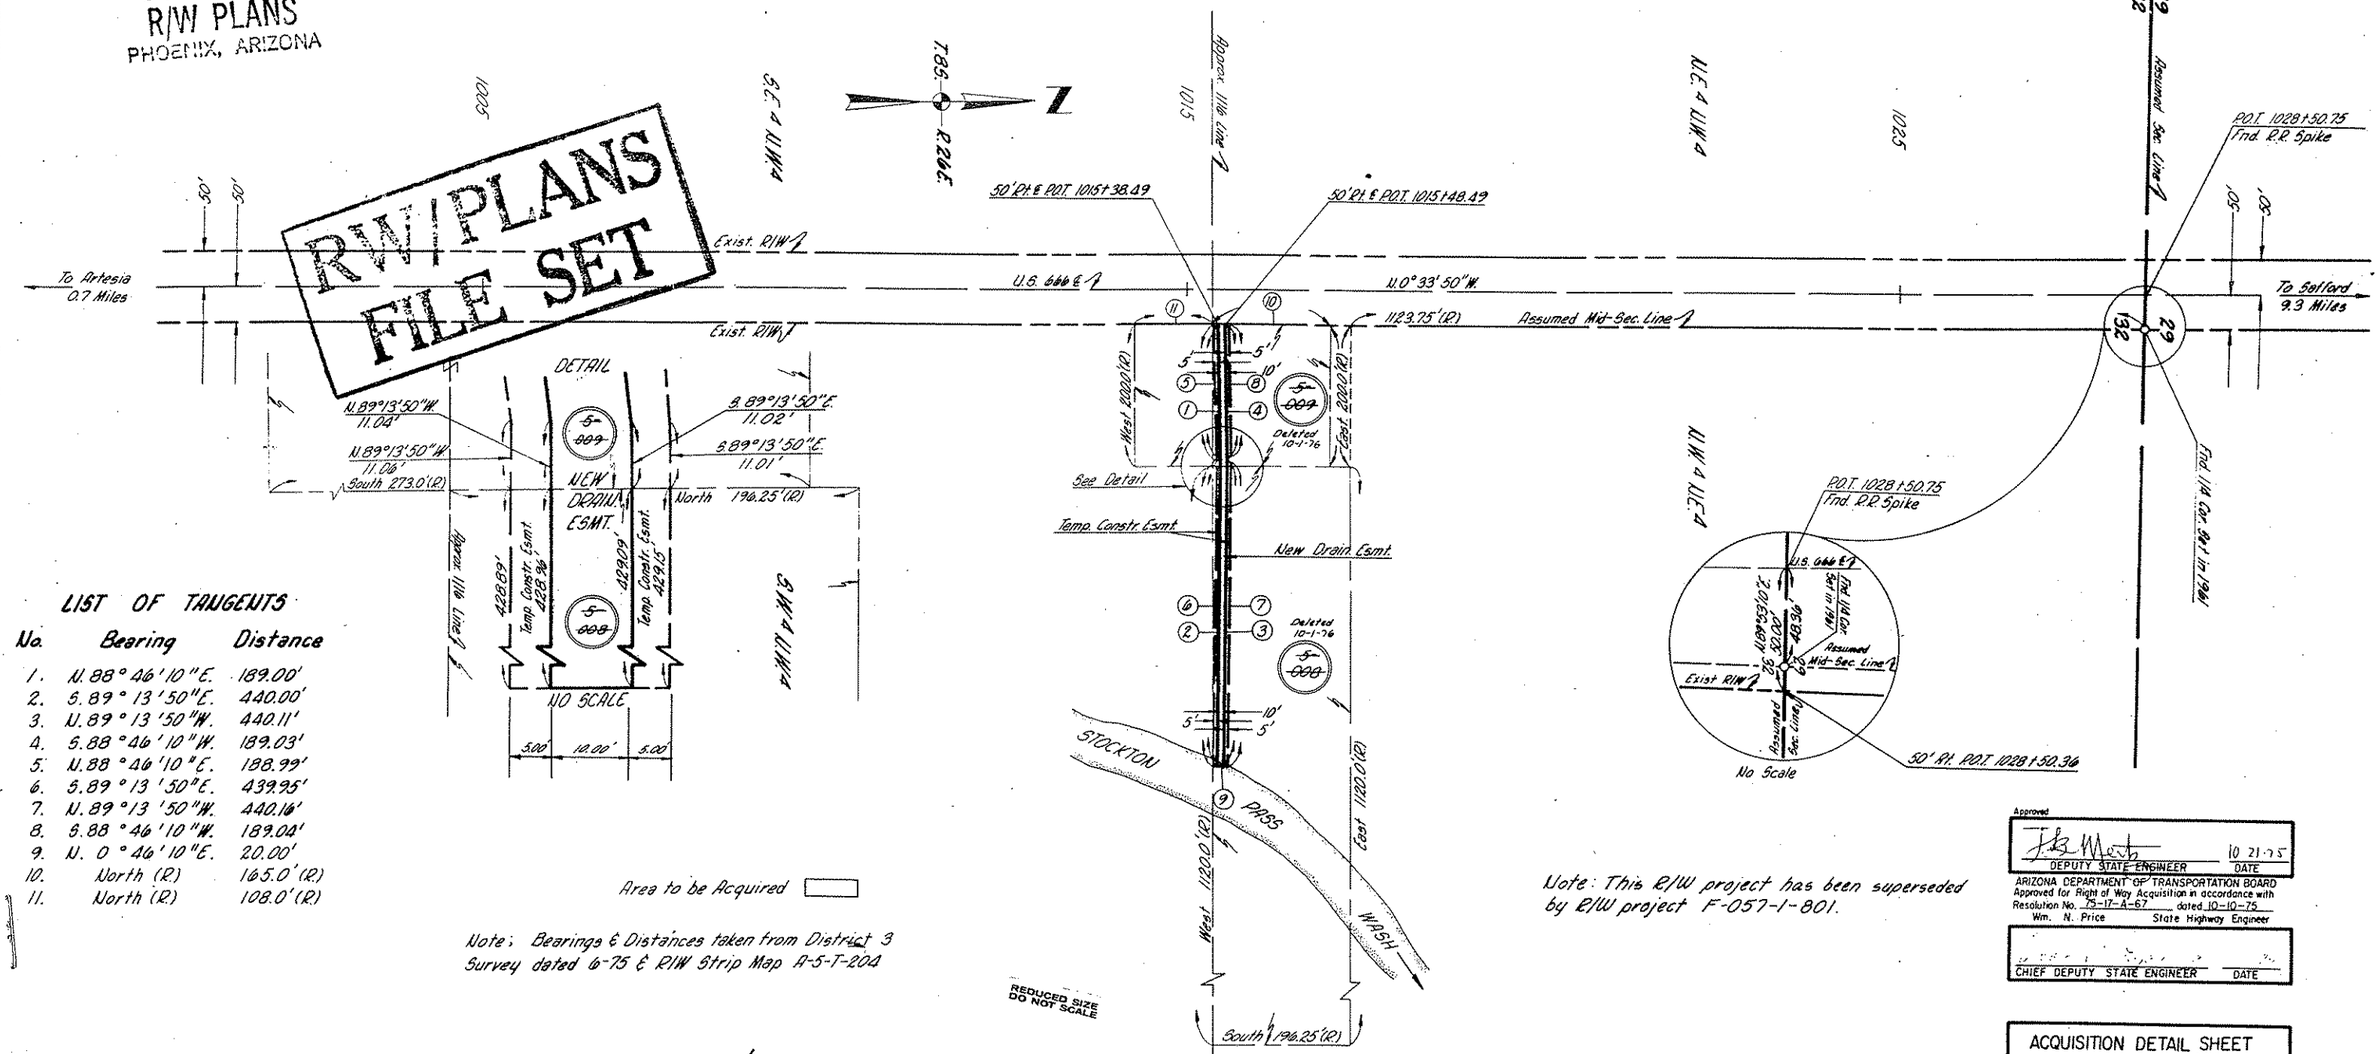

LIST OF TANGENTS

No.	Bearing	Distance
1.	N. 88° 46' 10" E.	189.00'
2.	S. 89° 13' 50" E.	440.00'
3.	N. 89° 13' 50" W.	440.11'
4.	S. 88° 46' 10" W.	189.03'
5.	N. 88° 46' 10" E.	188.99'
6.	S. 89° 13' 50" E.	439.95'
7.	N. 89° 13' 50" W.	440.16'
8.	S. 88° 46' 10" W.	189.04'
9.	N. 0° 46' 10" E.	20.00'
10.	North (R)	165.0'(R)
11.	North (R)	108.0'(R)

Area to be Acquired

Note: Bearings & Distances taken from District 3 Survey dated 6-75 & R/W Strip Map A-5-T-204

Note: This R/W project has been superseded by R/W project F-057-1-801.

Approved
J. B. Martin 10 21 75
DEPUTY STATE ENGINEER DATE
ARIZONA DEPARTMENT OF TRANSPORTATION BOARD
Approved for Right of Way Acquisition in accordance with Resolution No. 75-17-A-67 dated 10-10-75
Wm. N. Price State Highway Engineer
CHIEF DEPUTY STATE ENGINEER DATE

ACQUISITION DETAIL SHEET
Parcel No. 5-008 & 5-009

REDUCED SIZE DO NOT SCALE

C.O.# 4660 Dated 9-29-76 ~~in process, File Set updated~~ 10-20-76

HARD COPY 4-5-T-204 CHECKED BY