FED. ROAD DIV. NO.	STATE	PROJECT NO.	SHEET NO.	TOTAL SHEETS	AS BUILT
7	ARIZ.	F022-2(1)	1	27	

D-7-T-547A

STATE OF ARIZONA
STATE HIGHWAY DEPARTMENT

PLAN AND PROFILE OF PROPOSED

STATE HIGHWAY

WICKENBURG – PHOENIX HIGHWAY

MARICOPA COUNTY

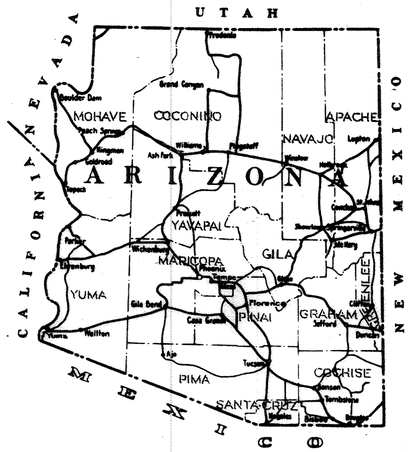

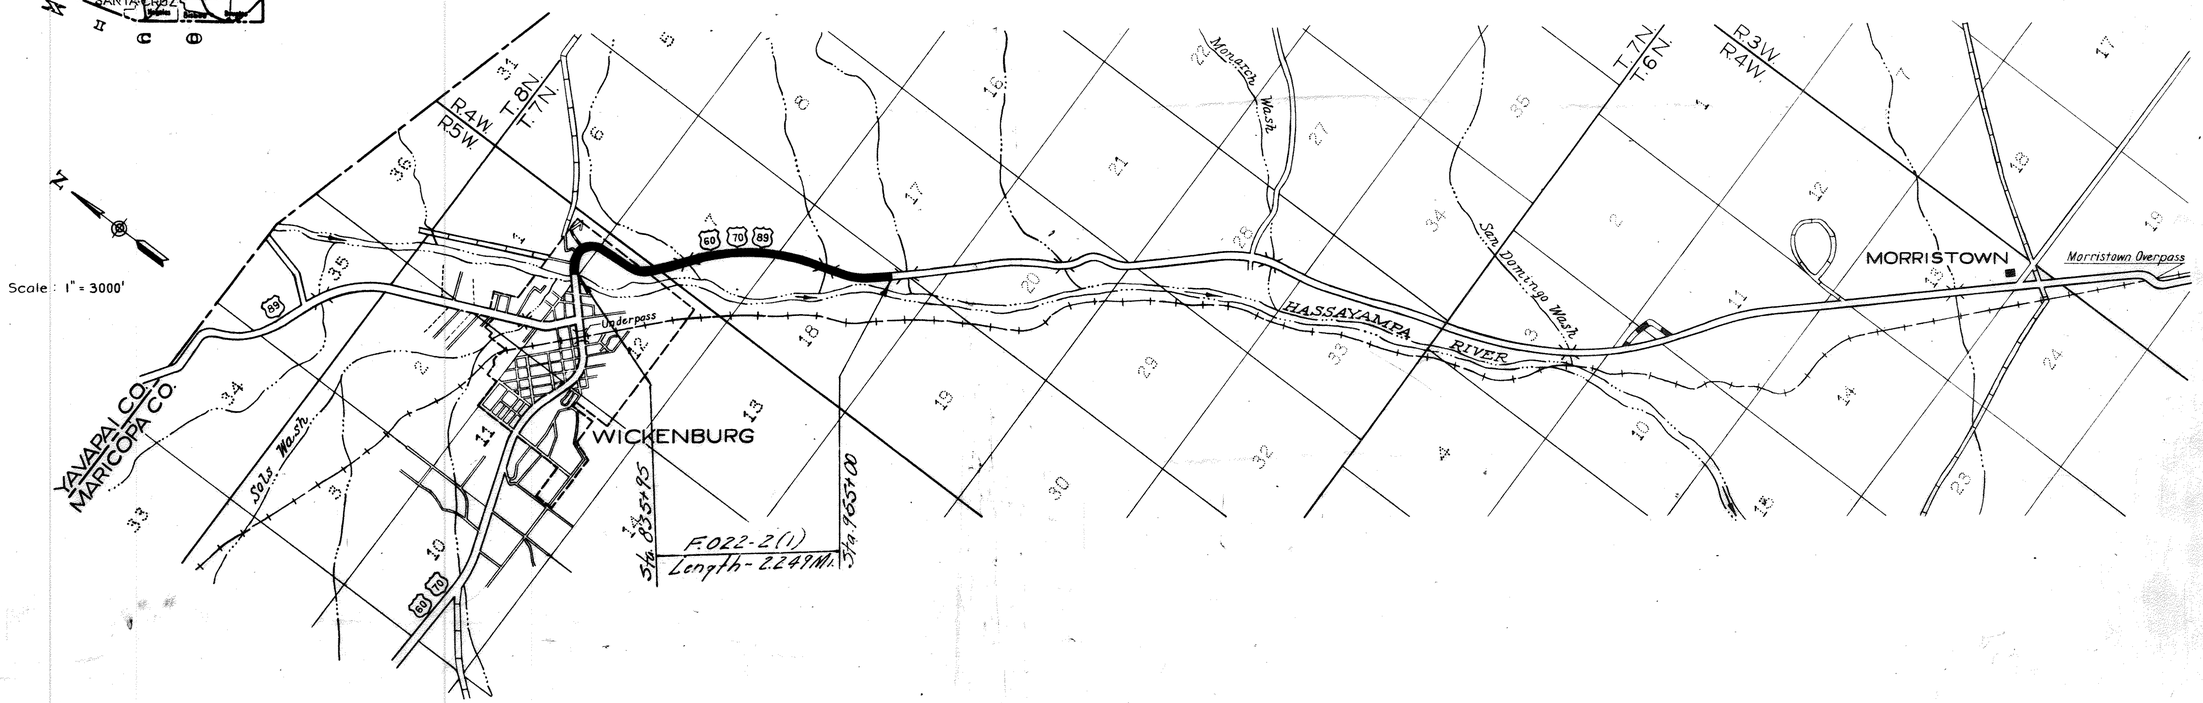

CONVENTIONAL SIGNS

STATE AND NATIONAL LINE
COUNTY LINE
CITY, VILLAGE OR BOROUGH
TOWNSHIP LINE
SECTION LINE
GRANT LINE
FENCE LINE
ROAD GUARD
UNFENCED PROPERTY
RIGHT OF WAY LINE
TRAVELED WAY
RAILROAD
RETAINING WALL
BASE OR SURVEY LINE
ROAD TRAFFIC SIGN

CULVERT, CONCRETE
CULVERT, PIPE
DROP INLET
CATTLE GUARD
POWER POLE
TELEPHONE POLE
CHANNEL OR DITCH
DIKE
GUIDE POST
BRIDGE
GRADE LINE
GROUND LINE
SECTION CORNER (FOUND)
R/W LINE MARKER
TREES AND SHRUBS

ARIZONA STATE HIGHWAY COMMISSION
APPROVED W.M.E. WILLEY
STATE ENGINEER
[redacted]
DATE [redacted] DEP. STATE ENGINEER
RECOMMENDED FOR APPROVAL
[redacted]
DATE [redacted] DISTRICT ENGINEER
RECOMMENDED FOR APPROVAL
[redacted]
DATE [redacted] BRIDGE ENGINEER
RECOMMENDED FOR APPROVAL
[redacted]
DATE [redacted] ENGINEER OF PLANS

DEPARTMENT OF COMMERCE
BUREAU OF PUBLIC ROADS
RECOMMENDED FOR APPROVAL DATE [redacted]
[redacted]
DISTRICT ENGINEER
APPROVED DATE [redacted]
[redacted]
DIVISION ENGINEER

Click here for US 60 Index

WICKENBURG-PHOENIX HWY.
MARICOPA COUNTY

Click here for US 60 Index

FED. RD. DIV. NO.	STATE	PROJ. NO.	SHEET NO.	TOTAL SHEETS	AS BUI
7	ARIZ.	F.022-2(1)	4	27	

D-7-T-547A

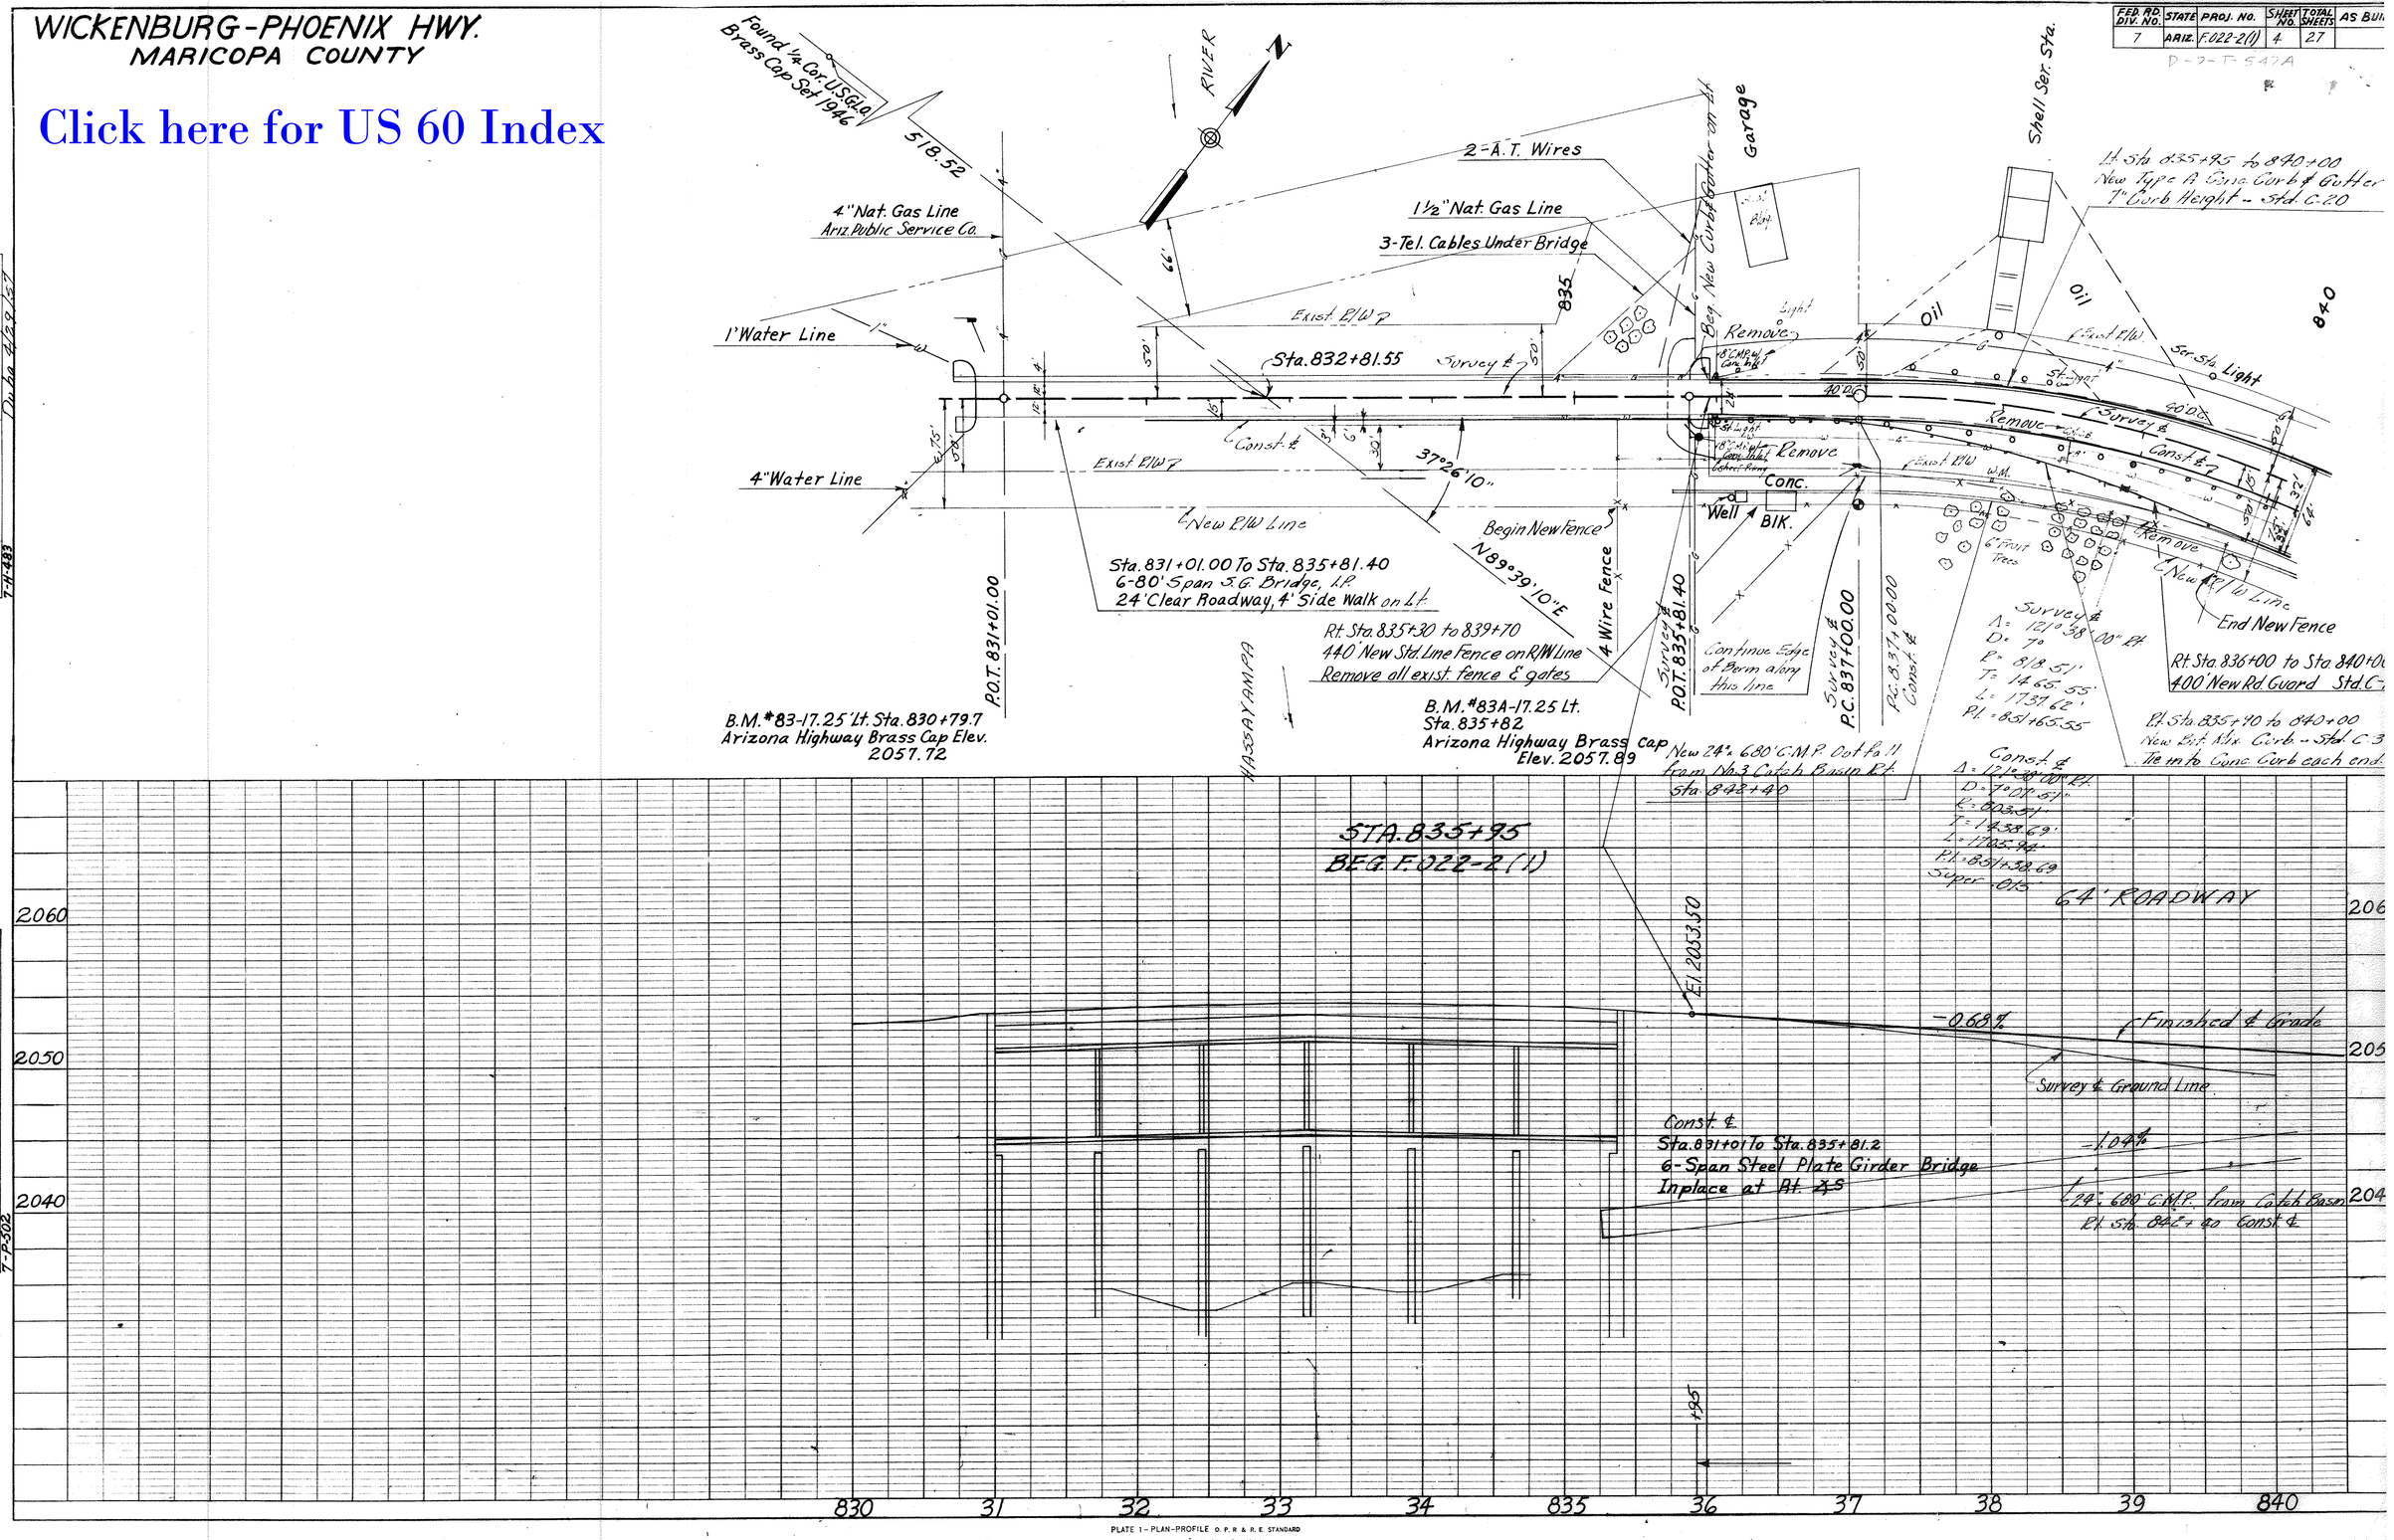

PLATE 1 - PLAN-PROFILE O. P. R. & R. E. STANDARD
KEUFFEL & ESSER CO., NEW YORK.

PLAN — NOTE BOOK NO. 7386-F — SURVEYED — PLOTTED — ALIGNMENT CHECKED — RT. OF WAY CHECKED — BY COOKINGHAM, LESLIE YUP — DATE 6/56, 10/56 — 7-H-483

PROFILE — NOTE BOOK NO. 7-492-A — SURVEYED — PLOTTED — GRADES CHECKED — B. M.'S NOTED — STRUCTURE NOTAT'NS CH'KD. — BY COOKINGHAM, LESLIE YUP — DATE 6/56, 10/56 — 7-P-502

Click here for US 60 Index

FED. RD. DIV. NO.	STATE	PROJ. NO.	SHEET NO.	TOTAL SHEETS	AS B
7	ARIZ.	F.022-2(1)	5	27	

D-7-T-547A

WICKENBURG - PHOENIX HWY.
MARICOPA COUNTY

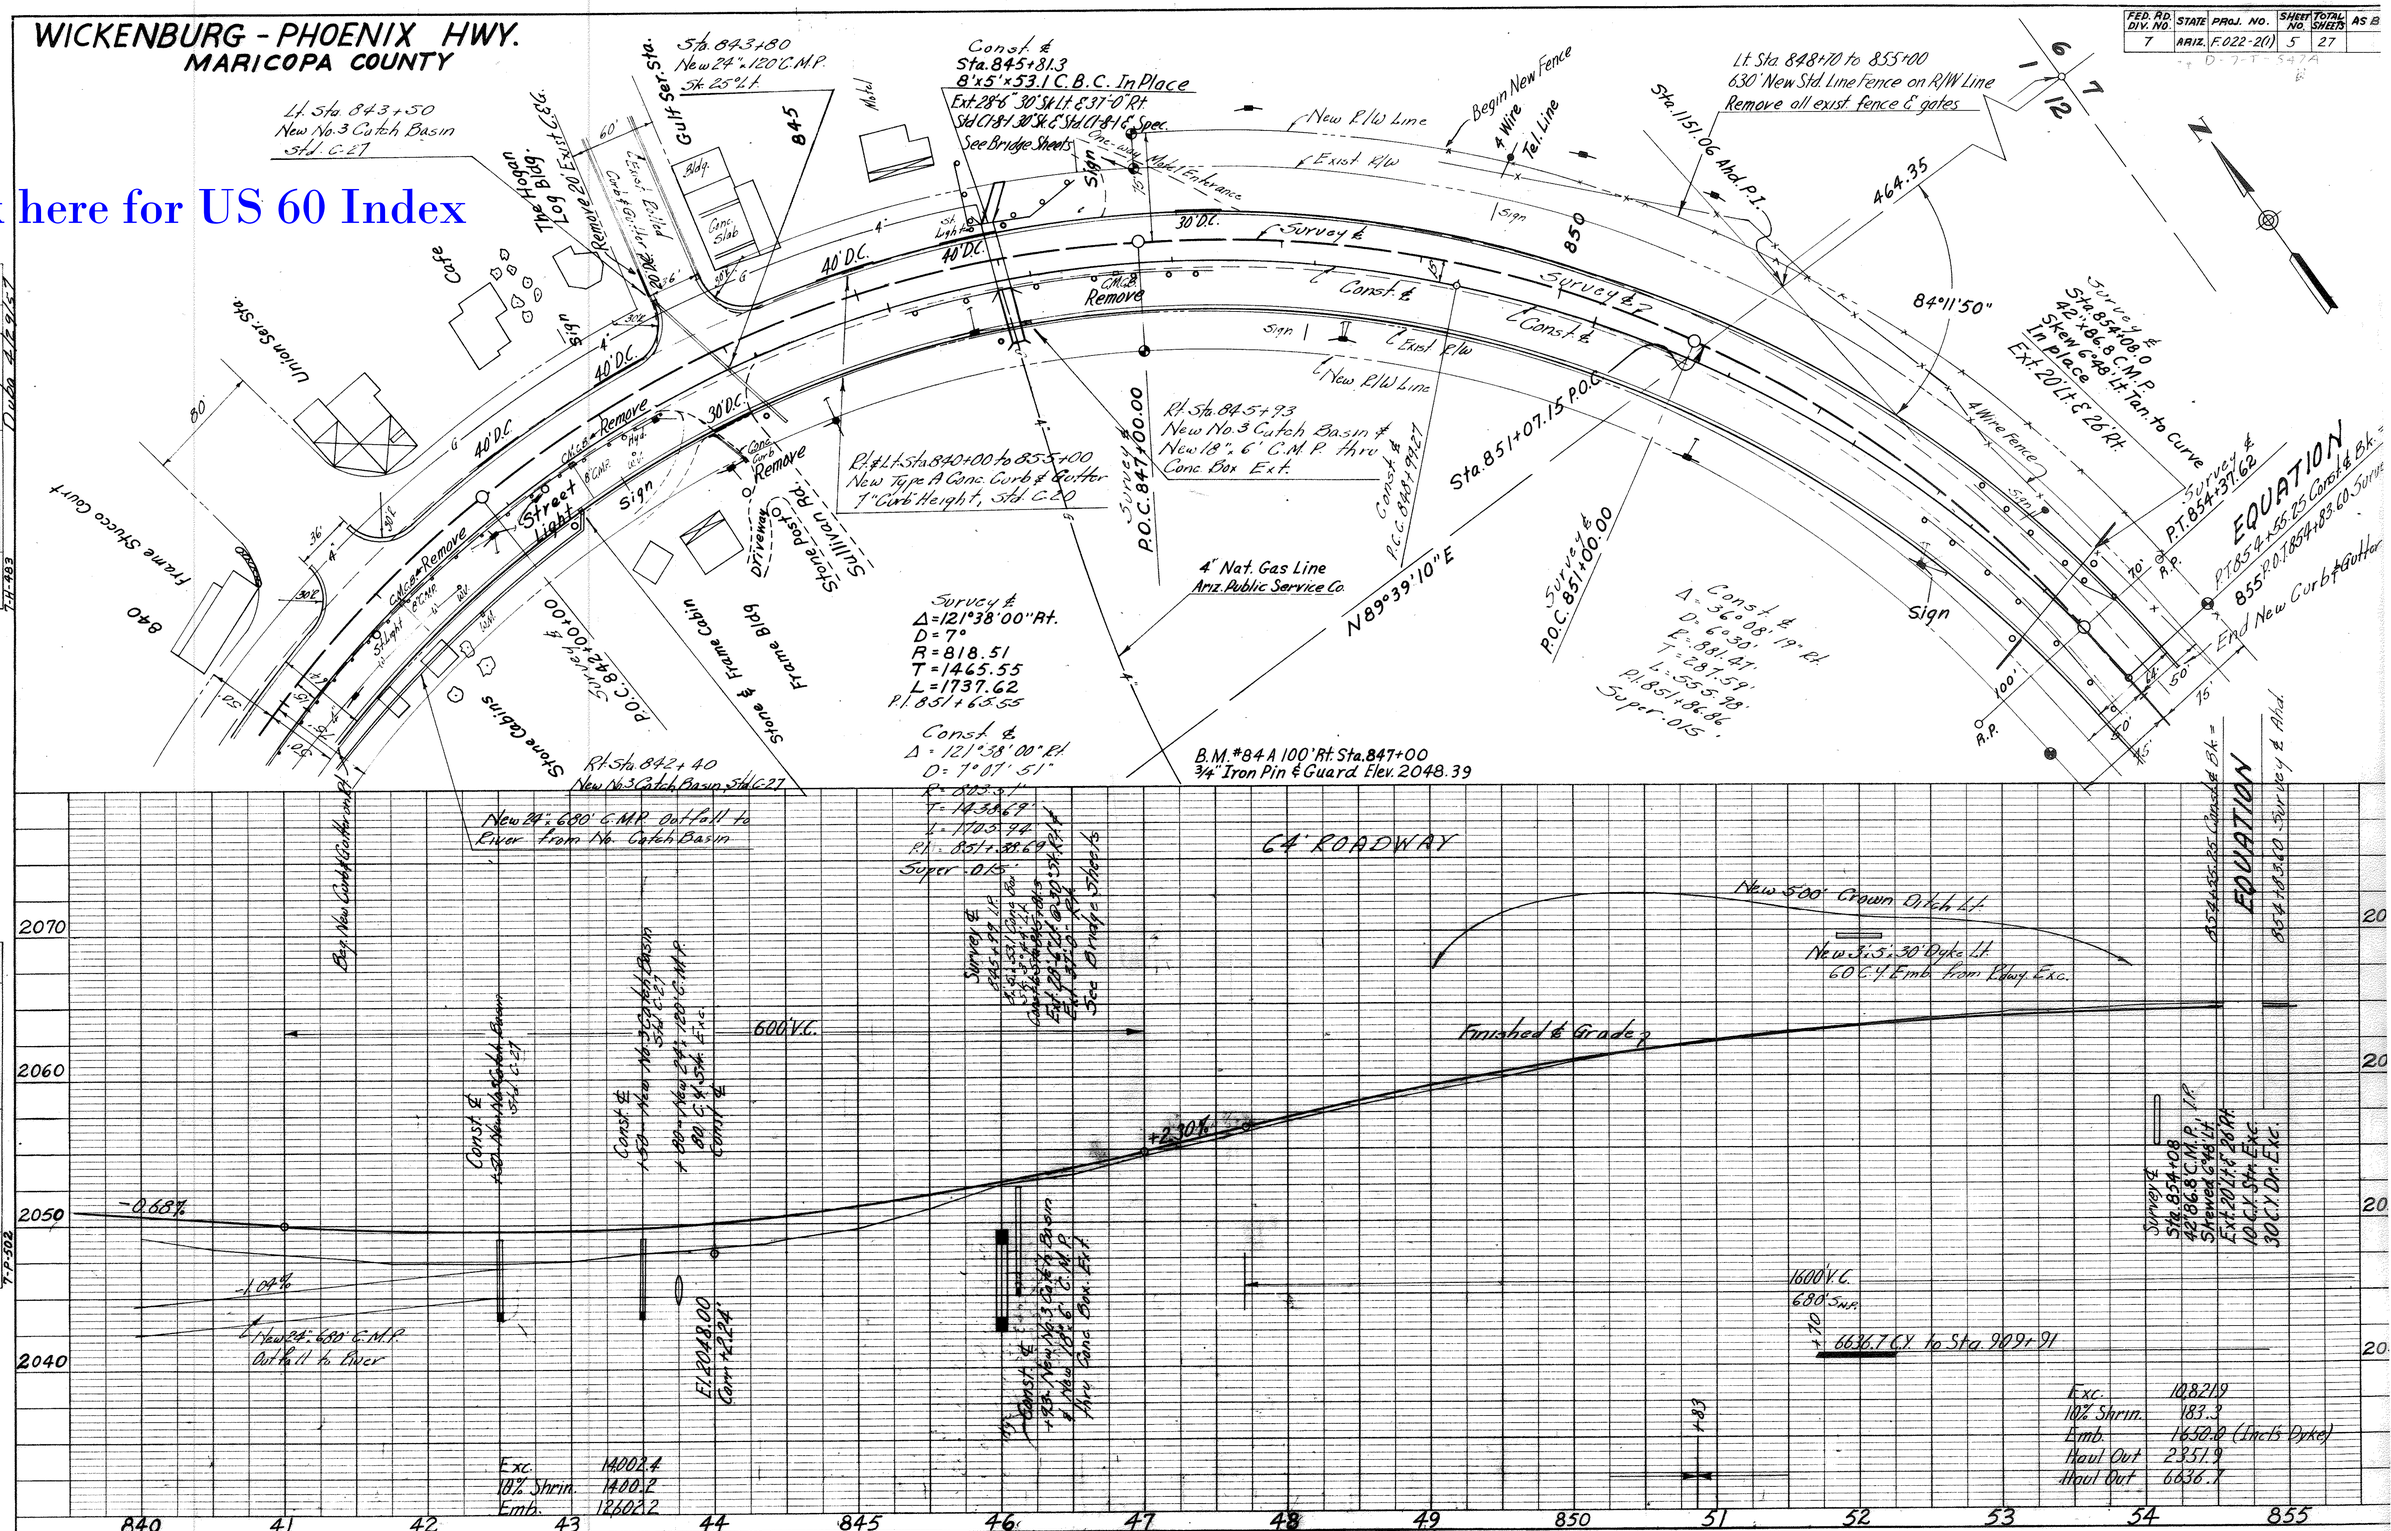

PLAN			
	SURVEYED		
	PLOTTED	COOPER-GRAHAM	6-26
	GRADES CHECKED	LESLIE FOB	6-26
NOTE BOOK	ALIGNMENT CHECKED		
NO. 7-1492	R.L. NOTE		
	RT. OF WAY CHECKED		
7-H-493			

PROFILE			
	SURVEYED		
	PLOTTED	COOPER-GRAHAM	6-26
	GRADES CHECKED	LESLIE FOB	6-26
NOTE BOOK	R.L. NOTE		
NO. 7-1492	STRUCTURE NOTATIONS CH'KD.		
7-P-502			

PLATE 1 - PLAN-PROFILE O.P.R. & R.E. STANDARD

KEUFFEL & ESSER CO., NEW YORK.

FED. ROAD DIV. NO.	STATE	PROJ. No.	SHEET NO.	TOTAL SHEETS	AS BUILT
7	ARIZ.	F.022-2(1)	6	27	

D-7-T-502A

WICKENBURG – PHOENIX HWY.
MARICOPA COUNTY

Click here for US 60 Index

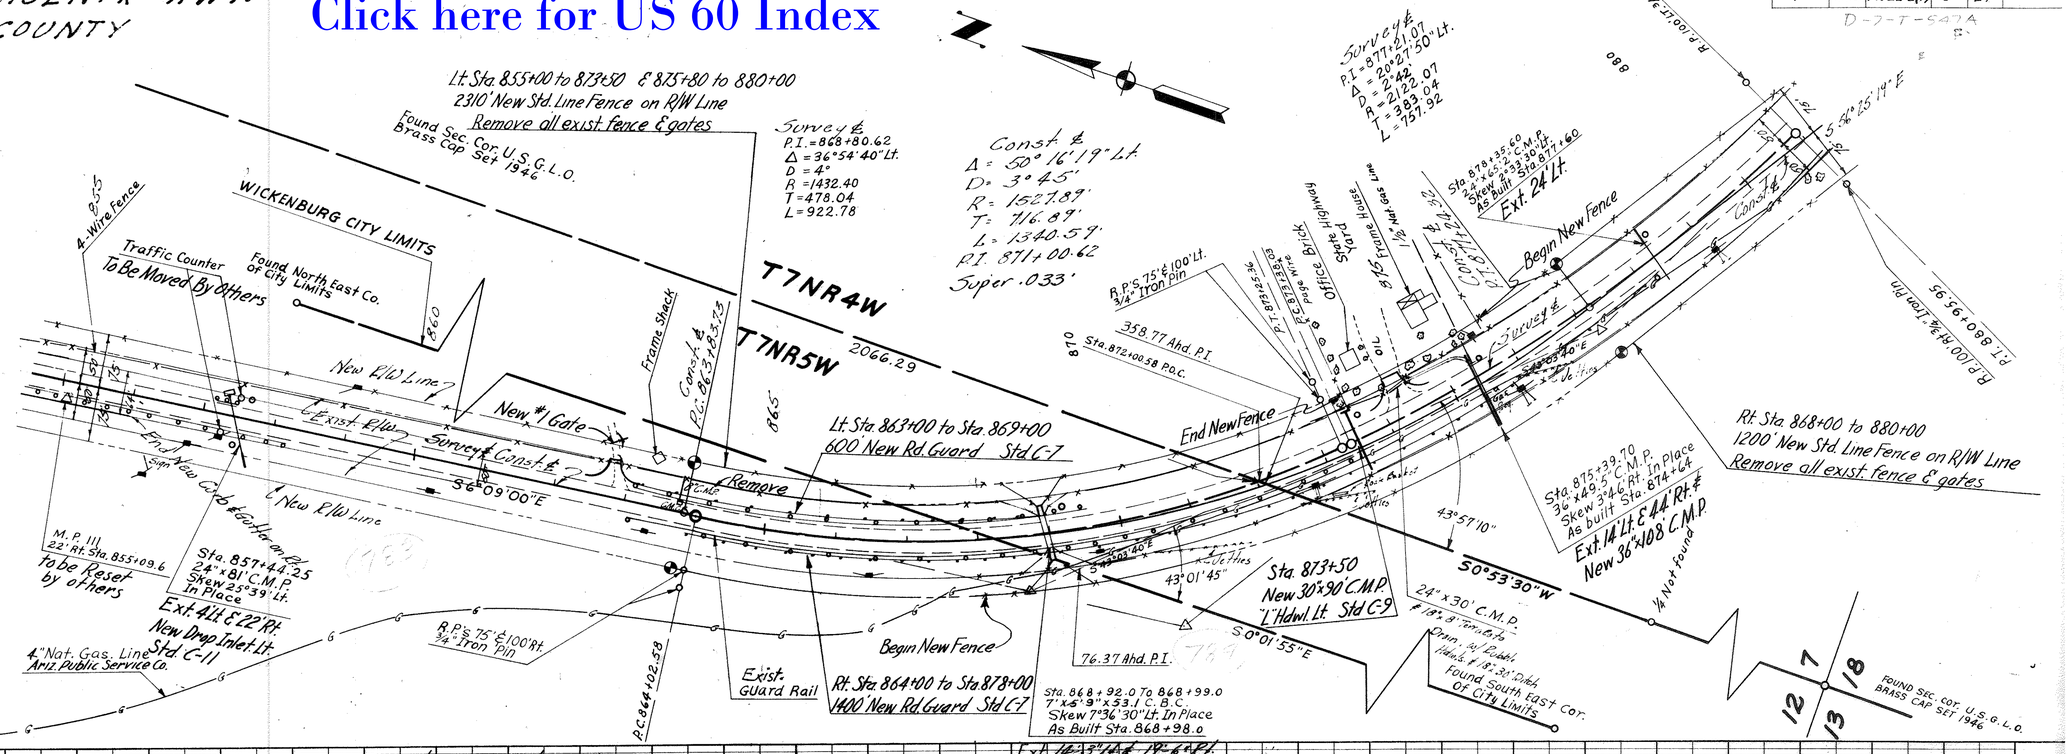

PLAN			BY	DATE
	SURVEYED		COOKINGHAM	6-56
	PLOTTED		L. VIP	9-56
NOTE BOOK	ALIGNMENT CHECKED			
NO. 2366	GRADES CHECKED			
	STRUCTURE NOTATIONS CHKD.			
7-H-483			Duba Alva Jr.	

PROFILE			BY	DATE
	SURVEYED		COOKINGHAM	4-56
	PLOTTED		L. VIP	9-56
NOTE BOOK	GRADES CHECKED			
NO. 2362	ALIGNMENT CHKD.			
	STRUCTURE NOTATIONS CHKD.			
7-P-502				

PLATE 1 – PLAN-PROFILE O. P. R. & M. E. STANDARD
KEUFFEL & ESSER CO., NEW YORK.

WICKENBURG - PHOENIX HWY.
MARICOPA COUNTY

FED. ROAD DIV. NO.	STATE	PROJ. NO.	SHEET NO.	TOTAL SHEETS	AS BUILT
7	ARIZ.	F022-2(1)	7	27	

D-7-T-547A

F ;

Click here for US 60 Index

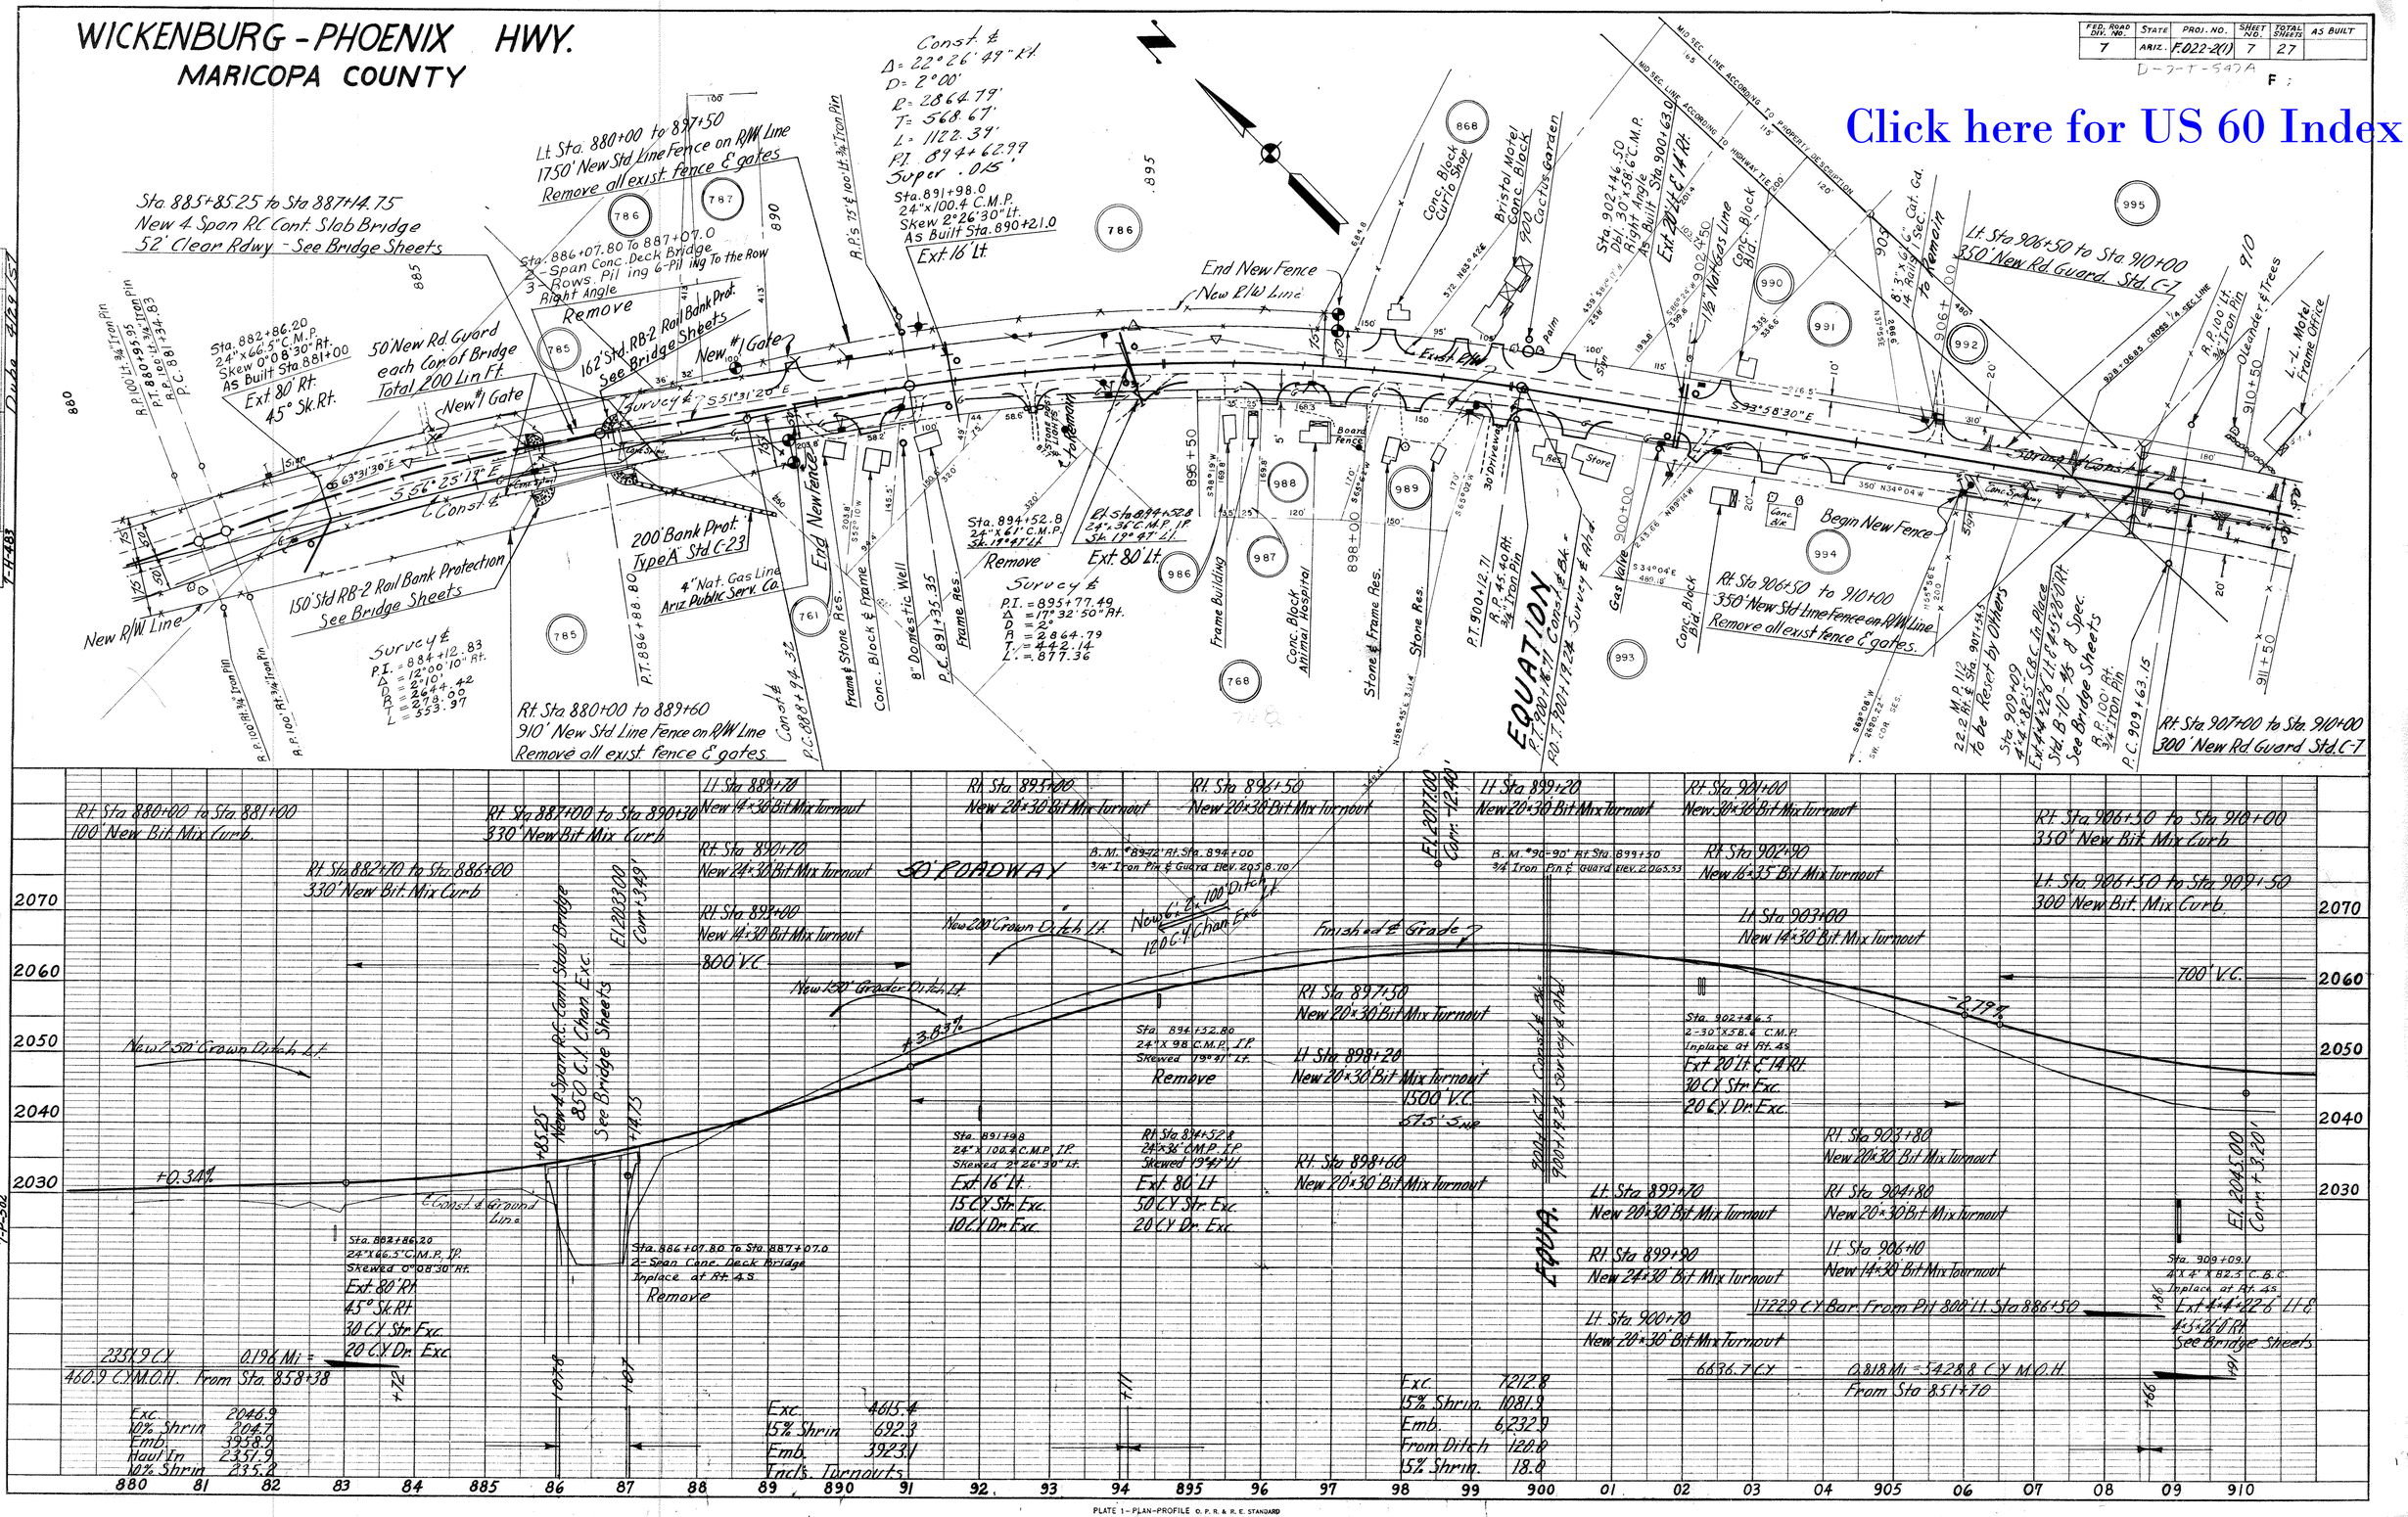

PLATE 1 - PLAN-PROFILE O. P. R. & R. E. STANDARD

PLAN	BY	DATE
SURVEYED		
PLOTTED	COOKINGHAM	4-56
GRADES CHECKED	LESLIE WOOD	9-56
ALIGNMENT CHECKED		
RIT. OF WAY CHECKED		
NOTE BOOK NO. 2386		
STRUCTURE NOTATIONS CH'KD.		
7-H-483	Duke 4/28/57	

PROFILE	BY	DATE
SURVEYED		
PLOTTED	COOKINGHAM	4-56
GRADES CHECKED	LESLIE WOOD	9-56
STRUCTURES CHECKED		
B. M. & NOTED		
STRUCTURE NOTATIONS CH'KD.		
NOTE BOOK NO. 2492		
7-P-502		

Click here for US 60 Index

WICKENBURG-PHOENIX HWY.
MARICOPA COUNTY

FED. ROAD DIV. NO.	STATE	PROJ. NO.	SHEET NO.	TOTAL SHEETS	AS BUILT
7	ARIZ.	F022-2(1)	8	27	

D-7-T-542A

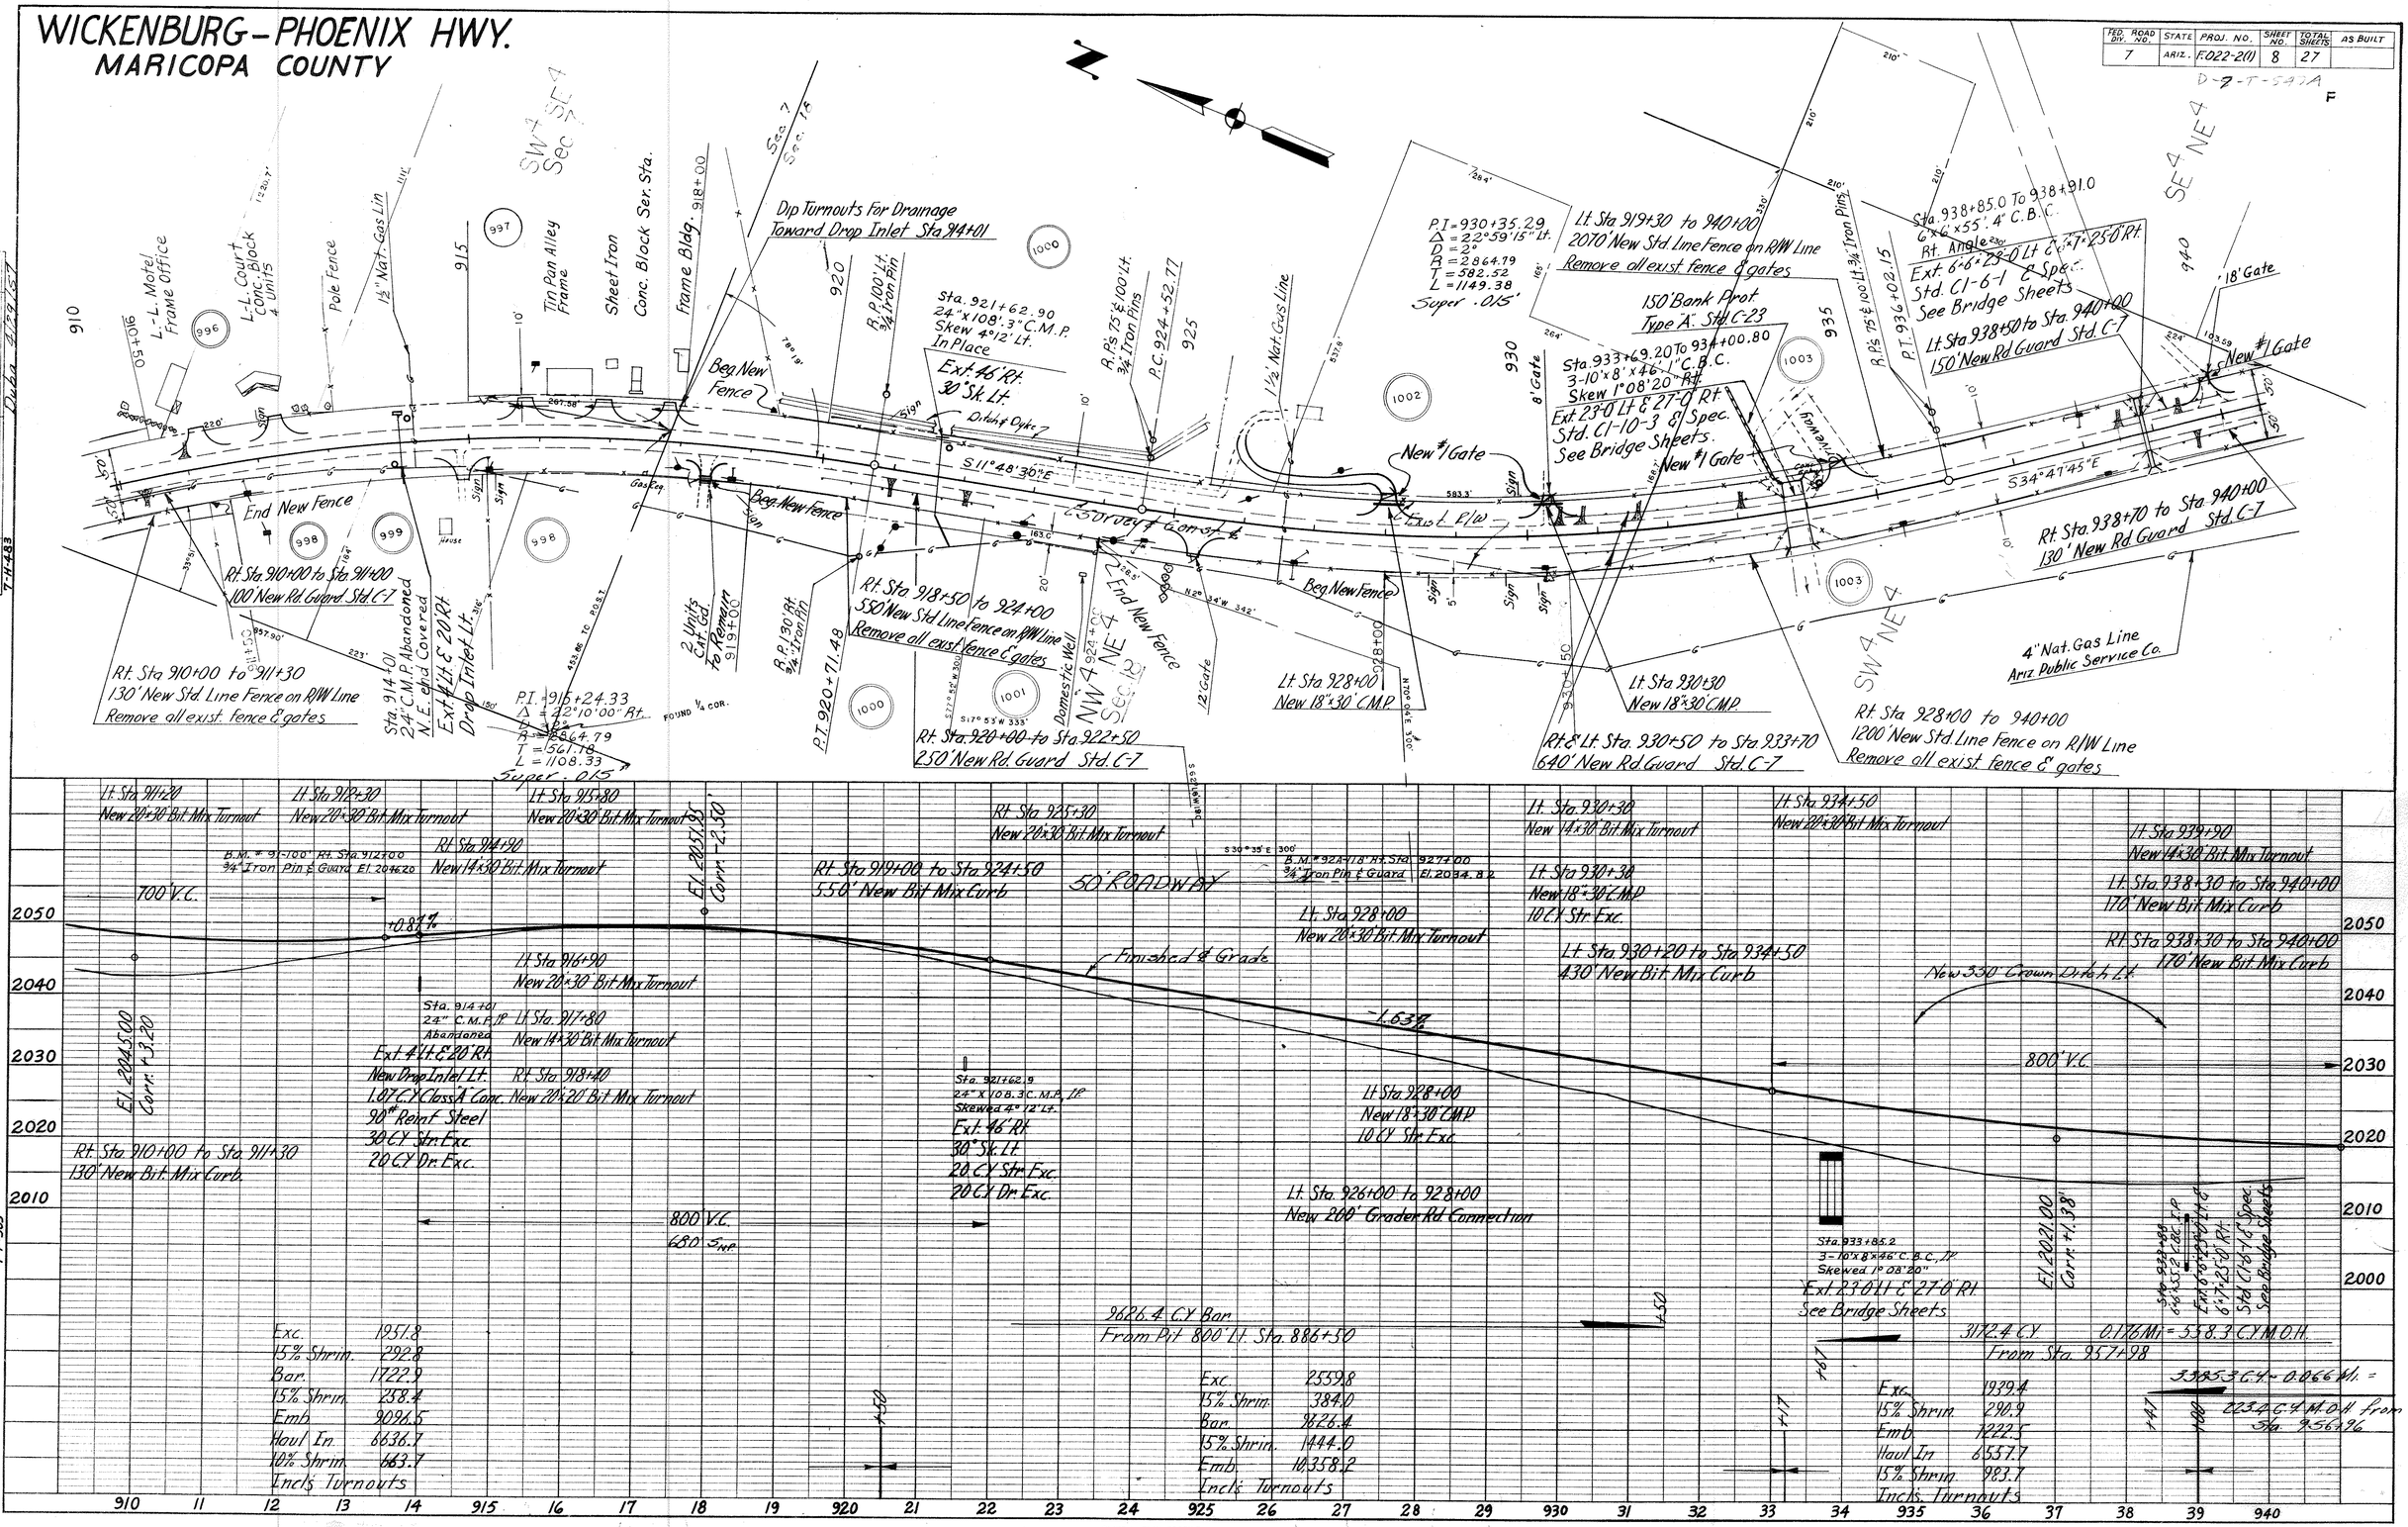

PLAN		BY	DATE
SURVEYED			
PLOTTED		COPPINGHAM	4-56
ALIGNMENT CHECKED		LESLIE KIDD	9-56
RIT. OF WAY CHECKED			
NOTE BOOK 7386		Dubin	4-29-57
NO.	7-H-483		

PROFILE		BY	DATE
SURVEYED			
PLOTTED		COPPINGHAM	4-56
GRADES CHECKED		LESLIE KIDD	9-56
B.M.'S NOTED			
STRUCTURE NOTATNS CH'KD.			
NOTE BOOK 7-4934			
NO.	7-P-503		

PLATE 1—PLAN-PROFILE O. P. R. & R. E. STANDARD

Click here for US 60 Index

WICKENBURG - PHOENIX HWY.
MARICOPA COUNTY

FED. ROAD DIV. NO.	STATE	PROJ. NO.	SHEET NO.	TOTAL SHEET
7	ARIZ.	F.022-2(1)	9	27

D-7-T-541A

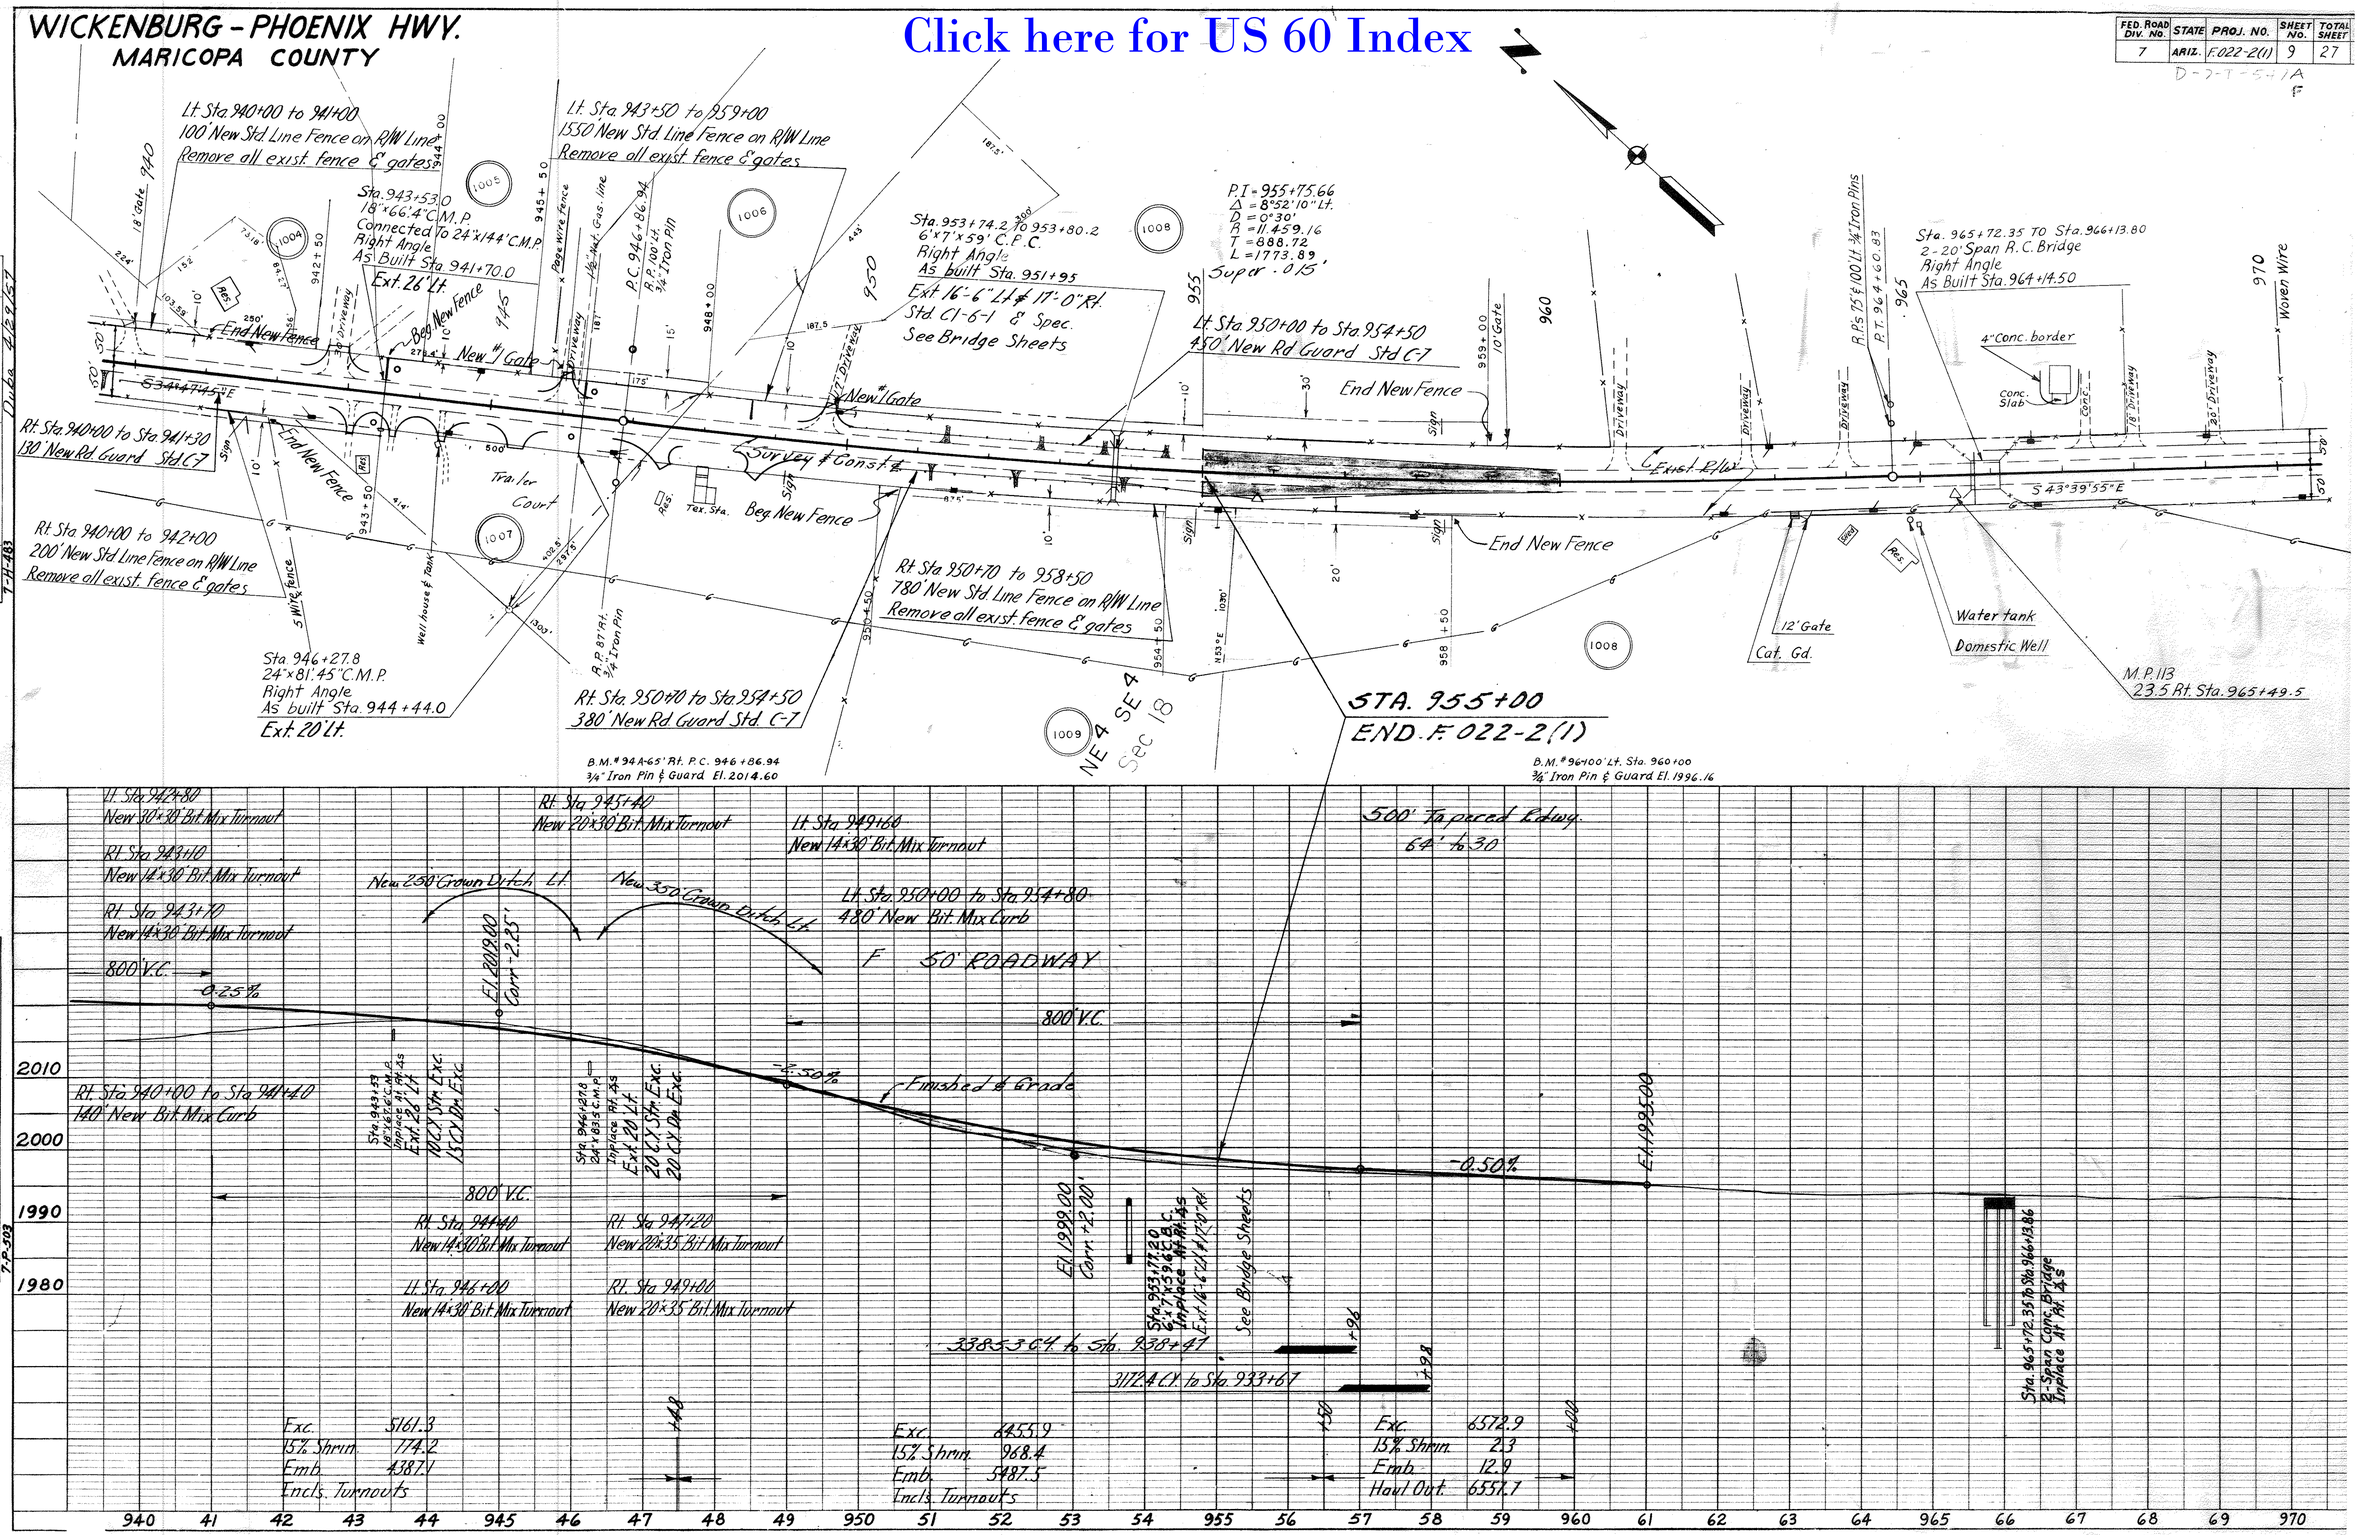

PLATE 1 - PLAN-PROFILE O.P.R. & R.E. STANDARD
KEUFFEL & ESSER CO. NEW YORK

PLAN		BY	DATE
NOTE BOOK NO. 7-386-F	SURVEYED	COOKINGHAM	6-56
	PLOTTED	LESLIE YUP	9-56
	ALIGNMENT CHECKED		
	RT. OF WAY CHECKED		

7-H-483

PROFILE		BY	DATE
NOTE BOOK NO. 7-494-J	SURVEYED	COOKINGHAM	4-56
	PLOTTED	LESLIE YUP	9-56
	GRADES CHECKED		
	B.M.'S NOTED		
	STRUCTURE NOTATIONS CH'KD.		

7-P-503

Duba 4/29/57