PHOENIX - GLOBE HWY.
U.S. 60 at Idaho Rd.
Pinal County

Click here for US 60 Index

REVISIONS				PROJECT NO.	F-022-5-929
C.O. No.	DATE	BY	DESCRIPTION	DRAWING NO.	D-11-T-446
7356	8-12-86	A.F.A.	Added Note & Zip for Abandoned Area.	SHEET NO.	1 of 1
7519	6-16-87	M.J.B.	Revised Area of Abandonment	DRAWN BY	PROJECT ENGINEERING
8791	12-27-93	R.C.O.	ADDED ABANDONMENT NOTE & ZIPPED AREA	DATE COMP.	JUNE 20, 1985
"	"	"	PERFORMED BY DMJM ARIZONA, INC.	SCALE	1" = 50'

OWNERSHIP RECORD									ACQUISITION RECORD				
PARCEL NUMBER	OWNER	DESCRIPTION	TOTAL AREA	AREA REQUIRED: GROSS INCLUDING EXISTING R/W	AREA REQUIRED: NET EXCLUDING EXISTING R/W	EASEMENT AREA	REMAINDER: LEFT	REMAINDER: RIGHT	BOARD APPROVAL	TYPE & DATE OF INSTRUMENT	RECORDED: DATE	RECORDED: BOOK	RECORDED: PAGE
11-285	ROBERT F. ANDERSON et. ux.	PT. S.E.1/4, SEC.20, T·1·N, R·8·E	152,305 ☐'		221 ☐'			152,084 ☐'					

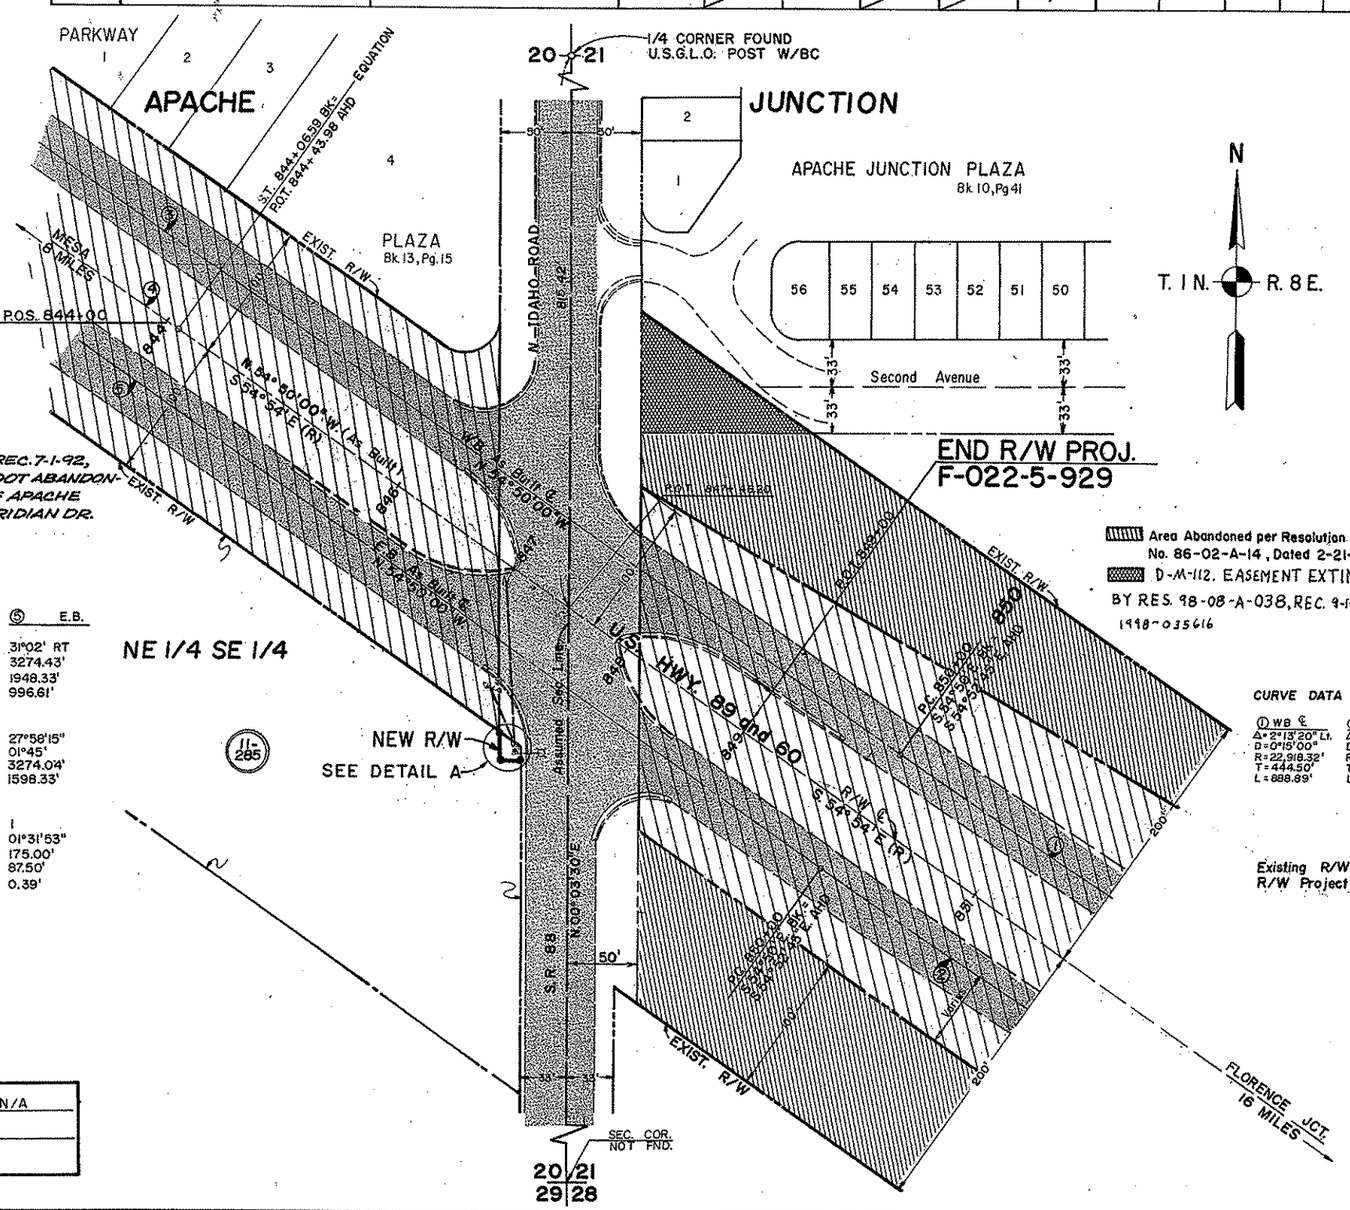

CURVE DATA

		③ W.B.	④ R/W ℄	⑤ E.B.
TOTAL CURVE	I	31°02' RT.	35°02' RT	31°02' RT
	R/0"	2292.97'	2867.12'	3274.43'
	L	1491.33'	2151.67'	1948.33'
	Ts	761.61'	1104.89'	996.61'
MAIN CURVE	Δ	24°47'	27°02'	27°58'15"
	D	02°30'	02°	01°45'
	R	2291.83'	2864.79'	3274.04'
	L	991.33'	1351.67'	1598.33'
SPIRAL CURVE	a	1	1/2	1
	Δ	03°07'30"	04°	01°31'53"
	L	250.00'	400.00'	175.00'
	t	124.99'	199.97'	87.50'
	"0"	1.14'	2.33'	0.39'

CURVE DATA

① WB ℄	② EB ℄
Δ = 2°13'20" Lt.	Δ = 2°13'20" Lt.
D = 0°15'00"	D = 0°14'56"
R = 22,918.32'	R = 23,018.32'
T = 444.50'	T = 446.44'
L = 888.89'	L = 892.77'

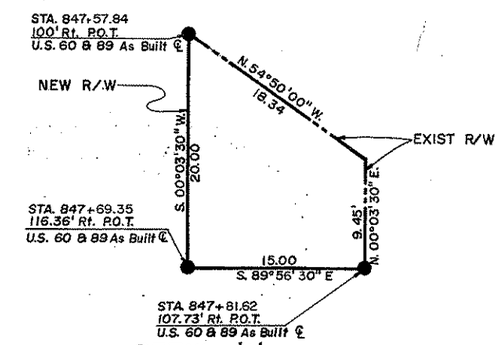

DETAIL 'A'

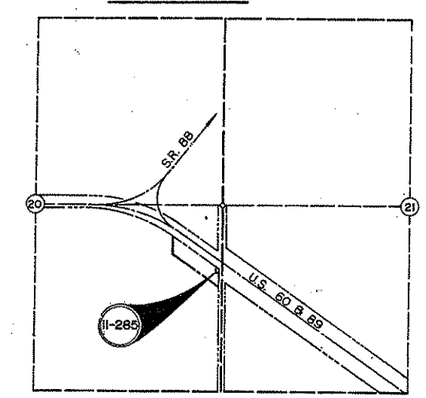

PARCEL INSERT

Scale 1" = 1000'

PUBLIC HEARING REQUIREMENTS CERTIFIED N/A

ENVIRONMENTAL CLEARANCE N/A

APPROVED IN ACCORDANCE WITH ROADWAY PLANS

Robert P. Mickelson 8/5/85
DEPUTY STATE ENGINEER DATE

ARIZONA DEPARTMENT OF TRANSPORTATION BOARD
APPROVED FOR RIGHT OF WAY ACQUISITION IN ACCORDANCE WITH RESOLUTION NUMBER 85-07-A-51
DATED 7-19-85

W.O. FORD STATE ENGINEER

CHIEF DEPUTY STATE ENGINEER 8/8/85 DATE

U.S. DEPARTMENT OF TRANSPORTATION
FEDERAL HIGHWAY ADMINISTRATION

DIVISION ENGINEER DATE

CHECKED BY. Michael J. Bruno

HARD COPY. As Built F-022-3(18) F-022-3(13)