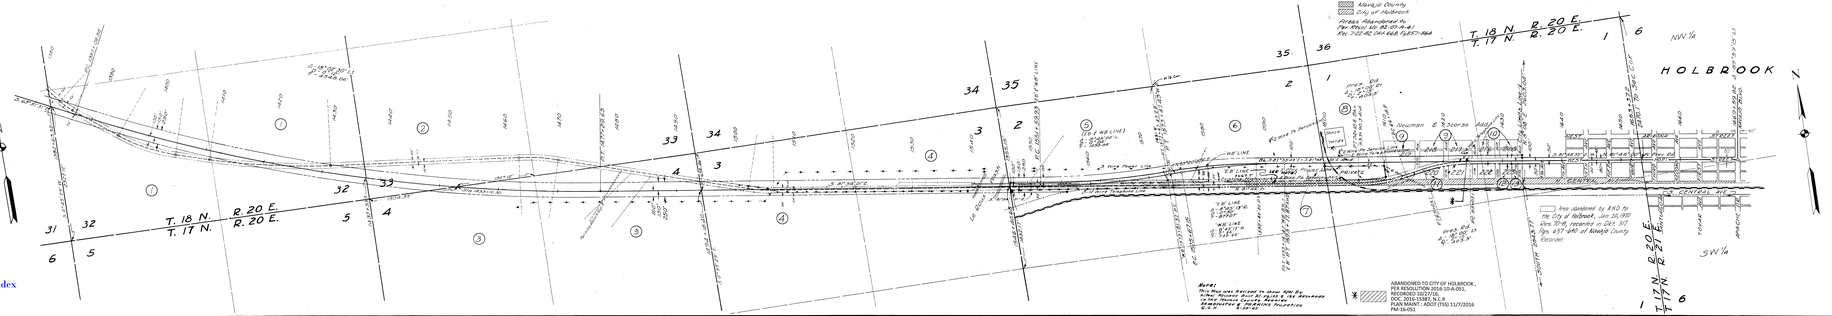

Click here for US 66 Index

OWNERSHIP RECORD		
ITEM	NAME	DESCRIPTION
1	State of Arizona	Sec. 32, T 18 N, R 20 E
2	C.E.&Louella Perkins	W½ Sec. 33, T 18 N, R 20 E
3	Dorothy Louise Perkins Hardgrave	N½N½ Sec. 4, T 17 N, R 20 E
4	J.C. Whiting	W½N½, S½NW¼ Sec. 3, T 17 N, R 20 E
5	Sophie Blumenings	W½S½, Sec. 34, T 17 N, R 20 E
6	J.C. Whiting	NE¼, Sec. 4, exc. SW¼SE¼ T 17 N, R 20 E
7	Ruth Ann Lewis et ux	N½N½ Sec. 10, T 17 N, R 20 E
8	ATCSF Ry. Co.	200' x 1,133.4' in NW Cor. NW¼, Sec. 1, T 17 N, R 20 E
9	Nancy H. Newman	Lots 1 & 2 Blk. 27 FIRST Div. Lots 7, 8, 17 & 18 Blk. 27 Newman & Stone Subdivision
10	Lola Stone Newman	Lots 3 & 4 Blk. 27 Ditto
11	Ditto	Lots 1 & 2 Blk. 28 Ditto
12	James F. Grimes et ux, Floyd Downing et ux	Lots 3 & 4 Blk. 28 Ditto
13	Charles Mandl	Lots 1 & 2 Blk. 28 No Bk/Pg Required

OWNERSHIP CHECK	
DATE	BY

Original scale 25.1296 x 1.8 FAP
Revised to reflect as-built conditions

ARIZONA HIGHWAY DEPARTMENT

RIGHT OF WAY DIVISION
RIGHT OF WAY MAP
WINSLOW-HOLBROOK HWY.

FEDERAL-AID PRIMARY NO. 3-A(8)

F. I. 40
NAVAJO CO.

In accordance with resolution dated minutes of Arizona Highway Commission

Approved for ADA
Acquisitions

Approved for Highways
Assistant Director, Highway Engineer

DRAWN BY:	DATE:	SCALE:	FILE NO.
Hannegan	4-17-1980	1" = 200'	9-5.183

Click here for US 66 Index