Click here for US 66 Index

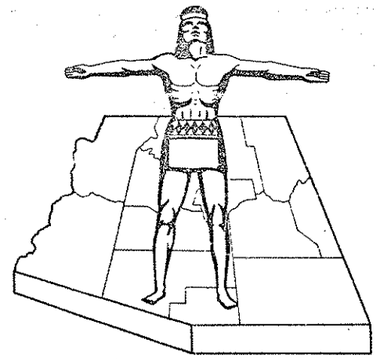

FED.ROAD DIV. NO.	STATE	PROJECT NO.	SHEET NO.	TOTAL SHEETS
7	ARIZ.	NONF-008-2-502	1	13

RIGHT OF WAY MAP NO. D-8-T-265

ALIGNMENT, RIGHT OF WAY, APPROVED IN ACCORDANCE WITH HIGHWAY PLANS.
DATE 12-6-1961 A.B. Lammon
ASSISTANT STATE ENGINEER

APPROVED IN ACCORDANCE WITH RESOLUTION DATED: 19 , NOTES OF THE ARIZONA HIGHWAY COMMISSION.

A.F.E. NO. 6657

FINALIZED R/W PLANS
Complies with as-built plans of project
NONF-008-2-502 R.L.R. 8-54
Approved J.E. Rountree 9-11-64
By
Date approved
DO NOT ERASE

STATE OF ARIZONA
STATE HIGHWAY DEPARTMENT

RIGHT OF WAY PLAN OF THE

KINGMAN-ASHFORK
STATE HIGHWAY

PROJECT NO. NON F-008-2-502

MOHAVE
COUNTY

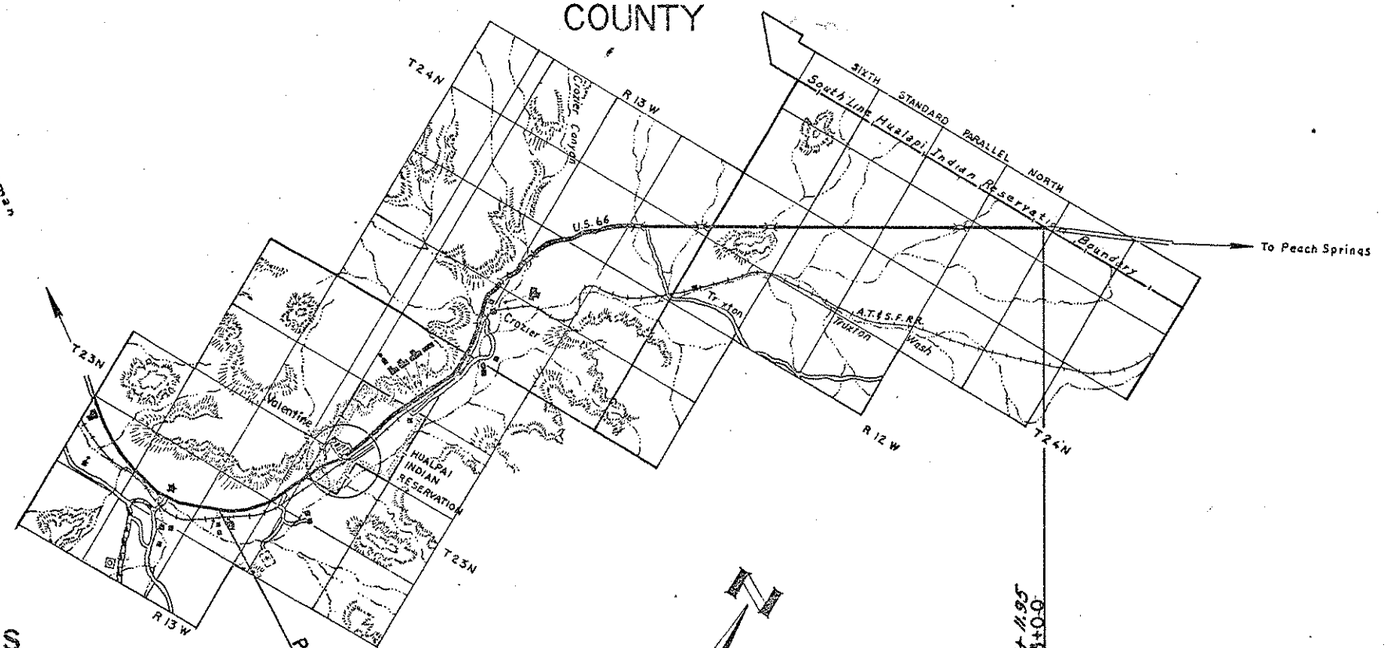

NOTE:

THE SOLID DOT, AS SHOWN BELOW, DOES NOT DESIGNATE A R/W MARKER BUT REPRESENTS AN ANGLE POINT OR CHANGE OF DIRECTION IN THE R/W LINE & IS FOR OFFICE USE ONLY.

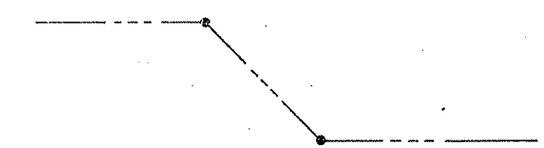

CONVENTIONAL SIGNS

HIGHWAY CENTER LINE
STATE AND NATIONAL LINES
CITY LIMITS
COUNTY LINE
TOWNSHIP AND RANGE LINES
SECTION LINE
HIGHWAY R/W LINE (NEW)
RAILROAD R/W LINE
PROPERTY LINE
LOT AND PROPERTY LINE (WITHIN EXISTING R/W)
RAILROAD
COMMON R.R. AND HWY R/W LINE
ACCESS IS OR DENIED
ACCESS OPEN
PARCEL ITEM Nos.
FOREST, NAT'L. MONUMENTS, AND INDIAN BOUDARIES
LAND GRANT BOUNDARY
R/W MARKER
HIGHWAY R/W LINE (EXISTING)
SUBDIVISION OR LOT LINE

TELEPHONE LINE
POWER LINE
WATER LINE
GAS LINE
SEWER LINE
STORM DRAIN
UNDERGROUND TEL. CABLE
BARBED WIRE FENCE & OTHER
CHAIN LINK FENCE
POWER TRANSMISSION LINE
TELEPHONE & POWER LINE
POWER POLE WITH TRANSFORMER
DOWN GUY
LIGHT POLE
FIRE HYDRANT
WATER METER
WATER VALVE
MANHOLE
EXIST. ROAD OR TRAVELED WAY
GAS METER
GAS VALVE

MAP REVISIONS		
DATE	NAME	DESCRIPTION
12-8-61	Woods	Add'l R/W Lines & Parcels D-455, 456 & D-457-1
12-6-61	Dick C.	Add'tl New R/W Line on Parcels D-455, 456 & D-457-1
12-28-61	L. Draper	R/W Plan R/W in Areas of Sta. 1600 & 1815 South Side of Hwy. Removed Item No. D-457
1-20-62	P. Julian	checked M&P, Put on culverts 3 sta. Made Corrections
2-6-62	P. Julian	Revised R/W between Sta. 1579+00 & 1593+00
4-12-62	Howard	Plotted 50' existing R/W in Hatch Estates
5-16-62	E.L.R.-R.H.W	reduced Ac. on D-458 from 7.65 to 7.01. Showed dedicated area Sta. 2123+93.05. Corrected R/W Rt. 2131 to 2202. Changed Ac. Item D-457 and D-460
7-18-62	D.E.H.	REVISED AREA ON D-458 TO 3.93 AC.

KINGMAN-ASHFORK HIGHWAY
ANNADALE-TRUXTON SECTION
MOHAVE COUNTY

Click here for US 66 Index

REVISIONS		
DATE	BY	DESCRIPTION
4-15-65	J.H.J.	Revised on Item D-451 & D-460

PROJECT NO.	Non F-008-2-502
DRAWING NO.	D-8-T-265
SHEET NO.	2 of 14
DRAWN BY	Pete Julian
DATE COMP.	11-16-61
SCALE	

OWNERSHIP RECORD

ITEM	OWNER	DESCRIPTION		Acreage Taken	Acreage Remaining	Easement Acreage	Sheet No.	ACQ. RECORD Comm. Appl.	Type & Date of Instru.	RECORDED DATE	BOOK	PAGE
D-451	State of Arizona	All Sec. 16.	T-23-N, R-13-W.	10.86	629.10		3&4					
		Lots 1,2,3,4, N½ SW¼, NW¼, N½ NE¼, Sec. 34.	T-24-N, R-13-W	3.01	424.95		7					
		All Sec. 24.	" "	10.18	619.65		9&10					
		E½ NW¼, Sec. 26.	" "	2.29	75.39		8	1-26-62	R/W 12-19-61	NOT	RECORDED	
		All Sec. 18.	" R-12-W	12.19	605.98		10&11					
		All Sec. 8.	" "	8.01	624.12		11&12					
		All Sec. 10.	" "	~~7.82~~ 1.82	~~626.27~~ 625.91		13					
D-451-L1	J.L. Carrow #885	All Sec. 16.	T-23-N, R-13-W.				3&4					
D-451-L2	Lawrence & Stegall Ranches #206	Lots, 1,2,3,4, N½ SW¼, NW¼, N½ NE¼, Sec. 34.	T-24-N, "				7					
		All Sec. 24.	" "				9					
		E½ NW¼, Sec. 26.	" "				8					
	Len Collins et ux	All Sec. 8	" R-12-W				11					
		All Sec. 18.	" "				10&11					
D-452	~~Marion B. Hattenbeck et ux~~	SW¼, Sec. 15.	T-23-N, R-13-W.	1.18	7.45		4					
"	" " " " "	Pts. NE¼, Sec. 21.	" "	4.86	40.70		3	2-20-64	Esm't 2-6-64	3-20-64	69	63-64
D-453	Hualapai Ind. School Reservation	NW¼, Sec. 15.	" "	6.82	146.23		4	1-19-62	R/W 7-26-63	NOT	RECORDED	
		All Sec. 10.	" "	4.89	620.54		4&5					
D-454	Lawrence & Stegall Ranches See Below	N½ NE¼, SE¼ NE¼, E½ SE¼, SE¼ SW¼, Sec. 27.	T-24-N, "	8.97	229.43		7&8					
		All Sec. 23.	" "	11.40	617.57		8&9					
		NE¼, W½ SE¼, W½ NW¼, SW¼, Sec. 26.	" "	8.56	462.26	0.20	8	5-7-65	F.O.C. 7-12-65	1-7-66	87	179-183
		All Sec. 17.	" "	6.10	627.67		11&12					
		All Sec. 13.	" R-12-W.	3.96	632.23		10					
D-455	Don J. Dilts et ux	Pt. NE¼ NE¼, Sec. 9.	" "	~~4764'~~	~~93486'~~		13	11-8-63	Esm't. 8-12-63	1-10-64	67	51-52
D-456	Horace H. Hightower et ux	Pt. NE¼ NE¼, Sec. 9.	" "	~~3600'~~	~~78600'~~		13	8-13-63	Esm't. 5-23-63	9-5-63	64	186-187
D-458	Bridge Canyon Land Development Co.	Pt. Sec. 9.	T24N. R 12 W	5.70 Ac.			12	3-20-64	Esm't. 2-10-64	4-8-64	69	339-340
~~D-459~~	~~W.F. Cattle Company~~	Pt. NE¼ NE¼, Sec. 9	" "	~~4,000'~~	~~21,000'~~		13	Deleted				
D-460	Clyde A. McCune	Pt. NW¼ NW¼, Sec. 10.	" "	~~7500'~~ 7520'	~~50,700'~~ 50,480'		13	5-19-64	Esm't. 2-10-64	7-15-64	72	317-318
D-461	S.G. Hatch et ux	Pt. Sec. 9.	T24N R12W	3148'			13	1-20-65	Esm't. 3-29-64	1-27-65	77	193-195
D-454	Lawrence & Stegall Ranches	Pt. SE¼ NE¼ Sec. 34	T24N R13W	2.88	37.12		7	5-7-65	F.O.C. 7-12-65	1-7-66	87	179-183

LIETZ 1700 IMPERIAL 300 241

D-8-T-265

KINGMAN - ASHFORK HIGHWAY
ANNADALE - TRUXTON SECTION
MOHAVE COUNTY

Click here for US 66 Index

STATE	PROJECT NO.	SHEET NO.	TOTAL SHTS	AS BUILT
ARIZ.	Non F-008-2-502	3	14	

ROBINSON & ASSOCIATES, INC.
FOR THE CONSULTING ENGINEER
DRAWN Schoeffer CHECKED

T23N R13W

Approx. Sec. Line
Approx. 1/16 Line
Approx. Mid Sec. Line
Exist ℄
New ℄
Exist R/W
New R/W
Survey & Constr. ℄
N.65°50'10"E.
ANNADALE
1575
1580
1585
T.S. 1585+57.04
Spiral
a .112
L = 400
S.C. 1589+57.04
Mid. Sec. Line 1590
R.R. R/W
A.T.&S.F. R.R.
Beg. R/W Proj. Non. F-008-2-502
End Const. Proj. NON F-008-2(61)E
Beg. Proj. Non. F-008-2-502 Construction

Curve Data
Δ = 39°10'00" Lt.
D = 2°00'00"
R = 2,864.79'
Ts = 1,219.98'

1/4 Cor. Fd. I.P. With Brass Cap U.S.G.L.O. 1958

1590 1595 1600 1605 1610 1615 1620

C.S. 1605+15.37
S.T. 1609+15.37
P.O.T. 1611+50.45
1594.99
N. 26°40'10" E.
Sta. 1617+16.35 6"ø Box Culv. Ext. 31'0" Rt. Ext. 20'6" Lt.
1603+42.00 POS
P.O.T. 1614+22.08
N89°34'54"W 262.98'
20' Dirt Road
State of Arizona
S. 48°00' W
2000'±
1915'±
800'
685'±
485'
600'
SW1/4 NE1/4
NE1/4 NE1/4
NW1/4 NE1/4
SE1/4 SE1/4
A.T.&S.F. R.R.
A.T.&S.F. R.R. R/W
EXIST. R.R. R/W
Fd. I.P. With Brass Cap U.S.G.L.O. 1958

D-8-T-265

KINGMAN - ASHFORK HIGHWAY
ANNADALE - TRUXTON SECTION
MOHAVE COUNTY

Click here for US 66 Index

FED. RD. DIV.	STATE	PROJECT NO.	SHEET NO.	TOTAL SHTS	AS BUILT
7	ARIZ.	Non F-008-2-502	4	14	

ROBINSON & ASSOCIATES, INC.
DATE 10-6-61 FOR THE CONSULTING ENGINEER
DESIGN Berg DRAWN Schaeffer CHECKED

Registered Civil Engineer — Lake Hayes — Dec. 31, 1962 — Arizona U.S.A.

T23N R13W

SE¼ SE¼ | NE¼ SE¼ | SW¼ NW¼

1620 | 1625 | 1630 | 1635 | 1640 | 1645 | 1650

P.O.T. 1624+66.2

P.O.T. 1629+00

P.O.T. 1637+86.85

P.O.T. 1642+66.35

Approx. 1/16 Line

D-451 L-1

State of Arizona

D-452

D-453

1/4 Cor. Fd. 3" I.P. Mkd. 1/4 Stone N Mkd. 1/4

New R/W

Exist. R/W

Survey & Constr. ℄

N. 26°40'10" E.

25°35'00"

46041'

100' | 50' | 50' | 50' | 50' | 100'

RES. BOUNDARY

Approx. 1/4 Line

United States - Indian School Reservation

N1°05'10"E

2060.91'

2587.38'

66.00'

W.C. Fd. I.P. With Brass Cap U.S.G.L.O. 1958

21 | 16 | 15 | 22

Sta. 1655+83.00 to 1654+27.17
4-10'x5'x25'6" Box Culv.
Ext. 4-10'x5' + 21'0" Rt.
Ext. 4-10'x5' + 16'0" Lt.

Fd. X" On Ledge 3 Notches E

9 | 10 | 16 | 15

TRUXTON CANYON INDIAN SCHOOL BUILDING AREA

T.S. 1653+00.5

S.C. 1656+00.5

C.S. 1661+66.83

S.T. 1664+66.83

T.S. 1666+25.64

S.C. 1669+25.64

P.O.S.T. 1673+87.96

C.S. 1676+22.68

S.T. 1679+22.68

Spiral a = ½

Curve Data
Δ = 13°-00' Rt.
D = 1°-30'
R = 3819.72
Ts = 585.29'

Curve Data
Δ = 14°-57'-20" Lt.
D = 1°-30'
R = 3819.72
Ts = 651.47

New Gate

2640.12'

1866.00'

22.39'

65°18'28"

P.O.S.T. 1267.77 Ahd. P.I.

Exist R/W Common To R.R. & HWY.

N39°40'10"E

R.R. R/W

A.T. & S.F. R.R.

Approx. 1/16 Cor.

NE¼ NW¼

N89°58'42"W

772.12'

Record 4.05 Ch. E.
Fd. Stone Mkd. W.C.

United States - Hualapai Indian School Reservation

United States Hualapai School Reserve

REDUCED SIZE
DO NOT SCALE.

D-8-T-265

KINGMAN - ASHFORK HIGHWAY
ANNADALE - TRUXTON SECTION
MOHAVE COUNTY

FED. RD. DIV.	STATE	PROJECT NO.	SHEET NO.	TOTAL SHTS	AS BUILT
7	ARIZ.	Hon F-008-2-502	5	14	

ROBINSON & ASSOCIATES, INC.
DATE 10-6-61 FOR THE CONSULTING ENGINEER
DESIGN Berg DRAWN Schaefer CHECKED

T23N R13W

SE 1/4 SW 1/4 | SW 1/4 SE 1/4 | NE 1/4 SW 1/4 | SW 1/4 NE 1/4

Approx 1/16 Line

P.O.T. 1683+94.6

New Gate

1680 | 1685 | 1690 | 1695 | 1700 | 1705 | 1710

D-453

100' | 50' | 50' | 100'

20' | 55' | 6.5' | 35'

New R/W

Exist R/W

Exist R/W Common to R.R. & HWY.

N. 24°42'50"E.

A.T.&S.F.R.R.

Approx 1/16 Cor.

Approx 1/16 Line

Spiral
a = 1/2
L = 400'

T.S. 1695+32.9

S.C. 1699+32.9

C.S. 1703+14.57

S.T. 1707+14.57

Curve Data
Δ = 15°38'00" Lt.
D = 2°00'00"
R = 2,864.79'
Tg = 593.58'

Survey & Constr. ℄

N. 9°04'50"E.

Click here for US 66 Index

T23N R13W

SW 1/4 NE 1/4 | NW 1/4 NE 1/4 | SW 1/4 SE 1/4

Survey Curve Data
Δ = 14°41' Rt.
D = 2°00'
R = 2864.79'
Tg = 569.38

Approx 1/16 Line

1715 | 1720 | 1725 | 1730 | 1735 | 1710

D-453

Fd. Mcl. Stone & Br. Tree

N89°46'40"E — 1093.04'

2644.70'

Exist R/W

New Gate

+48.5

1367

100' | 53' | 100'

200'

MP 86 Δ

Exist R/W Common to R.R. & HWY.

Bit. Mix Table

N 23°45'50"E

New Const ℄

New Survey ℄

A.T. & S.F. R.R.

Approx 1/16 Line

Sec. Line

Set By Double Proportion

T.S. 1711+13.38 (Survey)
P.O.S.T. 1711+51.37
P.C. 1711+51.37

Spiral
a = 1/2
L = 400'

S.C. 1715+13.38 (Survey)

Office Curve Data
Δ 14°41' Rt.
D 1°15'
R 4583.66'
T 590.57'

C.S. 1718+47.55 (Survey)

Spiral
a = 1/2
L = 400'

S.T. 1722+47.55 (Survey)

P.T. 1723+26.04 (Office)

P.O.T. 1730+33.12 (Survey)

Curve Data
Δ = 1°09' Lt.
D = 0°30'
R = 11,459.16'
T = 115.00'

P.C. 1737+39.6 (Survey)
P.C. 1737+39.5 (Office)

156'

P.T. 1739+69.61 (Survey)
1740 P.T. 1739+69.5 (Office)

Office Curve Data
Δ = 1°35'05"
D = 0°30'
R = 11,459.16
T = 158.51'

REDUCED SIZE
DO NOT SCALE.

D-8-T-265

KINGMAN - ASHFORK HIGHWAY
ANNADALE - TRUXTON SECTION
MOHAVE COUNTY

FED. RD. DIV.	STATE	PROJECT NO.	SHEET NO.	TOTAL SHTS	AS BUILT
7	ARIZ.	Hen F-008-2-502	6	14	

ROBINSON & ASSOCIATES, INC.
FOR THE CONSULTING ENGINEER
DATE ____ DESIGN Berg DRAWN Schaeffer CHECKED

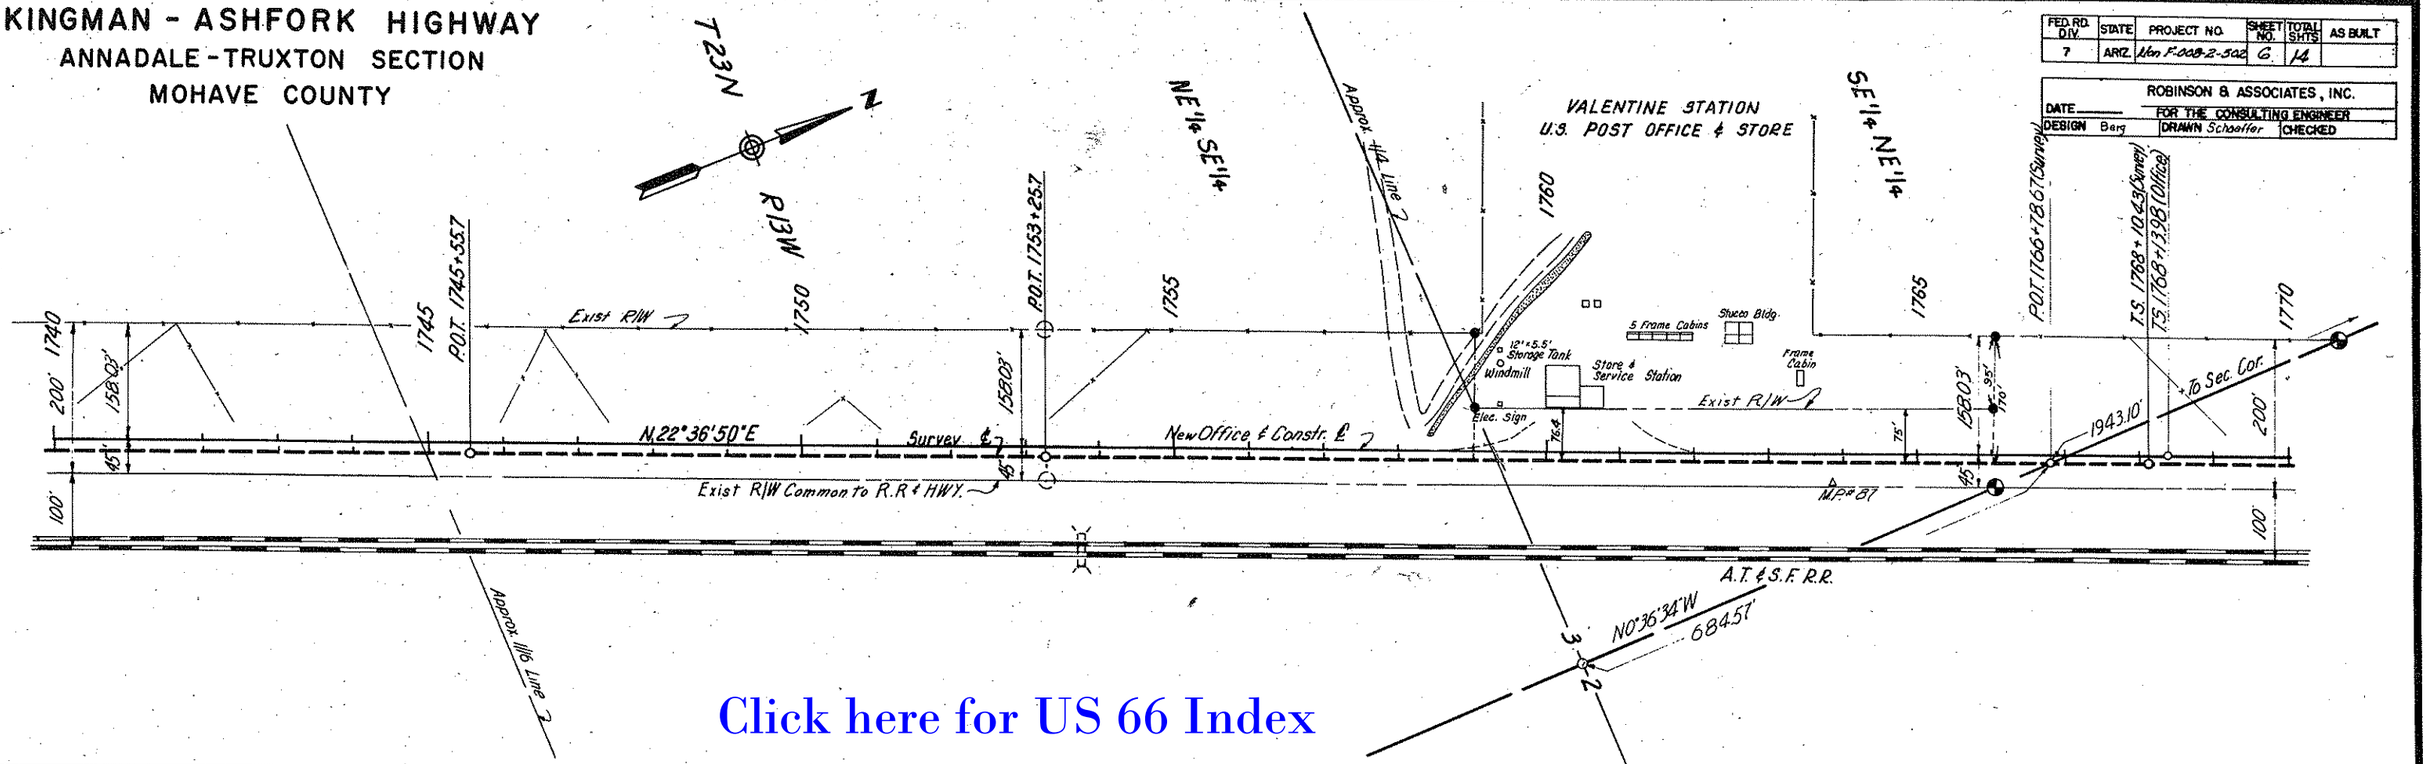

Click here for US 66 Index

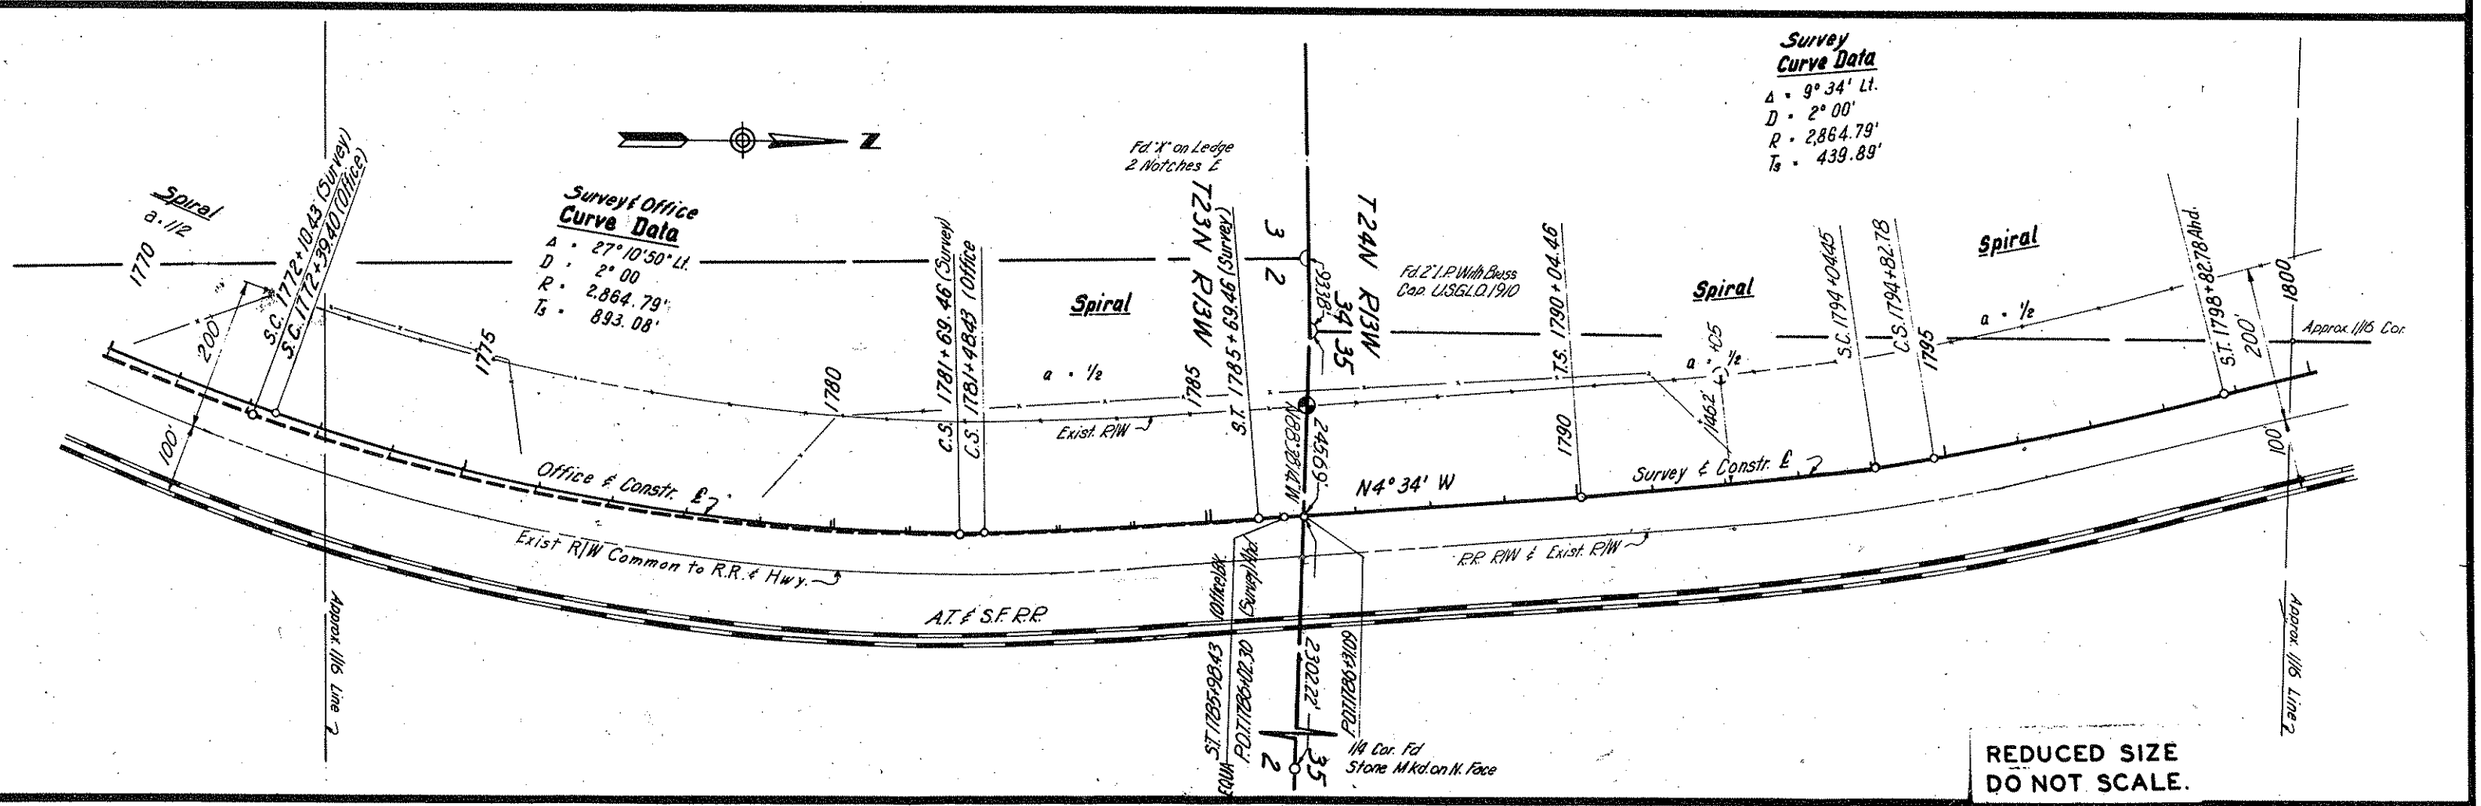

D-8-T-265

KINGMAN - ASHFORK HIGHWAY
ANNADALE - TRUXTON SECTION
MOHAVE COUNTY

FED. RD. DIV.	STATE	PROJECT NO.	SHEET NO.	TOTAL SHTS	AS BUILT
7	ARIZ.	Nat F-008-2-502	7	14	

ROBINSON & ASSOCIATES, INC.
FOR THE CONSULTING ENGINEER
DRAWN Schaeffer CHECKED

10-16-61 ON Berg

Registered Professional Engineer — LAKE HAYES — DEC 31 1961 — Ariz.

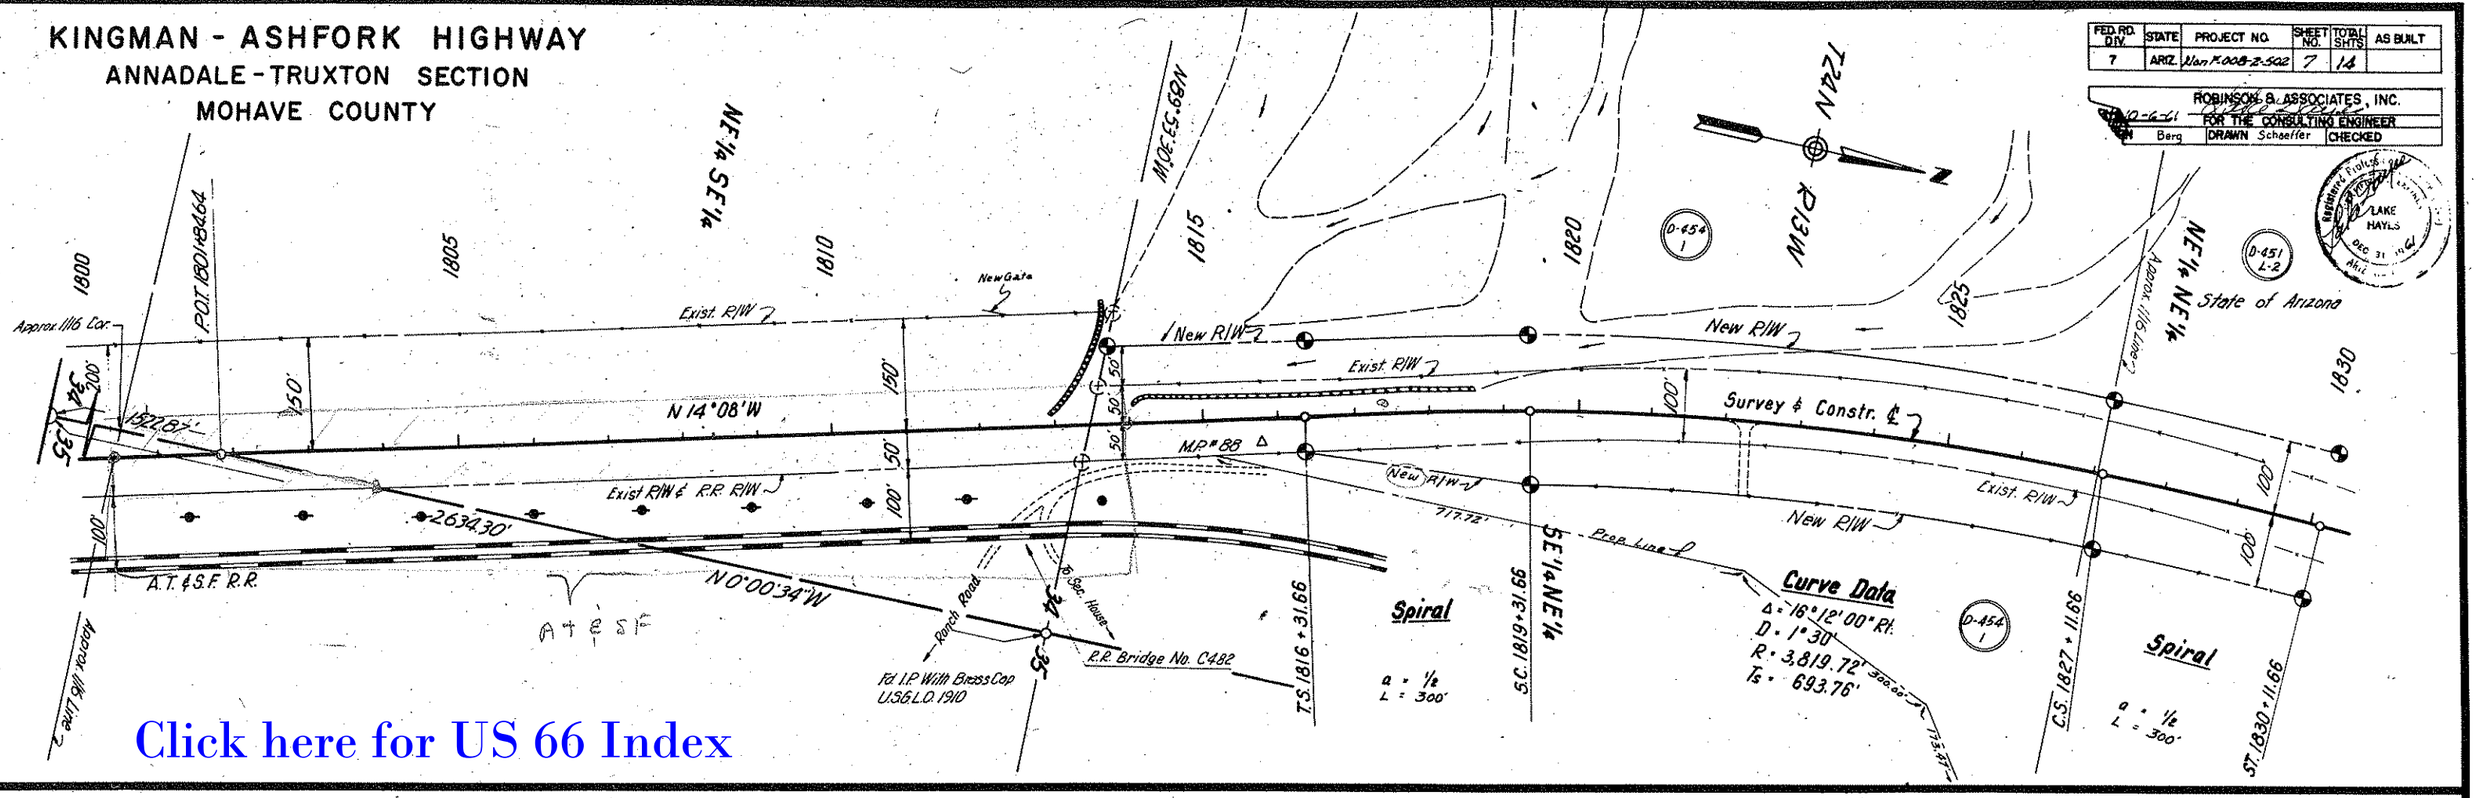

Click here for US 66 Index

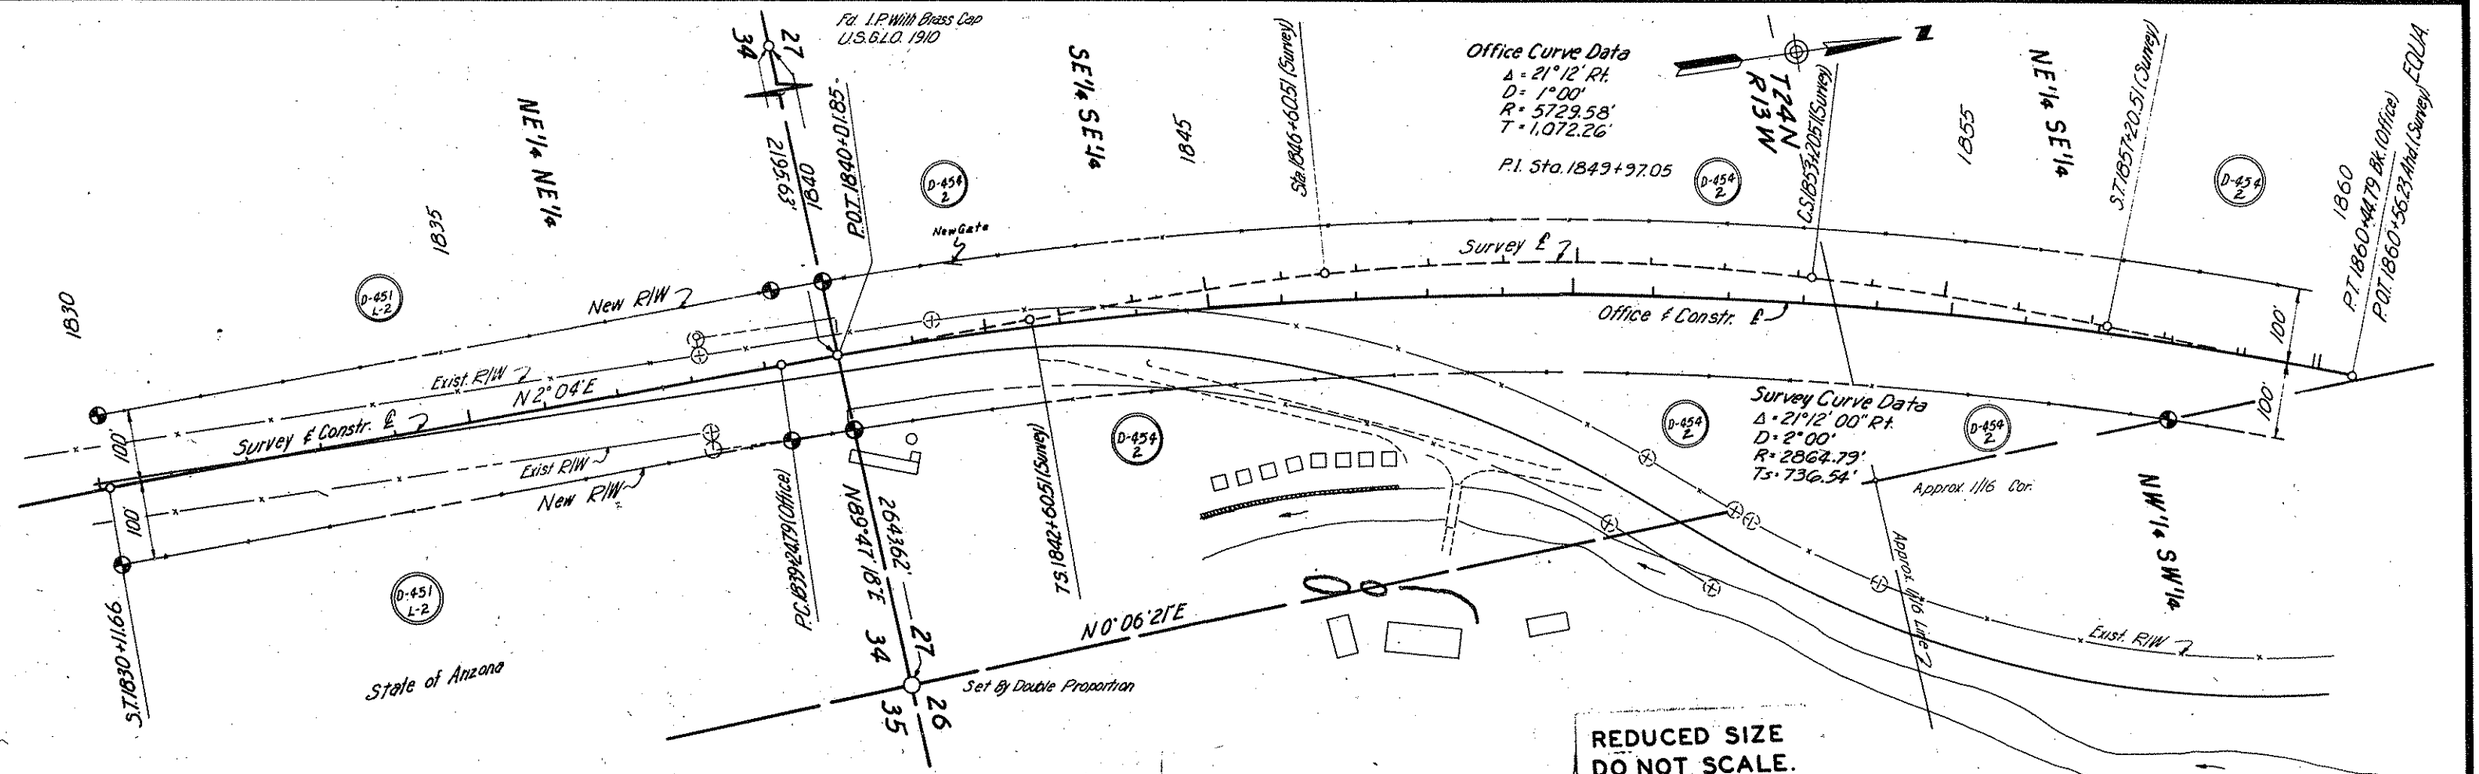

REDUCED SIZE
DO NOT SCALE.

D-8-T-265

KINGMAN - ASHFORK HIGHWAY
ANNADALE - TRUXTON SECTION
MOHAVE COUNTY

FED. RD. DIV.	STATE	PROJECT NO.	SHEET NO.	TOTAL SHTS	AS BUILT
7	ARIZ.	Non F-005-2-502	8	14	

ROBINSON & ASSOCIATES, INC.
DATE 10-6-61 FOR THE CONSULTING ENGINEER
DESIGN | DRAWN | CHECKED

Fd. I.P. With Brass Cap U.S.G.L.O. 1910

T24N R13W




P.O.T. 1860+44.00

P.O.T. 1863+00

P.O.T. 1869+30.5

New R/W

Exist R/W

Survey & Constr. ℄

Drainage Easement

New Gate

1966.40' To Sec. Cor.

P.T. 1860+44.79 Bk.

P.O.T. 1860+96.23 Ahd.

EQUA

N23°16'E Bk. =

N23°17'20"E Ahd.

P.O.T. 1874+04.95 Bk. =

P.O.T. 1874+65.68 Ahd.

EQUA

T.S. 1876+51.75

S.C. 1878+51.75

Spiral a = 1/2

Sta. 1865+12 to 1865+63
4-10'×8'×78'0" Box Culv.

Sta. 1870+58 to 1871+09
4-10'×8'×65'0" Box Culv.

Approx. 1/4 Line

Approx. 1/16 Line

P.O.C. 1886.50

Approx. 1/16 Cor.

Curve Data
Δ = 23°29' Rt.
D = 1°00'
R = 5729.58'
Ts = 1,290.94'

NW1/4 NW1/4

SW1/4 NW1/4

NW1/4 NW1/4

SW1/4 NW1/4

SE1/4 SW1/4

NW1/4 SE1/4

SW1/4 SE1/4

NE1/4 NW1/4

Fd. I.P. With Brass Cap U.S.G.L.O. 1910

N89°53'42"E 1884.51'

P.O.C. 1894+00

P.O.C. 1895+95

P.O.C. 1899+51.75

C.S. 1900+00

S.T. 1902+00

Sta. 1902+00
6-7'×108'6" Box Culv.

151.81'

P.O.T. 1911+17

P.O.T. 1918+23.4

P.O.T. 1914+88.4

P.O.T. 1919+36.53 Bk.

P.O.T. 1917+65.00 Ahd. EQUA

N46°46'20"E Bk.

N46°58'40"E Ahd.

Sta. 1917+27.94
6-7'×33'5" Box Culv. Ext. 26'6" Lt.

State of Arizona

Fd. I.P. With Brass Cap U.S.G.L.O. 1910

Click here for US 66 Index

REDUCED SIZE DO NOT SCALE.

D-8-T-265

KINGMAN - ASHFORK HIGHWAY
ANNADALE - TRUXTON SECTION
MOHAVE COUNTY

FED. RD. DIV.	STATE	PROJECT NO.	SHEET NO.	TOTAL SHTS	AS BUILT
7	ARIZ.	Nan F-008-2:502	9	14	

ROBINSON & ASSOCIATES, INC.
DATE 10-4-61 FOR THE CONSULTING ENGINEER
DESIGN Berg DRAWN Molotsky CHECKED

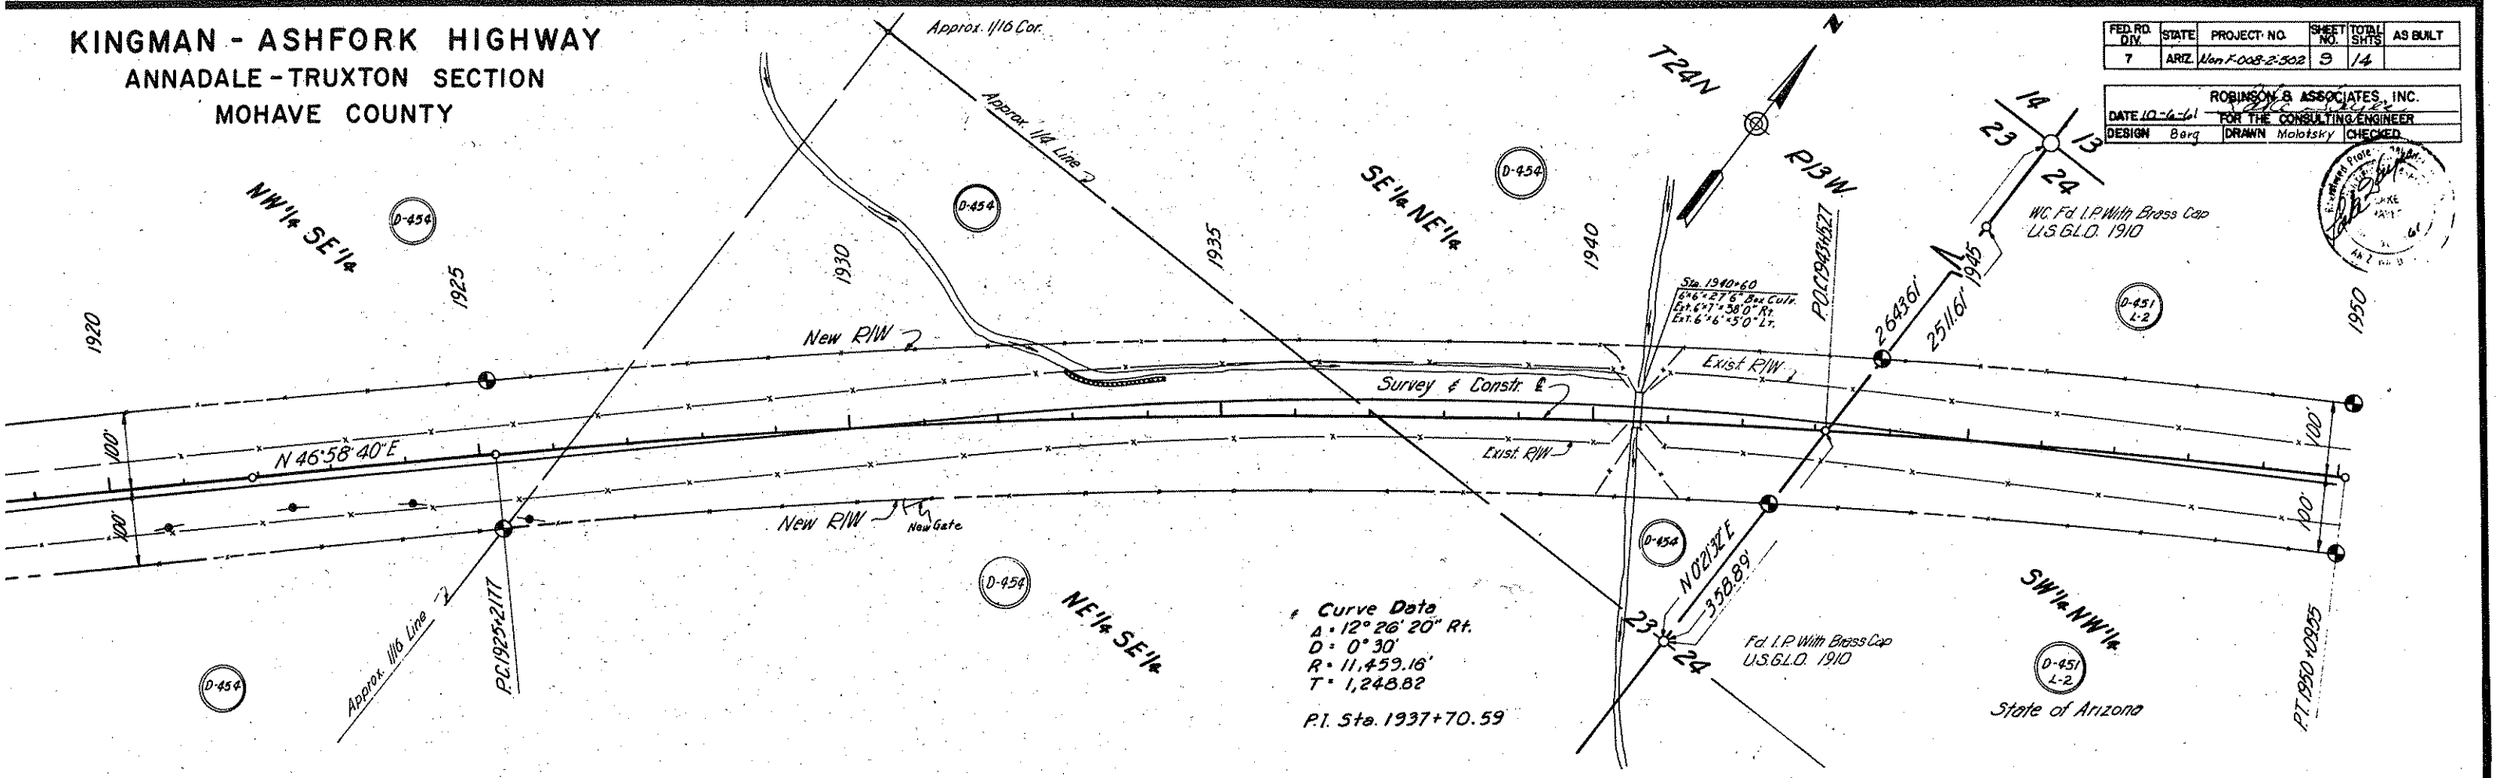

Click here for US 66 Index

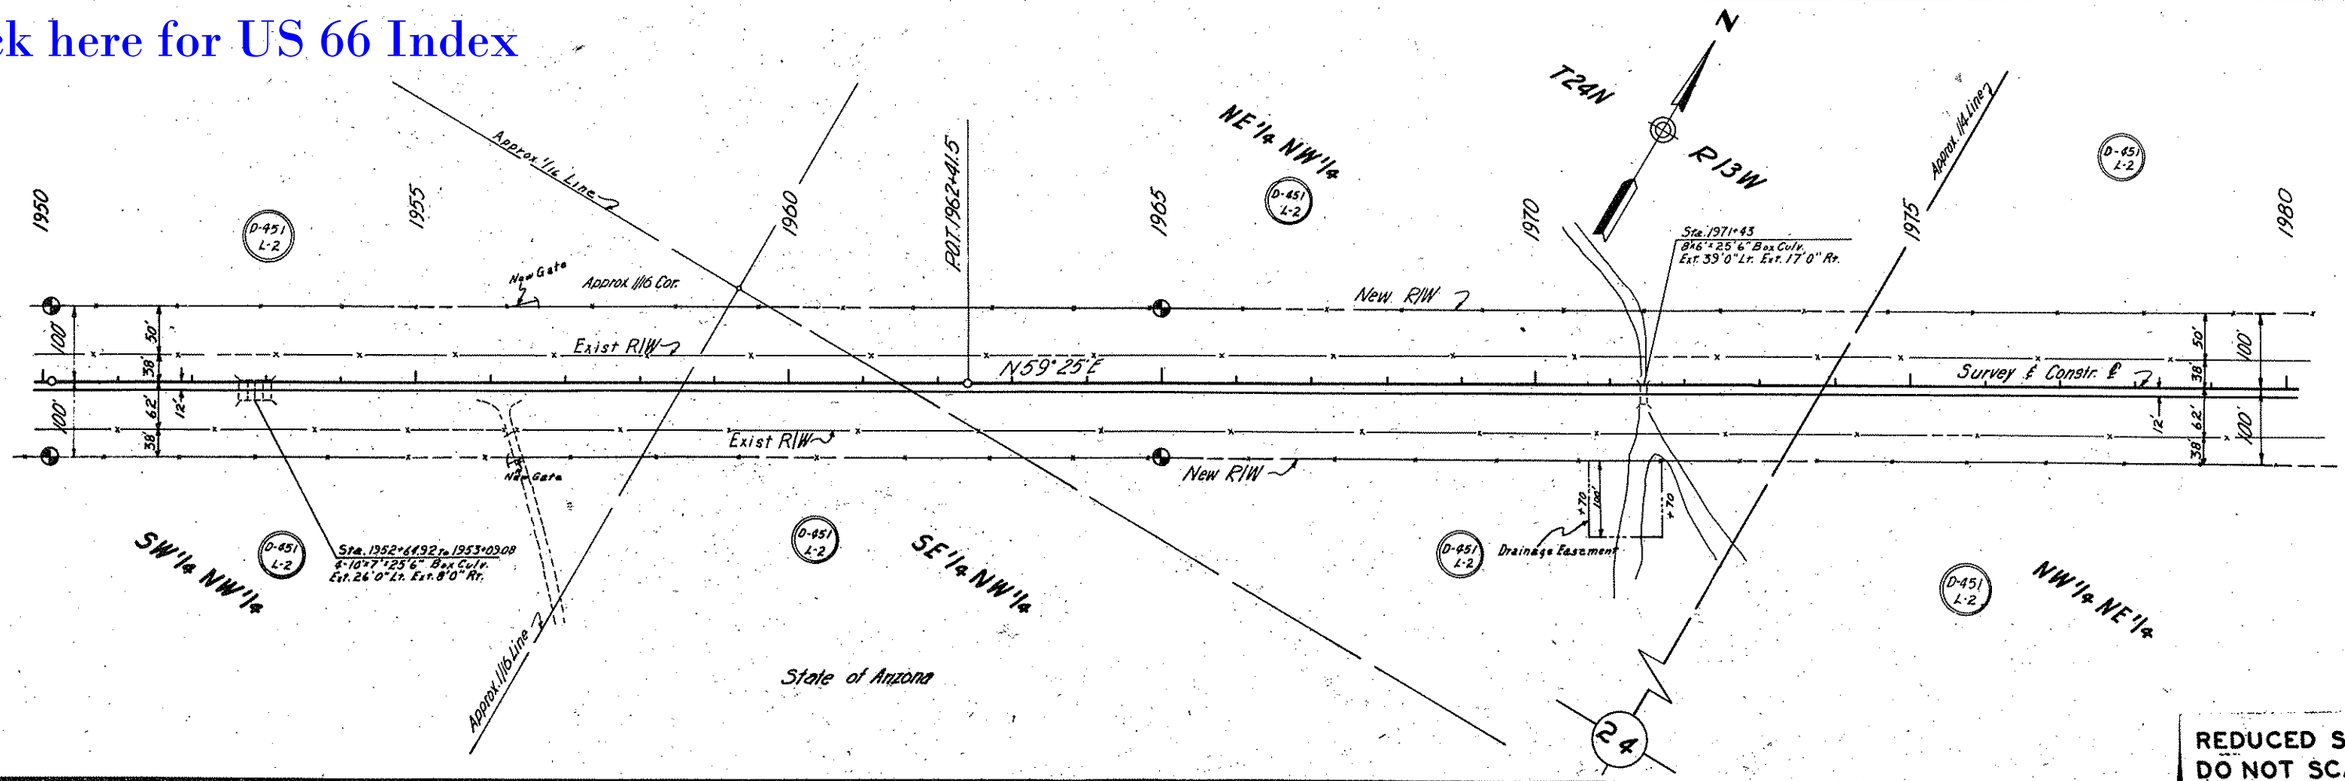

REDUCED SIZE
DO NOT SCALE.

D-8-T-265

KINGMAN - ASHFORK HIGHWAY
ANNADALE - TRUXTON SECTION
MOHAVE COUNTY

FED. RD. DIV.	STATE	PROJECT NO.	SHEET NO.	TOTAL SHTS	AS BUILT
7	ARIZ.	Nan-F008-2-502	10	14	

ROBINSON & ASSOCIATES, INC.
DATE 10-26-61 FOR THE CONSULTING ENGINEER
DESIGN Berg DRAWN Molotsky CHECKED

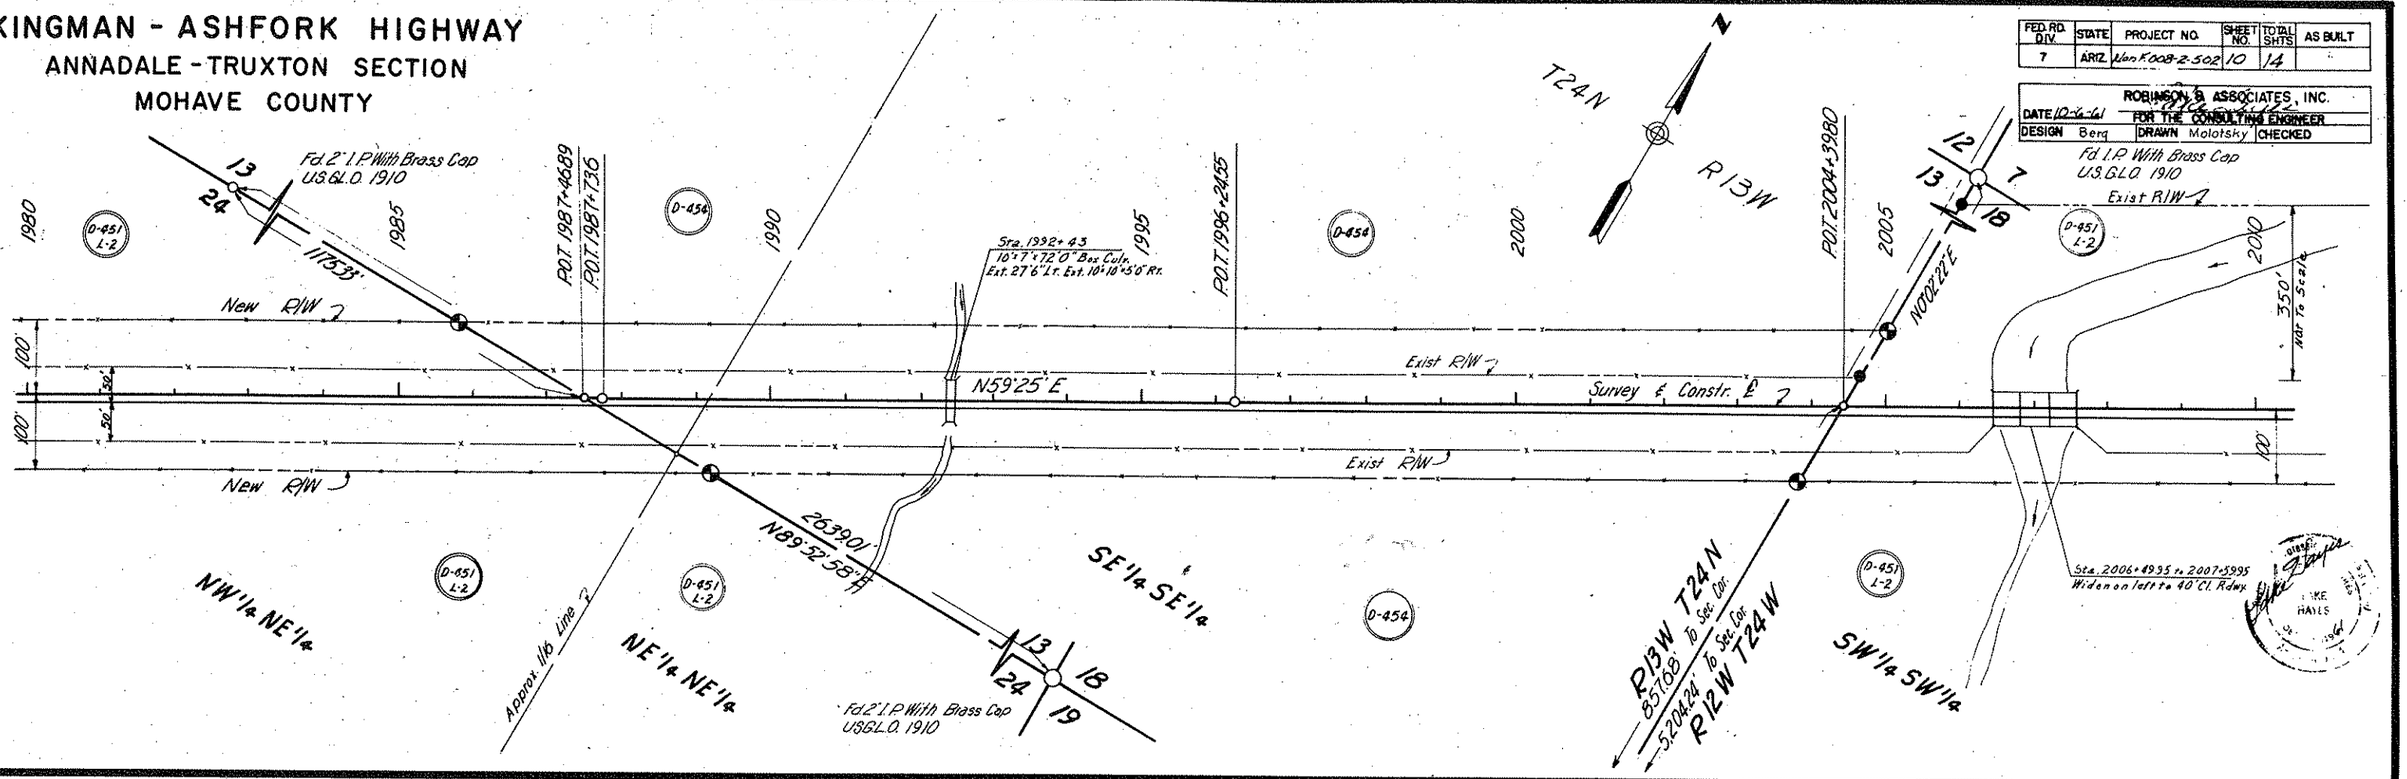

Click here for US 66 Index

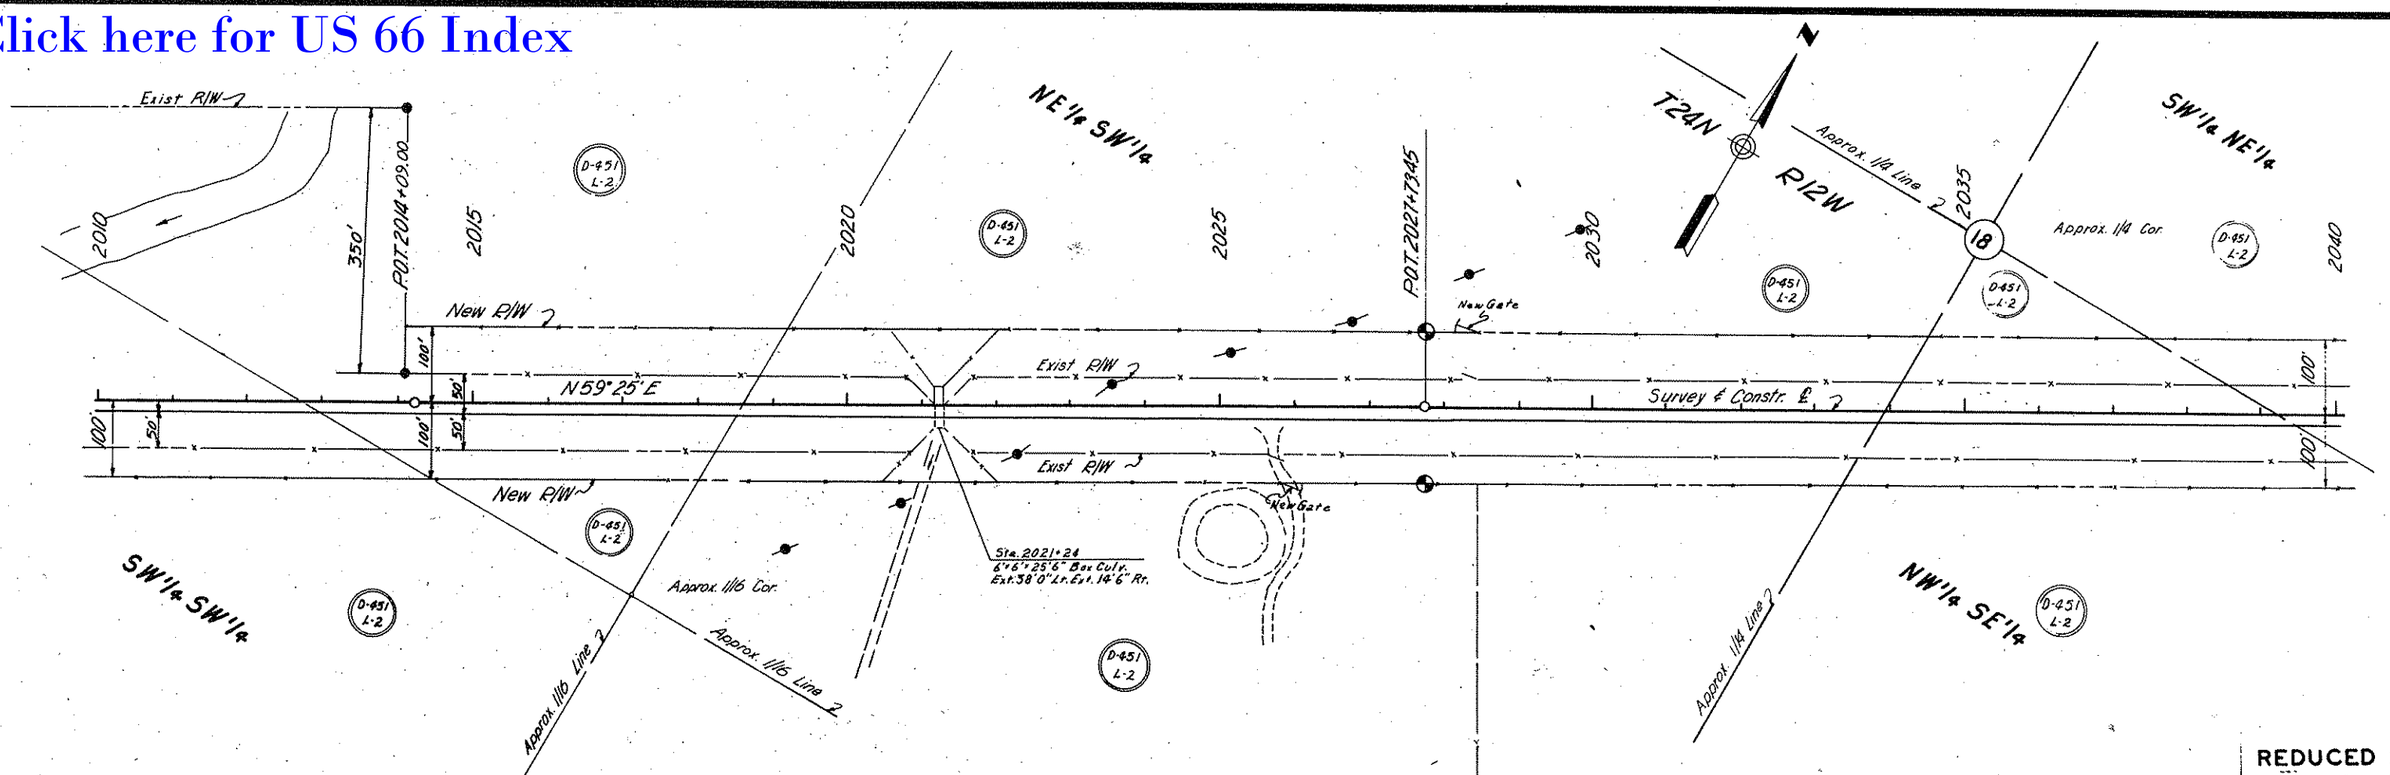

REDUCED SIZE DO NOT SCALE.

D-8-T-265

KINGMAN - ASHFORK HIGHWAY
ANNADALE - TRUXTON SECTION
MOHAVE COUNTY

FED. RD. DIV.	STATE	PROJECT NO.	SHEET NO.	TOTAL SHTS	AS BUILT
7	ARIZ.	Non F 008-2-502	11	14	

ROBINSON & ASSOCIATES, INC.
DATE 10-6-61 FOR THE CONSULTING ENGINEER
DESIGN Berg DRAWN Molotsky CHECKED

Registered Professional Engineer
LUKE HAYES
DEC. 31, 1961

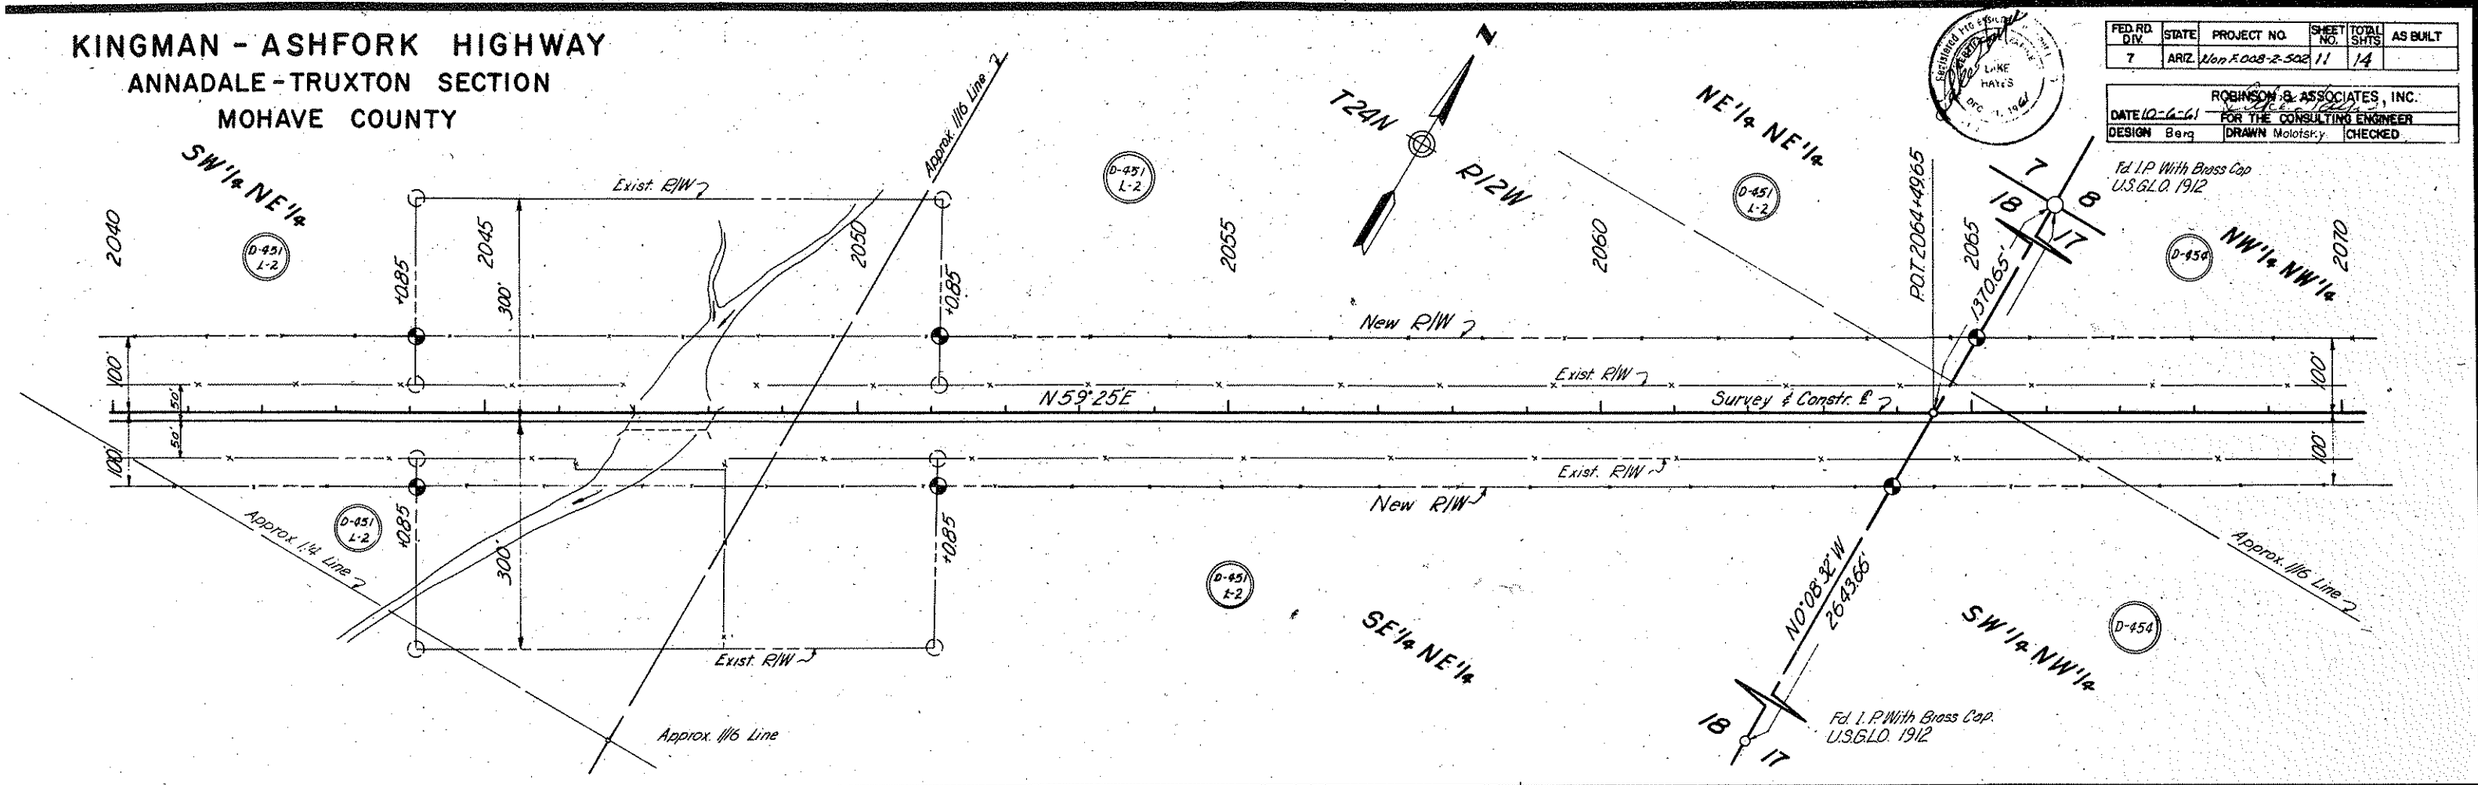

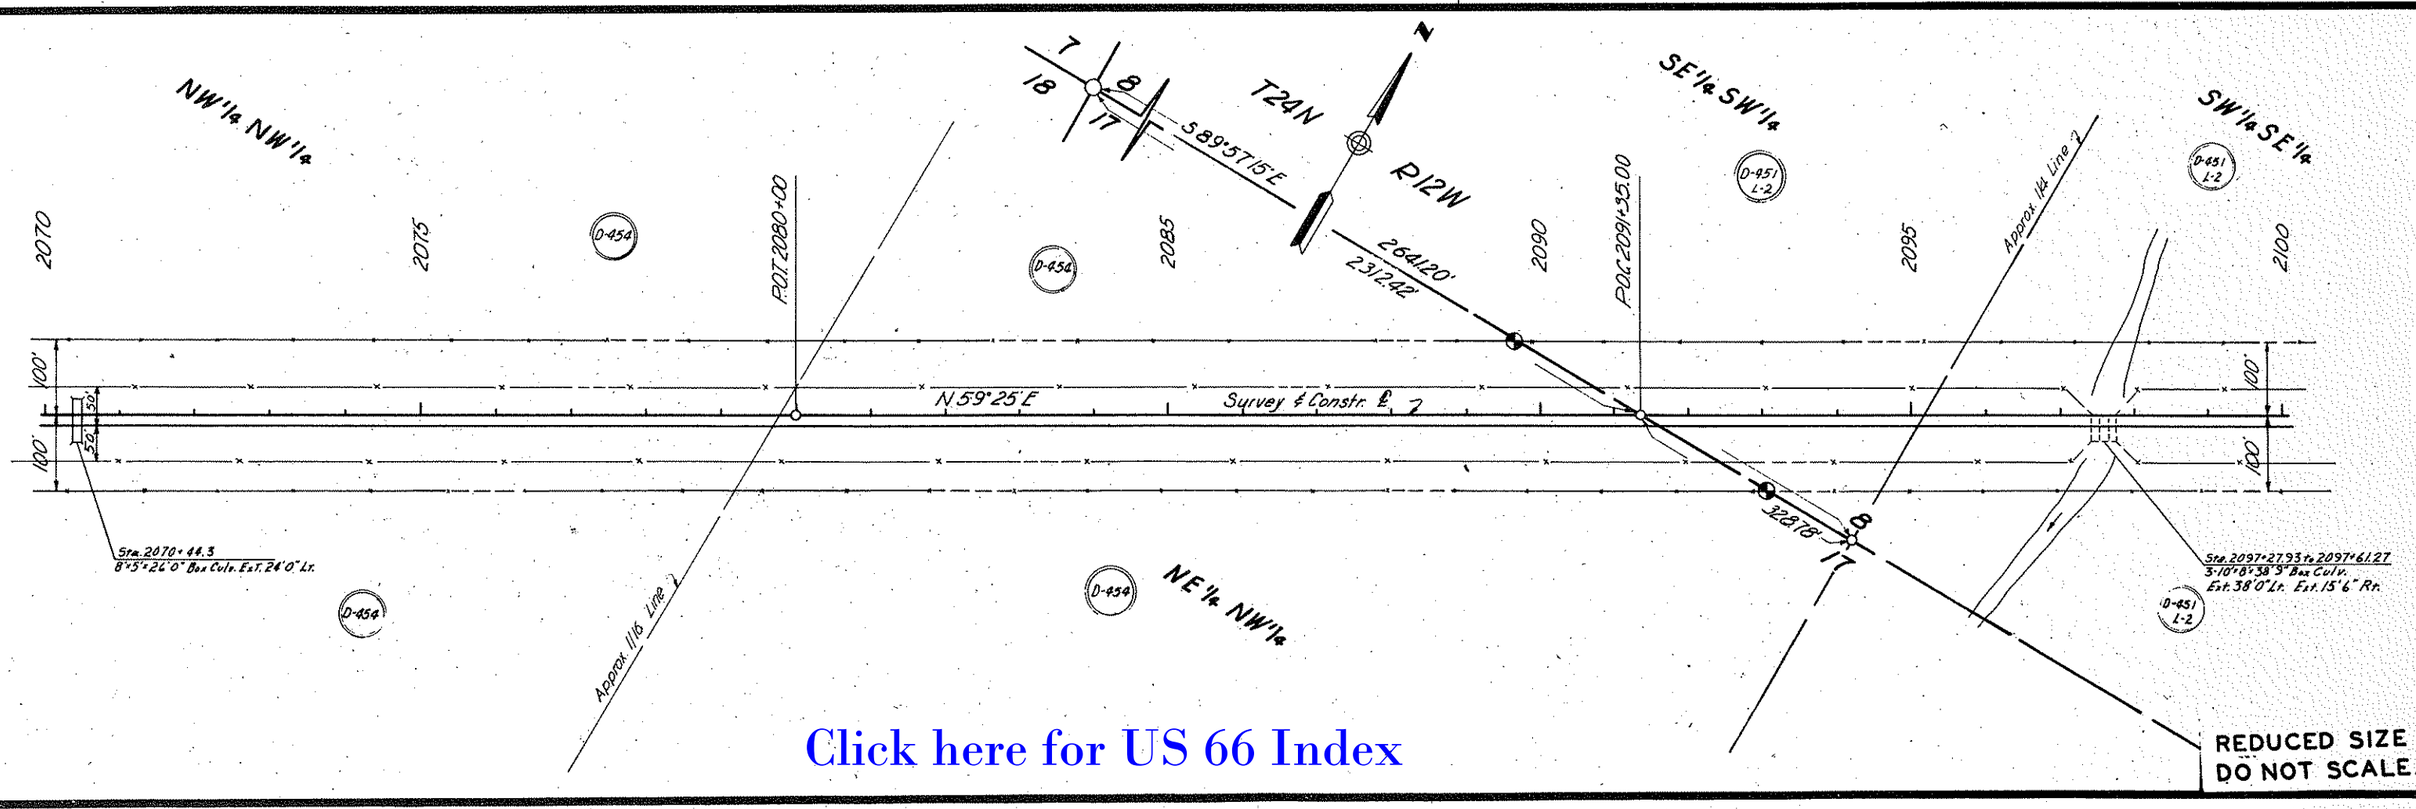

Click here for US 66 Index

REDUCED SIZE
DO NOT SCALE.

D-8-T-265

KINGMAN - ASHFORK HIGHWAY
ANNADALE - TRUXTON SECTION
MOHAVE COUNTY

FED. RD. DIV.	STATE	PROJECT NO.	SHEET NO.	TOTAL SHTS	AS BUILT
7	ARIZ.	Non F-008-2-302	12	14	

ROBINSON & ASSOCIATES, INC.
DATE 10-6-61 FOR THE CONSULTING ENGINEER
DESIGN Berg DRAWN Molotsky CHECKED

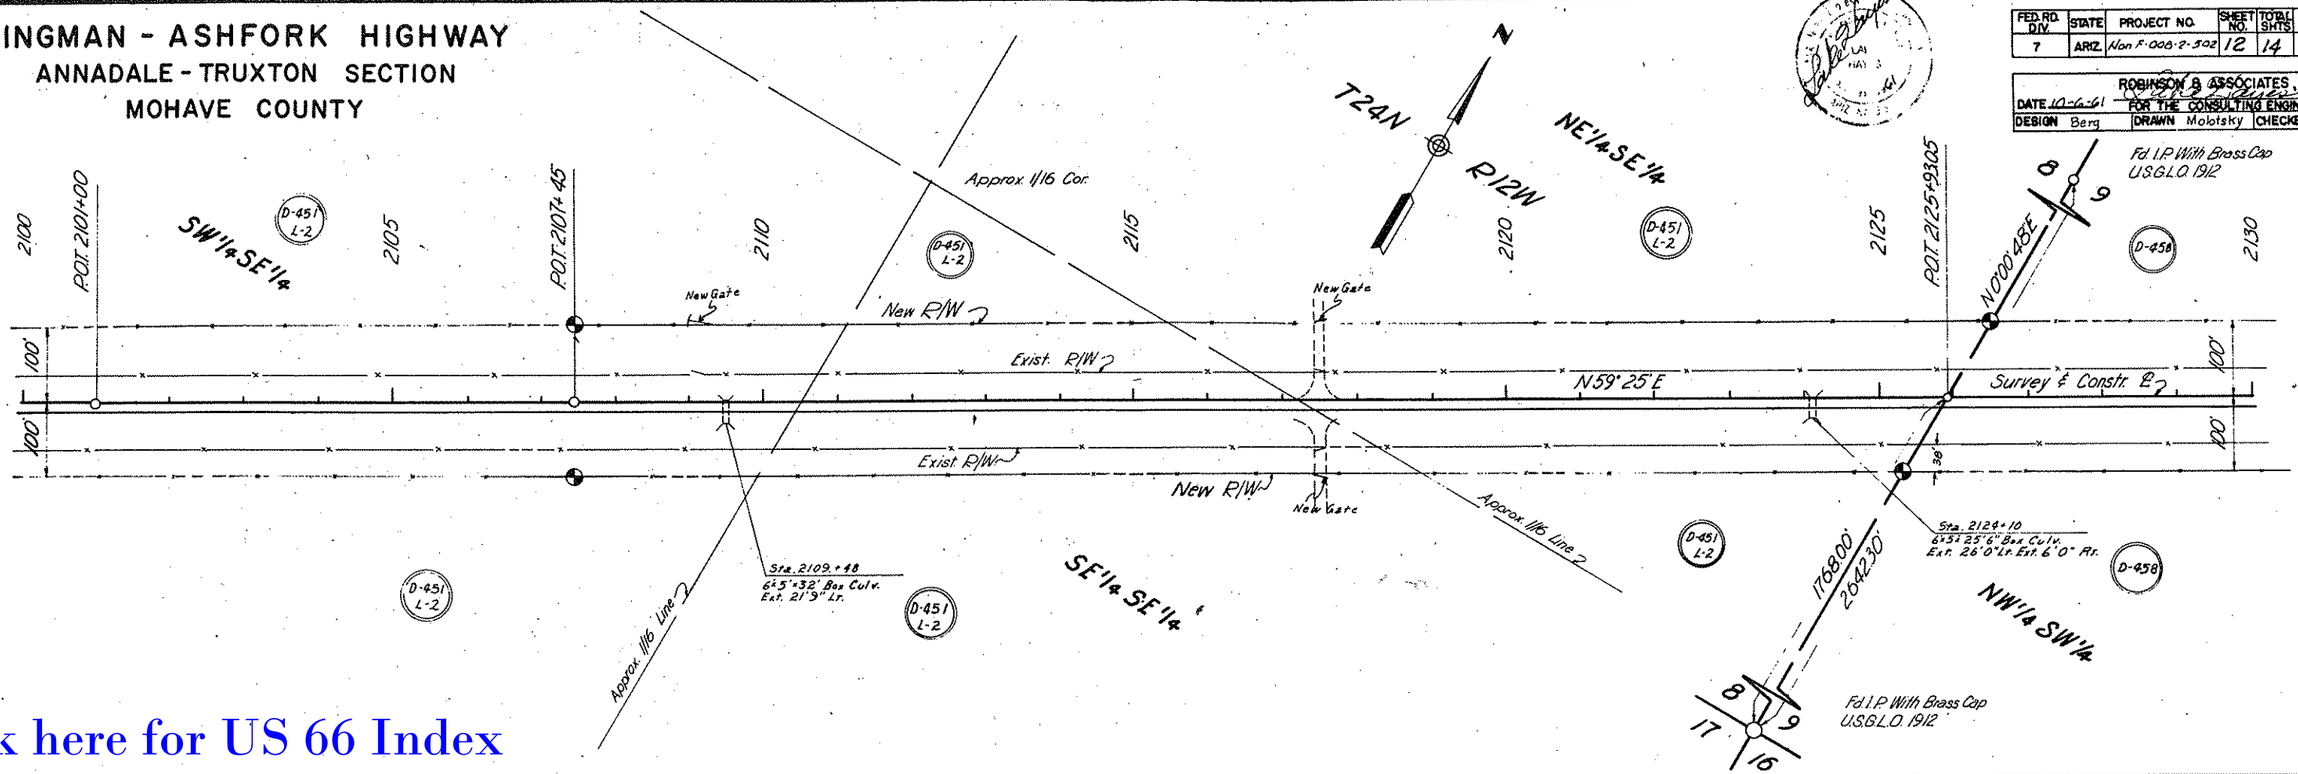

Click here for US 66 Index

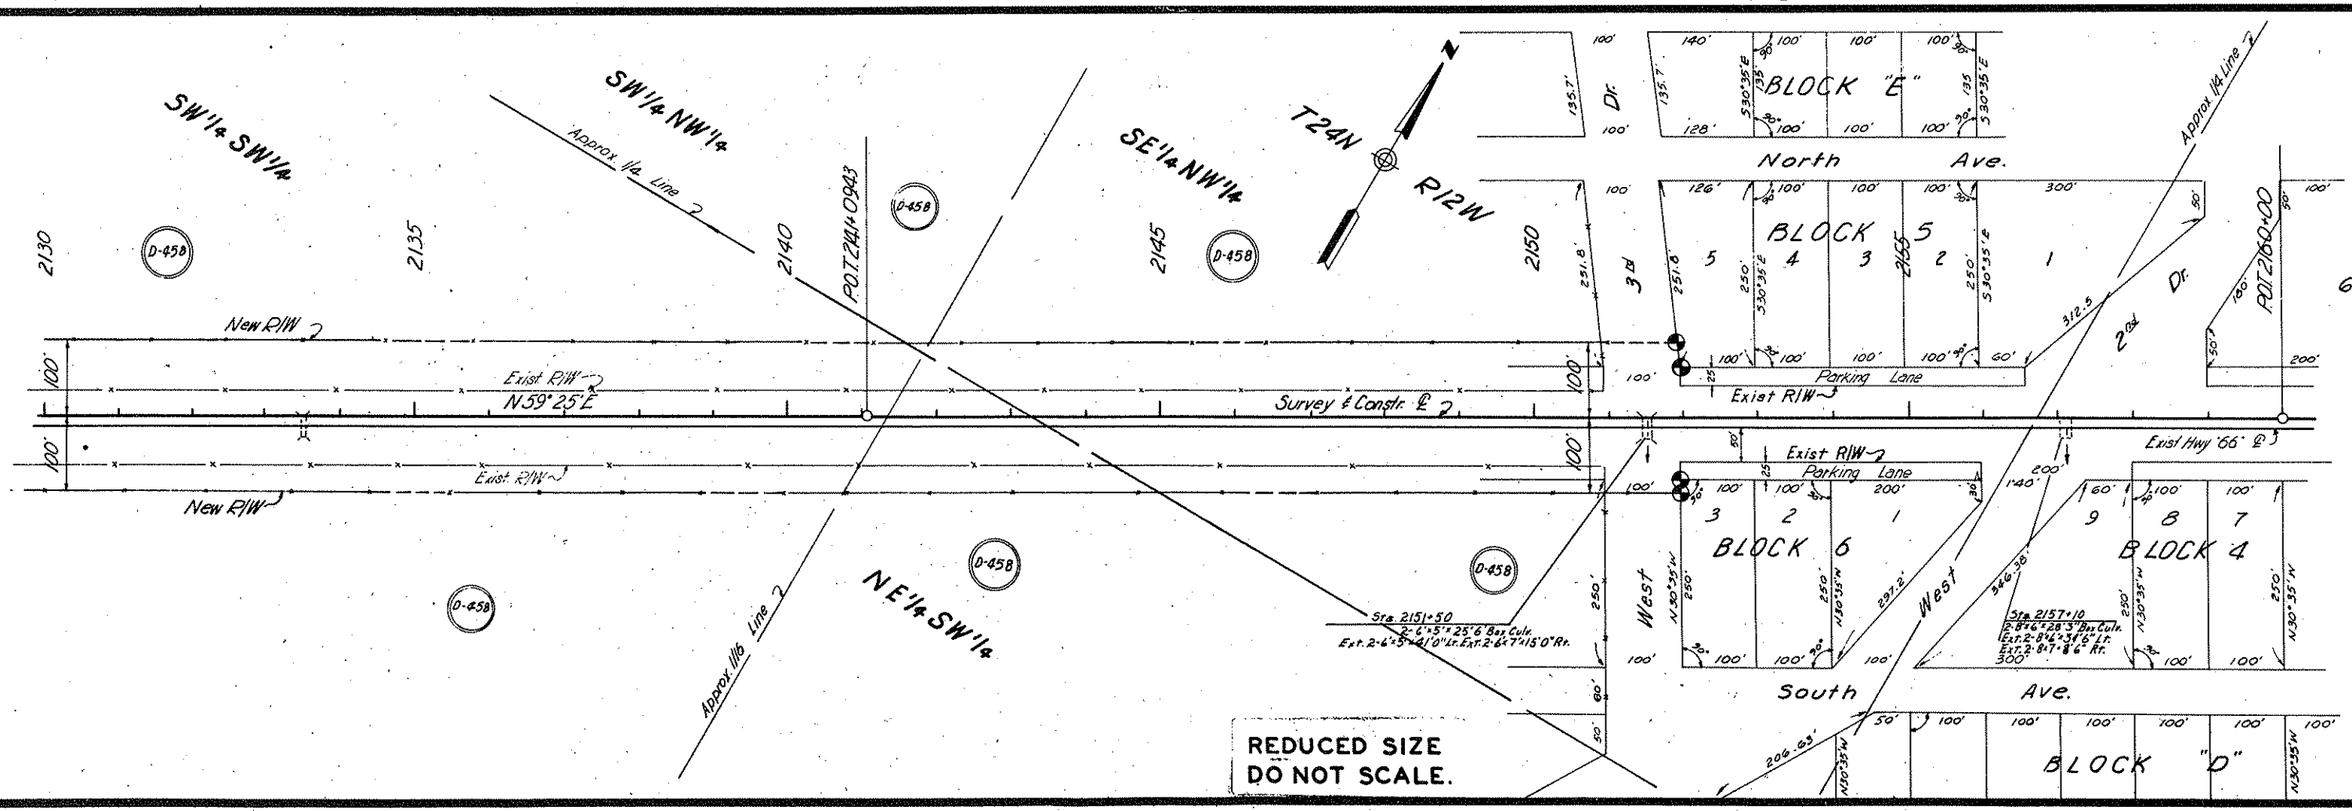

D-8-T-265

KINGMAN - ASHFORK HIGHWAY
ANNADALE - TRUXTON SECTION
MOHAVE COUNTY

FED. RD. DIV.	STATE	PROJECT NO.	SHEET NO.	TOTAL SHTS.	AS BUILT
7	ARIZ.	Non F-008-2-502	13	14	

ROBINSON & ASSOCIATES, INC.
DATE 10-6-61 FOR THE CONSULTING ENGINEER
DESIGN Berg DRAWN Molotsky CHECKED

BLOCK "C" · BLOCK "A" · NORTH AVE. · BLOCK 3 · BLOCK 1 · BLOCK 4 · BLOCK 2 · WEST MOLTHAN LANE · SOUTH AVE. · BLOCK "D" · BLOCK "B" · UNIT ONE BRIDGE CANYON JUNCTION SUBDIVISION

POT 2160+00 · POT 2178+49 · POT 2187+30.86

Survey ℄ Constr. ℄ · Exist R/W · 25' Parking Lane · Approx 1/16 Line · Approx 1/4 Line · ℄ Exist Hwy "66" · EXIST. R/W 360.6 · NEW R/W 396.96 · New R/W · Exist R/W 2

T24N R12W

N59°25'E · N30°35'W · N30°25'W · N30°29'W · S30°35'E · S30°29'E

D-455 · D-456 · D-461 · D-459 · D-451 · D-460

Sta. 2166+55 6'6" x 25'6" Box Culv. Ext. 28'6" Lt.

Sta 2205+03 2-8'6" x 25'6" Box Culv. Ext. 31'0" Lt. Ext. 2-8'7" x 8'0" Rt.

NE¼ NE¼ · NW¼ NW¼ · SW¼ SW¼ · SE¼ SW¼ · SW¼ SE¼

2284.40 · 2642.03 · 2643.68 · 1970.02' N89°59'17"E · 673.66' N89°58'E (Rec.)

POT 2195+11.95 · POT 2201+9.03

Fd. 1/2" Pipe Accepted Cor. · Approx. 1/16 Cor. · Fd. I.P. With Brass Cap U.S.G.L.O. 1912

State of Arizona

END Proj. Non.F-008-2-502 R/W · Beg. Proj. Non. F-008-2-501 R/W

Click here for US 66 Index

REDUCED SIZE DO NOT SCALE.

KINGMAN–ASHFORK HIGHWAY
TRUXTON–PEACH SPRINGS SECTION
MOHAVE COUNTY

Click here for US 66 Index

PROJECT NO.	Non F-008-2-502
DRAWING NO.	D-8-T-265
SHEET NO.	14 of 14
DRAWN BY	Pete Julian
DATE COMP.	11-14-61
SCALE	1"=100'

T. 22 N.
R. 12 W.

Hualapai South Line Indian Reservation Boundary

LOT 2

LOT 12

LOT 1

2220
2225
2235
2240

Exist R/W
New R/W
Survey & Construction ℄
Exist ℄
100'
50'
120'
162.02'
POT 2230+00
POT 2231+62.02
N 30°35'W
42.00'
N 59°25'E
1131.74' (calc.)
L = 686.77' (calc.)
12.00'
L = 637.27 (calc.)
817.91' (calc.)
POT 2243+00 AHD
POT 0+00 AHD
POT Sec. Line
198.73'
S 76°06' (Calc.)
N 46°13'30" E
1380.6'
S 89°51'30" E
Sec. Line
500.00'
1/4 Cor. Fd. 1" I. Brass Cap (U.S.G.L.O.)
Exist & Strand B/W fence
Exist U.S. Hwy. No. 66
Exist R/W
Exist Hwy. 66 ℄ Curve
Δ = 6°48'30" Lt.
D = 1°00'00"
R = 5729.58'
T = 340.80'
L = 680.10'
POT 1939.30
Exist Hwy. 66
POT 2257.2
Exist Hwy. 66

END CONST. PROJ. NON F-008-2-502
STA 2243+00 (0+00 AHD)

BEGIN CONST. PROJ. NON F-008-2501
STA. 0+00 (2243+00 BK.)

SUN STREET
BLOCK 1
DANCE
BLOCK 2
VICKI COURT
ESTA COURT
DRIVE
BLOCK 3
DAWN
DRIVE
IROQUOIS
ROAD
BLOCK 4
BLOCK 5
JOSHUA
HAULAPAI
STREET
UNIT TWO BRIDGE CANYON JUNCTION
LAURA LANE
AVENUE
BLOCK X
BLOCK 6
SUMAC
BLOCK 16
BLOCK 9
CHEROKEE
AVENUE
BLOCK 13
YUCCA
AVENUE
BLOCK 10

REDUCED SIZE
DO NOT SCALE.