*NOTE: NEW 10'X60' T.C.E. LT. OF STA. 4631+50± (PAR. 5-044) IS BEING DONE FOR & SHOULD BE CHARGED TO CONSTR. PROJECT OTO GH 340 H3111 01C, F-022-4-538, (SEE C.O. 8133, DATED 11/15/93).

4630+00
BEG. F. 67 (4)

5-044
DELETED
3-22-94

OWNERSHIP RECORD

№	OWNER	ADDRESS	DESCRIPTION
65	E.M. CLARIDGE, ET UX	SAFFORD	SE¼NE¼SE¼ SEC. 13, T.7S-R.26E.
66	S.L. CLARIDGE, ET UX	"	BLOCKS 1-2-3, SOLOMONSVILLE
67	W.E. WALDROM, ET UX	"	PT. BLOCK 10, MEXICAN ADD. & SW¼SEC. 18, T.7S-R.27E.
68	S.L. CLARIDGE, ET UX	"	PT. BLK. 10, MEXICAN ADD.
69 TO 71	– NO R/W REQUIRED		
72	JOHN DIAZ ESTATE	—	LOTS 1 TO 6, BLOCK 8, MEXICAN ADD.
73	REGINO CHAVARRIA, Jr.	SOLOMONSVILLE	BLK. 7, MEXICAN ADD.
74	EVEARISTO DELGADO, ET AL	"	BLKS. 4-5 & 6 MEXICAN ADD.
75	DELORES C. ARMIJO	"	LOTS 17-18-19 BLK. 3, MEXICAN ADD.
76	SANTOS HERNANDEZ, ET UX	"	LOTS 9 TO 14, BLK. 3, MEXICAN ADD.
77	PATRICIO ORNELAS, ET UX	"	LOTS 1 TO 3 & 15-16 BLK. 3, MEXICAN ADD.
78	S.L. CLARIDGE, ET UX	SAFFORD	PT. LOTS 9 TO 25, BLK. 3, MEXICAN ADD.
79	MONTEZUMA CANAL CO.	"	PT. BLOCK 2, MEXICAN ADD.
80	JUAN M. MARTINEZ	SOLOMONSVILLE	LOT "A" BLK. 1, PARK'S ADD. & BLK. 1 MEXICAN ADD. SO. OF CANAL.
81	S.L. CLARIDGE, ET UX	SAFFORD	LOTS 1 TO 5, BLK. 1, PARK'S ADD. LOT "A" BLK. 1, PARK'S ADD. & BLOCK 1, MEXICAN ADD. NO. OF CANAL.
82-83	WILLARD PACE	"	LOTS 6 TO 10, BLK. 2, PARK'S ADD.
84	MIKE WINNISER, ET UX	TIGER, ARIZ.	LOTS 1 TO 16, BLK. 2, PARK'S ADD.
85	W.W. CHAPMAN, ESTATE	—	PART OF SEC. 19, T.7S.-R.27E.
86	CLYDE KEMPTON, ET AL	SOLOMONSVILLE	NW¼NW¼SEC. 20 & NE¼NE¼ & E. 20 Rds. NW¼NW¼ SEC. 19, T.7S-R.27E.
87	JESSIE GOMEZ, ET CON	"	SE¼NE¼ SEC. 19, T.7S.-R.27E. LESS SMALL PARCEL IN NE. COR.
88	LOUIE G. MICHELENA ESTATE		PARCEL OF LAND IN NE. COR OF SE¼NE¼ SEC. 19, T.7S.-R.27E.
89	JESSIE GOMEZ, ET CON	SOLOMONSVILLE	W½ SW¼NW¼ SEC. 20, T.7S.-R.27E.
90	MONTEZUMA CANAL CO.	SAFFORD	R/W ACROSS LOTS 1 & 8 BLK. 4, MEXICAN ADD.
91	MONTEZUMA CANAL CO.	"	R/W ACROSS LOT "A" BLK. 1, PARK'S ADD. & BLOCK 1, MEXICAN ADD.
~~5-044~~	~~LARRY R. HUFF, ET UX~~	DELETED	~~PT. LOT 19, SEC. 18, T.7S. R.27E.~~

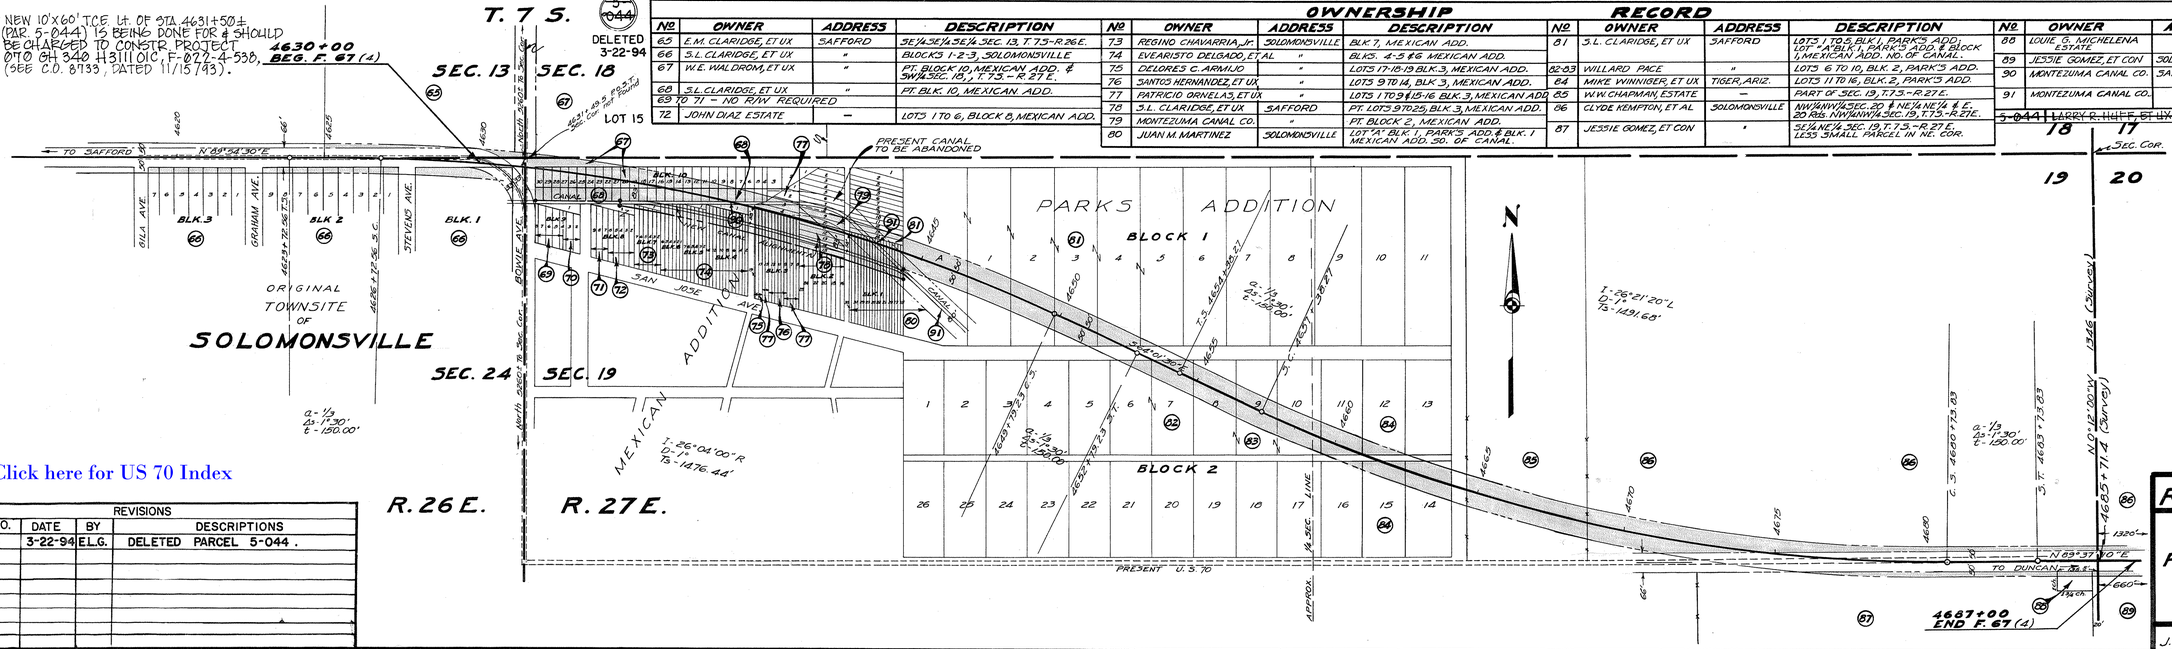

Click here for US 70 Index

REVISIONS			
C.O. NO.	DATE	BY	DESCRIPTIONS
8834	3-22-94	E.L.G.	DELETED PARCEL 5-044.

TITLE REPORT	
DATE	BY
APR. TO JULY 1947	CONSOLIDATED ABSTRACT CO. SAFFORD

— RIGHT-OF-WAY ACQUIRED

ARIZONA HIGHWAY DEPARTMENT
RIGHT OF WAY DIVISION
RIGHT OF WAY MAP
SHOWING
RIGHT OF WAY REQUIRED
THRU
SOLOMONSVILLE
F. 67 (4)

DRAWN	SCALE	DATE	FILE NO.
J. BAKER	1" = 200'	9-12-46	51-114