GLOBE-LORDSBURG HWY.
DUNCAN-WEST
GREENLEE COUNTY

REVISIONS				
C.O. No.	DATE	BY	DESCRIPTION	
3720	10-19-73	W.D.S.	Revised D.E. Alignment, Areas of Par. 5-006, 5-007	PROJECT NO. F-022-4-601
3867	2-6-74	J.H.	Deleted & Replaced: Parcels 5-006, 5-007 & Map No.	DRAWING NO. D-6-T-120
3975	6-24-74	W.D.S.	Add. Exist. 24" Pipe & Note concerning Check Valve	SHEET NO. 1 of 1
4294	7-8-75	EE	FINALIZED	DRAWN BY W. Shirley
T448	2-3-87	AJS	ADD NEW 100' D.E. & NOTE	DATE COMP. 6-19-73
				SCALE 1" = 100'

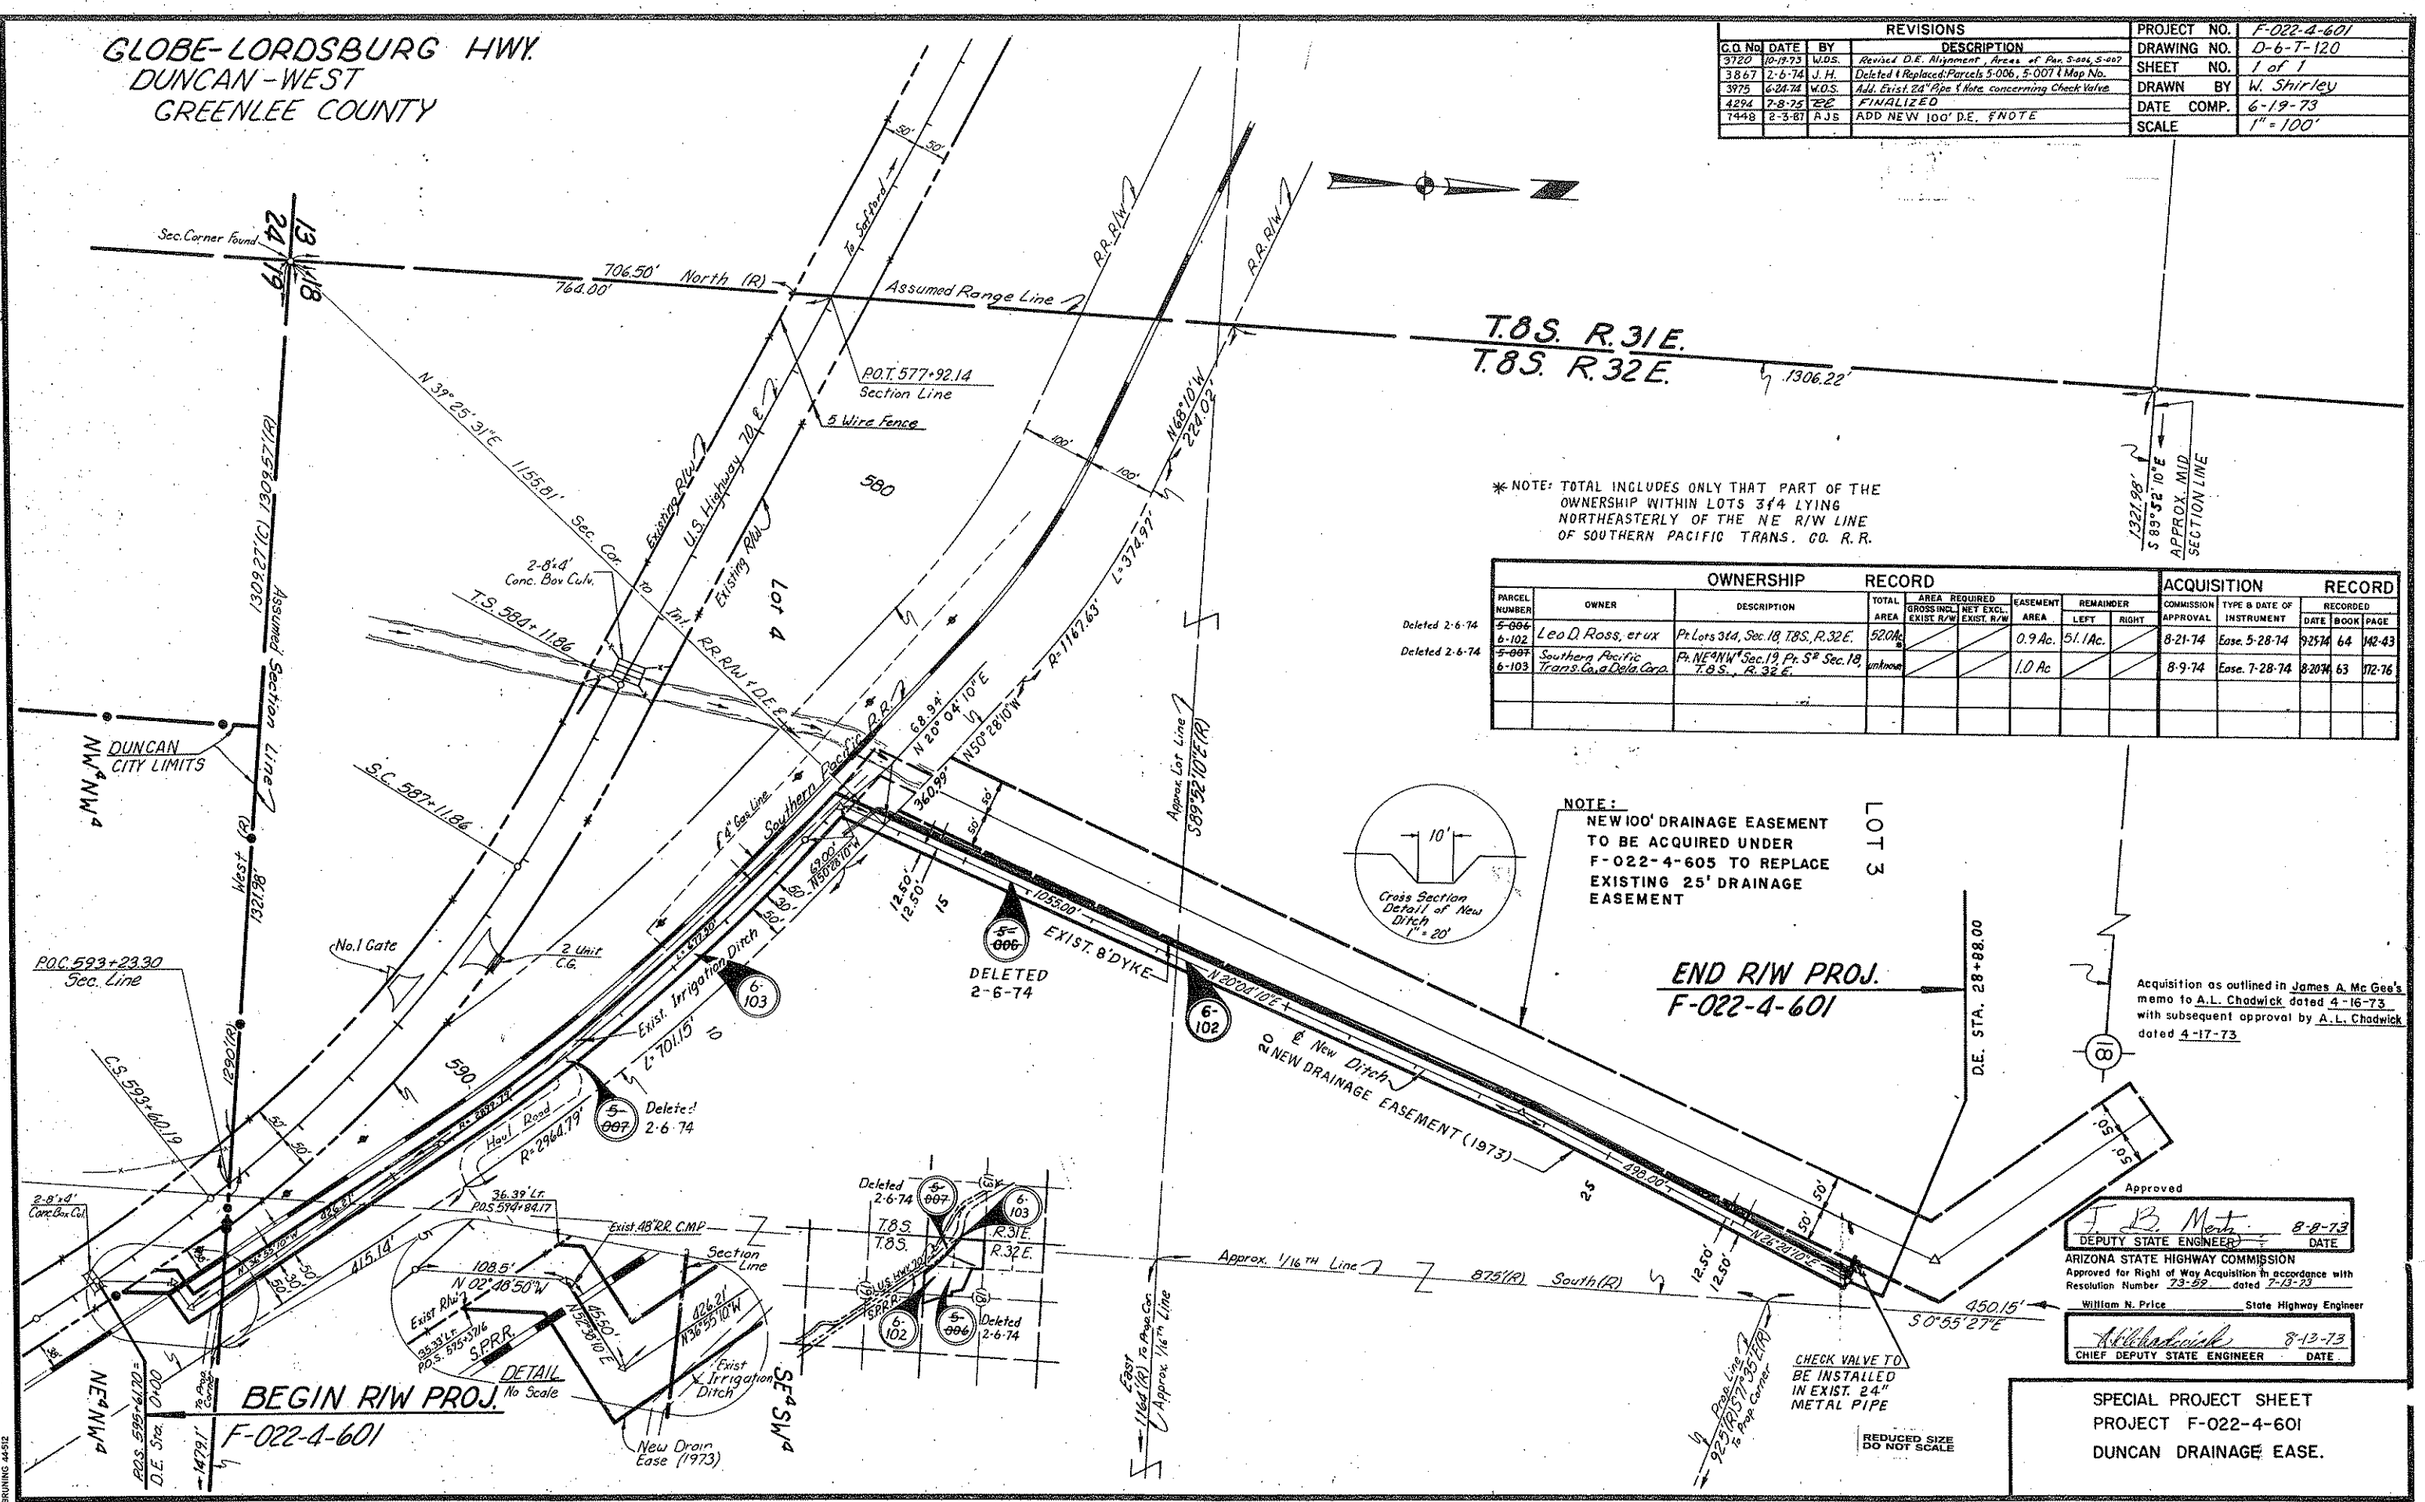

* NOTE: TOTAL INCLUDES ONLY THAT PART OF THE OWNERSHIP WITHIN LOTS 3 & 4 LYING NORTHEASTERLY OF THE NE R/W LINE OF SOUTHERN PACIFIC TRANS. CO. R.R.

OWNERSHIP RECORD									ACQUISITION RECORD				
PARCEL NUMBER	OWNER	DESCRIPTION	TOTAL AREA	AREA REQUIRED GROSS INCL. EXIST. R/W	AREA REQUIRED NET EXCL. EXIST. R/W	EASEMENT AREA	REMAINDER LEFT	REMAINDER RIGHT	COMMISSION APPROVAL	TYPE & DATE OF INSTRUMENT	RECORDED DATE	RECORDED BOOK	RECORDED PAGE
Deleted 2-6-74 ~~5-006~~ 6-102	Leo D. Ross, et ux	Pt. Lots 3 & 4, Sec. 18, T.8S., R.32E.	520 Ac.*			0.9 Ac.	51.1 Ac.		8-21-74	Ease. 5-28-74	9-25-74	64	142-43
Deleted 2-6-74 ~~5-007~~ 6-103	Southern Pacific Trans. Co. a Dela. Corp.	Pt. NE¼ NW¼ Sec. 19, Pt. S½ Sec. 18 T.8S., R.32E.	unknown			1.0 Ac			8-9-74	Ease. 7-28-74	8-20-74	63	172-76

Acquisition as outlined in James A. Mc Gee's memo to A.L. Chadwick dated 4-16-73 with subsequent approval by A.L. Chadwick dated 4-17-73

Click here for US 70 Index