D-2-T-376

FED. ROAD DIV. NO.	STATE	PROJECT NO.	SHEET NO.	TOTAL SHEETS	AS BUILT
7	ARIZ.				

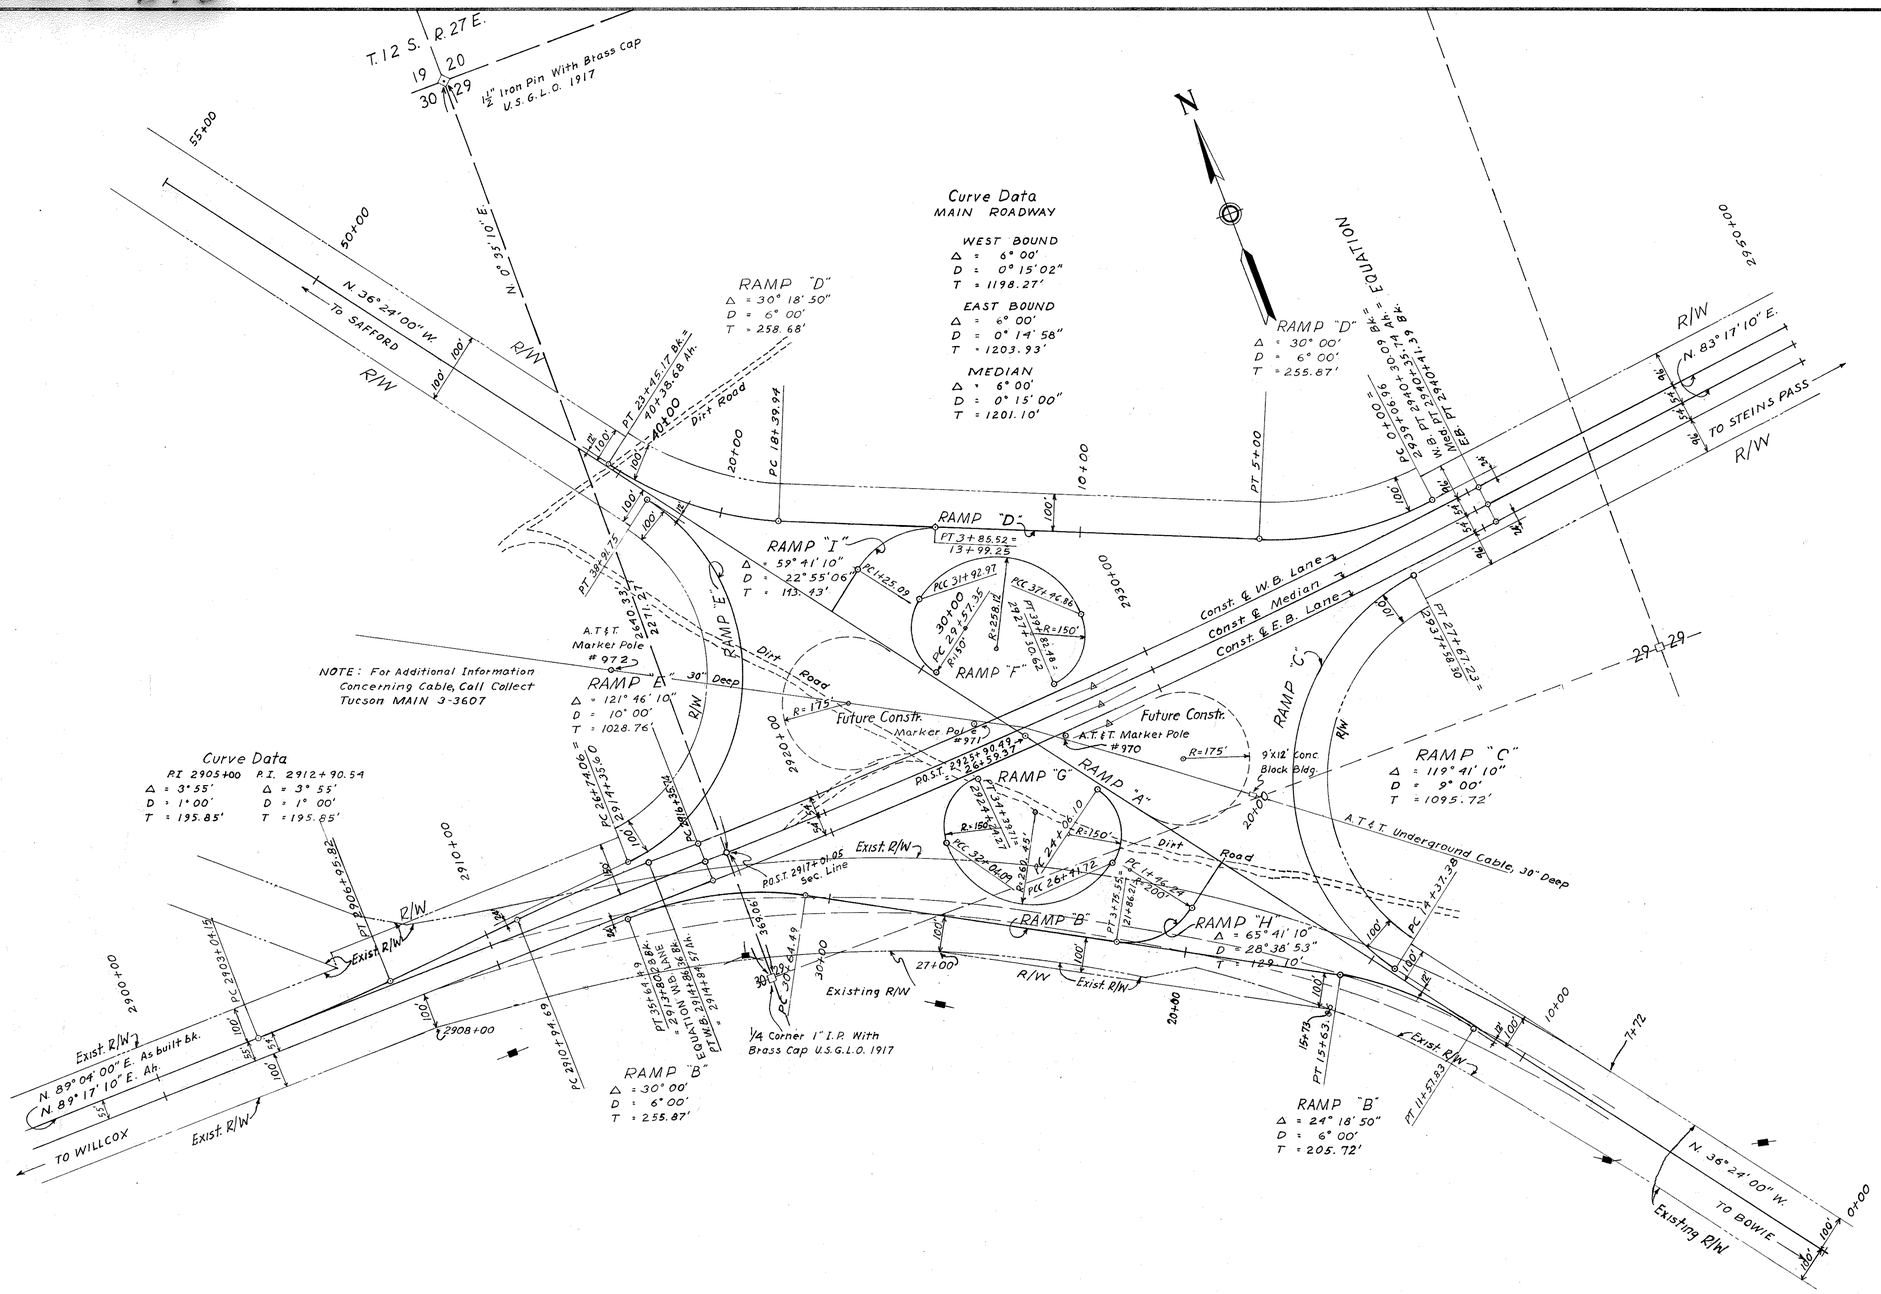

Click here for I-10 Index

ARIZONA HIGHWAY DEPARTMENT
RIGHT OF WAY DIVISION

RIGHT OF WAY MAP OF
BENSON–STEINS PASS INTERSTATE HIGHWAY
FEDERAL PROJECT I-002-5( )
INTERCHANGE–EAST LEG SAFFORD WYE
STA. 2900+00 TO STA. 2946+00
COCHISE COUNTY

Abutter's rights, including access rights to be acquired.
Date: _____ _____
Ass't. Deputy State Engineer

ALIGNMENT RIGHT OF WAY, AND CONTROL OF ACCESS APPROVED IN ACCORDANCE WITH RESOLUTION DATED: _____ 19 ___ MINUTES OF THE ARIZONA HIGHWAY COMMISSION

Access rights required shown thus: ||||||||||||||||||||||||

Registered Professional Engineer (Civil) Certificate Expires FRANCIS M. LIMBAUGH DEC. 31, 1958 ARIZONA, U.S.A.

LIMBAUGH ENGINEERING CONSULTING ENGINEERS

DESIGN		
TRACED		
CHECKED		

SUBMITTED BY: F M Limbaugh
FOR THE CONSULTING ENGINEER

DRAWN BY	DATE	SCALE	CHECKED BY	FILE NO.
K. CUMMINGS	FEB. 10, 58	1" = 200'		D-2-T-376

2	I-002-5-( )	1 OF 1