X.E.S.

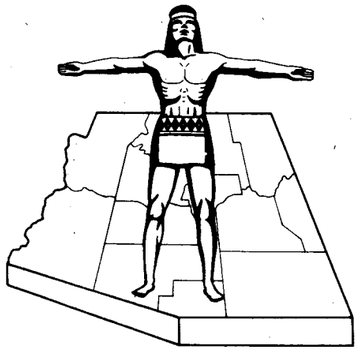

STATE OF ARIZONA
STATE HIGHWAY DEPARTMENT

RIGHT OF WAY PLAN OF THE

CASA GRANDE-TUCSON HWY.

STATE HIGHWAY

PROJECT NO. I-10-4(37)200

PINAL

COUNTY

FED.ROAD DIV. NO.	STATE	PROJECT NO.	SHEET NO.	TOTAL SHEETS
7	ARIZ.	I-10-4(37)200	1	13

RIGHT OF WAY MAP NO. D-11-T-376

ALIGNMENT, RIGHT OF WAY, AND CONTROL OF ACCESS APPROVED IN ACCORDANCE WITH HIGHWAY PLANS.

DATE 10-27-1961 R.E. Laurence
ASSISTANT STATE ENGINEER

APPROVED IN ACCORDANCE WITH RESOLUTION DATED: OCT. 25, 1961, MINUTES OF THE ARIZONA HIGHWAY COMMISSION BY RES.62-37

A.F.E. NO. 8459

FINALIZED

Click here for I-10 Index

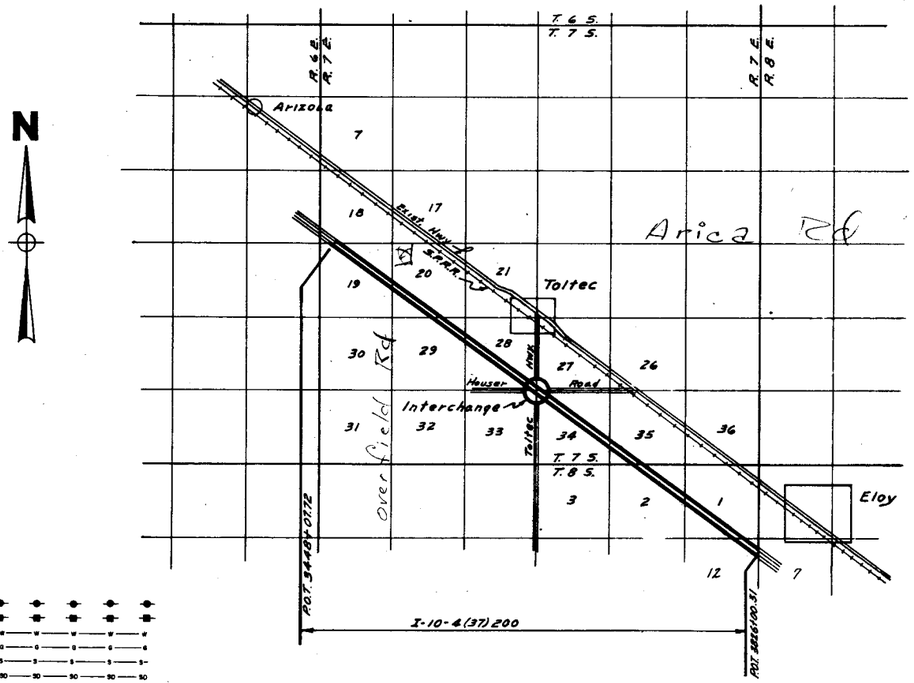

NOTE:

THE SOLID DOT, AS SHOWN BELOW, DOES NOT DESIGNATE A R/W MARKER BUT REPRESENTS AN ANGLE POINT OR CHANGE OF DIRECTION IN THE R/W LINE & IS FOR OFFICE USE ONLY.

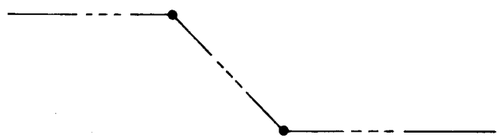

CONVENTIONAL SIGNS

- HIGHWAY CENTER LINE
- STATE AND NATIONAL LINES
- CITY LIMITS
- COUNTY LINE
- TOWNSHIP AND RANGE LINES
- SECTION LINE
- HIGHWAY R/W LINE (NEW)
- RAILROAD R/W LINE
- PROPERTY LINE
- LOT AND PROPERTY LINE (WITHIN EXISTING R/W)
- RAILROAD
- COMMON R.R. AND HWY. R/W LINE
- ACCESS TO BE DENIED
- ACCESS OPEN
- PARCEL ITEM No's
- FOREST, NAT'L. MONUMENTS, AND INDIAN BOUDARIES
- LAND GRANT BOUNDARY
- R/W MARKER
- HIGHWAY R/W LINE (EXISTING)
- SUBDIVISION OR LOT LINE
- TELEPHONE LINE
- POWER LINE
- WATER LINE
- GAS LINE
- SEWER LINE
- STORM DRAIN
- UNDERGROUND TEL. CABLE
- BARBED WIRE FENCE & OTHER
- CHAIN LINK FENCE
- POWER TRANSMISSION LINE
- TELEPHONE & POWER LINE
- POWER POLE WITH TRANSFORMER
- DOWN GUY
- LIGHT POLE
- FIRE HYDRANT
- WATER METER
- WATER VALVE
- MANHOLE
- EXIST. ROAD OR TRAVELED WAY
- GAS METER
- GAS VALVE

REDUCED SIZE DO NOT SCALE

ARIZONA HIGHWAY COMMISSION
APPROVED STATE HIGHWAY ENGINEER
R.E. Laurence 1-12-1962
FOR DEPUTY STATE ENGINEER DATE

DEPARTMENT OF COMMERCE
BUREAU OF PUBLIC ROADS
APPROVED
DIVISION ENGINEER DATE

MAP REVISIONS

DATE	NAME	DESCRIPTION
11-10-61	Sykes	Sheets 2, 3 + 6 corrected per B.P.R. request.
1-26-62	Rogers	Plotted Curves at Sta's. 3468, 3500, 3526 & 3569.
1-30-62	P. Julian	added Easement To Cross Sec. Bettigis Rd Casa Grande Tucson Hwy.
7-11-62	E. Espinoza	Computed Distances for Sheets 3, 4, 5, & 8, 9
8-7-62	Childers	Added Distances of Bearings From POT 3446+00 - POT 3500+00
9-14-62	R. Walley	Revised Brg. & Dist Sheet 12 & Acreage taken & Remain. Sheet 2 Item D-193
12-17-62	Sykes	Sheets 10+12 — Changed Items D-204 + D-204-1 to D-193
1-31-63	Jones & Jones	FINALIZED - Changed Sheets, Title Curves ins. C.O. #2671

COOLIDGE GRANDE-TUCSON HWY.
ARIZOLA - TOLTEC SEC.
PINAL COUNTY

Click here for I-10 Index

REVISIONS			
C.O. No.	DATE	BY	DESCRIPTION
5671	11/1/79	Uyeda	FINALIZED - Change 5 Stations in Orange
5330	3/22/79	R.W.M.	Removed existing R/W from Arica Road

PROJECT NO.	I-10-4 (37) 200
DRAWING NO.	D-11-T-376
SHEET NO.	2 OF 13
DRAWN BY	L. K. S.
DATE	SEPT. 11, 1961
SCALE	1" = 100'

OWNERSHIP RECORD — ACQUISITION RECORD

ITEM	OWNER	DESCRIPTION	ACREAGE TAKEN	ACREAGE REMAINING	DATE PROP. ACQUIRED	SHEET NO.	COMMISSION APPROVAL	TYPE & DATE OF INSTRUMENT	RECORDED DATE	RECORDED BOOK	RECORDED PAGE
D-193	C & V Sheep & Cattle Co.	All of Section 3 T 8 S R 7 E All of Section 13 T 8 S R 7 E	30.64 21.41	609.36 607.07		2 & 9 / 10 / 11 11 / 12 & 13	5/20/64	FOC. 12/2/63	3/17/64	378	553-555
D-194	Phoenix Title & Trust Co. as trustee, under Trust No. 2312	SW¼ Sec. 20 T 7 S. R 7 E.	24.2	135.8		3, 4 & 6	"	FOC. 10/10/68	10/24/68	551	138-142
D-194-1	Joa Trust Co.	S½ S½ SE¼, SW¼ Sec. 28 T. 7 S. R. 7 E.	22.4	177.6		5 & 6	"	FOC. 3/8/68	3/19/68	533	802-805
D-195	Florence L. Rice	S½ N½ SE¼, N½ NW¼ SE¼, N½ S½ SE¼ Sec. 28 T 7 S. R. 7 E.	14.39	85.61		5 & 6	"	W.D. 5/1/62	6/28/62	328	T-8
D-196	Oro-Verde Farms Inc.	All Of Sec. 33 T. 7 S. R. 7 E.	5.45	634.55		6	"	FOC. 3/11/68	4/4/68	535	269-271
D-197	B & R Ranches, Inc., et al	Part Of Sec. 27 T. 7 S. R. 7 E., lying S. of S.P.R.R. R/W	3.70			6	"	FOC. 8/9/64	9/21/64	396	114-115
D-198	~~Kerringer Bldg. Corp.~~ Frank C. Hale, et ux	All That Part Sec. 35 T. 7 S. R. 7 E., Lying South Of Southern Pacific R.R. R/W	7 [1.41 R/W] 15.19		(Temp Const Ease	8 & 9	"	W.D. 8/13/63	5/6/64	384	497-498
D-199	John D. Singh Et ux	All Of Sec. 34 T. 7 S. R. 7 E.	49.72	590.28		6, 7 & 8	"	FOC. 3/12/64	3/31/64	380	429-431
D-200-1	Phoenix Title & Trust Co. (Trustee)	Lot 1, NE¼ NW¼ Sec. 19 T 7 S. R. 7 E.	~~41.53~~ 11.98	~~65.58~~ 85.55		2 & 3	"	FOC. 12/18/67	1/9/68	527	566-570
D-200-2	Phoenix Title & Trust Co. (Trustee)	SE¼ Sec. 19 T 7 S. R. 7 E.	~~0.34~~ 3.96	~~159.66~~ 156.04		3	"	Same as D-200-1			
D-200-3	Phoenix Title & Trust Co. (Trustee)	SE¼ Sec. 20, S½, NE¼ Sec. 29, NW¼, SW¼ NE¼ Sec. 28 T. 7 S. R. 7 E.	~~35.94~~ 36.64	~~404.06~~ 403.36		4 & 5	"	Same as D-200-1			
D-201	Hill Land Co.	W½ NE¼ Sec. 19 T. 7 S. R. 7 E.	11.26	68.74		3	4/10/62	W.D. 3/27/62	6/20/62	327	274
D-202	Raymond E. Flaskered	W½ SE¼ NE¼ Sec. 19 T. 7 S. R. 7 E.	5.62	14.38		3	4/10/62	W.D. 4/2/62	5/23/62	325	256
D-203	Edward I. Comins	E½ SE¼ NE¼ Sec. 19 T. 7 S. R. 7 E.	2.58	17.42		3	4/10/62	W.D. 10/23/63	11/7/63	366	226-227
D-205	Clay Development Corp.	Por N½ Sec 1, T8S R7E	0.610	284.815		11 & 12	4/19/63	W.D. 4/5/63	5/28/63	354	84-88
D-206	Margarito & Estela G. Robles H/W, et al	S½ Sec 1 T8S R7E	3/.342	284.453		11 & 12	4/19/63	W.D. 4/11/63 Cor. W.D. 10/7/63	4/23/63 10/21/63	355 364	442-443 547-548

FINALIZED

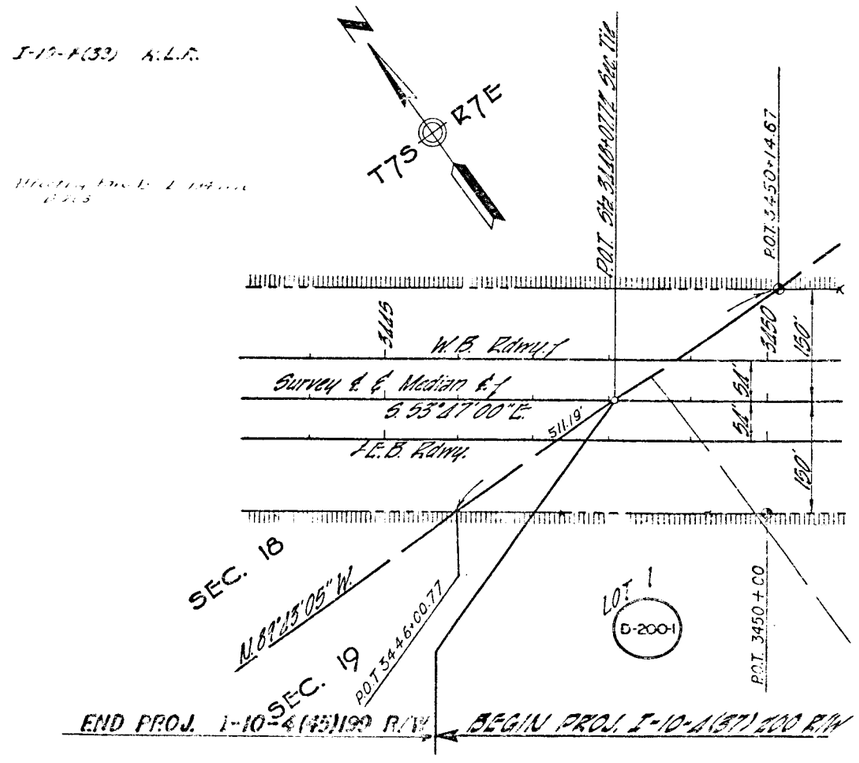

CASA GRANDE - TUCSON HWY.
ARIZONA - TOLTEC SEC.
PINAL COUNTY

REVISIONS			
CO. No.	DATE	BY	DESCRIPTION
2671	11/13/75	Wilson	Ent. Kinder-Chg. Ties Shown to Change
5335	3/22/78	R. Stitt	Removed Lighting R/W from Arica Overfield Roads

PROJECT NO.	I-10-4 (37) 200
DRAWING NO.	D-11-T-376
SHEET NO.	3 OF 13
DRAWN BY	L. K. S.
DATE	MAY 26, 1961
SCALE	1" = 100'

FINALIZED

Click here for I-10 Index

OR 324
PG 293

I-10-4(39) R.L.P.

Click here for I-10 Index

CASA GRANDE - TUCSON HWY.
ARIZOLA - TOLTEC SEC.
PINAL COUNTY

REVISIONS			
C.O. No.	DATE	BY	DESCRIPTION
2671	7/31/62	J.R.Hanna	FINALIZED - Changes Shown in Orange

PROJECT NO.	I-10-4 (37) 200
DRAWING NO.	D-11-T-376
SHEET NO.	4 OF 13
DRAWN BY	L. K. S.
DATE	MAY 26, 1961
SCALE	1" = 100'

FINALIZED

T7S R7E

S83°41'00"E 100'

Drainage Easement

S6°19'00"W 197.73'

N6°19'00"E 200'

60°

Approx. Mid-Section Line

Approx. 1/16 Line

N.W. 1/4 S.W. 1/4

N.E. 1/4 S.W. 1/4

S.E. 1/4 S.W. 1/4

S.W. 1/4 S.W. 1/4

S.W. 1/4 S.E. 1/4

N.W. 1/4 N.E. 1/4

S.W. 1/4 N.W. 1/4

N.E. 1/4 N.E. 1/4

S.E. 1/4 N.E. 1/4

D-194

D-200-3

R/W Marker Set

New 5 Wire Fence

New R/W

W.B. Rdwy.

Median

Survey

E.B. Rdwy.

3244.04'

3256.90'

3510

3515

3520

3525

3530

3535

3540

3545

3550

3555

3560

3565

3570

150'

54'

60'

2 NEW 4-10'X5' C.B.C.S

No Access

P.O.T. Sta 3529+35.12

P.O.T. Sta 3550+28.98 (Calc.)

P.O.T. Sta 3531+62.14

Remove Within R/W

Ex. Conc. Rd.

Ex. Dirt Rd.

N 0°

N 50°

56°21'50"

56°21'05"

SEC. 19

SEC. 20

1/4 Corner Fd. 3/4" Pipe, Brass Cap Marked U.S.G.L.O. 1918

Section Corner Not Fd. Set Rear Car Axle

N. 89°36'30" E.

Approx. Section Line

N 36°19'00"E

S36°19'00"W

100'

S53°41'00"E

N53°41'00"W

N.W. 1/4 N.W. 1/4 Sec. 21

Legal R/W

Exist. R/W

P.O.T. Sta 3565+61.97 Sec. Tie

N.O.°35'55"W.

Part of Drainage Easement

Remove Within R/W

REDUCED SIZE
DO NOT SCALE

CASA GRANDE-TUCSON I.W.H.
ARIZOLA - TOLTEC SEC.
PINAL COUNTY

REVISIONS			
C.O.No.	DATE	BY	DESCRIPTION
2671	7/31/70	JR Hunt	FINALIZED-Changes Shown in Orange

PROJECT NO.	I-10-4 (37) 200
DRAWING NO.	D-11-T-376
SHEET NO.	5 OF 13
DRAWN BY	L. K. S.
DATE	MAY 26, 1961
SCALE	1" = 100'

FINALIZED

T7S R7E

Approx Mid-Section Line

Approx 1/16 Line

New 5 Wire Fence

P.O.T. Sta 3584+70.32

Remove Within R/W
& Strand B/W
W. Dirt Rd
& E. Dirt Rd

No Access

New R/W

P.O.T. Sta 3596+70.70 (Cal.)

P.O.T. Sta 3597+83.58

P.O.T. Sta 3595+47.82

P.O.T. Sta 3588+67.11 (Cal.)

P.O.T. Sta 3580+63.90

Survey ℄

Median ℄
S 55°21'00" E

W.B. Rdwy.

E.B. Rdwy.

Approx Light & Water Line

Remove Within R/W
Dirt Rd.

4787.86

505.15'

1087.50'

375.46'

1719.68

S 89° 53' 00" W

S 36°19'00" W
65.32'

N 36°19'00" E
139.33'

100'
Drainage Easement

S 53°41'00" E

S 36°19'00" W
150'

N 36°19'00" E
150'

100'
Drainage Easement

S 53°41'00" E

N 0°38'45" W

Approx 1/16 Line

3570 3575 3580 3585 3590 3595 3600 3605 3610 3615

150' 24' 24' 150'

+50 +50 +50 +50

D-200-3 D-194-1 D-195

N.W.¼ S.W.¼ N.W.¼
N.E.¼ S.W.¼
S.W.¼ S.E.¼

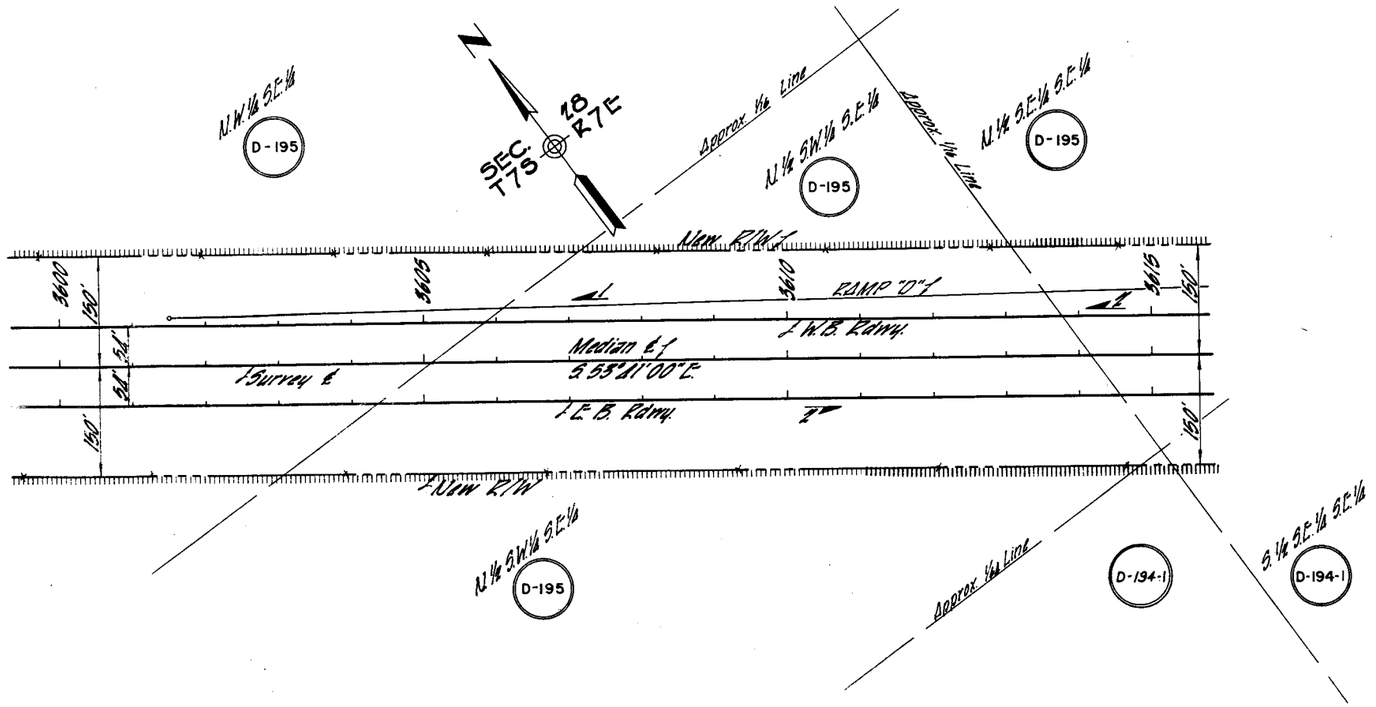

Click here for I-10 Index

REDUCED SIZE
DO NOT SCALE

Click here for I-10 Index

CASA GRANDE - TUCSON HWY.
ARIZOLA - TOLTEC SEC.
PINAL COUNTY

REVISIONS			
C.O. No.	DATE	BY	DESCRIPTION
2671	7/31/70	JR	FINALIZED - Changes Shown In Orange
4537	5-14-74	W. HILLS	Showed & Called out Abandoned Land
"	"	"	Left Sta 362+31 To Sta 363+31 and
"	"	"	Right Sta 362+42 To Sta 363+51

PROJECT NO.	I-10-4 (37) 200
DRAWING NO.	D-11-T-376
SHEET NO.	6 OF 13
DRAWN BY	L. K. S.
DATE	MAY 26, 1961
SCALE	1" = 100'

Registered Professional Engineer (Civil) — Roland Jacobsmith, Jr. — Dec. 31, 19[illegible] — Arizona, U.S.A.

FINALIZED

Abandoned Land
Res No 76-05-A-09 Dated March 26, 1976
Recorded Pinal County
Docket 818, Pages 452-458

Abandoned Land
Res. No. 76-05-A-09 Dated March 26, 1976
Recorded Pinal County
Docket 818, Pages 452-458

1/4 Cor. Fd. Mon.
Exist. R/W
N. 0°25'45" W.
816.90' Lt. Mod. Sta 362+14.96
820.62' Lt. Mod. Sta 362+53.05
R/W Markers Set
S. 89°49'00" E. 19.84'
759.71' Lt. Mod. Sta 362+92.93
R/W Markers Set
758.65' Lt. Mod. Sta 363+32.05
S. 89°49'00" E. 19.84'
S. 10°36'00" E. 1100.00'
561.79' Lt. Mod. Sta 363+71.57
N. 20°36' 00" W.
R/W Markers Set
N. 89°49'00" W. 162.81'
New Cattle Guard
4 Unit C-14
New 5 Wire Fence
391.89' Lt. Mod. Sta 364+03.89
S. 76°58'51" E. 1120.06'
150' Lt. Mod. Sta 364+00
R/W Marker Set
Approx. Sec. Line
RAMP "D"
P.O.T. Sta 361+85.54 (Cal.)
R/W Marker Set
S. 52°39'46" E. 138.82'
S. 15°47'15" E. 211.14'
150' Rt. Mod. Sta 362+00
New 5 Wire Fence
199.11' Rt. Mod. Sta 362+66.84
R/W Markers Set
211.89' Rt. Mod. Sta 362+76.85
Approx. Sec. Line
N. 89°45'00" W.
Exist. R/W
HOUSE
Exist. R/W
Sec. Line & Exist. 20' Rdwy.
28 Sec. Cor. Fd. 3/4" Pipe, Brass Cap Marked U.S.G.L.O. 1928
S. 1/4 S. 1/2 S.E. 1/4
D-194-R
N.E. 1/4 N.E. 1/4
D-196
S.W. 1/4 S.W. 1/4
D-197
N. 1/2 S. 1/2 S.E. 1/4
D-195
N.W. 1/4
D-199
P.O.T. Sta 361+85.54 Sec. Tie
P.O.T. Sta 361+99.40 Sec. Tie
P.O.T. Toltec Crossroad Sta 11+99.40 Sec. Tie
Section Corner Fd. Mon.
N. 37°39'37" W. (130.55')
S. 10°19'23" W. 1100.05'
568.30' Lt. Mod. Sta 363+66.82
589.59' Lt. Mod. Sta 363+22.90
561.98' Lt. Mod. Sta 363+58.06
R/W Markers Set
N. 89°40'17" E.
S. U. M. P. To Irr. Pump
Exist. R/W
Exist. Line & & Exist. 20' Rdwy.
ROAD
R/W Markers Set
515.54' Lt. Mod. Sta 365+05.61
501.70' Lt. Mod. Sta 365+15.75
N. 10°19'23" W. 1100.00'
477.85' Lt. Mod. Sta 365+76.66
150' Lt. Mod. Sta 365+00
R/W Marker Set
5672.25' (R)
RAMP "C"
N. 89°40'17" E. 111.51'
Main R/W Line
W.B. Rdwy. ℄
Median ℄
S. 55°21'00" E.
I.F.B. Rdwy.
℄ Survey
TOLTEC
TOLTEC CROSSROAD
N. 01°11'00" E.
AIR STRIP
Exist. R/W
Exist. 20' Rdwy.
ROAD
New Cattle Guard
4 Unit C-14
S. 89°49'00" E. 161.77'
R/W Markers Set
S. 20°36'00" E. 1954.80'
RAMP "A"
New R/W
N. 10°11'00" E. 1100.00'
R/W Markers Set
S. 89°49'00" E. 16.99'
RAMP "B"
R/W Marker Set
5385.85' (R)
150' Rt. Mod. Sta 364+00
R/W Marker Set
S. 89°49'00" E. 25.84'
1/4 Cor. Fd.
T 15 S
R 7 E
35
1
T 16 S
R 7 E
Section Corner Fd. 2" Iron Pipe
REDUCED SIZE
DO NOT SCALE

CASA GRANDE - TUCSON LINE
ARIZOLA - TOLTEC SEC.
PINAL COUNTY

Click here for I-10 Index

REVISIONS			
CO. No	DATE	BY	DESCRIPTION
2671	7/31/70	[illegible]	FINALIZED - Changes Shown in Orange

PROJECT NO.	I-10-4 (37) 200
DRAWING NO.	D-11-T-376
SHEET NO.	7 OF 13
DRAWN BY	L. K. S.
DATE	MAY 26, 1961
SCALE	1" = 100'

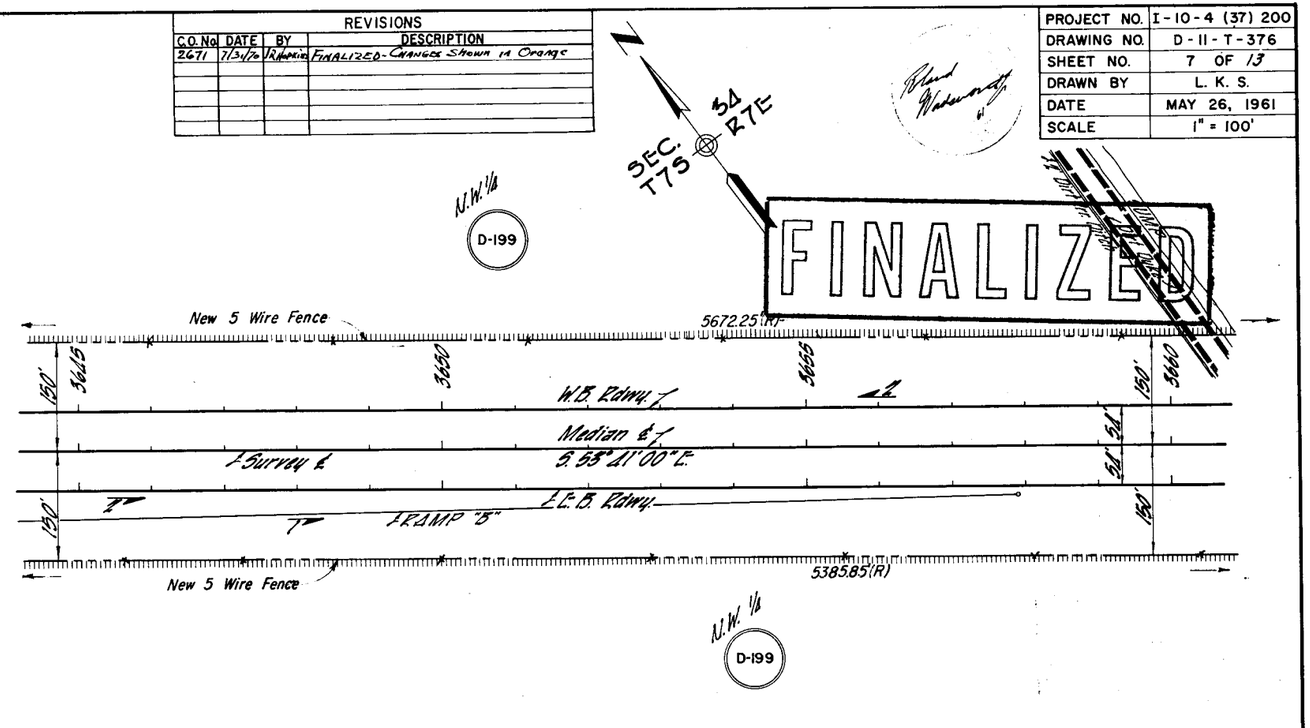

FINALIZED

REDUCED SIZE
DO NOT SCALE

CASA GRANDE - TUCSON LINE
ARIZOLA - TOLTEC SEC.
PINAL COUNTY

REVISIONS			
CO No.	DATE	BY	DESCRIPTION
2411	11-6-61	[illegible]	Finish Sec. Changed Sec. Tie to 2 Sec.

NOTE: See Sheet No. 9 for R/W on Battaglia Crossroad

FINALIZED

PROJECT NO.	I-10-4 (37) 200
DRAWING NO.	D-11-T-376
SHEET NO.	8 OF 13
DRAWN BY	L. K. S.
DATE	MAY 26, 1961
SCALE	1" = 100'

Section Corner Fd. 3/4" Iron Pin

16 / 35 / 34 / 17

1/4 Cor. Not Fd.

Exist. R/W

Exist. R/W

GULLY

R/W Marker Set

S.E. 1/4 D-199

567.25'

3690

150' Lt. Survey ℄ P.O.T. 3693+72.26

150'

54'

54'

150'

3695

3700

3705

3710

3715

3716

New R/W ℄

W.B. Rdwy. ℄

Median ℄

S. 55°21'00" E.

Survey ℄

E.B. Rdwy. ℄

New R/W

54'55'00"

130' Rt. Survey ℄ P.O.T. 3695+85.84 R/W Marker Set

5385.85

Const. Easement

Exist. R/W

Sec. Line ℄ Exist. 26' Graded Rdwy.

N. 00°49'00" E.

S.E. 1/4 D-199

S.W. 1/4 D-198

S.W. 1/4 D-198

T7S R7E 34 35 1 R7E T8S

Section Corner Fd. 3/4" Iron Pipe

Battaglia Sta. 15+00 Sec. Tie

Mid. Sta. 3716+22.57

Section Corner Fd. 3/4" I.P. Brass Cap Marked U.S.G.L.O. 1920

35 36 1

Const. Easement

R/W Marker Set

Exist. R/W

N. 89°40'05" E.

R/W Marker Set

Exist. R/W

Sec. Line ℄ Exist. 26' Graded Rdwy.

5308.15'

37+81.45

56°38'55"

502.59

3714+78.74

R/W Marker Set

459.39

150'

54'

54'

150'

LINE

MATCH with Sheet No. 9

T7S R7E 34 35 1 R7E T8S

Section Corner Fd. 3/4" Iron Pipe

N.W. 1/4 D-193

FOR DETAIL OF BATTAGLIA ROAD SEE SHEET 8 of 13 BELOW

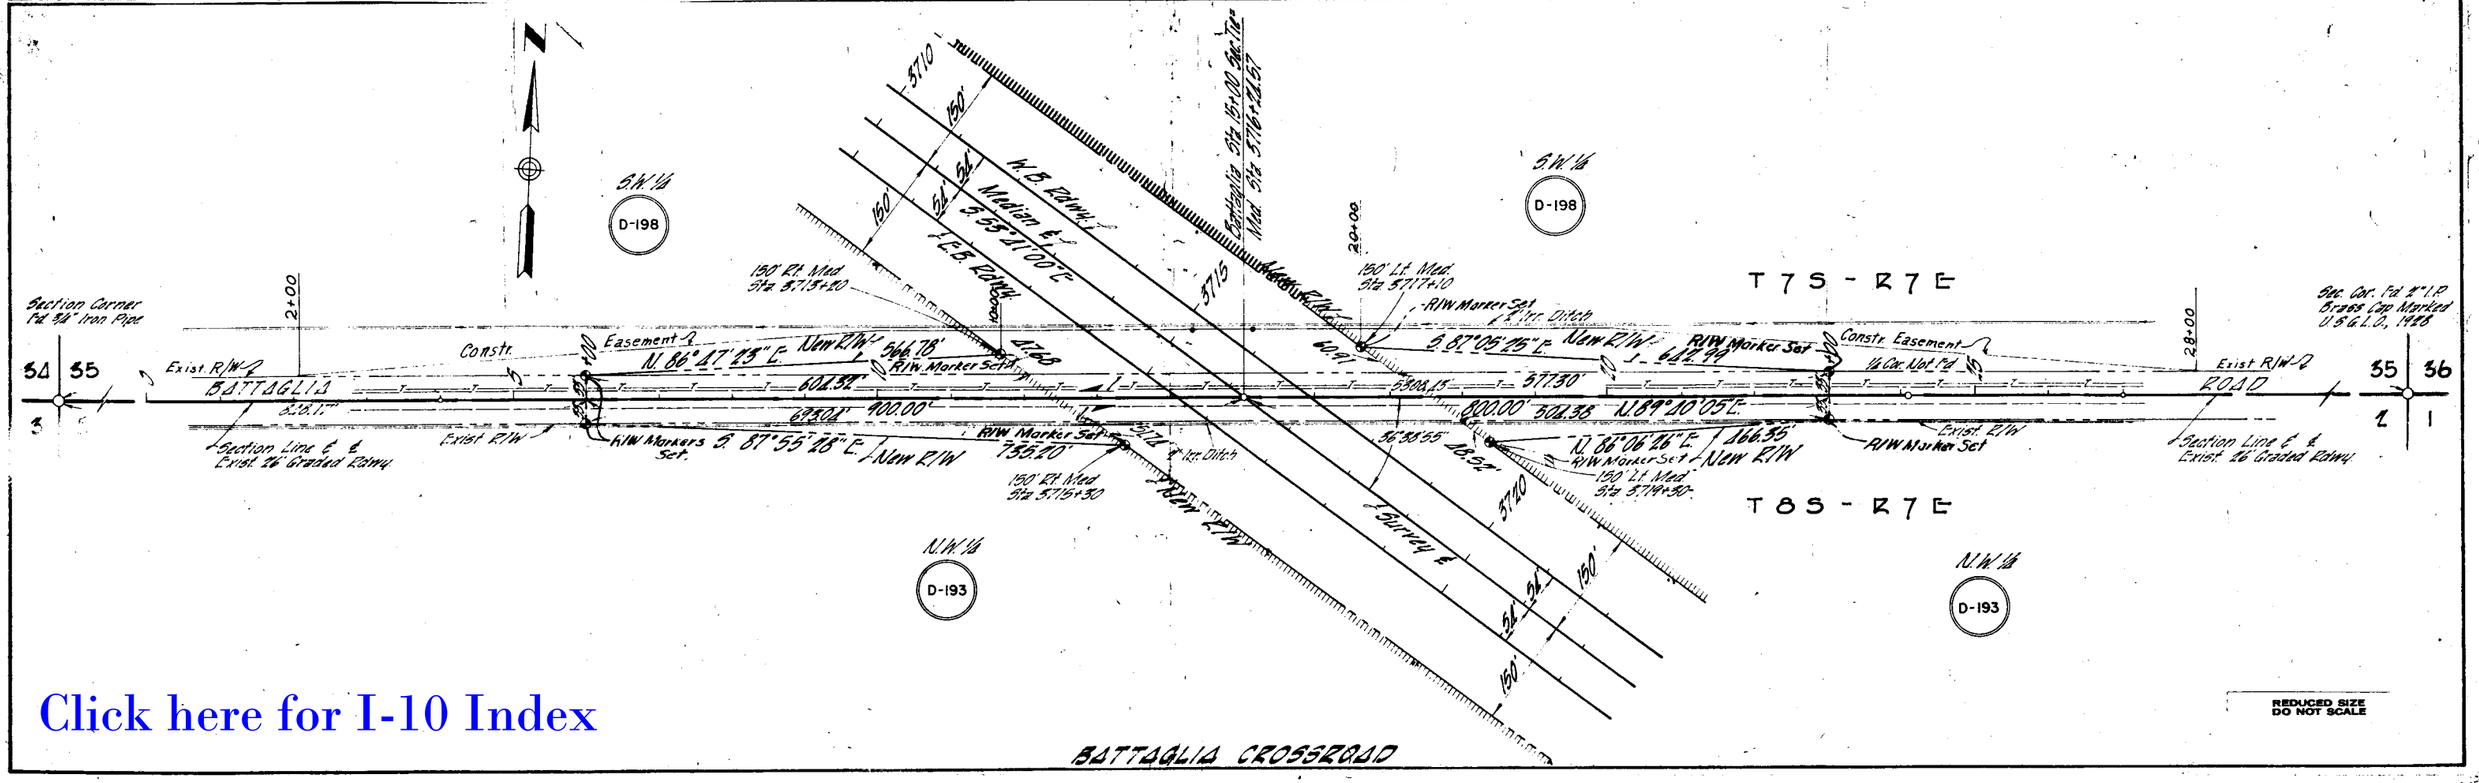

BATTAGLIA CROSSROAD

Click here for I-10 Index

REDUCED SIZE DO NOT SCALE

CASA GRANDE – TUCSON HWY.
ARIZOLA TOLTEC SECTION
PINAL COUNTY

Click here for I-10 Index

REVISIONS			
C.O. No.	DATE	BY	DESCRIPTION
2671	7/31/70	JR Waters	FINALIZED - Changes shown in Orange.

MARUM & MARUM CONSULTING ENGINEERS
232 E. SIXTH ST. TUCSON ARIZONA
DESIGNED ZEM | TRACED MERRILL | DATE 12-11-61
DRAWN | CHECKED W.D. | REV. AND 1-8-62 2-28-62 | 1973

PROJECT NO.	I-10-4(37)200
DRAWING NO.	D-11-T-376
SHEET NO.	9 of 13
DRAWN BY	RWJ
DATE	3-15-62
SCALE	1" = 100'

FINALIZED

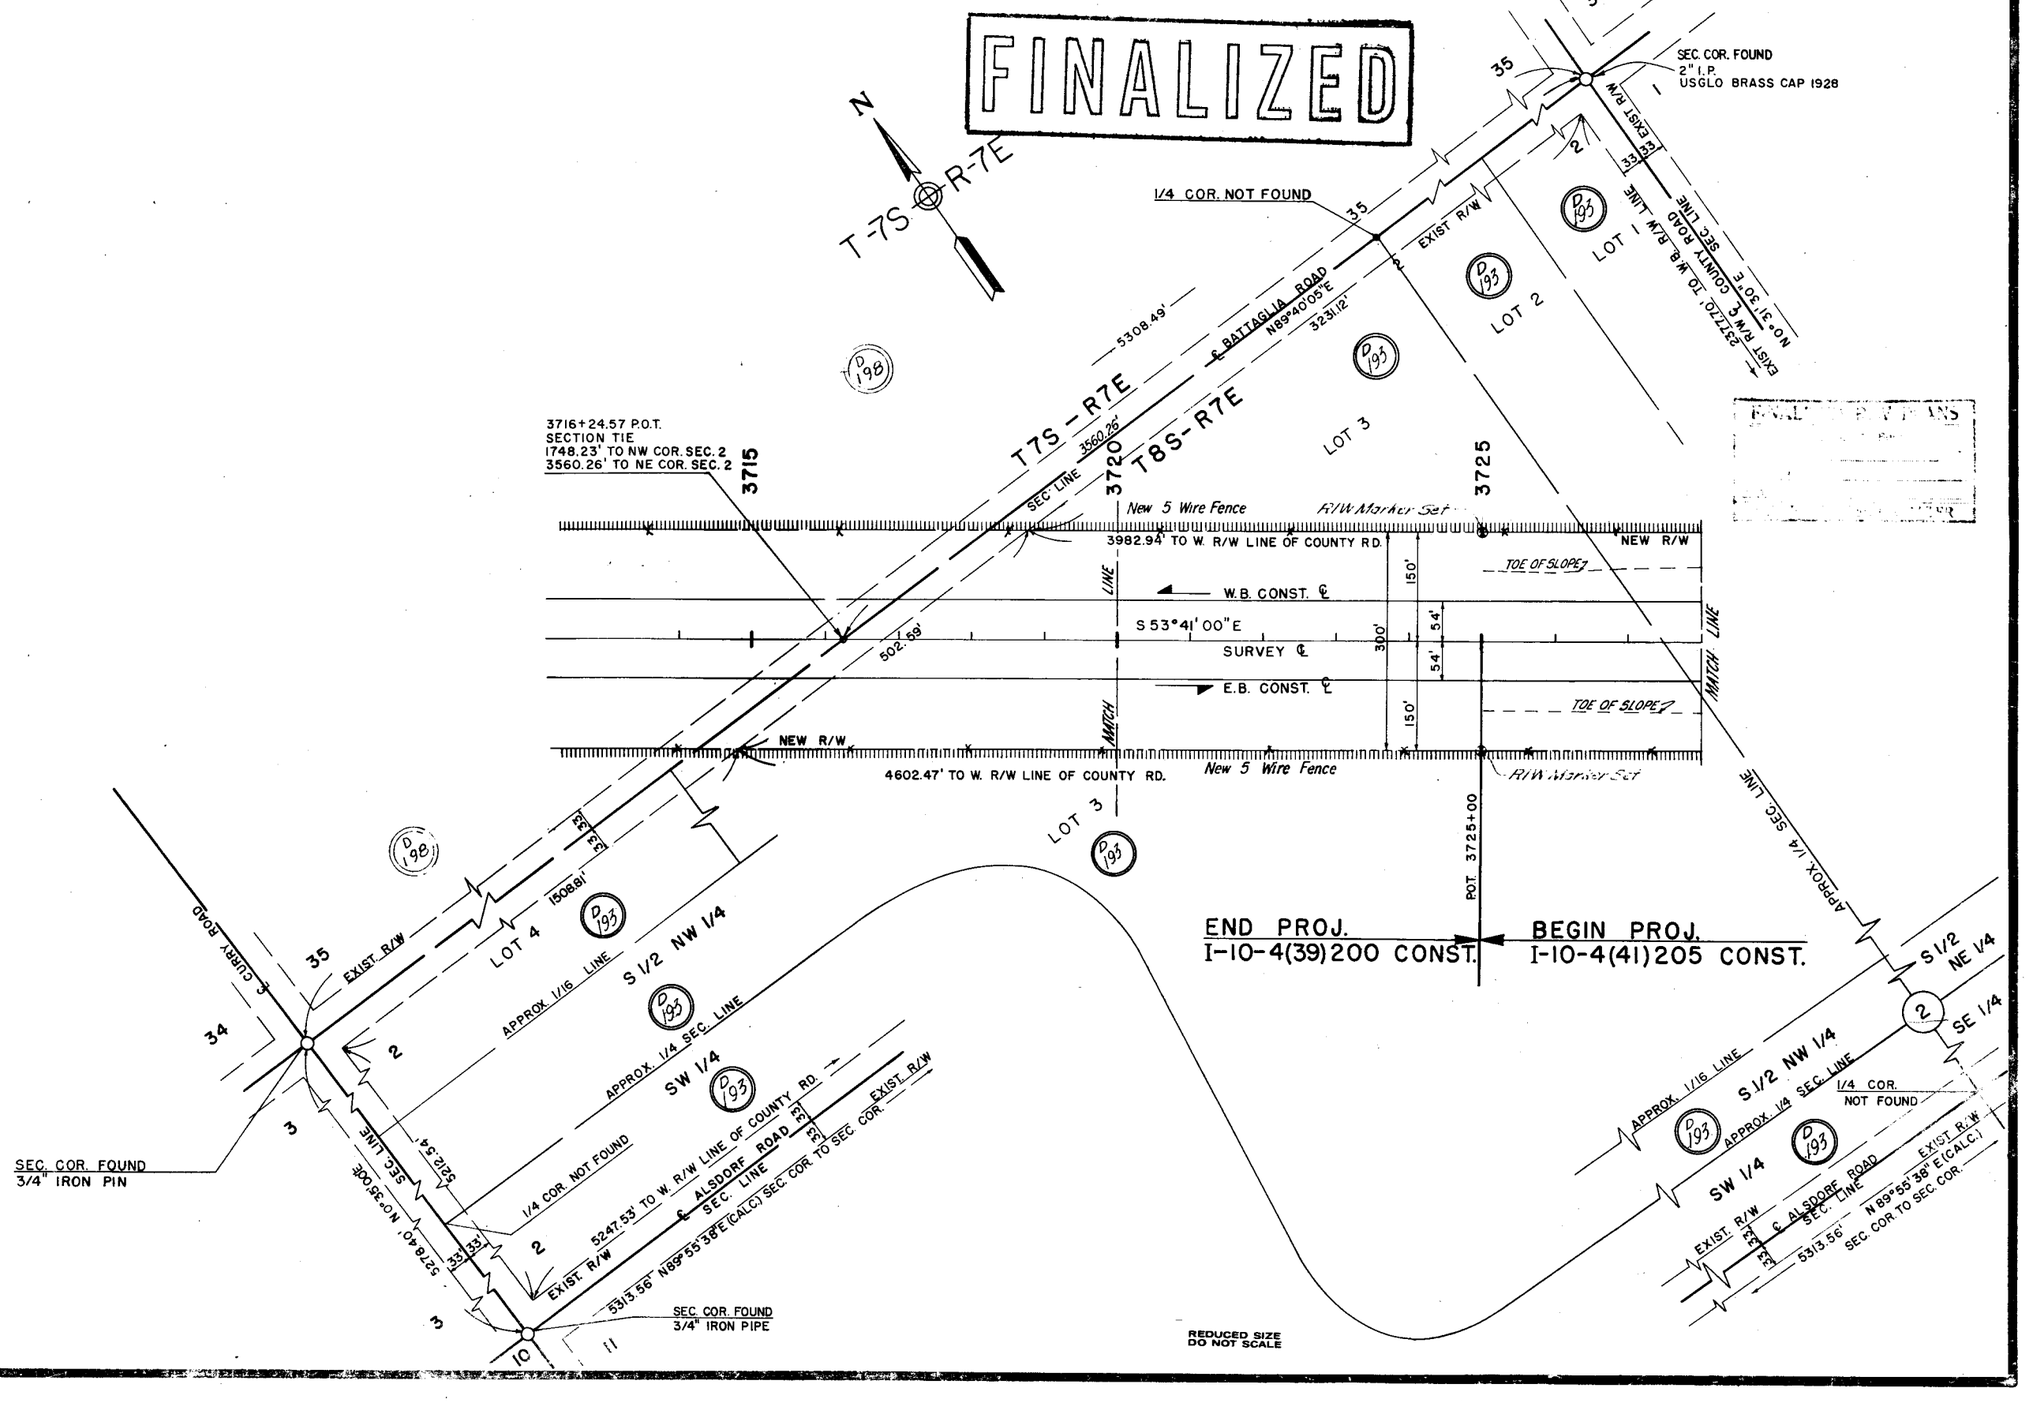

REDUCED SIZE
DO NOT SCALE

CASA GRANDE - TUCSON HWY.

ARIZOLA - TOLTEC SECTION

PINAL COUNTY

REVISIONS			
C.O No.	DATE	BY	DESCRIPTION
2671	7/31/70	VR Hopkins	FINALIZED - Changes shown in Orange

MARUM & MARUM CONSULTING ENGINEERS
232 E. SIXTH ST. TUCSON ARIZONA

DESIGNED	TRACED	DATE		
E.M.M.	M.B.R.J.	12-11-61		
DRAWN	CHECKED	REVISED	2-28-62	1.973
	W.B.	1-3-62		

PROJECT NO.	I-10-4(37)200
DRAWING NO.	D-11T-376
SHEET NO.	10 of 13
DRAWN BY	RWJ
DATE	3-15-62
SCALE	1" = 100'

CENTRAL FILES DATA
FIELD BOOKS 11-236-F, 11-381-F
FIELD COPY 11-381-F
STRUCTURES
MISC.

T7S-R7E
T8S-R7E
T-8S R-7E
N
35
36
1
2
LOT 1
LOT 2
LOT 4
LOT LINE
S 1/2 NE 1/4
SE 1/4
D 193
℄ BATTAGLIA ROAD
EXIST R/W
SEC. LINE
SEC. COR.
N89° 40' 05"E 5308.49' SEC. COR. TO SEC. COR.
5308.49' N89° 40' 05"W SEC. COR. TO SEC. COR.
TO NEW R/W LINE 323.12'
SEC. COR. FD 2" I.P. BR. CAP U.S.G.L.O. 1928
TO W.B. R/W LINE 2625.98'
TO W.B. R/W LINE 2372.70'
TO SEC. COR. S 0° 23' 30" W 2302.35'
EXIST R/W
COUNTY ROAD
℄ SEC. LINE
3730
3735
3740
3745
3750
3755
New 5 Wire Fence
NEW R/W
3982.94' FROM S. R/W LINE BATTAGLIA RD. TO W. R/W LINE COUNTY RD.
Toe of Slope
W.B. CONST. ℄
SURVEY ℄
E.B. CONST. ℄
S 53° 41' 00" E
MATCH LINE
150'
300'
54'
4602.47' FROM S. R/W LINE BATTAGLIA RD. TO W. R/W LINE COUNTY RD.
APPROX. 1/16 LINE
APPROX. 1/4 SEC. LINE
APPROX. 1/4 SEC. LINE
APPROX. LOCATION
TO EAST R/W LINE OF CURRY ROAD 5247.53' (CALC.)
EXIST R/W
℄ ALSDORF ROAD
SEC. LINE
5313.56' N 89° 55' 38" E (CALC.) SEC. COR. TO SEC. COR.
TO E.B. R/W LINE 2488.64'
TO SEC. COR. N 0° 31' 30" E 2302.35'
SEC. COR. FOUND 1/2" IRON PIN
5247.53' (CALC.) TO EAST R/W LINE OF CURRY RD.
5313.56' N89° 55' 38" E (CALC.) SEC. COR. TO SEC. COR.

FINALIZED

Click here for I-10 Index

REDUCED SIZE DO NOT SCALE

CASA GRANDE - TUCSON HWY.

ARIZOLA - TOLTEC SECTION

PINAL COUNTY

REVISIONS			
C.O. No.	DATE	BY	DESCRIPTION
2671	7/31/70	JR Hopkins	FINALIZED - Changes shown in Orange.

MARUM & MARUM CONSULTING ENGINEERS
232 E. SIXTH ST. TUCSON, ARIZONA

DESIGNED	TRACED	DATE		
EFM	MBERJ	12-11-61		
DRAWN	CHECKED	REVISED		1973
	WB	1-5-62	2-28-62	

PROJECT NO.	I-10-4(37)200
DRAWING NO.	D-11T-376
SHEET NO.	11 of 13
DRAWN BY	RWJ
DATE	3-15-62
SCALE	1" = 100'

Edmund F. Marum

FINALIZED

T-8S R-7E

SEC. 1 NW 1/4 SE 1/4 — APPROX. 1/4 SEC. LINE — APPROX. 1/4 SEC. LINE SW 1/4

SOUTHERN PACIFIC RAILROAD
N 53°40'06"W
100' 100'
RR R/W LINE
2302.80' TO W. R/W LINE OF 11 MILE RD.

SEC. COR. FOUND
2" I.P. BRASS CAP
U.S.G.L.O. 1928

T7S-R7E
T8S-R7E
℄ BATTAGLIA ROAD
N89°48'52"W
EXIST. R/W
3367.45' (CALC.)
EXIST R/W
36
35
1
2
LOT 1
LOT 2
LOT 3
LOT 4
S1/2 NW 1/4
S1/2 NE 1/4
APPROX. 1/16 LINE
D 205
D 206
SEC. LINE
N0°31'30"E
2711.70'
2423.98'
3760+13.24 P.O.T.
SECTION TIE
2682.43' TO SE COR. SEC. 2
2619.92' TO NE COR. SEC. 2
APPROX. 1/4 SEC. LINE 4984.10' (CALC.) TO W. R/W LINE OF 11 MILE RD.
EXIST. IRR. DITCH (NOT LINED)
EXIST. DIRT ROAD
Removed within R/W
3760
3765
3770
3775
3780
3785
SW 1/4
New 43"X 27" C.M.P. Arch
New 5 Wire Fence
←3982.94' TO S. R/W LINE OF BATTAGLIA RD.
332.79'
No Access
New R/W
NO ACCESS
4299.57' TO NEW N. R/W LINE OF ALSDORF RD.
Toe of Slope
W.B. CONST. ℄
SURVEY ℄
E.B. CONST. ℄
S53°41'00"E
300'
150'
54'
54'
150'
Toe of Slope
MATCH LINE
POT. 3759+32.50
NEW 24"X370' CONC. IRR. PIPE W/RUBBER SEALED JOINTS SK 36° LT.
3759+74 POT.
3-WIRE POWER LINE (27.3' CLEARANCE)
DITCH
ACCESS
S/W MON.
SUMP
EXIST R/W
269.96'
150.61'
41.00'
←4602.47' TO S. R/W LINE OF BATTAGLIA RD.
4030.66' TO NEW N. R/W LINE OF ALSDORF RD.
POT. 3776+60
~~NEW 24"X370' CONC. IRR. PIPE W/ RUBBER SEALED JOINTS SK. 39° LT.~~
EXIST IRR. DITCH
EXIST DIRT ROAD
New 43"X 27" C.M.P. Arch
Deleted Field C.O. #1 I-10-4 (41)
1/4 COR. NOT FOUND
EXIST R/W
2488.64'
2440.38'
℄ COUNTY ROAD
SE 1/4
SW 1/4
NW 1/4
D 193
D 206
2135.78' TO ALSDORF ROAD
℄ ALSDORF ROAD
STA. 0+00
SEC. LINE
N 89°56'43"E
1
2
11
12
(CALC.) 5247.53' TO E. R/W LINE OF CURRY RD.
CALC. 5313.56' N89°55'38"E
SEC. COR. TO SEC. COR.
SEC. COR. FOUND
1/2" IRON PIN

Click here for I-10 Index

REDUCED SIZE
DO NOT SCALE

CASA GRANDE - TUCSON HWY.

ARIZOLA - TOLTEC SECTION
PINAL COUNTY

REVISIONS			
C.O. No.	DATE	BY	DESCRIPTION
2671	7/31/70	JR Hanlin	FINALIZED - Changes shown in Green

MARUM & MARUM CONSULTING ENGINEERS
232 E. SIXTH ST. TUCSON, ARIZONA
DESIGNED E.P.M. | TRACED [illegible] | DATE 12-11-61
DRAWN | CHECKED | REVISED 1-5-62, 2-28-62 | 1973

PROJECT NO.	I-10-4(37)200
DRAWING NO.	D-117-376
SHEET NO.	12 of 13
DRAWN BY	RWJ
DATE	3-15-62
SCALE	1" = 100'

REGISTERED CIVIL ENGINEER
CERTIFICATE NO. 5,678
E. P. MARUM
DEC. 31, 1962
ARIZONA, U.S.A.

FINALIZED

ALSDORF ROAD GRADE SEPARATION

(ALSDORF ROAD OVER INTERSTATE)
NEW STEEL GIRDER BRIDGE
26' CLEAR ROADWAY

N
T-8S R-7E

APPROX. 1/4 SEC. LINE
N 89° 59' 21" W 4984.10' (CALC.) TO W.B. R/W LINE
1/4 COR. NOT FOUND
SEC. COR. FOUND 3/4" IRON PIN
EXIST. R/W
EXIST. R/W LINE 11 MILE ROAD
2488.64' (CALC.) TO R.R. R/W
N 0° 20' 30" W 2660.70'
533.55' TO SEC. COR.
N89°43'33"W
2639.52' TO N/S 1/4 SEC. LINE
N89°56'43"E 357.77'
N89°56'43"E 357.14'
NE 1/4, SE 1/2, SE 1/4, SW 1/4, S 1/2 NW 1/4
LOT 1
D-205, D-206, D-207, D-193
APPROX. LOCATION
00+82
26+00
N87°19'53"W 1178.75'
NEW R/W
Toe of Slope
Cut Line Z
EXIST. R/W
N86°52'56"E 93.70'
NEW IRR. DITCH (BY OTHERS)
EXIST. CONC. LINED IRR. DITCH (TO BE RELOCATED)
SEC. LINE
00+00
3790, 3795, 3800, 3805, 3810, 3815
New 43"X27" C.M.P. Arch
New 5 Wire Fence
P.O.T. ℄ STA. 3805+36.36 = ALSDORF RD. STA. 15+00
SECTION TIE
1690.94' TO SE COR SEC 1
3669.11' TO SW COR SEC 1
150' Lt. Sta. 3805+78.13
150' Lt. Sta. 3808+79.99
4299.57' TO E-W 1/4 SEC. LINE
1574.96' TO W. R/W LINE 11 MILE RD.
NEW R/W
Toe of Slope Z
W.B. CONST. ℄ Z
SURVEY ℄ Z
E.B. CONST. ℄ Z
MATCH LINE
P.O.T. 3792+85
NEW 24"X39" CONC. IRR. PIPE W/RUBBER SEALED JOINTS (SK. 39° LT.)
S 53° 41' 00" E
NEW 24"X30" CONC. IRR. PIPE W/RUBBER SEALED JOINTS (SK. 54° RT.)
P.O.T. 3803+50
NEW 10'X3' CONC. BOX CULV.
ABANDON EXIST. IRR. DITCH WITHIN NEW R/W
4030.66' TO E. R/W LINE COUNTY RD.
150', 300', 54', 75'
℄ NEW 26' B.S.T. FRONTAGE RD. (2 WAY) "F-1"
S 53° 41' 00" E 2032.55'
190.01'
N 71° 52' 08" W
225' Rt. Sta. 3805+83.80
150' Rt. Sta. 12+24.25 (℄ Alsdorf Road)
SW 1/4, S 1/2 NW 1/4, NW 1/4, NE 1/4
D-206, D-205, D-193
APPROX. LOCATION
New 43"X27" C.M.P. Arch
New 5 Wire Fence
APPROX. 1/4 SEC. LINE
EXIST. CONC. LINED IRR. DITCH
NEW IRRIG. DITCH (BY OTHERS)
℄ ALSDORF RD.
EXIST. R/W
N89°56'43"E 2135.78' TO ALSDORF RD. STA. 0+00
2136.57' TO STA. 0+00
N89°56'43"E
2800.00'
NEW 10'X2' DITCH
℄ NEW 26' B.S.T. FRONTAGE RD. (2 WAY)
N89°56'43"E 964.25'
N87°46'28"E 1135.18'
NEW R/W
Toe of Slope
Toe of Slope Z
1/4 COR. NOT FOUND
NEW 10'X3' CONC. BOX CULV.
N65°49'37"W 285.11'
150' Rt. Sta. 2+60 (℄ Alsdorf Road)
SEC. COR. FOUND 1/2" IRON PIN
N0°31'30"E 5302.35' TO SEC COR
2488.64' TO NEW R/W
COUNTY RD. SEC. LINE
EXIST. R/W
N0°24'51"E 5280' TO SEC COR
N0°24'51"E 2640.38' TO NEW R/W
00+00
00+00

Click here for I-10 Index

REDUCED SIZE
DO NOT SCALE

Click here for I-10 Index

CASA GRANDE-TUCSON HWY.
ARIZOLA - TOLTEC SECTION
PINAL COUNTY

REVISIONS			
C.O. No.	DATE	BY	DESCRIPTION
2611	11-11-[illegible]	[illegible]	Finaling Ex. Change - [illegible]

MARUM & MARUM CONSULTING ENGINEERS
232 E. SIXTH ST. TUCSON, ARIZONA
DESIGNED E.F.M. | TRACED MEEKS | DATE 12-11-61 | 1973
DRAWN | CHECKED [illegible] | REVISED 1-3-62, 2-28-62

PROJECT NO.	I-10-4(37)200
DRAWING NO.	D-11-T-376
SHEET NO.	13 of 13
DRAWN BY	RWJ
DATE	3-15-62
SCALE	1" = 100'

FINALIZED

Edmund F. Marum

CENTRAL FILES DATA
LOCATION BOOKS
LAND DESCRIPTIONS
R/W PLANS
MISC. REF.

T-8S R-8E NE 1/4-NW 1/4

N

SE 1/4-NW 1/4

APPROX 1/16 LINE

LOT LINE

LOT 1

LOT 2

LOT 3

LOT 4

END I-10-4(37)200 R/W

BEG. I-10-4(38)205 R/W
See Map No. D-11-T-390

CALC. N89°43'33"W 2644.79' TO 1/4 SEC. LINE

CALC. 5323.55' N89°43'33"W SEC. COR. TO SEC. COR.

CALC. 2639.92' TO 1/4 SEC. LINE

EXIST. R/W

EXIST R/W

SEC. COR. FOUND 3/4" IRON PIN

5280.48' (CALC.) TO 1/4 SEC. LINE

2601.04', (CALC.) N0°20'30"W

536.06' N89°56'43"E SEC. COR TO SEC. COR.

ALSDORF ROAD

357.77' EXIST. R/W

357.14'

ALSDORF RD STA 28+00.37

NE 1/4

D 193

429.07'

30.92

229'

560'

POT. 3826+00.31
SEC. TIE - 1224.31' TO NE COR. SEC. 12
SEC. TIE - 4022.31' TO SE COR. SEC. 12

POT 3826+38.70
EXIST. 6 WIRE POWER &
2 WIRE TEL. LINE - 2 - X ARMS,
TEL. CLEARANCE 20.5', POWER 27.5'

N1°8'20"E 984.26'

11 MILE ROAD

SEC. LINE

3820 3825 3830 3835 3840 3845

229'

12.28'

New 5 Wire Fence

1574.96

3263.63' TO 1/4 SEC. LINE

Toe of Slope

569.40'

82.99'

W.B. CONST. ℄

SURVEY ℄

S 53°41'00"E

E.B. CONST. ℄

300

150'

54'

54'

MATCH LINE

NEW 36" PIPE CULV.

POT. 3825+63
EXIST. 4-WIRE POWER-LINE
CLEARANCE 21.0'

New 5 Wire Fence

3268.76' TO N-S 1/4 SEC. LINE

NEW 26' B.S.T. FRONTAGE RD. (TWO-WAY)

NEW R/W

2032.55'

S 53°41'00"E

88.71'

N26°11'21"W

NEW 43"X27" C.M.P.

225' Rt. Sta 3826+16.35

265.95' Rt. Sta 3826+95.04

N88°41'40"W 42.0'

1/4 COR. NOT FOUND

3782.38'

3782.38'

180.75'

275'

100'

275'

℄ MILLIGAN ROAD

N89°51'06"W 2732.24" (CALC.)

2423.19' (CALC.) TO 1/4 SEC. LINE

EXIST. R/W

SEC. COR. TO S 1/4 COR. SEC. 7

SEC. COR. FOUND 1" IRON PIN

360°13'

100'

SE 1/4 NW 1/4

APPROX. 1/16 LINE

NE 1/4 SW 1/4

LOT 2

LOT LINE

LOT 3

NE 1/4

D 193

APPROX 1/4 SEC. LINE

SE 1/4

D 193

EXIST. R/W

12 7 13 18

REDUCED SIZE
DO NOT SCALE