Click here for I 17 Index

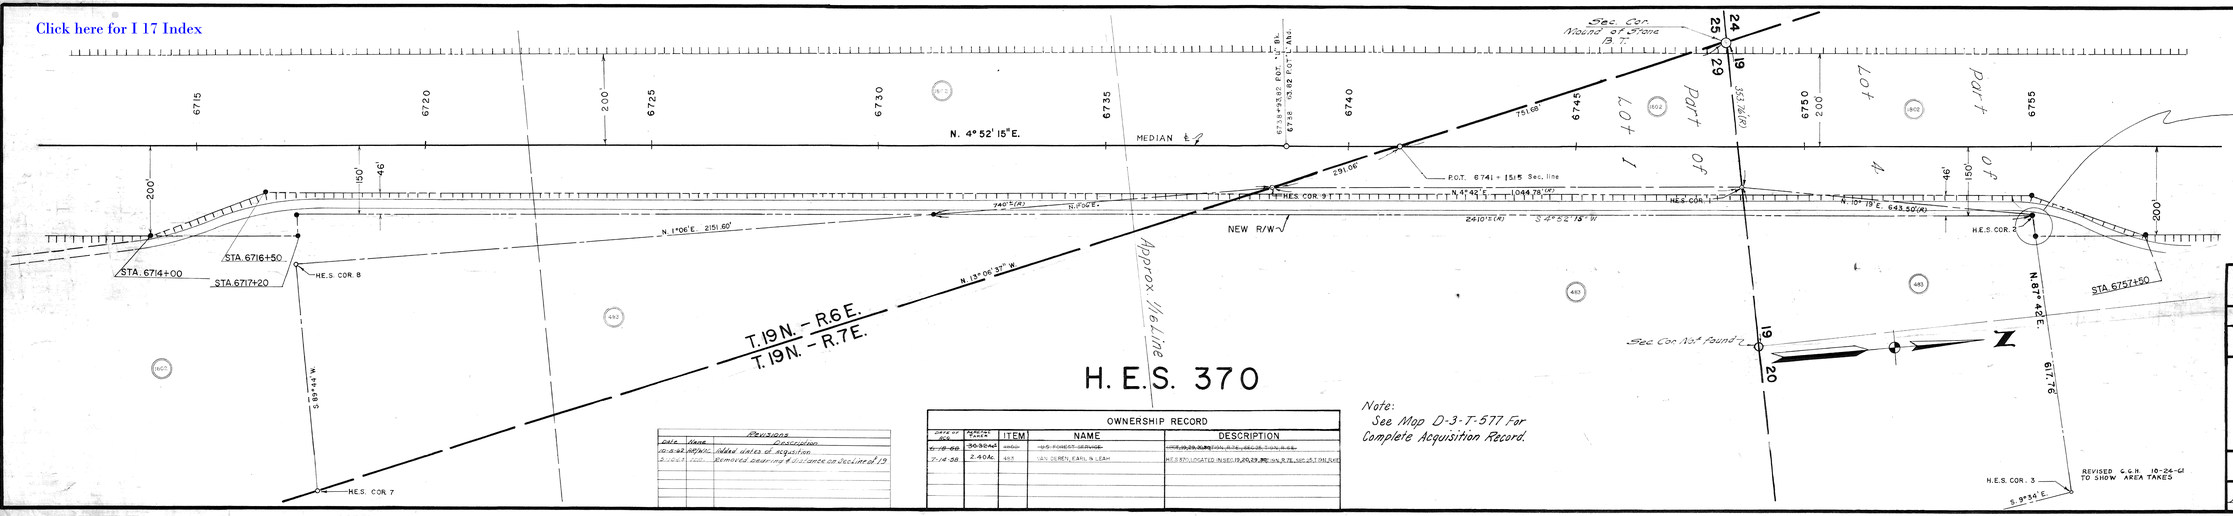

Note:
See Map D-3-T-577 For Complete Acquisition Record.

Revisions		
Date	Name	Description
10-24-61	RFW/WL	Added dates of acquisition
3-20-61	[illegible]	Removed bearing & distance on decline of 19

OWNERSHIP RECORD				
Date of Rec.	Parcel Number	ITEM	NAME	DESCRIPTION

Abutter's rights, including access rights to be acquired
Date: _____ Ass't. Deputy State Engineer.

Access rights required shown thus: ||||||||||||||||||||

ARIZONA HIGHWAY DEPARTMENT

RIGHT OF WAY DIVISION

RIGHT OF WAY MAP
CORDES JCT.-FLAGSTAFF HWY.
FROM STA. 6715 TO STA. 6755
PROJ. IN 003-3 (7)
COCONINO COUNTY

ALIGNMENT AND RIGHT OF WAY APPROVED IN ACCORDANCE WITH RESOLUTIONS DATED Nov. 16, 1956 MINUTES OF ARIZONA HIGHWAY COMMISSION.

REVISED G.G.H. 10-24-61 TO SHOW AREA TAKES

DRAWN BY:	DATE:	SCALE:	FILE NO.
R. D. Wilcox	NOV. 26, 1956	1" = 100'	A 3-T-309-A