C-7-T-622

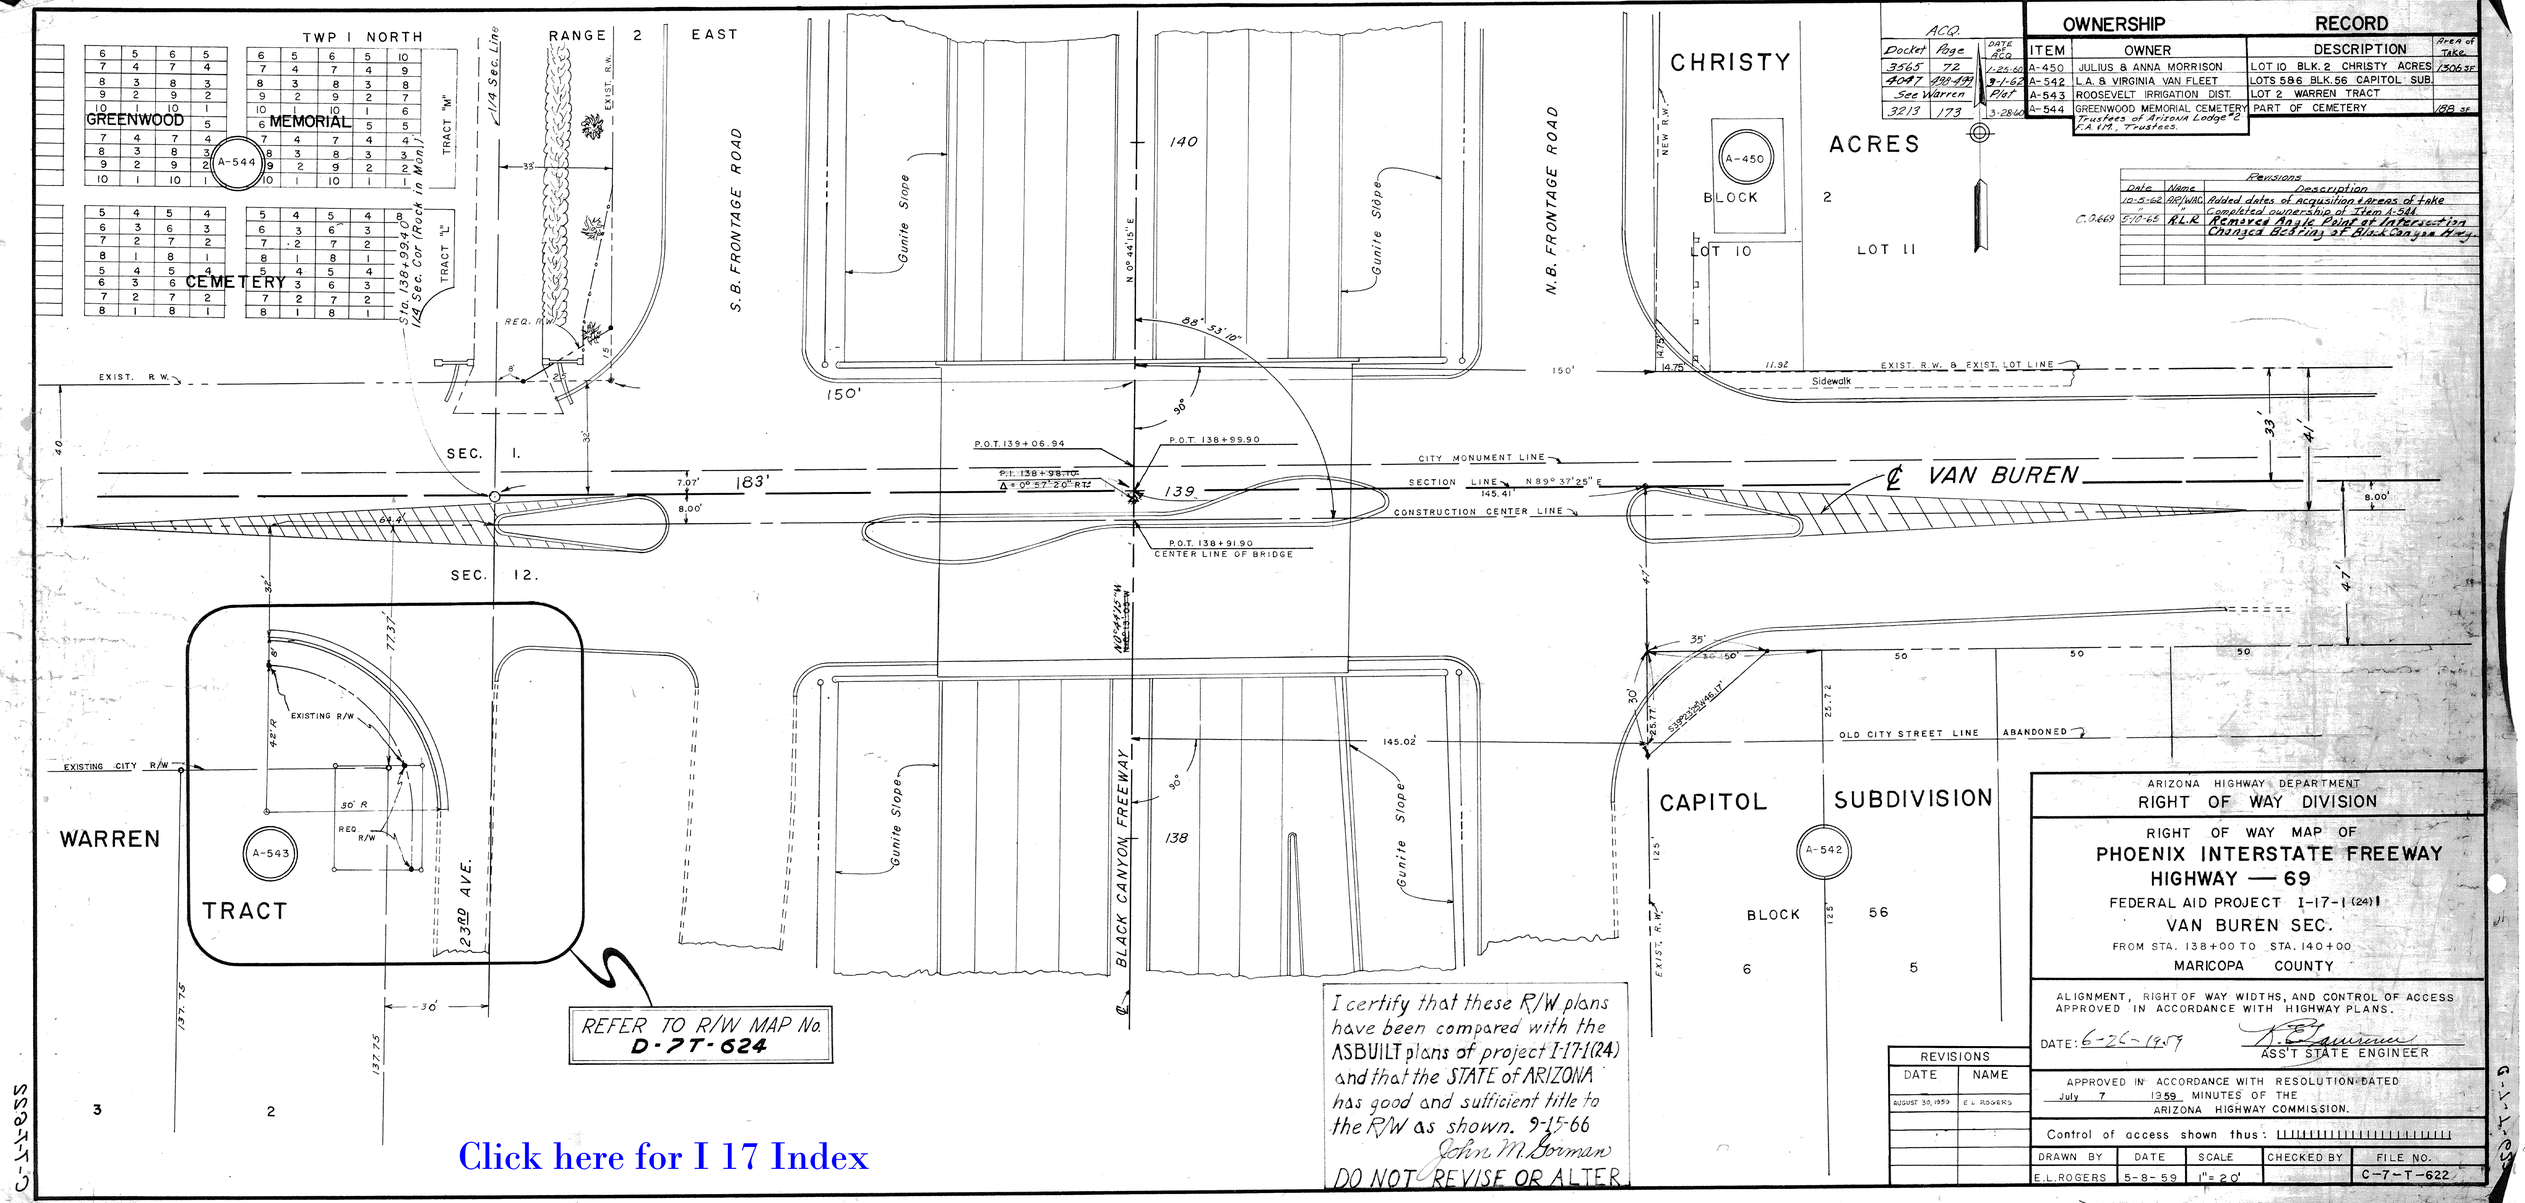

ACQ. Docket	ACQ. Page	DATE OF ACQ.	ITEM	OWNER	DESCRIPTION	Area of Take
3565	72	1-25-62	A-450	JULIUS & ANNA MORRISON	LOT 10 BLK. 2 CHRISTY ACRES	1506 SF
4047	498-499	9-1-62	A-542	L.A. & VIRGINIA VAN FLEET	LOTS 586 BLK. 56 CAPITOL SUB.	
See Warren		Plat	A-543	ROOSEVELT IRRIGATION DIST.	LOT 2 WARREN TRACT	
3213	173	3-28-60	A-544	GREENWOOD MEMORIAL CEMETERY Trustees of Arizona Lodge #2 F.A.M., Trustees.	PART OF CEMETERY	188 SF

OWNERSHIP RECORD

Revisions		
Date	Name	Description
10-5-62	AR/WAC	Added dates of acquisition & areas of take
"	"	Completed ownership of Item A-544
C.O.669 5-10-65	R.L.R	Removed Angle Point of Intersection
		Changed Bearing of Black Canyon Hwy

I certify that these R/W plans have been compared with the ASBUILT plans of project I-17-1(24) and that the STATE of ARIZONA has good and sufficient title to the R/W as shown. 9-15-66
John M. Borman
DO NOT REVISE OR ALTER

REVISIONS DATE	NAME
AUGUST 30, 1959	E.L. ROGERS

ARIZONA HIGHWAY DEPARTMENT
RIGHT OF WAY DIVISION

RIGHT OF WAY MAP OF
PHOENIX INTERSTATE FREEWAY
HIGHWAY — 69
FEDERAL AID PROJECT I-17-1(24)1
VAN BUREN SEC.
FROM STA. 138+00 TO STA. 140+00
MARICOPA COUNTY

ALIGNMENT, RIGHT OF WAY WIDTHS, AND CONTROL OF ACCESS APPROVED IN ACCORDANCE WITH HIGHWAY PLANS.

DATE: 6-26-1959 ASS'T STATE ENGINEER

APPROVED IN ACCORDANCE WITH RESOLUTION DATED July 7 1959 MINUTES OF THE ARIZONA HIGHWAY COMMISSION.

Control of access shown thus: |||||||||||||||||||||||||

DRAWN BY	DATE	SCALE	CHECKED BY	FILE NO.
E.L. ROGERS	5-8-59	1" = 20'		C-7-T-622

Click here for I 17 Index

C-7-T-622