F.H.W.A. REGION	STATE	PROJECT NO.	SHEET NO.	TOTAL SHEETS	FINALIZED PLANS
9	ARIZ.	I-17-1-822	1	9	

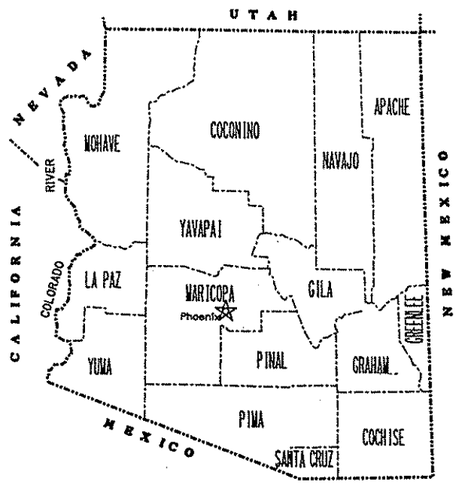

STATE OF ARIZONA
DEPARTMENT OF TRANSPORTATION
HIGHWAYS DIVISION

RIGHT OF WAY PLAN OF THE
PHOENIX - CORDES JUNCTION
GLENDALE AVENUE T.I.
17 MA 205 H4619 02R
I-17-1-822

LENGTH OF PROJECT 0.27 DISTRICT E

Click here for I 17 Index

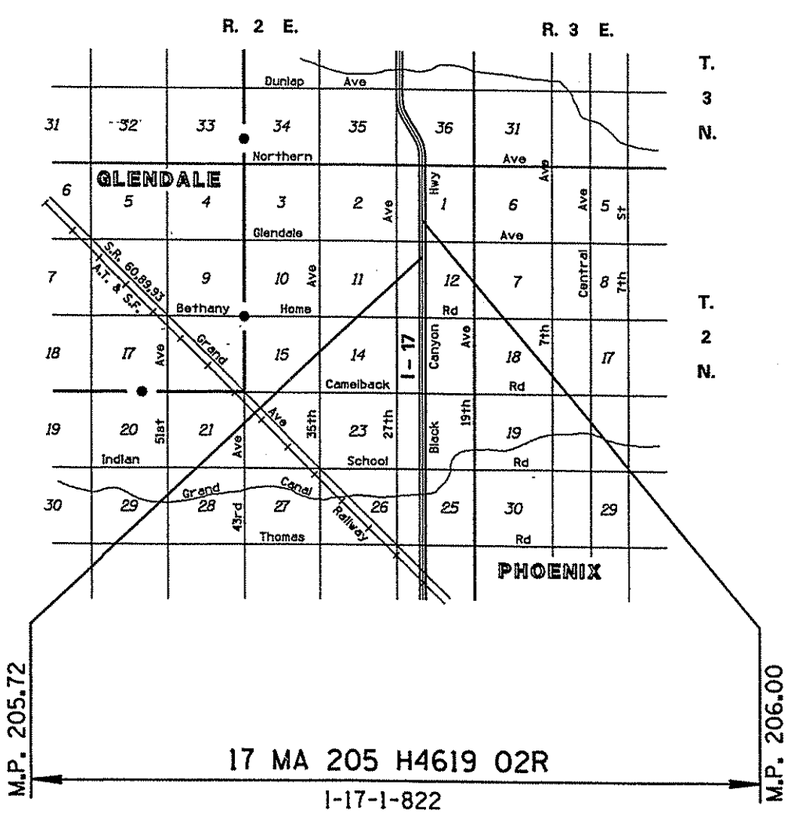

ARIZONA DEPARTMENT OF TRANSPORTATION BOARD
APPROVED FOR RIGHT OF WAY ACQUISITION IN ACCORDANCE WITH RESOLUTION 98-03-A-007 DATED 3-20-98
THOMAS E. SCHMITT P.E. STATE ENGINEER

APPROVED IN ACCORDANCE WITH ROADWAY PLANS
DATE

CHIEF R/W AGENT

U. S. DEPARTMENT OF TRANSPORTATION
FEDERAL HIGHWAY ADMINISTRATION

APPROVED DATE

DIVISION ADMINISTRATOR

DRAWING NO. D-7-T-893
SHEET NO. 1 OF 9

PUBLIC HEARING REQUIREMENTS CERTIFIED 7-7-97
ENVIRONMENTAL CLEARANCE 10-23-97
C & S REVIEW
BID SET REVIEW

OWNERSHIP RECORD — ACQUISITION RECORD

PARCEL NUMBER	OWNER	DESCRIPTION	TOTAL AREA	AREA REQUIRED: GROSS INCLUDING EXISTING R/W	AREA REQUIRED: NET EXCLUDING EXISTING R/W	NEW EASEMENTS	EXISTING EASEMENTS	REMAINDER: LEFT	REMAINDER: RIGHT	SHEET NO.	CHIEF R/W AGENT APPROVAL	INSTRUMENT: TYPE	INSTRUMENT: DATE	RECORDED: DATE	RECORDED: DOCUMENT
7-8201	JOE H. SONG, ET AL	PT. LOT 1, BLK 2, HOMEHEARTH ADDITION	10338Φ		237Φ				10101Φ	6					
7-8202	MERCANTILE INVESTMENT, INC.	PT. LOT 2, BLK 2, HOMEHEARTH ADDITION	29216Φ		572Φ				28644Φ	6					
① 7-8203	CORRAL RESTAURANTS, INC.	PT. LOT 1, HOME HAVEN ADDITION	46156Φ		~~1915Φ~~ 46156Φ				~~44241Φ~~ 0Φ	6					
7-8218	JOE E. SONG, ET AL.	PT. LOT 1, HOMESTEAD TRACT & PT. E2, W2, NE4, NW4, SEC 12, T. 2N., R. 2 E.	14248Φ		1608Φ				12640Φ	5&6					
7-8221	WELLS FARGO BANK	PT. LOTS 2 THRU 5, BLK 1, KRALL'S HOMESITES	33283Φ	2157Φ	469Φ				31126Φ	4&5					
7-8223	SAMIR AJAMI	PT. LOT 17, WEST HAVEN	13408Φ		1402Φ			12006Φ		6					
7-8224	ANITA H. BIEDERMANN, TRUSTEE	LOT 15 & PT. LOT 16, WEST HAVEN	~~13774Φ~~ 23937Φ		604Φ			~~13170Φ~~ 23333Φ		6					
7-8226	JOE H. SONG, ET AL	PT. LOTS 76 THRU 81, & LOTS 113 & 114, ARROWHEAD HOMES AMENDED	~~57832Φ~~ 68072Φ		5257Φ			~~52575Φ~~ 62815Φ		5&6					
7-8227	ARNOLD H. ROVEY, TRUSTEE	PT. TRACT 2, GLEN MANOR	39073Φ	4838Φ	629Φ			34235Φ		4&5					
7-8228	VAN B. BRINTON, JR. & RUTH F. BRINTON, CO-TRUSTEES	PT. TRACT 1, GLEN MANOR	24628Φ		2433Φ			22195Φ		4					
7-8229	JOE H. SONG, ET UX	PT. LOT 35, GLENWOOD TERRACE	17178Φ		728Φ			16450Φ		4					
7-8230	JOHN F. LONG	PT. S2, S2, SW4, SEC 1, T. 2 N., R. 2 E.	200164Φ		5491Φ			194673Φ		4					

① TO BE AQUIRED BY TOTAL AQUISITION.

Click here for I 17 Index

REVISIONS			
C.O. NO.	DATE	BY	DESCRIPTION
9236	6-2-98	DMJM	REV. AREA PAR. 7-8228
9243	7-13-98	CJK	REV. TOTAL & REM. AREAS FOR
"	"	"	PARCELS 7-8224 & 7-8226

DRAWING NO.	D-7-T-893
HARD COPY	
DRAWN/DATE	JFS 2/98
CHECKED	RCO 3/98

DMJM ARIZONA, INC. 2777 E. CAMELBACK RD. SUITE 300 PHOENIX, AZ. 85016-4302 (602) 337-2777

ARIZONA DEPARTMENT OF TRANSPORTATION
INTERMODAL TRANSPORTATION DIVISION
RIGHT OF WAY PLANS SECTION

HIGHWAY	PHOENIX - CORDES JUNCTION
PROJECT NO.	I-17-1-822
TRACS NO.	017 MA 205 H4619 02R
ROUTE	I-17
SECTION	GLENDALE AVENUE T.I.

25-NOV-1998 14:35 s:\usr3\rw20\17rw205.o01

INDEX TO EXISTING R/W

IND.	SUBDIVISION	SEC.	TWP.	R.	ACQ. FROM	TYPE	BK./DKT.	PAGE	WIDTH	YEAR	PARCEL NO.
1	VARIOUS LT'S,HMSTD.TR.	12	2N	2E	PHX. TTL. & TR. CO.	S.W.D.	556	231	VARIES	1946	5175
2	LT. 17, BK.1, KRALL'S H.	"	"	"	BERNHARDT F. MISCHKE	W.D.	566	7	"	1950	5184
3	LT. 16, BK.1, KRALL'S H.	"	"	"	VIRGINIA M. ANDREA	W.D.	583	478	"	1950	5188
4	LT. 15, BK.1, KRALL'S H.	"	"	"	NORMAN A. GARTON	" "	304	368	"	1948	5182
5	LTS.13&14,BK.1,KRALL'SH.	"	"	"	EVERETT F. THOMPSON	" "	430	13	"	1949	5183
6	LT. 12, BK.1, KRALL'S H.	"	"	"	MABEL B. WILLAUER	"	566	70	"	1950	5185
7	LTS.10&11,BK.1,KRALL'SH.	"	"	"	NEWT O. GOSSETT	"	229	523	"	1948	5181

Click here for I 17 Index

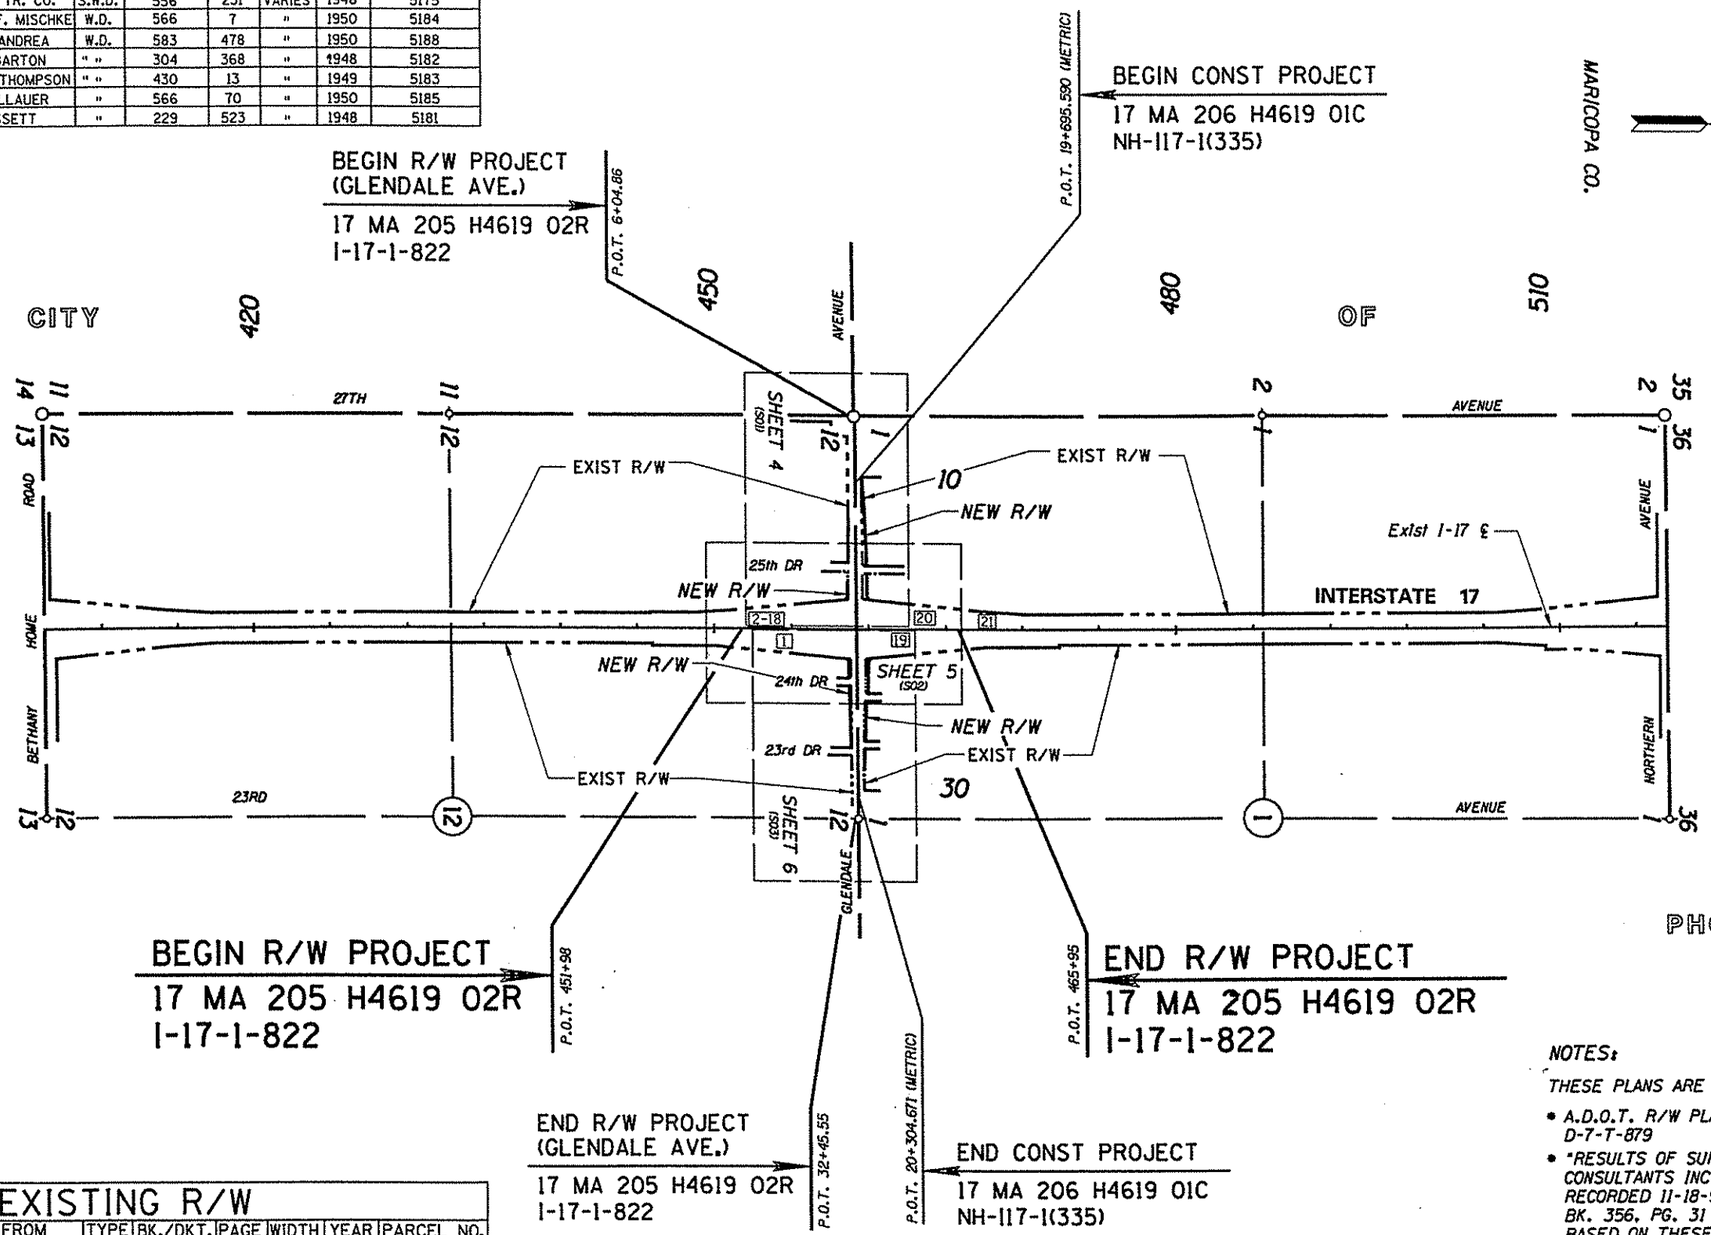

INDEX TO EXISTING R/W

IND.	SUBDIVISION	SEC.	TWP.	R.	ACQ. FROM	TYPE	BK./DKT.	PAGE	WIDTH	YEAR	PARCEL NO.
8	LT. 9, BK.1, KRALL'S H.	13	2N	2E	HAROLD H. BROWN	W.D.	181	397	"	1948	5186
9	LT. 18, BK.1, KRALL'S H.	"	"	"	GEORGE O. McVEY	"	2638	558	"	1958	1845
10	LT. 17, BK.1, KRALL'S H.	"	"	"	BERNHARDT F. MISCHKE	"	2611	536	"	"	1848
11	LT. 16, BK.1, KRALL'S H.	13	"	"	EDWARD SHEPARD	"	2571	109	"	"	1849
12	LT. 15, BK.1, KRALL'S H.	12	"	"	NORMAN A. GARTON	"	2611	535	"	"	1850
13	LT. 8, BK.1, KRALL'S H.	"	"	"	ALBERT ROBINSON	"	407	143	"	1949	5187
14	LT. 7, BK.1, KRALL'S H.	"	"	"	DONALD S. HOPWOOD	"	563	287	"	1946	5177
15	LT. 6, BK.1, KRALL'S H.	"	"	"	HERBERT G. SWANSON	"	575	595	"	1947	5180
16	LT. 5, BK.1, KRALL'S H.	"	"	"	FRED C. CALHOUN	"	404	572	"	1949	5179
17	LT. 1, BK.1, KRALL'S H.	"	"	"	LESLIE J. HOPWOOD	"	556	235	"	1946	5176
18	LT. 2, BK.1, KRALL'S H.	"	"	"	"	"	556	233	"	"	5178
19	SE1/4 SW1/4	1	2N	2E	F.C. SMITH	"	96	539	"	1947	5174
20	S1/2 SW1/4	"	"	"	WILLIAM J. RASMUSSEN	"	81	145	"	"	5173
21	" "	"	"	"	ARNOLD H. ROVEY	"	2536	248	"	1958	1851

NOTES:

THESE PLANS ARE BASED ON THE FOLLOWING:

- *A.D.O.T. R/W PLANS: NH-17-1(315), D-7-T-879*
- *"RESULTS OF SURVEY" OF I-17 BY STANLEY CONSULTANTS INC. PREPARED FOR A.D.O.T., RECORDED 11-18-94, DKT. 92-655976 AND BK. 356, PG. 31 (ALL FOUND MONUMENTATION BASED ON THESE PLANS)*

VICINITY MAP

SCALE: 1" = 500'

DRAWING NO.	D-7-T-893	ARIZONA DEPARTMENT OF TRANSPORTATION INTERMODAL TRANSPORTATION DIVISION RIGHT OF WAY PLANS SECTION
HARD COPY		
DRAWN/DATE	JFS 2/98	HIGHWAY: PHOENIX - CORDES JUNCTION
CHECKED	RCO 3/98	PROJECT NO.: I-17-1-822
DMJM ARIZONA, INC.	300 WEST CLARENDON SUITE 400 PHOENIX, AZ. 85013-3499 (602) 264-0217	TRACS NO.: 017 MA 205 H4619 02R
ROUTE: I-17	SECTION: GLENDALE AVENUE T.I.	SHEET 3 OF 9

REGISTERED LAND SURVEYOR 25064 JAMES F. SARGENT ARIZONA, U.S.A.

Click here for I 17 Index

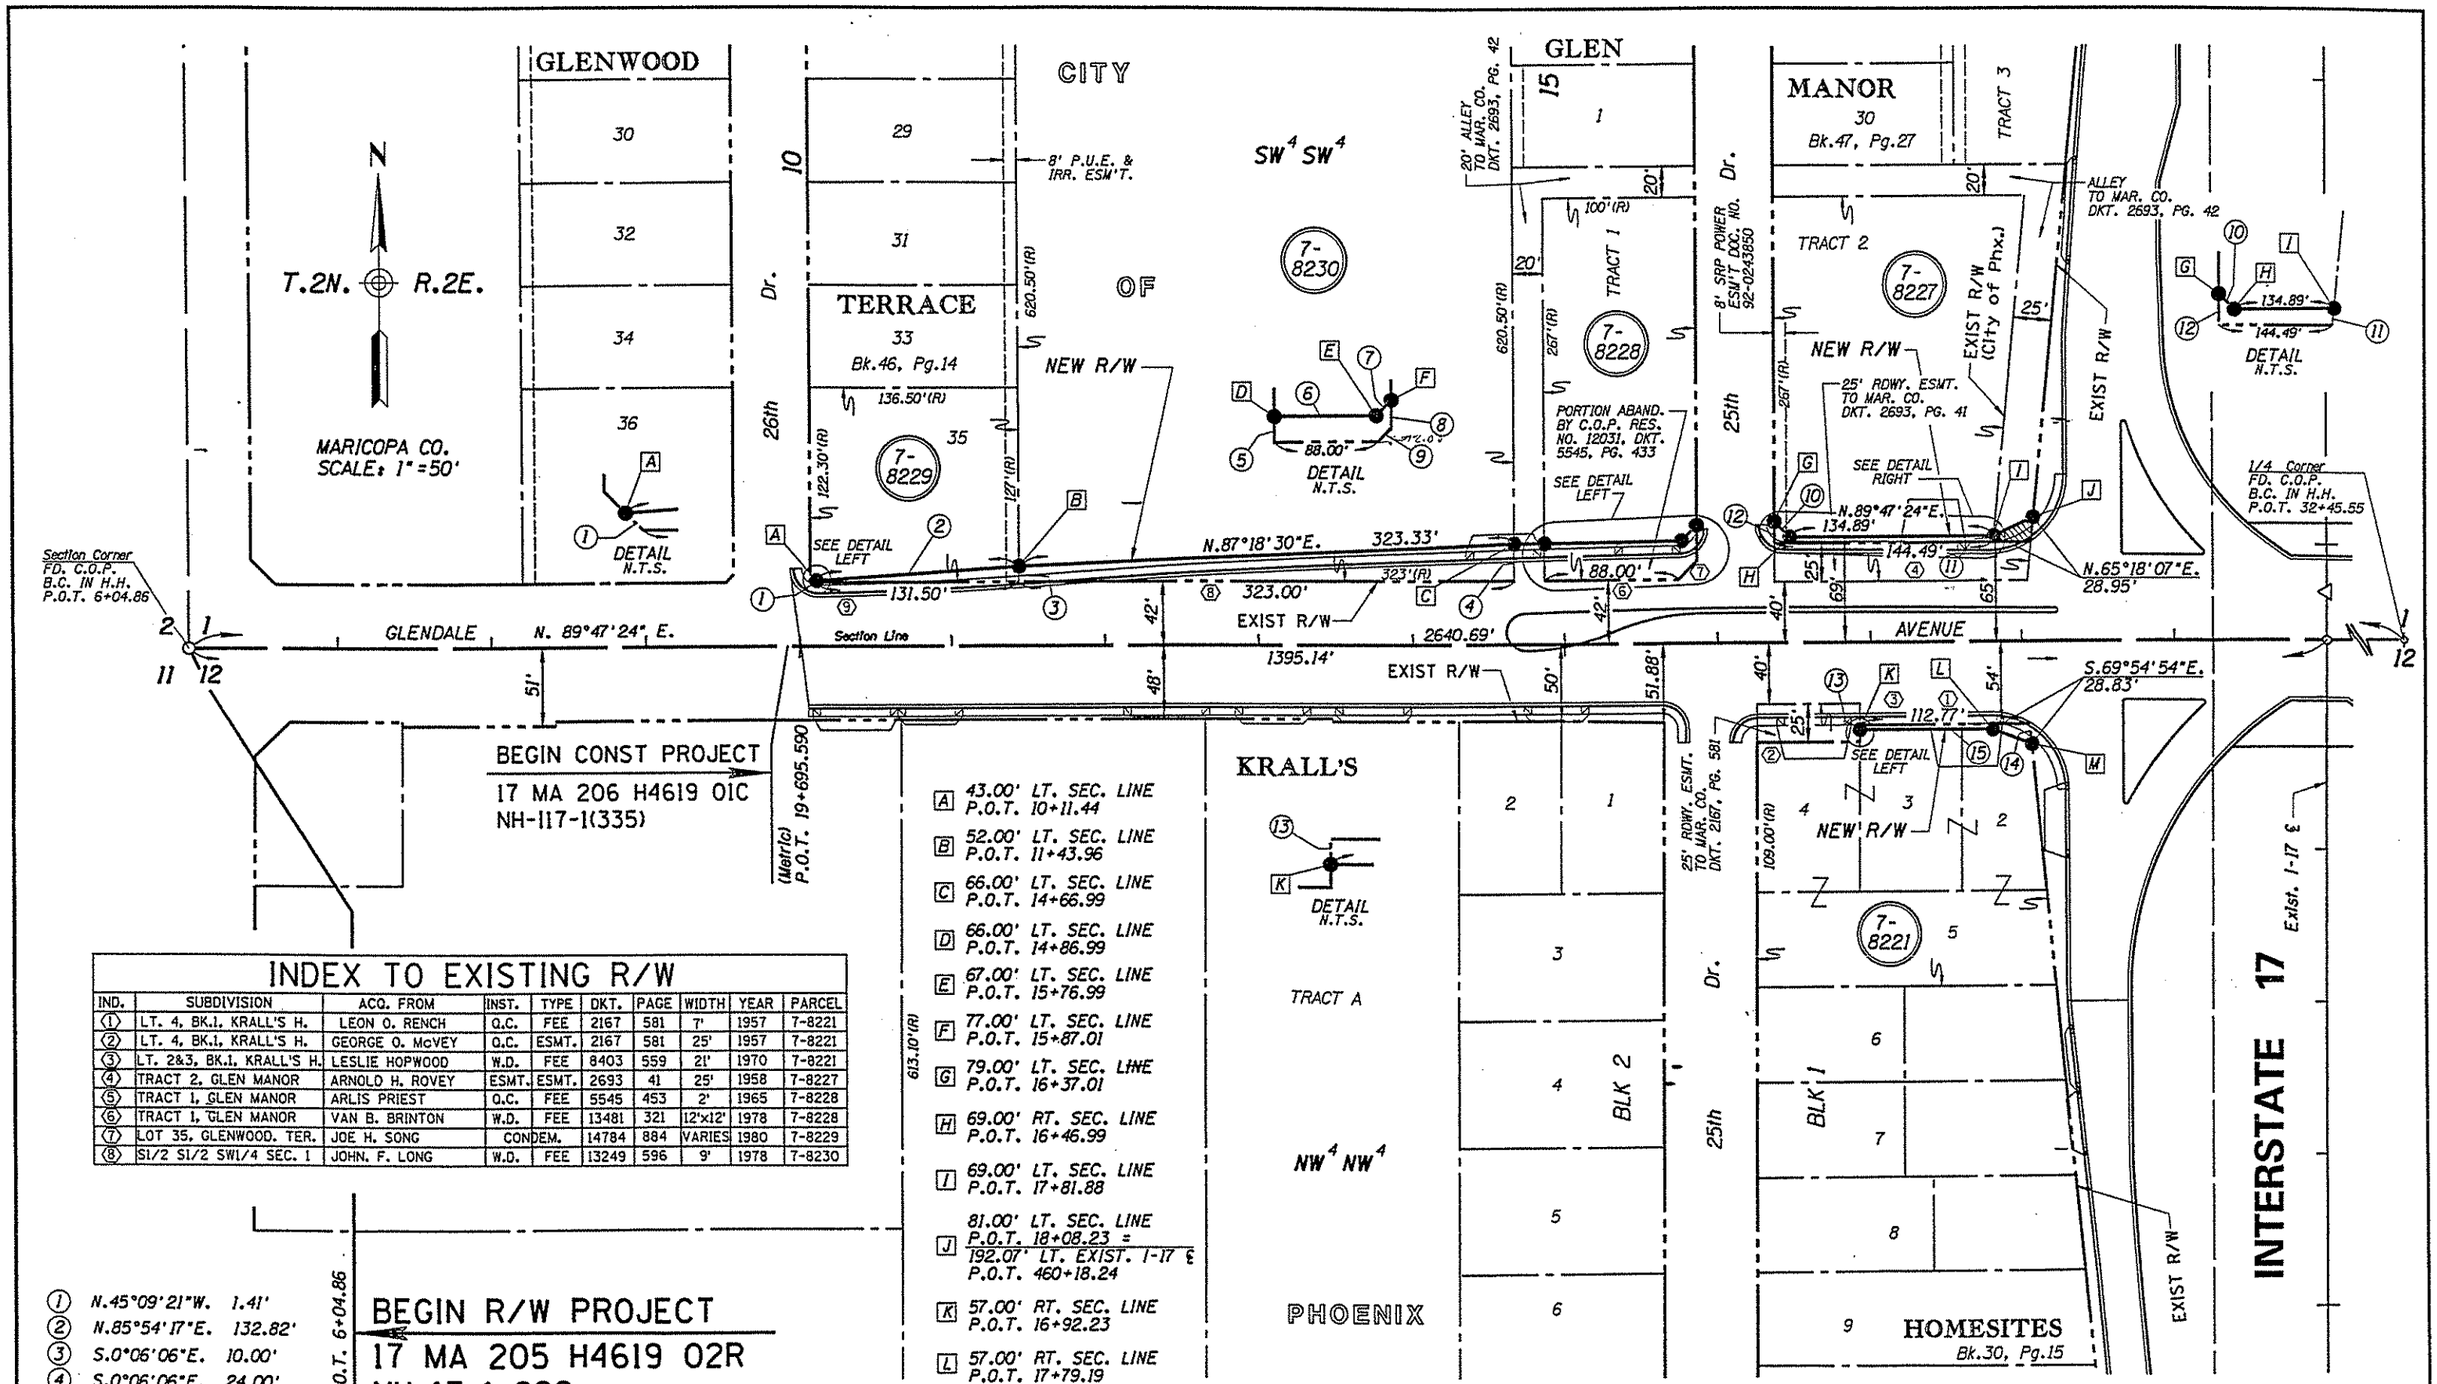

INDEX TO EXISTING R/W									
IND.	SUBDIVISION	ACQ. FROM	INST.	TYPE	DKT.	PAGE	WIDTH	YEAR	PARCEL
①	LT. 4, BK.1, KRALL'S H.	LEON O. RENCH	Q.C.	FEE	2167	581	7'	1957	7-8221
②	LT. 4, BK.1, KRALL'S H.	GEORGE O. McVEY	Q.C.	ESMT.	2167	581	25'	1957	7-8221
③	LT. 2&3, BK.1, KRALL'S H.	LESLIE HOPWOOD	W.D.	FEE	8403	559	21'	1970	7-8221
④	TRACT 2, GLEN MANOR	ARNOLD H. ROVEY	ESMT.	ESMT.	2693	41	25'	1958	7-8227
⑤	TRACT 1, GLEN MANOR	ARLIS PRIEST	Q.C.	FEE	5545	453	2'	1965	7-8228
⑥	TRACT 1, GLEN MANOR	VAN B. BRINTON	W.D.	FEE	13481	321	12'x12'	1978	7-8228
⑦	LOT 35, GLENWOOD TER.	JOE H. SONG	CONDEM.		14784	884	VARIES	1980	7-8229
⑧	S1/2 S1/2 SW1/4 SEC. 1	JOHN. F. LONG	W.D.	FEE	13249	596	9'	1978	7-8230

P.O.T. 6+04.86

BEGIN R/W PROJECT
17 MA 205 H4619 02R
NH-17-1-822

① N.45°09'21"W. 1.41'
② N.85°54'17"E. 132.82'
③ S.0°06'06"E. 10.00'
④ S.0°06'06"E. 24.00'
⑤ N.0°06'06"W. 24.00'
⑥ N.89°09'12"E. 90.01'
⑦ N.44°50'39"E. 14.16'
⑧ S.0°06'06"E. 23.00'
⑨ S.44°50'39"W. 16.99'
⑩ N.45°09'21"W. 14.13'
⑪ N.5°35'06"E. 4.02'
⑫ N.0°06'06"W. 14.00'
⑬ N.0°11'46"E. 3.00'
⑭ N.5°31'00"W. 13.06'
⑮ N.89°47'24"E. 86.96'

Ⓐ 43.00' LT. SEC. LINE P.O.T. 10+11.44
Ⓑ 52.00' LT. SEC. LINE P.O.T. 11+43.96
Ⓒ 66.00' LT. SEC. LINE P.O.T. 14+66.99
Ⓓ 66.00' LT. SEC. LINE P.O.T. 14+86.99
Ⓔ 67.00' LT. SEC. LINE P.O.T. 15+76.99
Ⓕ 77.00' LT. SEC. LINE P.O.T. 15+87.01
Ⓖ 79.00' LT. SEC. LINE P.O.T. 16+37.01
Ⓗ 69.00' RT. SEC. LINE P.O.T. 16+46.99
Ⓘ 69.00' LT. SEC. LINE P.O.T. 17+81.88
Ⓙ 81.00' LT. SEC. LINE P.O.T. 18+08.23 = 192.07' LT. EXIST. I-17 ℄ P.O.T. 460+18.24
Ⓚ 57.00' RT. SEC. LINE P.O.T. 16+92.23
Ⓛ 57.00' RT. SEC. LINE P.O.T. 17+79.19
Ⓜ 67.00' RT. SEC. LINE P.O.T. 18+06.23 = 193.29' LT. EXIST. I-17 ℄ P.O.T. 458+69.10

TO BE ACQUIRED BY RESOLUTION

REVISIONS			
C.O. NO.	DATE	BY	DESCRIPTION
9236	6-2-98	DMJM	REV. EXIST. R/W PAR. 7-8228

DRAWING NO.	D-7-T-893
HARD COPY	
DRAWN/DATE	JFS 2/98
CHECKED	RCO 3/98
DMJM ARIZONA, INC.	2777 E. CAMELBACK RD. SUITE 200 PHOENIX, AZ. 85016-4302 (602) 337-2620
ROUTE	I-17
SECTION	GLENDALE AVENUE T.I.

ARIZONA DEPARTMENT OF TRANSPORTATION
INTERMODAL TRANSPORTATION DIVISION
RIGHT OF WAY PLANS SECTION

HIGHWAY: PHOENIX - CORDES JUNCTION
PROJECT NO.: I-17-1-822
TRACS NO.: 017 MA 205 H4619 02R

REGISTERED LAND SURVEYOR — 28034 — JAMES F. SARGENT — ARIZONA, U.S.A.

SHEET 4 OF 9

Click here for I 17 Index

CITY OF KRALL'S BLK 2

BLK 1

HOMESITES
Bk.30, Pg.15

HOMESTEAD

TRACT
Bk.35, Pg.30

HOME HAVEN

ADDITION
Bk.40, Pg.49

GLEN
Bk.47, Pg.27

MANOR
Bk.47, Pg.27

ARROWHEAD HOMES

AMENDED
Bk.45, Pg.8

PHOENIX

25th Dr.

AVENUE

GLENDALE

24th Dr.

455

465

NW 4 NW 4

SW 4 SW 4

SE 4 SW 4

T.2N. R.2E.

MARICOPA CO.
SCALE: 1"=50'

Section Corner
F.D. C.O.P.
B.C. IN H.H.
P.O.T. 6+04.86

1/4 Corner
F.D. C.O.P.
B.C. IN H.H.
P.O.T. 32+45.55

Section Line

Approx 1/16 Line

EXIST R/W

NEW R/W

SEE DETAIL SHEET 4

SEE DETAIL SHEET 1

TRACT 1

TRACT 2

TRACT 3

PARCEL INSERT NOT TO SCALE

25' RDWY. ESMT. TO MAR. CO. DKT. 2167, PG. 581

25' RDWY. ESMT. TO MAR. CO. DKT. 2693, PG. 41

ALLEY TO MAR. CO. DKT. 2693, PG. 42

5' IRR. ESM'T & P.U.E.

8' ESM'T

TO BE ACQUIRED BY RESOLUTION

7-8228 7-8227 7-8221 7-8218 7-8226

INTERSTATE 17

BEGIN R/W PROJECT
17 MA 205 H4619 02R
I-17-1-822

END R/W PROJECT
17 MA 205 H4619 02R
I-17-1-822

P.O.T. 451+98

P.O.T. 465+85

N. 0°12'06" E.

N. 0°08'04" W.

P.I. 459+69.17
= 0°20'10" LT.

P.O.T. 459+37.49 EXIST. I-17 ℄ =
P.O.T. 20+00+00 SEC. LINE

Exist. I-17 ℄

N. 89°47'24" E.

1395.14'

2640.69'

1245.54'

109'(R)

267'(R)

124.89'(R)

108.91'(R)

134.69'

86.96'

96.55'(R)

192.78'

40'

56'

65'

54'

25'

20'

30 29 28

1 2 3 4 5

76 77 78 79 80 81 82 83

① N.0°11'46"E. 3.00'
② N.89°47'24"E. 112.77'
③ N.45°09'21"W. 14.13'
④ S.0°06'06"E. 14.00'
⑤ N.89°47'24"E. 144.49'
⑥ N.5°35'06"E. 4.02'
⑦ N.89°47'24"E. 89.98'
⑧ S.45°00'32"E. 14.09'
⑨ N.0°11'32"E. 12.00'
⑩ S.45°00'32"E. 14.09'
⑪ N.89°47'24"E. 113.99'
⑫ N.5°28'39"E. 21.10'
⑬ N.5°50'10"W. 30.15'

N.65°18'07"E. 28.95

S.69°54'54"E. 28.83'

S.5°31'00"E. 13.06'

S.70°42'36"W 27.53'

S.66°29'16"E. 29.83'

S.69°19'06"E. 192.78'

Ⓐ 194.36' RT. EXIST. I-17 ℄ P.O.T. 458+77.88 = 61.00' RT. SEC. LINE P.O.T. 21+93.93

Ⓑ 220.31' RT. EXIST. I-17 ℄ P.O.T. 458+87.07

Ⓒ 191.23' RT. EXIST. I-17 ℄ P.O.T. 460+23.74 = 86.00' LT. SEC. LINE P.O.T. 21+91.53

Ⓓ 218.55' RT. EXIST. I-17 ℄ P.O.T. 460+11.78

Ⓔ 193.29' LT. EXIST. I-17 ℄ P.O.T. 458+69.10 = 67.00' RT. SEC. LINE P.O.T. 18+06.23

Ⓕ 220.40' LT. EXIST. I-17 ℄ P.O.T. 458+78.90

Ⓖ 192.07' LT. EXIST. I-17 ℄ P.O.T. 460+18.24 = 81.00' LT. SEC. LINE P.O.T. 18+08.23

Ⓗ 218.40' LT. EXIST. I-17 ℄ P.O.T. 460+06.20

REVISIONS			
C.O. NO.	DATE	BY	DESCRIPTION
9236	6-2-98	DMJM	REV. EXIST. R/W PAR. 7-8228
9243	7-13-98	CJK	REV. LIMITS OF PAR. 7-8226.

DRAWING NO.	0-7-T-893
HARD COPY	
DRAWN /DATE	JFS 2/98
CHECKED	RCO 3/98
DMJM ARIZONA, INC.	2777 E. CAMELBACK RD. SUITE 300 PHOENIX, AZ. 85016-4302 (602) 337-2620
ROUTE	I-17
SECTION	GLENDALE AVENUE T.I.

ARIZONA DEPARTMENT OF TRANSPORTATION
INTERMODAL TRANSPORTATION DIVISION
RIGHT OF WAY PLANS SECTION

HIGHWAY: PHOENIX - CORDES JUNCTION
PROJECT NO.: I-17-1-822
TRACS NO.: 017 MA 205 H4619 02R

Click here for I 17 Index

INTERSTATE 17

ARROWHEAD HOMES — 74, 75, 76, 77, 78, 79, 80, 81, 82, 83 — 7-8226

CITY OF PHOENIX

WEST HOMEHEARTH — 20, 19, 18, 17 — 7-8223

WEST HAVEN — 13, 14, 15, 16, 17, 18, 19, 20 — 7-8224

HAVEN ADDITION Bk.36, Pg.36

AMENDED Bk.45, Pg.8 — 110, 112, 113, 114 — 7-8226

HOMEHEARTH — 1, 2, 3 — 7-8202, 7-8201, 7-8203

HOME D-M-182/L-M-266 — 1, 2, 3

HOMESTEAD TRACT Bk.35, Pg.30 — 1, 2, 3, 4, 5 — 7-8218

HAVEN ADDITION Bk.40, Pg.49 — 3, 4, 5

ADDITION Bk.33, Pg.3 — 8, 9

24th Ave. — 23rd Lane — 23rd Dr. — 24th Dr. — 24th Ave. — 23rd Dr. — 23rd Ave.

GLENDALE AVENUE

EXIST R/W — NEW R/W — 8' ESM'T. — 8' P.U.E. — 20' INGRESS/EGRESS ESM'T DKT 15825 PG 1016 — 5' IRR. ESM'T. & P.U.E.

108.91'(R) — 68'(R) — 60'(R) — 96.55'(R) — 217.10' — 136.50'(R) — 131.55' — 123.05' — 131.50' — 2640.69' — N. 89°47'24" E. — 1245.54' — 113.99' — 55'(R) — 210.04' — 209.90'(R) — S.88°27'34"W. — 205.12' — 117.37' — 117.42' — 70.00' — 65.03' — 88.71'(R) — 158'(R) — 133'(R) — 75'(R) — 65'(R) — 127.08'(R) — 117.35'(R) — 120'(R) — 70.00' — 65.03'

SEE DETAIL RIGHT — DETAIL N.T.S. — SEE DETAIL BELOW — DETAIL N.T.S.

Section Line — 56' — 48.15' — 40.87' — 40'

* NOTE: TO BE ACQUIRED BY TOTAL AQUISITION.

N — T.2N. — R.2E. — MARICOPA CO. SCALE: 1" = 50'

Section Corner FD. C.O.P. B.C. IN H.H. P.O.T. 6+04.86

1/4 Corner FD. C.O.P. B.C. IN H.H. P.O.T. 32+45.55

END CONST PROJECT
17 MA 206 H4619 01C
NH-117-1(335)
P.O.T. 20+304.671 (Metric)

(1) N.5°28'39"E. 21.10'
(2) S.45°00'32"E. 14.09'
(3) S.0°11'32"W. 12.00'
(4) N.45°00'32"W. 14.09'
(5) S.89°47'24"W. 89.98'
(6) S.70°42'36"W. 27.53'
(7) N.0°11'32"E. 16.00'
(8) N.44°59'28"E. 7.10'
(9) S.0°15'28"W. 6.24'
(10) S.44°59'28"W. 14.19'
(11) N.0°16'21"E. 3.51'
(12) S.44°58'07"E. 7.04'
(13) S.0°16'21"W. 7.00'
(14) N.44°58'07"W. 14.08'
(15) S.0°10'03"E. 2.00'
(16) N.45°11'19"W. 7.07'
(17) N.0°10'03"W. 11.00'
(18) S.45°11'19"E. 14.14'
(19) S.88°23'56"E. 126.56'
(20) S.44°48'41"W. 7.07'
(21) S.0°10'03"E. 15.13'
(22) S.44°48'41"W. 14.15'
(23) S.88°34'12"E. 126.55'
(24) S.0°10'03"E. 9.99'
(25) N.45°11'19"W. 7.07'
(26) N.0°10'03"W. 14.85'
(27) S.45°11'19"E. 14.14'
(28) S.88°34'12"E. 118.05'
(29) S.0°10'03"E. 15.00'
(30) S.44°48'41"W. 14.15'
(31) N.5°50'10"W. 30.15'
(32) S66°29'16"E. 29.83'
(33) S89°19'06"E. 192.78'
(34) S.44°48'41"W. 14.15'

INDEX TO EXISTING R/W

IND.	SUBDIVISION	ACQ. FROM	INST.	TYPE	DKT.	PAGE	WIDTH	YEAR	PARCEL
(7)	LT. 1, BK.2, HOMEHRTH.	LEON O. RENCH	O.C.	FEE	2031	33	7'	1957	7-8201
(8)	LT. 2, BK.2, HOMEHRTH.	ANDERSON CONST. CO.	O.C.	FEE	2054	49	7'	1956	7-8202
(9)	LT. 1, HOME HAVEN ADD.	HUBERT C. PHILLIPS	O.C.	FEE	2387	352	7'	1958	7-8203
(10)	LT. 1, HOMESTEAD TR.	JOE H. SONG	O.C.	FEE	1974	596	7'	1956	7-8218
(11)	LT. 17 WEST HAVEN	GASAMAT INC.	W.D.	FEE	14025	1169	TAPER	1978	7-8223
(12)	LT. 17 WEST HAVEN	WILLIAM J. LADYMAN JR.	O.C.	FEE	2043	108	7'	1956	7-8223
(13)	LT. 16 WEST HAVEN	CARL MORRIS	O.C.	FEE	3457	461	7'	1960	7-8224
(14)	LT. 16 WEST HAVEN	KEITH J. MORRIS	W.D.	FEE	13541	469	COR.	1978	7-8224
(15)	LT. 16 WEST HAVEN	DAN R. MORRIS	W.D.	FEE	13541	470	COR.	1978	7-8224
(16)	LT. 16 WEST HAVEN	KEITH & DAN MORRIS	ABD.		13541	443	COR.	1979	7-8224
(17)	LOTS. 78-80, 113, 114.	JOE H. SONG	O.C.	FEE	2031	35	7'	1958	7-8226
	ARROWHEAD HOMES AM.								

END R/W PROJECT
17 MA 205 H4619 02R
NH-17-1-822
P.O.T. 32+45.55

A — 194.36' RT. EXIST. I-17 ℄ P.O.T. 458+77.88 = 61.00' RT. SEC. LINE P.O.T. 21+93.93
B — 52.00' RT. SEC. LINE P.O.T. 22+19.95
C — 52.00' RT. SEC. LINE P.O.T. 23+09.93
D — 62.00' RT. SEC. LINE P.O.T. 23+19.86
E — 61.00' RT. SEC. LINE P.O.T. 23+69.87
F — 51.00' RT. SEC. LINE P.O.T. 23+79.94
G — 42.00' RT. SEC. LINE P.O.T. 27+67.40
H — 52.00' RT. SEC. LINE P.O.T. 27+77.32
I — 42.00' LT. SEC. LINE P.O.T. 29+22.58
J — 46.00' LT. SEC. LINE P.O.T. 27+96.08
K — 56.00' LT. SEC. LINE P.O.T. 27+86.09
L — 61.00' LT. SEC. LINE P.O.T. 27+36.09
M — 51.00' LT. SEC. LINE P.O.T. 27+26.08
N — 58.00' LT. SEC. LINE P.O.T. 24+81.59
O — 68.00' LT. SEC. LINE P.O.T. 24+71.60
P — 81.00' LT. SEC. LINE P.O.T. 24+21.61
Q — 71.00' LT. SEC. LINE P.O.T. 24+11.60
R — 74.00' LT. SEC. LINE P.O.T. 22+18.84
S — 191.23' RT. EXIST. I-17 ℄ P.O.T. 460+23.74 = 86.00' LT. SEC. LINE P.O.T. 21+91.53

REVISIONS			
C.O. NO.	DATE	BY	DESCRIPTION
9243	7-13-98	CJK	REV. PARCEL LIMITS FOR PAR. 7-8224 AND 7-8226.

DRAWING NO.	D-7-T-893
HARD COPY	
DRAWN/DATE	JFS 2/98
CHECKED	RCO 3/98
DMJM ARIZONA, INC.	2777 E. CAMELBACK RD. SUITE 200 PHOENIX, AZ. 85016-4302 (602) 337-2620
ROUTE	I-17
SECTION	GLENDALE AVENUE T.I.

ARIZONA DEPARTMENT OF TRANSPORTATION
INTERMODAL TRANSPORTATION DIVISION
RIGHT OF WAY PLANS SECTION

HIGHWAY	PHOENIX - CORDES JUNCTION
PROJECT NO.	I-17-1-822
TRACS NO.	017 MA 205 H4619 02R

SHEET 6 OF 9

25-NOV-1998 10:26 s:\usr3\rw20\17rw205.s03