ARIZONA HIGHWAY DEPARTMENT
RIGHT OF WAY SECTION

Project I-40-5-701	Highway HOLBROOK-LUPTON	Drawn By W. Shirley	Date 10-18-71
Section DEAD RIVER DRAINAGE EASEMENTS		Checked By J.A. Marin Jr.	Date 11-11-71

REMARKS: Acquisition for Drainage Easements as outlined in E.F. Gentsh's memo to A.L. Chadwick dated 9-14-71 with J.B.Mertz's subsequent approval dated 9-20-71.

ARIZONA HIGHWAY COMMISSION

Approved for acquisition of Parcel 1-172

STATE HIGHWAY ENGINEER

Oran J. Lyon Jr. 12-29-71

for Chief Deputy State Engineer Date

Gross area includes existing R/W
Net area excludes existing R/W

OWNERSHIP RECORD

Parcel	OWNER	DESCRIPTION	TOTAL AREA	GROSS AREA	NET AREA	ESM'T AREA	REMAIN LEFT	REMAIN RIGHT
~~1-172~~	~~Raymond Fitzgerald,etux~~	~~Pt. of sec. 33,T.20N.R.25E.~~	~~640 Ac.~~	DELETED 11-14-72 C.O. 3438				

Revised per C.O. 3438 dated 11/6/72 L.M.F.

NOTE: BEARINGS & DIMENSIONS TAKEN FROM R/W STRIP MAP A-1-T-207 OLD R/W PROJ. NO. I-40-5(6)

AREA TO BE ACQUIRED

SCALE: 1" = 400'

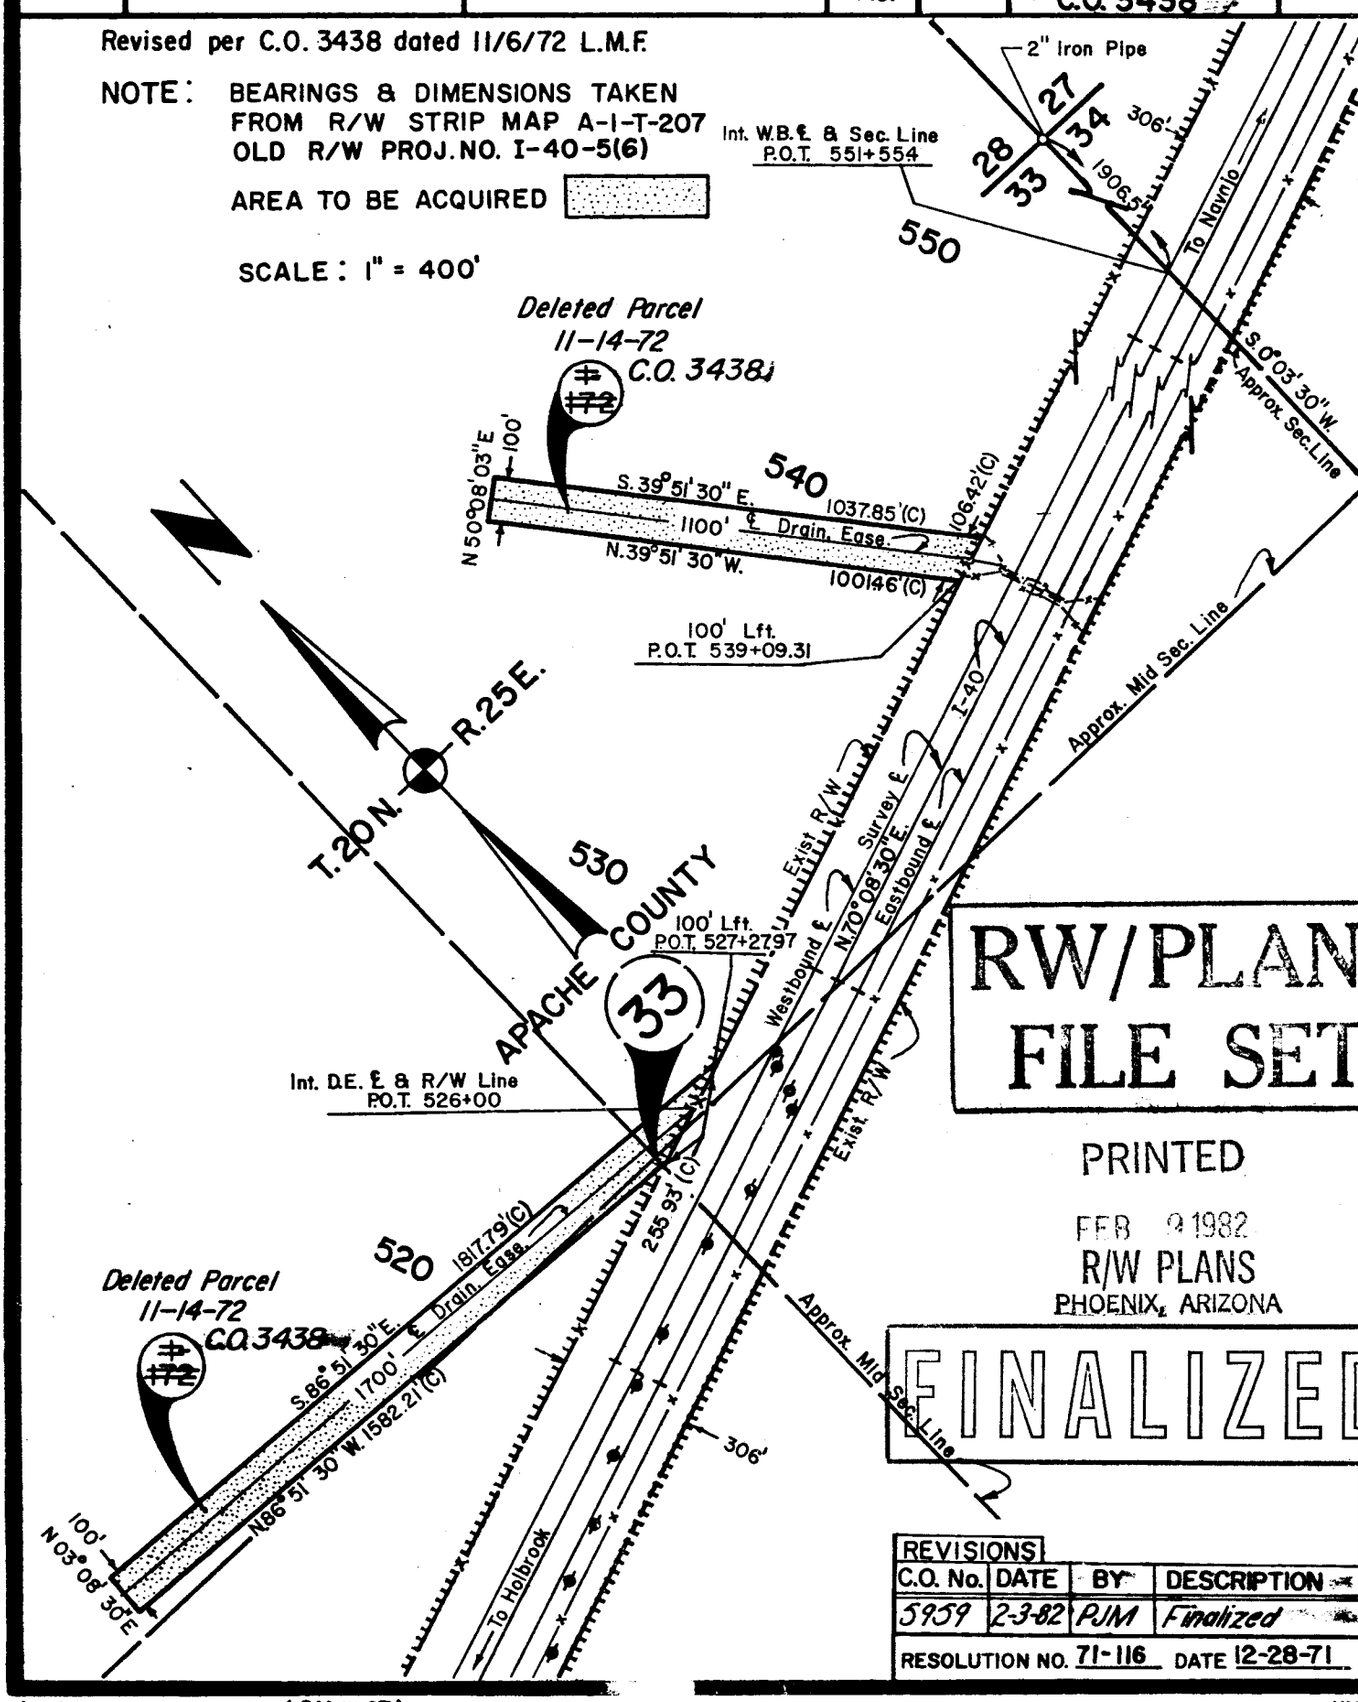

RW/PLANS FILE SET

PRINTED

FEB 9 1982

R/W PLANS
PHOENIX, ARIZONA

FINALIZED

REVISIONS			
C.O. No.	DATE	BY	DESCRIPTION
5959	2-3-82	PJM	Finalized

RESOLUTION NO. 71-116 DATE 12-28-71

A.H.D. 60-431 9-66 (.5M 11-67) J.M.R.

Click here for I 40 Index