FHWA REGION	STATE	PROJECT NUMBER	SHEET NUMBER	TOTAL SHEETS	FINALIZED PLANS
9	ARIZ.	S-456-705	1	11	

DRAWING NUMBER	D-4-T-369

STATE OF ARIZONA
DEPARTMENT OF TRANSPORTATION

HIGHWAYS DIVISION
RIGHT OF WAY PLAN OF THE
ROOSEVELT – PAYSON HWY.
ROCK CREEK - BUMBLEBEE CREEK
S.R. 188
PROJECT NO. S-456-705

GILA COUNTY DISTRICT 2
LENGTH OF PROJECT 3.97 MILES

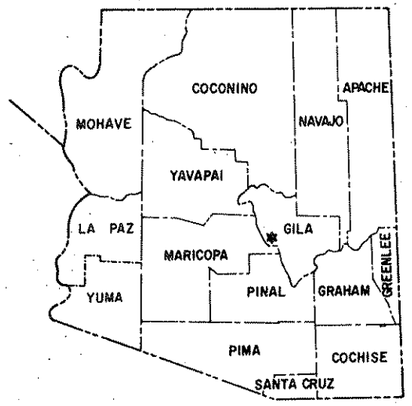

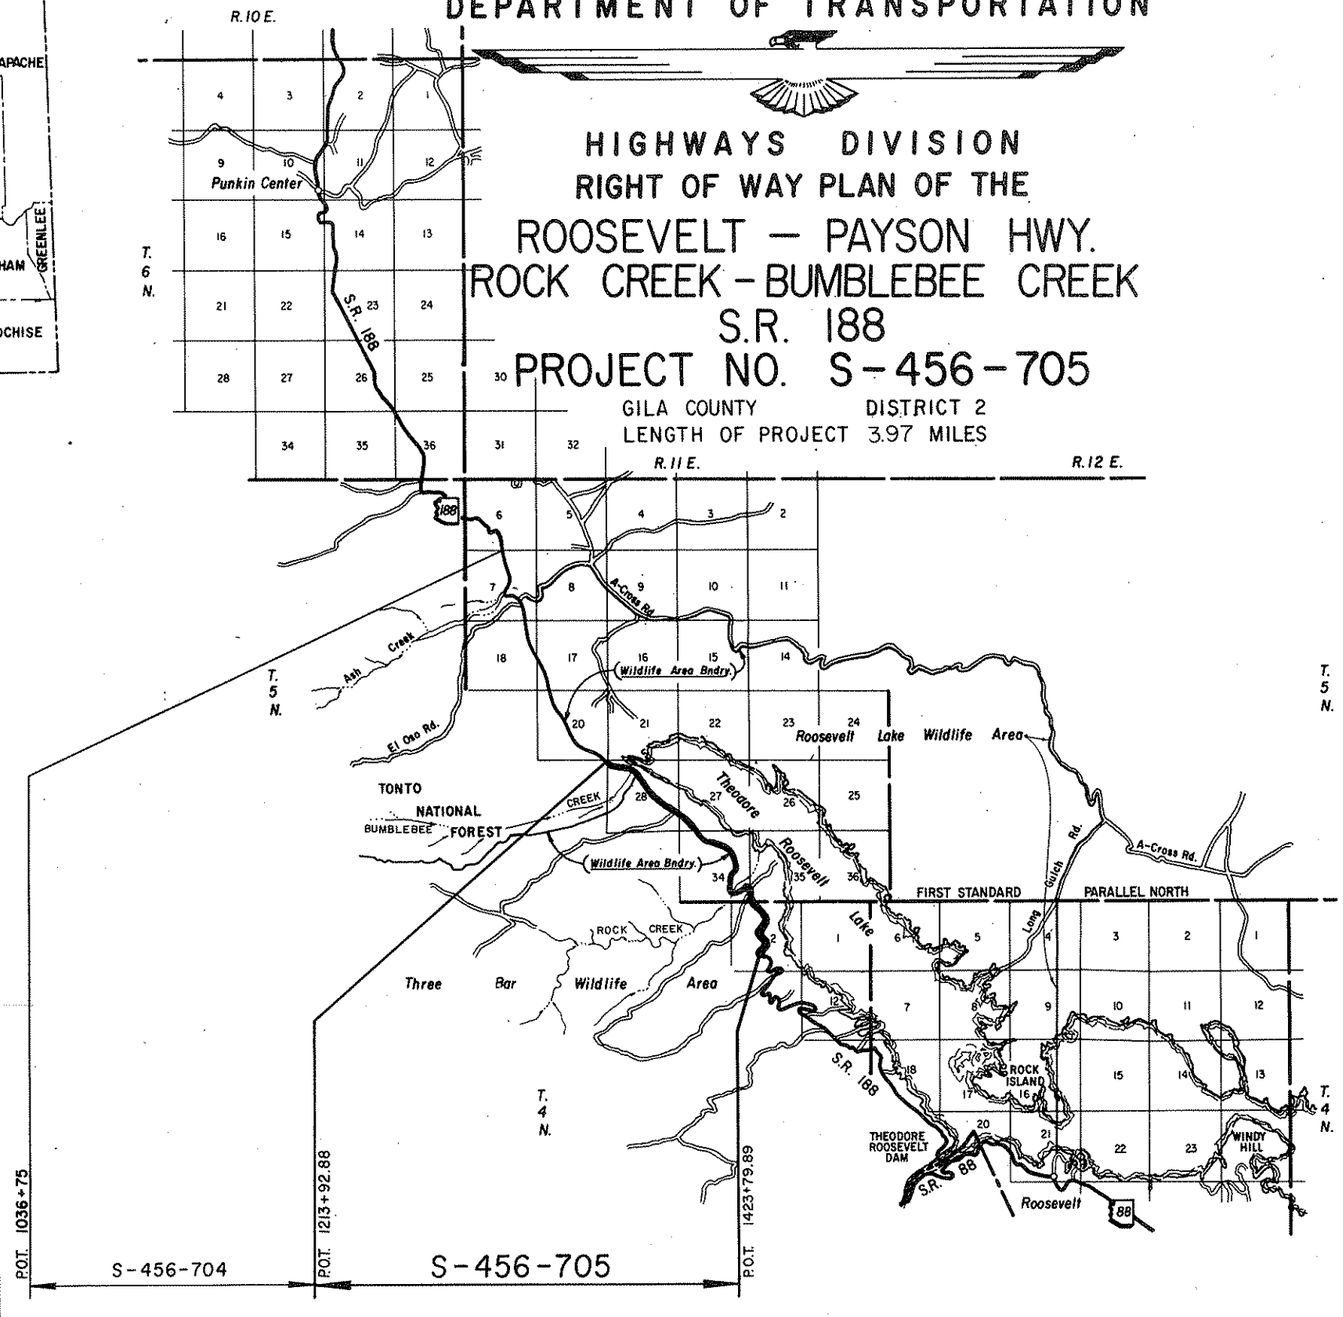

Click here for SR 188 Index

Approved in accordance with Roadway Plans

DEPUTY STATE ENGINEER — DATE 9/2/83

ARIZONA DEPARTMENT OF TRANSPORTATION BOARD
Approved for Right of Way Acquisition in accordance with Resolution Number 83-11-A-39 Dated July 15, 1983

Thomas R. Lammers State Engineer

CHIEF DEPUTY STATE ENGINEER — DATE 9.2.83

U.S. DEPARTMENT OF TRANSPORTATION
FEDERAL HIGHWAY ADMINISTRATION

DIVISION ENGINEER — DATE

Public Hearing Requirements Certified 4-14-77
Environmental Clearance 11-9-81

REDUCED SIZE DO NOT SCALE

ROOSEVELT – PAYSON HWY.
ROCK CREEK – BUMBLEBEE CREEK
GILA COUNTY

Click here for SR 188 Index

REVISIONS				PROJECT NO.	S-456-705
C.O. No.	DATE	BY	DESCRIPTION	DRAWING NO.	D-4-T-369
6566	6/1/84	Leroy	Changed Net Area Par. 4-239, Esmt 240	SHEET NO.	2 of 11
7187	11-18-85	A.F.A.	Rev. Net Area & Esmt Par. 4-239, 4-240	DRAWN BY	LMF.
				DATE COMP.	7-29-83
				SCALE	

REDUCED SIZE DO NOT SCALE

OWNERSHIP RECORD										ACQUISITION RECORD				
PARCEL NUMBER	OWNER	DESCRIPTION	TOTAL AREA	AREA GROSS INCLUDING EXISTING R/W	AREA REQUIRED NET EXCLUDING EXISTING R/W	EASEMENT AREA	REMAINDER LEFT	REMAINDER RIGHT	SHEET NUMBER	BOARD APPROVAL	TYPE & DATE OF INSTRUMENT	RECORDED DATE	RECORDED BOOK	RECORDED PAGE
4-239	U.S.A., Bureau of Reclamation (S.R.P.)	Pt. of Secs 21, 27, 28 & 34, T.5N., R.11E., & Pt. W2, Sec. 2, T.4N., R.11E.			~~99.3 Ac.~~ 115.6 Ac.	T.C.E. ~~4.5 Ac.~~ 7.1 Ac.			4 thru 11					
4-240	U.S.A. (Tonto National Forest)	Pt. of SE4 SE4, Sec. 28, T.5N., R.11E.			2.3Ac.	T.C.E. 0.8 Ac.			6					
		Pt. of NW4, Sec. 34, T.5N., R.11E.			1.8 Ac.				7					
		Pt. of W2; Sec. 2; T.4N, R.11E.			~~16.3 Ac.~~	~~2.6Ac. T.C.E.~~			9 thru 11					

CHECKED BY: Peter Bryan

HARD COPY

BRUNING 44-512

ROOSEVELT - PAYSON HWY.
ROCK CREEK - BUMBLEBEE CREEK
GILA COUNTY

Click here for SR 188 Index

REVISIONS				PROJECT NO.	S-456-705
C.O. No.	DATE	BY	DESCRIPTION	DRAWING NO.	0-4-T-369
6666	10/14/84	Leroy	Add New T.C.E. Rt. Sta. 1017+25 & Constr. Limits.	SHEET NO.	3 of 11
"	"	"	Revised New R/W at Rock Creek.	DRAWN BY	RB
7187	11-18-85	A.F.A.	Re-plotted Section 2, T.4N., R.11E.	DATE COMP.	7-29-83
				SCALE	1" = 1000'

HARD COPY 8229 M1 CHECKED BY

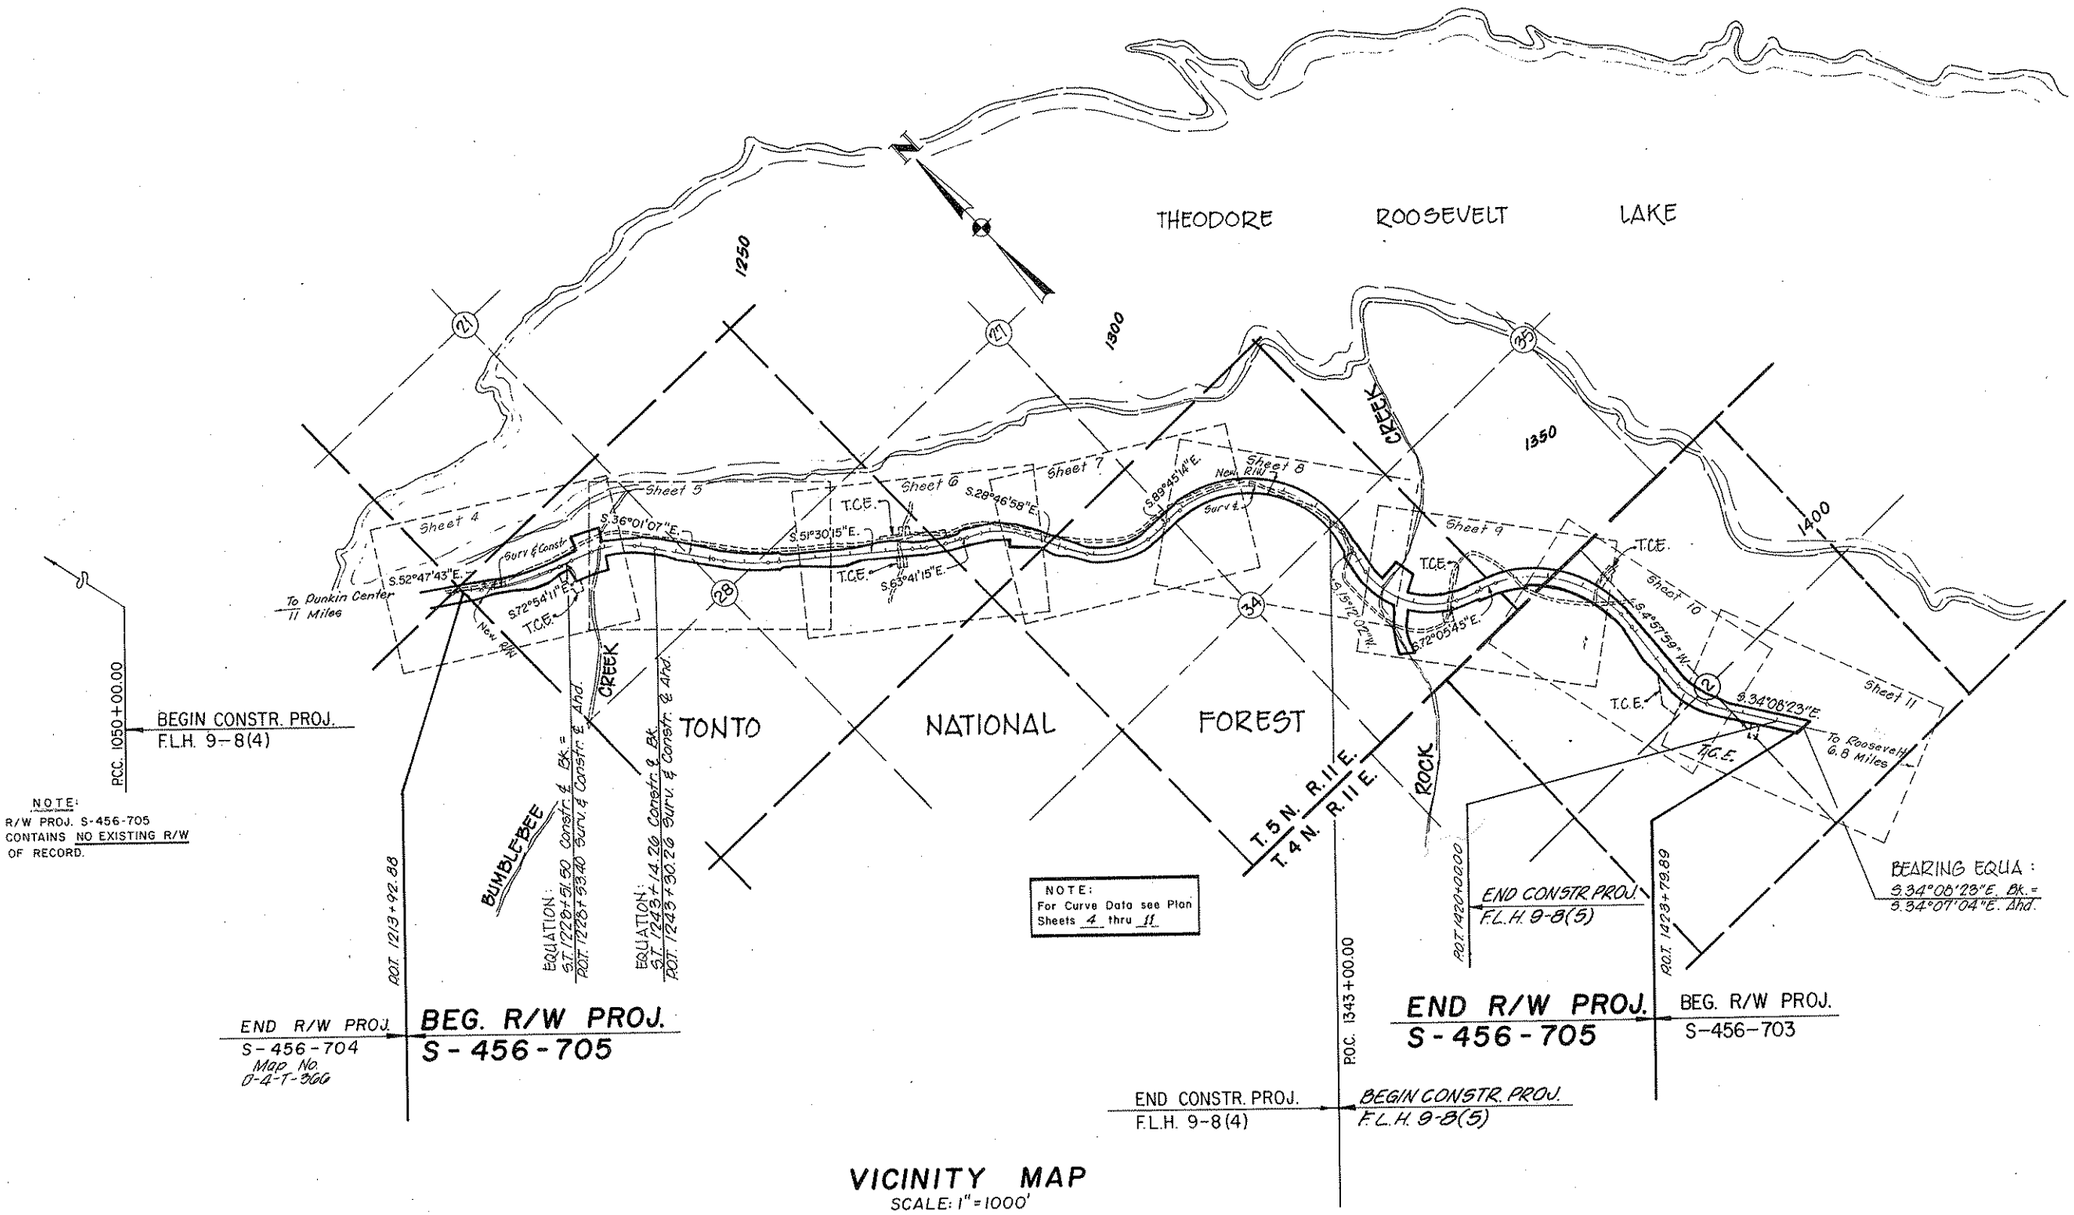

VICINITY MAP
SCALE: 1" = 1000'

ROOSEVELT - PAYSON HWY.
ROCK CREEK - BUMBLEBEE CREEK
GILA COUNTY

Click here for SR 188 Index

REVISIONS				
C.O. No	DATE	BY	DESCRIPTION	

PROJECT NO.	S-456-705
DRAWING NO.	D-4-T-369
SHEET NO.	4 of 11
DRAWN BY	RJ
DATE COMP.	7-29-85
SCALE	1" = 100'

CHECKED BY. _____
HARD COPY ____ 8229 M-1
DRAWING 44-512

T.5N. R.11E.

1/16 Cor. Fnd B.C. in Conc. Post U.S. Dept. of Agriculture Biological Surv.

SEC. LINE N.01°11'25"E.

SEC. COR.

15.68' 10 21 20 92.20' 29 12.61'

NEW R/W

S.52°47'43"E. SURV. ℄

CONSTR. ℄ S.56°00'46"E.

POT. 1213+04.70 Sec. Ln. Tie (C)

180.76'

N.0°05'59"E.

NEW R/W

— DETAIL — No Scale

SE¼SE¼

1199.55'(C.) N.89°54'42"W.

1/16 Cors. Fnd. B.C. U.S. Dept. of Interior Biological Surv. (1934)

P.C.C. 1050+00.00

BEGIN CONSTR. PROJ.
F.L.H. 9-8(4)

END R/W PROJ.
S-456-704
Map No. D-4-T-366

BEG. R/W PROJ.
S-456-705

POT. 1213+92.88 Surv. ℄ Sec. Line Tie

NE¼NE¼

1326.93'(C.) N.0°05'59"E. Sec. Ln.

1/16 Cor. Fnd. B.C. U.S. Dept. of Interior Biological Surv. (1934)

1210 1215 1220 1225 1230 1235

3966.98'(C.) N.0°11'25"E.

THEODORE ROOSEVELT LAKE

Approx. Sec. Ln.

Sec. Cor. Fnd. B.C. U.S. Dept. of Interior Biological Surv. (1934)

100.00' Lt Constr. ℄ POT. 1213+27.49

New R/W

S.56°00'46"E. 519.50'

S.52°47'43"E. Surv. ℄

S.56°00'46"E. Constr. ℄

122.01' 20 21 29 28 92.20'

NW¼NW¼

S.56°32'29"E. 197.20'

NEW GAME FENCE L=660.62' R=2764.78'

S.72°27'45"E. 180.59'

NEW 2-36" PIPE CULV's

NEW 48" PIPE CULV.

EXIST. S.R. 188

Constr. ℄

SLOPE LIMITS

Surv. ℄

354.95' N.64°06'38"W. 162.79' N.59°55'02"W. N.51°15'55"W. 309.71' 210.45' N.65°28'22"W. 205.97' N.69°26'44"W.

150.00' Rt. Constr. ℄ POT. 1214+95.58

NEW GAME FENCE

T.S. 1218+09.11 Surv. ℄

T.S. 1218+49.99 Constr. ℄

S.C. 1220+06.99 Constr. ℄

L.T.B. S.57°36'46"E.

T.S. 1216+49.11 Surv. ℄

4-299

C.S. 1226+54.50 Surv. ℄

C.S. 1226+91.50 Constr. ℄

L.T.B. S.71°16'11"E.

S.T. 1228+14.50 Surv. ℄

Approx. ℄ of U.S. 60/70/80

EQUATION: ST. 1228+51.90 Constr. ℄ Bk. = ST. 1228+53.40 Surv. ℄ Constr. ℄ Ahd.

POT. 1228+53.40

S.72°27'45"E. 180.59'

S.71°55'25"E. 205.21'

S.71°54'11"E. Surv. ℄

S.71°54'11"E. CONSTR. ℄

194.17' N.72°27'07"W.

N.18°49'49"E. 150'

94.09' N.72°01'12"W.

T.C.E.

N.72°54'11"W. 100'

N.21°19'12"E. 212.20'

T.S. 1228+84.78 Constr. ℄

T.S. 1229+99.46 Surv. ℄

S.C. 1230+84.78 Constr. ℄

L.T.B. S.69°54'11"E.

N.20°05'49"E. 200'

S.C. 1232+99.46 Surv. ℄

NE¼NW¼

New R/W

L=422.59' R=2208.86'

P.O.C. 1234+50.00 Constr. ℄

L.T.B. S.56°56'47"E.

S.3°03'13"W. 200'

CREEK

NEW 3-SPAN PRESTRESSED CONC. GIRDER BRIDGE

Surv. ℄

Constr. ℄

N.70°07'53"W. 314.85'

50.06'

176.92' N.62°06'47"W.

S.3°03'13"W.

Match Line

BUMBLEBEE

300.00' Rt. Constr. ℄ POC. 1232+00.00

20.0' 1234+50.00 Constr. ℄

SE¼NW¼

SW¼NW¼

1/16 Ln.

TONTO NATIONAL FOREST

Curve Data
Surv. ℄
TOTAL
I = 20°06'28" Lt.
L = 1165.39'
Ts = 587.88'
MAIN
Δ = 16°54'28"
D = 2°00'00"
R = 2864.79'
L = 845.39'
SPIRAL
a = 1 1/4
Δ = 1°36'00"
L = 160.00'

Curve Data
Constr. ℄
TOTAL
I = 16°53'25" Lt.
L = 1004.51'
Ts = 505.40'
MAIN
Δ = 13°41'25"
D = 2°00'00"
R = 2864.79'
L = 684.51'
SPIRAL
a = 1 1/4
Δ = 1°36'00"
L = 160.00'

Curve Data
Surv. ℄
TOTAL
I = 36°53'04" Rt.
L = 1222.11'
Ts = 628.48'
MAIN
Δ = 24°53'04"
D = 4°00'00"
R = 1432.38'
L = 622.11'
SPIRAL
a = 1 1/3
Δ = 6°00'00"
L = 300.00'

Curve Data
Constr. ℄
TOTAL
I = 36°53'04" Rt.
L = 1429.48'
Ts = 737.17'
MAIN
Δ = 30°53'04"
D = 3°00'00"
R = 1909.86'
L = 1029.48'
SPIRAL
a = 1 1/2
Δ = 3°00'00"
L = 200.00'

REDUCED SIZE DO NOT SCALE

ROOSEVELT - PAYSON HWY.
ROCK CREEK - BUMBLEBEE CREEK
GILA COUNTY

REVISIONS				
C.O. No.	DATE	BY	DESCRIPTION	

PROJECT NO.	S-456-705
DRAWING NO.	D-4-T-369
SHEET NO.	5 of 11
DRAWN BY	RJ
DATE COMP.	7-28-83
SCALE	1"=100'

CHECKED BY. _____

HARD COPY 8229 M-1

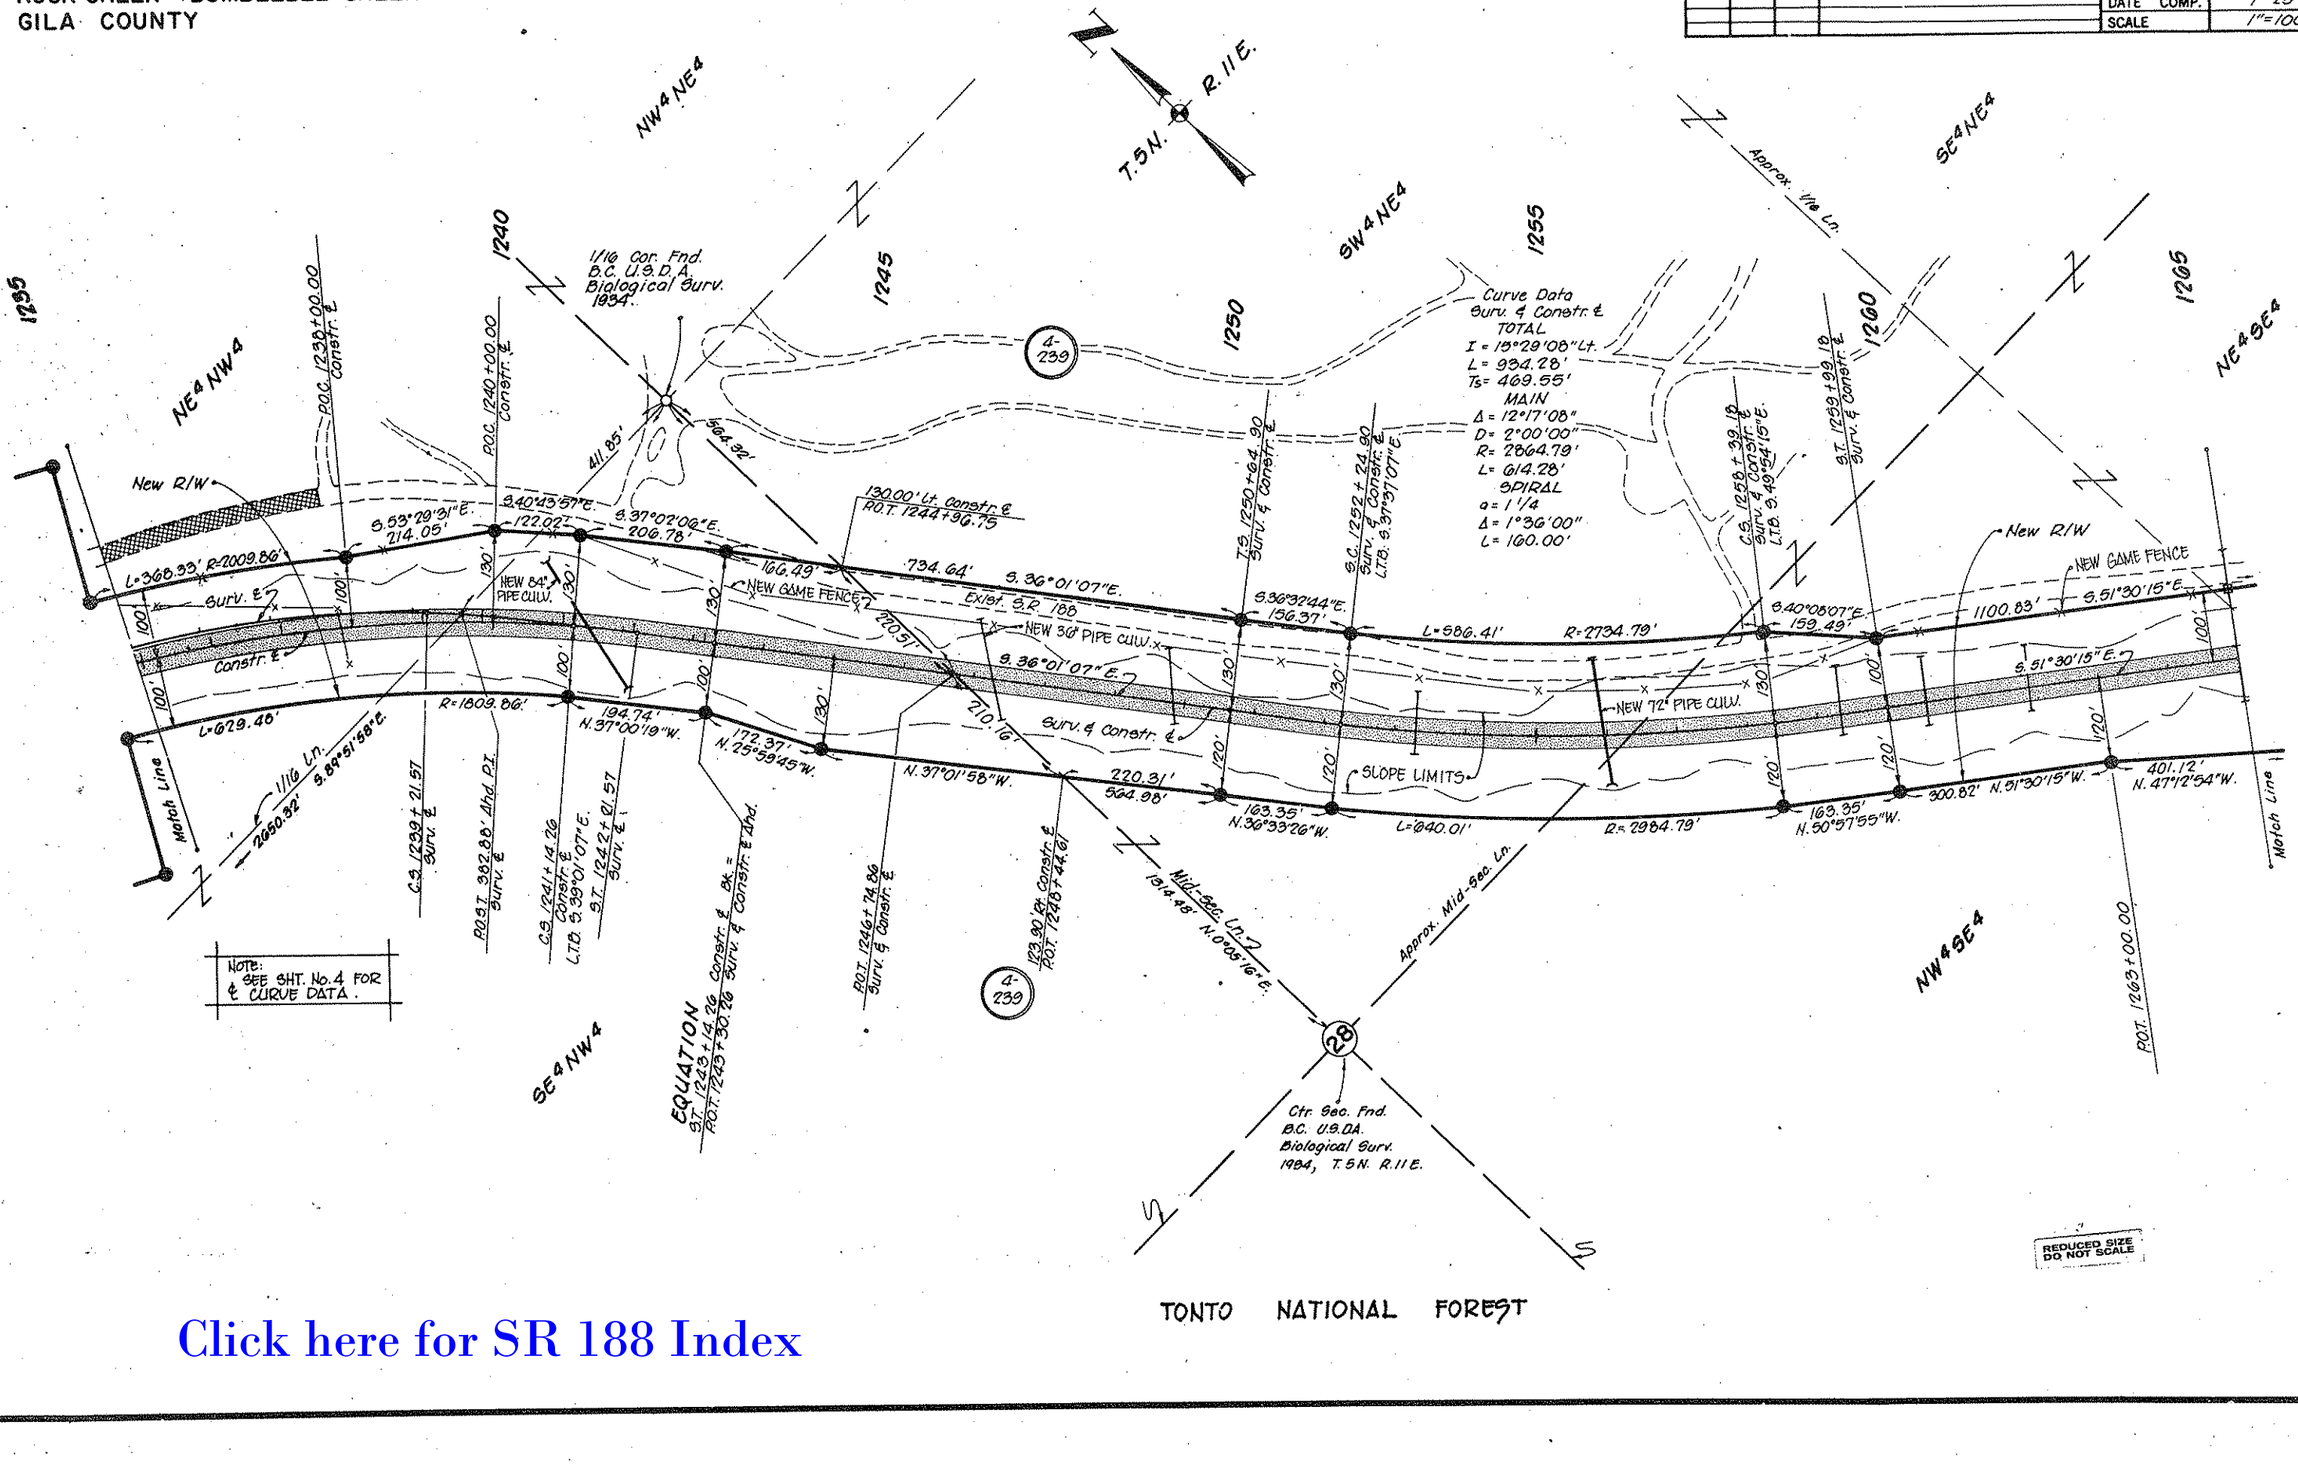

Click here for SR 188 Index

BRUNING 44-512

ROOSEVELT – PAYSON HWY.
ROCK CREEK – BUMBLEBEE CREEK
GILA COUNTY

REVISIONS				
C.O No.	DATE	BY	DESCRIPTION	

PROJECT NO.	S-456-705
DRAWING NO.	D-4-T-309
SHEET NO.	6 of 11
DRAWN BY	RJ
DATE COMP.	7-29-83
SCALE	1"=100'

CHECKED BY: RJ Gan

HARD COPY 8229 M-1

T.5N. R.11E.

Curve Data
Constr. & Surv. ℄
TOTAL
I = 12°11'00" Lt.
L = 687.33'
Ts = 344.66'
MAIN
Δ = 7°11'00"
D = 2°30'00"
R = 2291.83'
L = 287.33'
SPIRAL
a = 1 1/4
Δ = 2°30'00"
L = 200.00'

1/16 Cor. Fnd. B.C. 103
U.S. Dept. of Agriculture
Biological Surv. 1954

NE4SE4 NW4SW4 SW4SW4 NW4SE4 SE4SE4 NW4NW4

4-239 4-240

1265 1270 1275 1280 1285 1290 1295

New R/W
NEW GAME FENCE
Exist. S.R. 188
SLOPE LIMITS
NEW 3-8'x7' BOX CULV.
Constr. & Surv. ℄
EXIST. FENCE
New 4' Dike
Match Line
T.C.E.
Approx. 1/16 Ln.
Sec. Ln.

135.63' Lt. Constr. ℄ ROT. 12774+25.00
N. 36°29'45"E. 89.38'
ROT. 12774+25.00 Constr. ℄
1100.83' S.51°30'15"E.
302.04' S.55°09'31"E.
175.06' 200.06' S.52°56'11"E.
289.97' S.43°34'31"E.
322.28' S.57°44'19"E.
190.82'
787.21' N.51°30'15"W.
401.12' N.47°12'54"W.
200.00' N.51°30'15"W.
206.16' N.65°32'25"W.
204.35' N.52°20'47"W.
204.35' N.62°50'42"W. 104.82'
104.82' 316.77' S.61°07'17"E.
197.48'
L=443.26' R=1275.92' S.25°55'21"E. 316.85'
285.63' N.57°14'45"W.
249.62' N.49°23'06"W.
390.00' N.57°43'03"W.
1328.44' N.01°15'37"W.
1288.08' N.89°50'52"E.

S.C. 1280+87.21 L.T.B. S.54°00'19"E.
C.S. 1283+74.54 L.T.B. S.61°11'15"E.
S.T. 1285+74.54 L.T.B. S.28°18'49"W.
S.C. 1289+79.30 L.T.B. S.56°11'15"E.
S.C. 1293+77.45 L.T.B. S.56°16'38"E.
P.O.C. 1282+52.34 Sec. Ln. Tie L.T.B. S.58°07'37"E.
100.00' Lt. Constr. ℄ P.O.C. 1283+83.40 L.T.B. S.56°24'32"E.
100.00' Rt. Constr. ℄ P.O.C. 1283+74.54 L.T.B. N.59°40'37"W.
139.20' Rt. Constr. ℄ P.O.C. 12932+58.74
276.89' Rt. Constr. ℄ P.O.C. 12933+16.81
ROT. 1267+00.00
ROT. 1269+00.00
ROT. 1271+00.00
ROT. 1276+65.00
ROT. 1277+90.00

Curve Data
Constr. & Surv. ℄
TOTAL
I = 34°54'17" Rt.
L = 998.09'
Ts = 511.20'
MAIN
Δ = 19°54'17"
D = 5°00'00"
R = 1145.92'
L = 398.09'
SPIRAL
a = 1 2/3
Δ = 7°30'00"
L = 300.00'

Sec. Cor. Fnd. 5"x 7"x 12" Granite Stone and Mound of Stone Mkd. XXXIV South XXVIII West XXVII East

28 27 33 34

TONTO NATIONAL FOREST

REDUCED SIZE DO NOT SCALE

Click here for SR 188 Index

ROOSEVELT – PAYSON HWY.
ROCK CREEK – BUMBLEBEE CREEK
GILA COUNTY

REVISIONS				
C.O No.	DATE	BY	DESCRIPTION	

PROJECT NO.	S-456-705
DRAWING NO.	0-4-T-369
SHEET NO.	7 of 11
DRAWN BY	RL
DATE COMP.	7-29-83
SCALE	1" = 100'

CHECKED BY: _____

COPY. 8229 MI

HARD COPY

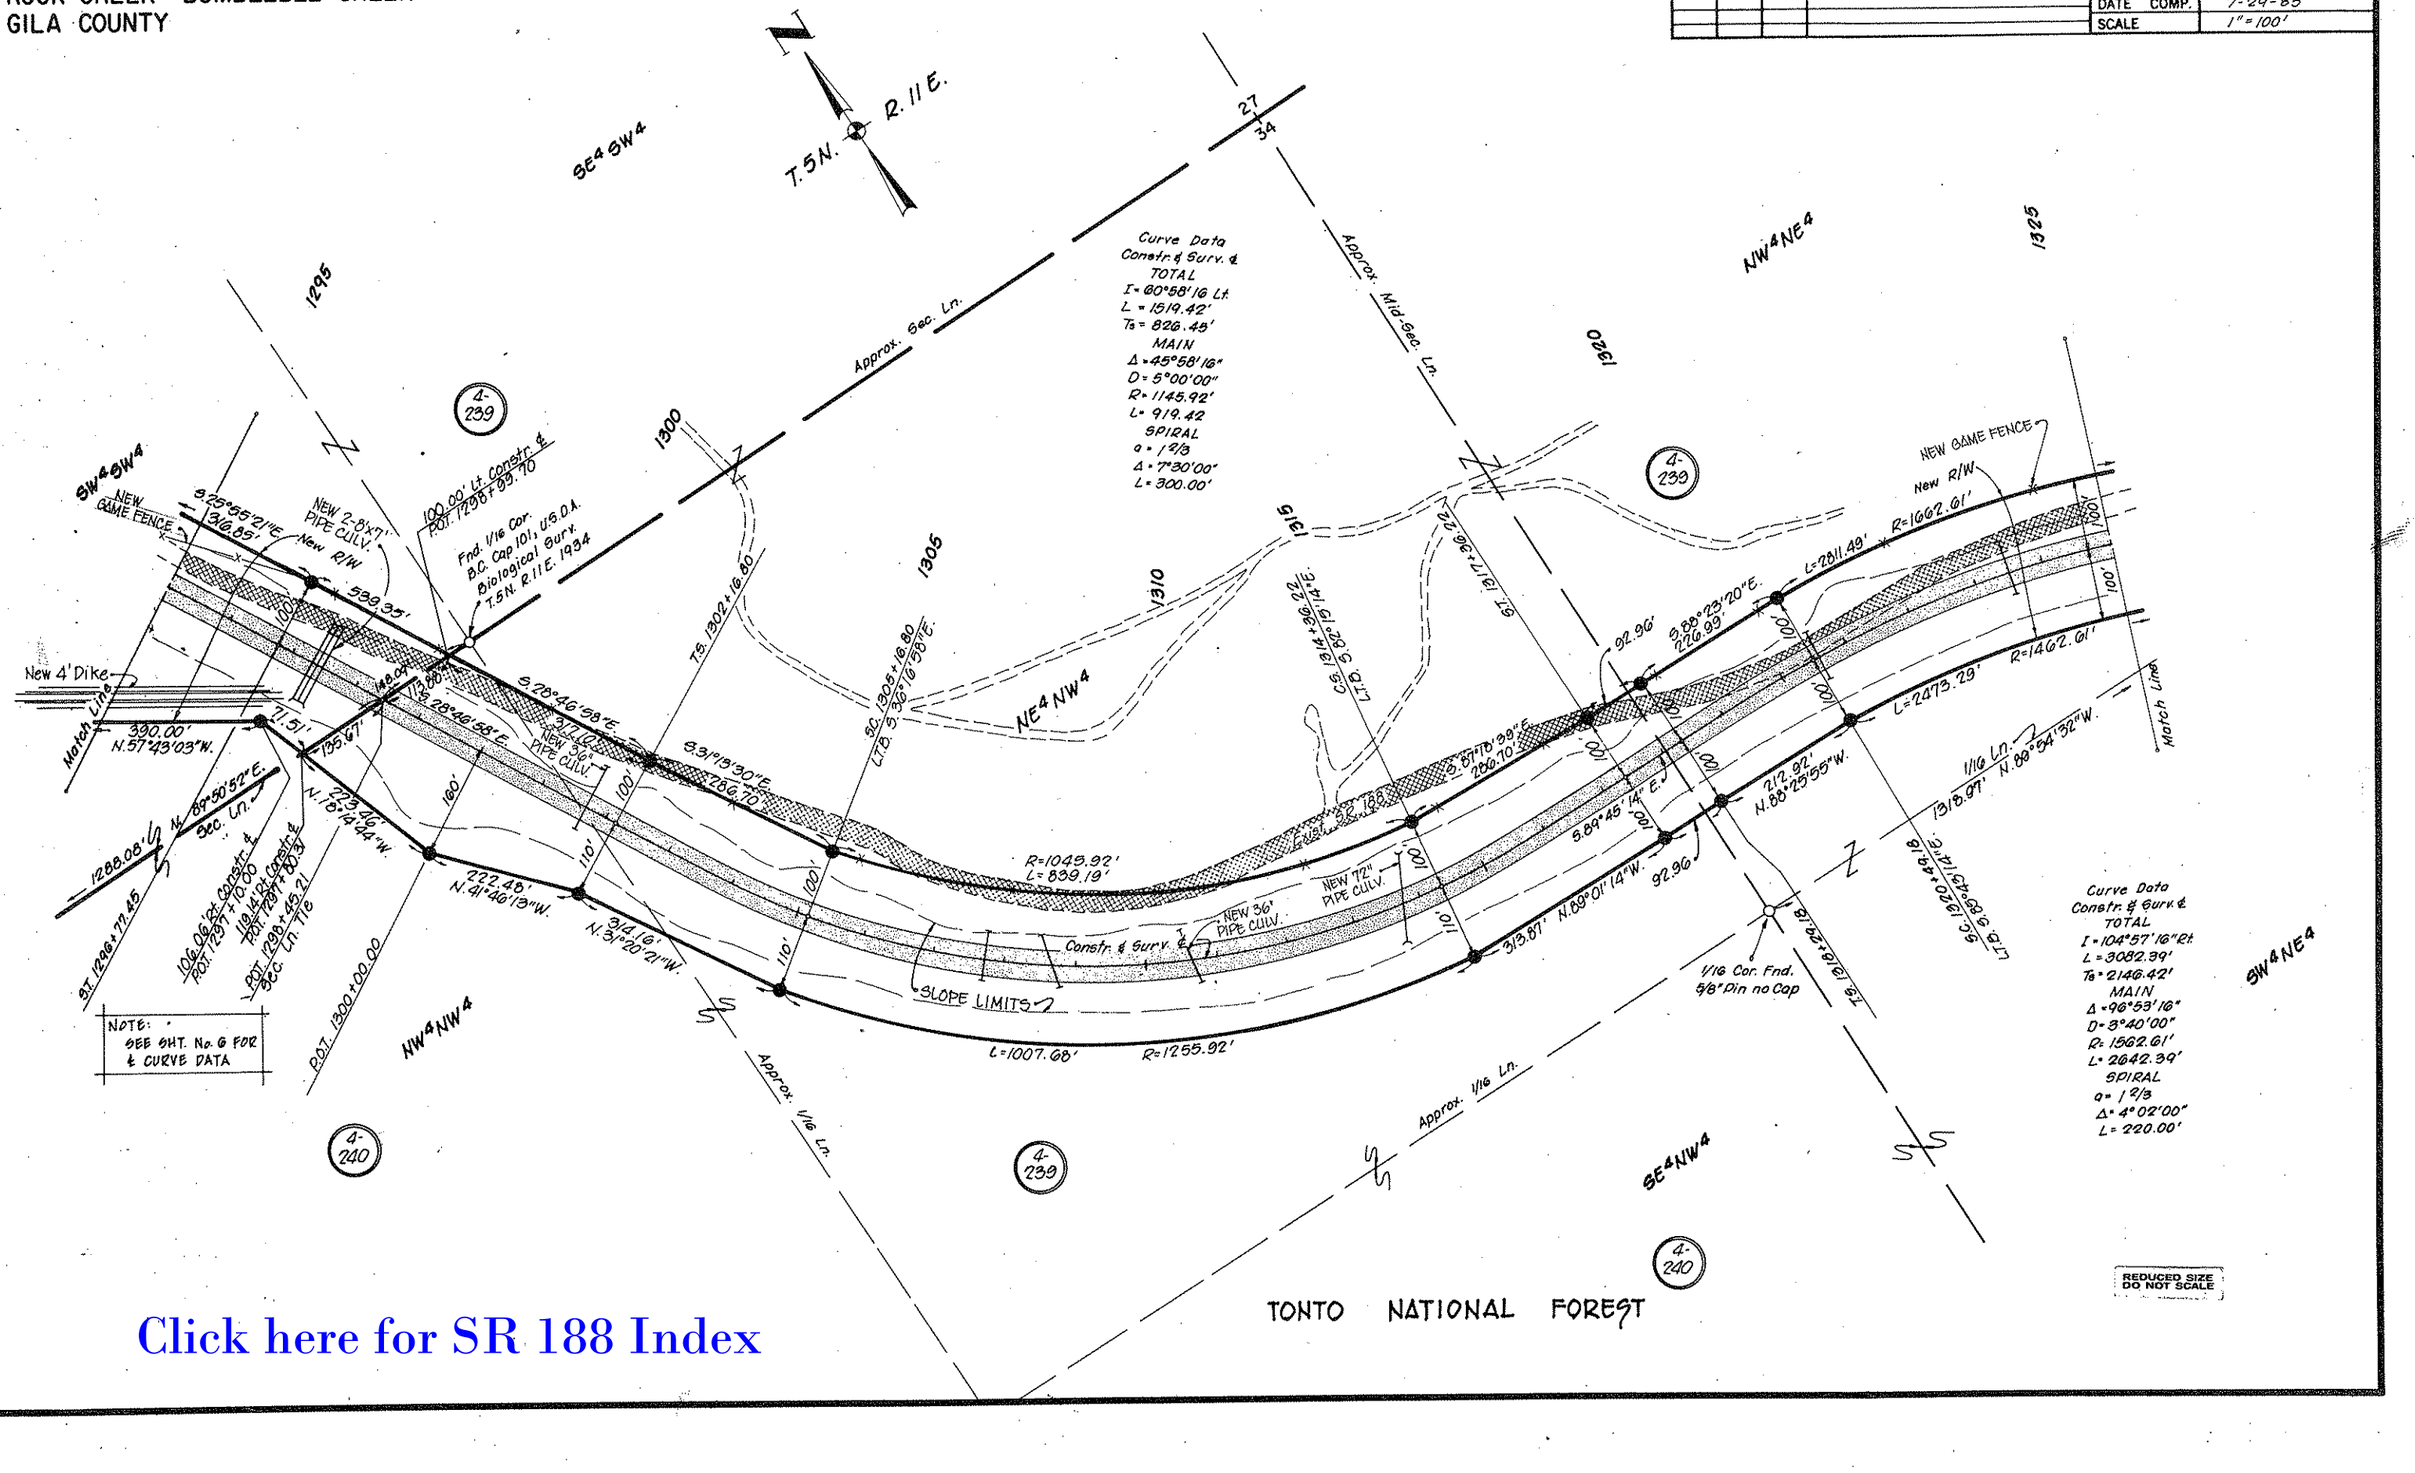

Click here for SR 188 Index

ROOSEVELT – PAYSON HWY.
ROCK CREEK – BUMBLEBEE CREEK
GILA COUNTY

REVISIONS				PROJECT NO.	S-456-705
C.O. No.	DATE	BY	DESCRIPTION	DRAWING NO.	D-4-T-369
6566	6-25-84	MC	Added Begin Constr Proj	SHEET NO.	8 of 11
				DRAWN BY	RJ
				DATE COMP.	7-29-83
				SCALE	1"=100'

CHECKED BY. Rick Myers

HARD COPY. 8229 M.I.

Fnd. 1/16 Cor. BC. 97, U.S.D.A. Biological Surv. 1934

NEW GAME FENCE

SLOPE LIMITS Constr. & Surv. ℄

EXIST. S.R. 188

NEW 72" PIPE CULV.

NEW 4-30" PIPE CULV.

NEW 3-48" PIPE CULV.

NEW 60" PIPE CULV.

New R/W

Match Line

1/16 Line

N.89°54'32"W. 1318.97'

Fnd. 1/16 Cor. 5/8" Pin no Cap

T.5N. R.11E.

NW¼NE¼ SE¼NE¼ SW¼NE¼ NE¼SE¼ NW¼SE¼

1325 1330 1335 1340 1345 1350 1355

4-240 4-239 4-238

271.99' 304.88'

L=2811.49' R=1062.61'

L=2473.29' R=1462.61'

1320.60' S. 0°05'58" W.

POC. 1337+78.16 1/16 Cor. 1/16 S. 40°59.90'E. L.T.B.

POC. 1328+78.16 1/16 Cor. 1/16 S. 9°54'40"E. L.T.B.

Curve Data
Constr. & Surv. ℄
TOTAL
I = 104°57'16" Rt
L = 3082.39'
Ts = 2146.42'
MAIN
Δ = 96°53'16"
D = 3°40'00"
R = 1562.61'
L = 2642.39'
SPIRAL
a = 1 2/3
Δ = 4°02'00"
L = 220.00'

POC. 1343+00.00

END CONSTR. PROJ. F.L.H. 9-8(4)

BEGIN CONSTR. PROJ. F.L.H. 9-8(5)

Approx. Mid-Sec. Ln.

Fnd. 1/16 Cor. BC. 98, U.S.D.A. Biological Surv. 1934

C.S. 1346+91.57 L.T.B. S.11°10'02"W.

S.T. 1349+11.57

N.13°52'41"E. 212.91'

N.3°40'59"E. 316.47'

S.T. 1349+86.56

S.12°46'12"W. 204.08'

S.15°12'02"W. 77.62'

S.11°10'02"W. 220.29'

S.C. 1352+86.56 L.T.B. S.T=42°02'W.

N.12°38'20"E. 316.47'

R=1029.92' L=604.40'

R=1029.92'

TONTO NATIONAL FOREST

NOTE: SEE SHT. NO. 9 FOR ℄ CURVE DATA.

REDUCED SIZE DO NOT SCALE

Click here for SR 188 Index

ROOSEVELT – PAYSON HWY.
ROCK CREEK – BUMBLEBEE CREEK
GILA COUNTY

REVISIONS				PROJECT NO.	S-456-705
C.O. No.	DATE	BY	DESCRIPTION	DRAWING NO.	D-4-T-369
6566	9/1/82	ETDY	Revised R/W Lt. Sta 1340+00, Revised R/W Rt Sta 1358+ To 1340+ From Sta 1340+ to Sta 1370+37	SHEET NO.	9 of 11
"	"	"	49 Each Side	DRAWN BY	RJ
7187	11-18-85	A.F.A.	Deleted Section line and lot 1 Added 1/16 th line.	DATE COMP.	7-29-85
"	"	"	Lot 3 & Por. 4-240 & re-plotted lot 4 in Sec. 2	SCALE	1" = 100'
"	"	"	T4N R11E		

HARD COPY 8229 M1 CHECKED BY: RJ Glass

Curve Data
Constr. & Surv. ℄
TOTAL
I = 87°17'47" Lt.
L = 2045.93'
Ts = 1246.11'
MAIN
Δ = 72°17'47"
D = 5°00'00"
R = 1145.92'
L = 1446.93'
SPIRAL
a = 1 2/3
Δ = 7°30'00"
L = 300.00'

Curve Data
Constr. & Surv. ℄
TOTAL
I = 77°03'44" Rt.
L = 2321.70'
Ts = 1355.35'
MAIN
Δ = 65°59'44"
D = 3°40'00"
R = 1562.61'
L = 1801.70'
SPIRAL
a = 1 2/3
Δ = 4°02'00"
L = 220.00'

1355 P.O.C. 1355+50.00 L.T.B. S 5°28'17"E.
P.O.C. 1360+35.00 L.T.B. S 28°13'17"E.
1365
1370
1375
1380
1395
1400
Approx. 1/16 Ln.
Approx. Sec. Ln.
ST. 1370+32.49
N 84°39'43"E. 900'
S 11°50'49"E. 306.34'
N 60°46'43"E. 260.00'
NE¼SE¼
SW¼SE¼
SE¼SE¼
NW¼NW¼
LOT 4
LOT 3
NE¼NW¼
SW¼SW¼
SW¼SW¼
NEW GAME FENCE
NEW BRIDGE
NEW R/W
L = 627.23' R = 1015.92'
285.62'
S 63°38'51"E.
SLOPE LIMITS
S 64°35'45"E.
S 70°43'50"E. 226.99'
NEW GAME FENCE
L = 2002.12'
R = 1562.61'
Milepost #749 & Marker
NEW 60" PIPE CULV.
NEW 4' DIKE
NEW 36" Pipe Culv.
L = 1365.81'
R = 1462.61'
L = 961.85' R = 1412.61'
74.99'
209.39'
N 70°47'0" W.
S 72°05'45"E.
NEW 36" PIPE CULV.
130'
100'
150'
50.00'
S 31°25'45"W.
SC 1373+27.49
LTB S 66°03'45"E.
T.9N. R.11E.
T.4N. R.11E.
Approx. Twp. Ln.
North Line
Section Line
35
34
POC 1371+50.00 L.T.B. N 39°44'17"W.
4-239
4-240
APPROX. V/G LINE
TONTO NATIONAL FOREST
ROCK CREEK
Match Line
600.40' R = 1765.92'
6° 41' 20.00" 331.30'
120' Rt. Constr. ℄ P.O.C. 1356+33.04 L.T.B. N 18°38'11"W.
430.61' Rt. Constr. ℄ P.O.C. 1359+40.79
748.56' Rt. Constr. ℄ P.O.C. 1360+50.32 L.T.B. N 24°52'00"E.
450.01' S 41°17'32"E.
717.39' Rt. Constr. ℄ P.O.C. 1363+24.78
Approx. Ste Ln.
130' Rt. Constr. ℄ P.O.C. 1361+22.88 L.T.B. N 34°06'55"W.
352.22' Rt. Constr. ℄ P.O.C. 1361+57.02
605.65' Rt. Constr. ℄ P.O.C. 1362+53.39
P.O.C. 1364+19.00 Constr. ℄ L.T.B. S 49°43'17"E.
P.O.C. 1365+20.00 Constr. ℄ L.T.B. S 59°58'17"E.
T.C.E.
L = 116.91'
R = 1275.92'
318.30' S 65°55'49"E.
325.36'
L = 678.77'
S 44°29'26"W.
226.01'
R = 1200.28'
L = 390.00'
S 41°19'45"E. 130'
S 51°20'34"E. 127.80'
S 8°40'11"W. 130'
S 49°43'17"E.
S 59°58'17"E.
L = 1590.27'
R = 1015.92'

ROOSEVELT - PAYSON HWY.
ROCK CREEK - BUMBLEBEE CREEK
GILA COUNTY

REVISIONS				PROJECT NO.	S-456-705
C.O No.	DATE	BY	DESCRIPTION	DRAWING NO.	D-4-T-369
7187	11-19-85	A F A	Deleted section line, lot 4 & par 4-240. Added lot 2, 1/16 th line. Revised mid-section line, and re-plotted lot 3.	SHEET NO.	10 of 11
"	"	"		DRAWN BY	RJ
				DATE COMP.	7-29-83
				SCALE	1"=100'

CHECKED BY _____ HARD COPY 8229 M1

Approx. 1/16 Ln.
Approx. TWP Ln.
1385
1390
1395
1400
1405
1410
1380
T.C.E.
LOT 2
LOT 3
4-239
NW4 NE4
SW4 NE4
NW4 SE4
SW4 SW4
NE4 NW4
SE4 NW4
NE4 SW4
100.00' S.3°32'48"E.
50.00' S.86°27'12"W.
50.00' N.86°27'12"E.
132.05' N.72°42'12"E.
P=868.51'
L=208.43'
L=184.43'
S.77°42'12"W.
P=768.51'
132.05'
100.00' Lt. Constr. ℄ P.O.C. 1386+65.00 L.T.B. N.19°01'12"W.
R=1662.61'
L=2002.12'
L=100.02'
100.00' Lt. Constr. ℄ P.O.C. 1387+59.00 L.T.B. N.15°34'24"W.
NEW 48" PIPE CULV
EXIST. 32' DIRT RD.
L=1365.81'
R=1462.61'
New R/W
APPROX. MID. SECTION LINE
S.3°36'05"W. 776.99'
SLOPE LIMITS
S.4°57'59"W.
775.34' S.2°00'33"W.
S.2°32'52"W. 281.46'
212.92' N.3°30'40"E.
471.24' N.7°23'56"E.
303.50' N.4°57'59"E.
315.47' N.2°24'15"E.
406.08' N.36°49'25"E.
T.C.E.
255.28' N.11°55'24"W.
Sta. 1402+03.49
Sta. 1403+03.49
EXIST. DIRT RD.
L.T.B. S.2°32'01"E.
Sta. 1409+85.61
C.S. 1409+85.73
L.T.B. S.26°35'13"E.
New R/W
L=473.22' R=1005.92'
L=217.05'
L=532.61'
R=1265.92'
WATER SIGN
Curve Data
Constr. & Surv. ℄
TOTAL
I = 39°06'22" Lt.
L = 1082.12'
Ts = 558.06'
MAIN
Δ = 24°06'22"
D = 5°00'00"
R = 1145.92'
L = 482.12'
SPIRAL
o = 1°/5
Δ = 7°30'00"
L = 300.00'
NOTE: SEE SHT. No. 9 FOR ℄ CURVE DATA.
Approx. Sec. Ln.
T.5N. R.11E.
T.4N. R.11E.
34
35
APPROX. 1/16 LINE
Match Line
Approx. Mid-Sec. Ln.
C.S. 1392+28.18 L.T.B. S.0°35'59"W.
Sta. 1394+28.18
Approx. 1/16 Ln.

Click here for SR 188 Index

BRUNING 44-512

ROOSEVELT - PAYSON HWY.
ROCK CREEK - BUMBLEBEE CREEK
GILA COUNTY

REVISIONS			
C.O. No.	DATE	BY	DESCRIPTION
C5660	10/1/84	Leroy	Add T.C.E. Rt. Sta. 1411+25± (Constr. Proj.
7187	11-19-85	A.F.A.	Revised 1/16th line & Mid-section line & Par.
"	"	"	4-239, Deleted Parcel 4-240.

PROJECT NO.	S-456-705
DRAWING NO.	D-4-T-369
SHEET NO.	11 of 11
DRAWN BY	RV
DATE COMP.	7-29-83
SCALE	1"=100'

CHECKED BY. Peter Mann

HARD COPY. 8229 M-1

REDUCED SIZE DO NOT SCALE

T.4 N.
R.11 E.

SW4 NE4
SE4 NW4
NW4 SE4
SW4 SE4
NE4 SW4

1410
1415
1420
1425

4-239

NOTE: SEE SHT. No. 10 FOR ℄ CURVE DATA.

C.S. 1409+85.61
L.T.B. S.26°38'23"E.

S.23°41'17"E. 285.96'

S.T. 1412+85.61

New R/W

1158.60'

S.34°08'23"E.

100' Lt. Constr. & Surv. ℄
P.O.T. 1424+44.21

S.88°36'41"W. Bk.° 1319.84'
S.88°38'06"W. Ahd.

1/16 Cor. Fnd.
U.S. Dept. of Agriculture
Biological Survey T.4N., R.11E.

APPROX. 1/16 LINE

BEARING EQUA:
S.34°08'23"E. Bk. =
S.34°07'04"E. Ahd.

140'
100'
120'
100'
118.90'
142.69'
120'

Constr. & Surv ℄

SLOPE LIMITS

1017.08'

315.46'
N.31°34'41"W.

Approx. Mid-Sec. Line

Match Line

200'
100'
200'
100'
T.C.E.

S.34°05'23"E.

1/16 Line
639.44'

120' Rt. Constr. & Surv. ℄
P.O.T. 1423+02.69

320' Rt. Constr ℄
P.O.T. 1416+35.00

320' Rt. Constr ℄
P.O.T. 1417+35.00

P.O.T. 1420+00.00

END CONSTR. PROJ.
F.L.H 9-8(5)

APPROX. MID. SECTION LINE

1/16 Cor. Fnd.
U.S. Dept. of Agriculture
Biological Survey T.4N., R.11E.

P.O.T. 1423+79.89

END R/W PROJ
S-456-705

BEGIN R/W PROJ.
S-456-703

Click here for SR 188 Index

BRUNING 44-512