PAYSON - SHOW LOW HWY. 160
STAR VALLEY SECTION
GILA COUNTY

Click here for SR 260 Index

REVISIONS				PROJECT NO.	S-309-601
C.O.	DATE	BY	DESCRIPTION	DRAWING NO.	D-4-T-328
	9-64	JCK	Added dimensions per title reports, NOTE	SHEET NO.	1 of 1
	"	"	upper Pk cor, added parcel 4-046.	DRAWN BY	L.F.W
8781	2-5-93	RCO	Added Vacated Note & Zipped Area.	DATE COMP.	5-20-64
"	"	"	Performed By DMJM ARIZONA, INC.	SCALE	1" = 200'

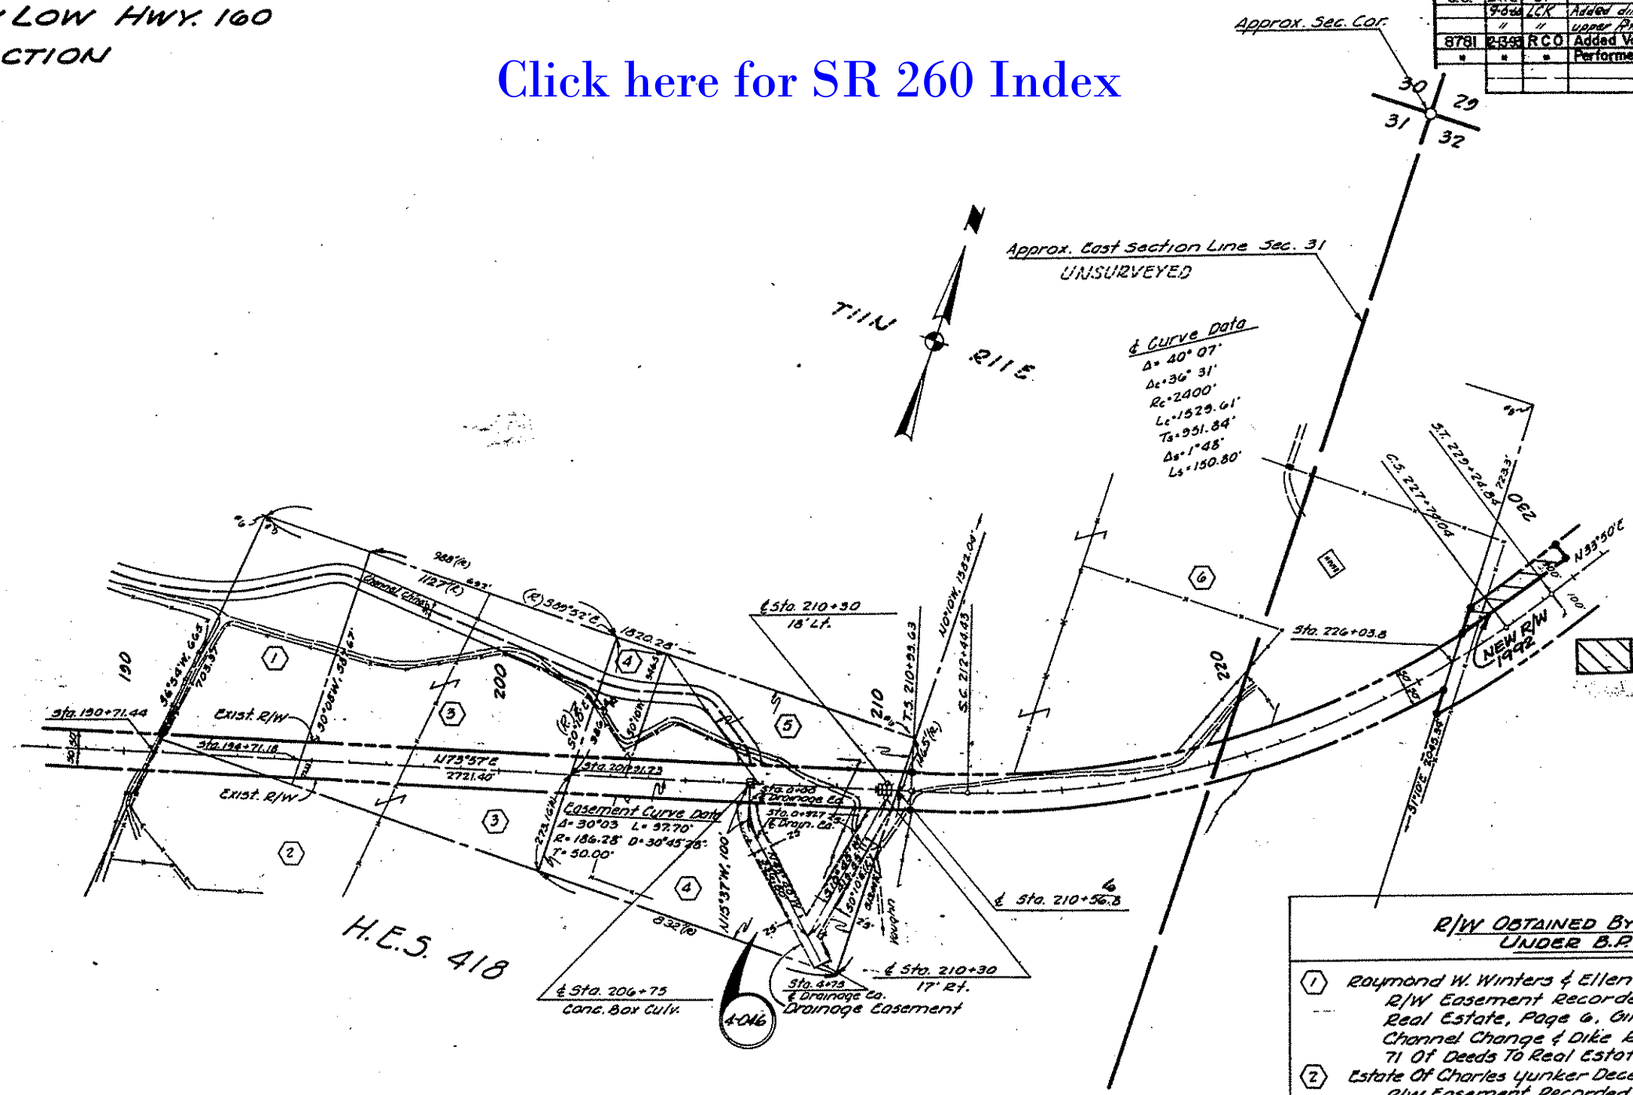

NOTE: This map is to be used for existing alignment and R/W index only.

AREA VACATED BY ADOT PER RES. NO. 92-03-A-19 REC. 3-30-92, DKT. 863, PG. 78. SEE PROJECT F-053-2-705, D-4-T-363 FOR MORE DETAIL.

ARIZONA HIGHWAY COMMISSION
APPROVED FOR ACQUISITION OF PARCELS
STATE HIGHWAY ENGINEER
Kfleldrick 5-21-64
DEPUTY STATE ENGINEER DATE

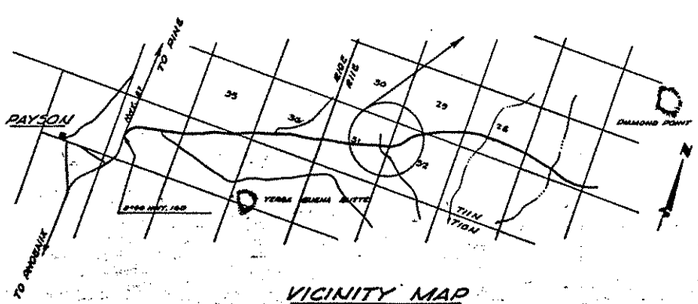

VICINITY MAP

R/W OBTAINED BY BUREAU OF PUBLIC ROADS UNDER B.P.R. PROJECT 11-H

(1) Raymond W. Winters & Ellen Winters:
R/W Easement Recorded August 21, 1953, Book 71, Of Deeds To Real Estate, Page 6, Gila County, Arizona.
Channel Change & Dike Right Of Entry Recorded August 21, 1953, Book 71 Of Deeds To Real Estate, Page 6, Gila County, Arizona.

(2) Estate Of Charles Yunker Deceased:
R/W Easement Recorded Aug. 21, 1953, Book 71 Of Deeds To Real Estate, Page 8, Gila County, Arizona.

(3) Harry C. Neal & Goldene H. Neal:
R/W Easement Recorded Aug. 21, 1953, Book 71 Of Deeds To Real Estate Page 1, Gila County, Arizona.
Channel Change & Dike Right Of Entry Recorded Aug. 21, 1953, Book 71 Of Deeds To Real Estate Page 1, Gila County, Arizona.

(4) Louis B. & Mary Jean Ellworth, Jr.:
R/W Easement Recorded Aug. 21, 1953, Book 70 Of Deeds To Real Estate Page 620, Gila County, Arizona.

(5) Chester A. & Edith L. Cochran:
R/W Easement Recorded Aug 21, 1953, Book 71 Of Deeds To Real Estate, Page 3, Gila County, Arizona.
Channel Change & Dike Right Of Entry Recorded Aug. 21, 1953, Book 71 Of Deeds To Real Estate Page 3, Gila County, Arizona.

(6) R.A. & Ida Moe Emmett:
R/W Easement Recorded Sept. 25, 1952, Book 69 Of Deeds To Real Estate, Page 607, Gila County, Arizona.

4-046 See Parcel File # 4-046.

HARD COPY AS BUILT PLANS FOR PROJECT 11-H CHECKED BY: 5-21-64