STATE OF ARIZONA
STATE HIGHWAY DEPARTMENT

STATE	PROJECT NO.	SHEET NO.	TOTAL SHEETS
	F-008-4-809	12	

RIGHT OF WAY MAP NO. D-9-T-219

ALIGNMENT, RIGHT OF WAY APPROVED IN ACCORDANCE WITH HIGHWAY PLANS
SHEET NO. 4 SHEETS 12
DATE 6-10-1964 [signature] STATE HIGHWAY ENGINEER

APPROVED IN ACCORDANCE WITH RESOLUTION DATED June 26, 1964, MINUTES OF THE ARIZONA HIGHWAY COMMISSION AS ITEM NO. 64-53

JOB NO. 66960

PRINTED
MAR 2 9 1975
R/W PLANS
PHOENIX, ARIZONA

RW/PLANS
FILE SET

RIGHT OF WAY PLAN OF THE
FLAGSTAFF-HOLBROOK
STATE HIGHWAY
PROJECT NO. F-008-4-809
NAVAJO
COUNTY

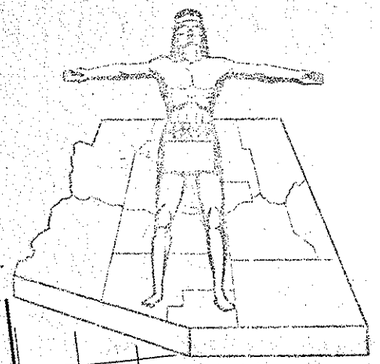

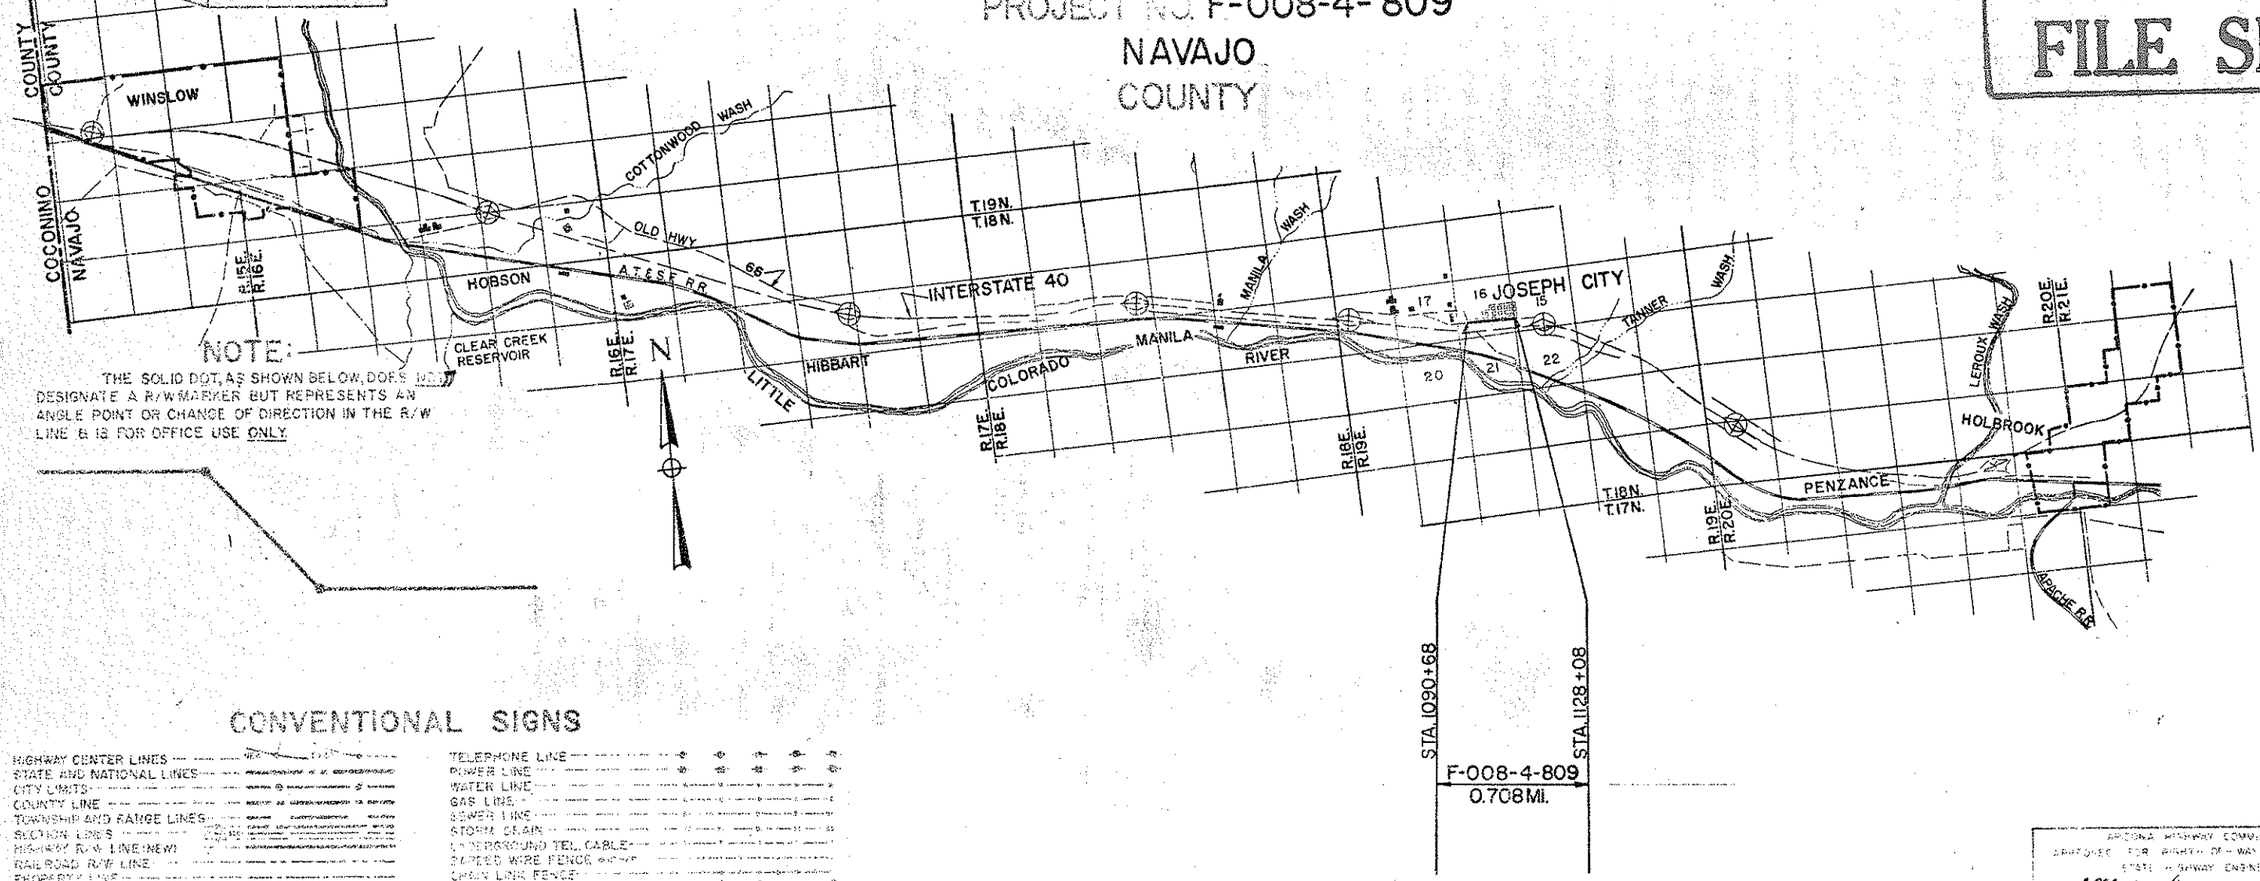

NOTE:
THE SOLID DOT, AS SHOWN BELOW, DOES NOT DESIGNATE A R/W MARKER BUT REPRESENTS AN ANGLE POINT OR CHANGE OF DIRECTION IN THE R/W LINE & IS FOR OFFICE USE ONLY.

CONVENTIONAL SIGNS

HIGHWAY CENTER LINES
STATE AND NATIONAL LINES
CITY LIMITS
COUNTY LINE
TOWNSHIP AND RANGE LINES
SECTION LINES
HIGHWAY R/W LINE (NEW)
RAILROAD R/W LINE
PROPERTY LINE
LOT AND PROPERTY LINE (WITHIN EXISTING R/W)
RAILROAD
COMMON R/L AND EXIST HWY R/W
ACCESS TO BE DENIED
ACCESS OPEN
PARCEL ITEM No.
POINTS (R/W MONUMENTS)
R/W RADIAL BOUNDARY
LAND GRANT BOUNDARY
R/W MARKER (EXCEPTION)
HIGHWAY R/W LINE (EXISTING)
SUBDIVISION OR LOT LINE
EXISTING CONTROL LOT ACCESS

TELEPHONE LINE
POWER LINE
WATER LINE
GAS LINE
SEWER LINE
STORM DRAIN
UNDERGROUND TEL. CABLE
BARBED WIRE FENCE
CHAIN LINK FENCE
POWER TRANSMISSION LINE
TELEPHONE & POWER LINE
POWER POLE WITH TRANSFORMER
DOWN GUY
LIGHT POLE
FIRE HYDRANT
WATER METER
W.S.& R. VALVE
MAN HOLE
EDGE ROAD OR TRAVELED WAY
GAS METER
GAS VALVE
TRAFFIC FLOW ARROW
PARKING LOT ARROW
TRAFFIC RADIO BASE

ARIZONA HIGHWAY COMMISSION
APPROVED FOR RIGHT OF WAY ACQUISITION
STATE HIGHWAY ENGINEER
[signature] 6-10-64
DATE

DEPARTMENT OF TRANSPORTATION
BUREAU OF PUBLIC ROADS
APPROVED
TRAFFIC ENGINEER — DATE

Click here for SR 40B Index

FLAGSTAFF-HOLBROOK HWY.
JOSEPH CITY STREETS
NAVAJO COUNTY

Click here for SR 40B Index

REVISIONS				PROJECT NO.	F-008-4-800
C.O.	DATE	BY	DESCRIPTION	DRAWING NO.	D-9-T-219
415	8/7/64	J.B.	Parcel 9-012 Added Easement; Deleted Net Area & changed Remainder.	SHEET NO.	2 of 12
455	9/30/64	J.B.	The following Parcels have been changed: 9-002, 9-003, 9-004, 9-009, 9-010, 9-010-1, 9-016, 9-017, 9-018, 9-018-1, 9-018-2, 9-019, 9-020, 9-021.	DRAWN BY	J. Button
				DATE COMP.	6-64
501	10/16/64	J.B.	Changed Parcel 9-022.	SCALE	1"

OWNERSHIP RECORD

PARCEL NUMBER	OWNER	DESCRIPTION	TOTAL AREA	AREA REQUIRED GROSS INCLUDING EXISTING R/W	AREA REQUIRED NET EXCLUDING EXISTING R/W	EASEMENT AREA	REMAINDER LEFT	REMAINDER RIGHT	SHEET NUMBER	COMM APPL	ACQ RECORD TYPE & DATE OF INSTRUMENT	RECORDED DATE	RECORDED BK	RECORDED PG
~~9-001~~	~~Gladys McLaws~~	~~Lot 34~~	~~81,576 Sq.Ft.~~	Deleted		6-3-64			4					
9-002	Archie Leo McLaws et ux	Lot 34	78,408 Sq.Ft.	Temp	Const.	Ease.	Only		4-5	12-18-64	TCE 6-5-63	NOT	RECORDED	
~~9-003~~	~~Theodore Owen Porter~~	~~Lot 37~~	~~39,204 Sq.Ft.~~	Deleted		9-22-64			4-5					
9-004	Edwin L. Westover et ux	Lot 33	10,140 Sq.Ft.	Temp.	Const.	Ease.	Only		5	12-18-64	TCE 6-5-63	NOT	RECORDED	
9-005	Hal D. Porter et ux	Lot 33	7,137 Sq.Ft.	"	"	"	"		5	12-18-64	TCE 6-5-63	NOT	RECORDED	
9-006	Midway Dairy (R. Westover)	Lot 33	13,464 Sq.Ft.	"	"	"	"		5	12-18-64	TCE 6-5-63	NOT	RECORDED	
9-007	Lester R. Porter et ux	Lot 32	8,991 Sq.Ft.	"	"	"	"		5	12-18-64	TCE 6-5-63	NOT	RECORDED	
9-008	Clinton Duncan et ux	Lot 32	30,894 Sq.Ft.	"	"	"	"		5	12-18-64	TCE 6-5-63	NOT	RECORDED	
~~9-009~~	~~Walter C. Shelley et ux~~	~~Lot 28~~	~~4800 Sq.Ft.~~	Deleted		9-22-64			6					
~~9-010~~	~~Newell Kay et ux~~	~~Lot 41~~	~~3476 Sq.Ft.~~	Deleted		9-22-64			6					
~~9-010-1~~	~~Newell Kay et ux~~	~~Lot 43~~	~~22379 Sq.Ft.~~	Deleted		9-22-64			6					
9-011	Elwin E. Bushman et ux et al	Lot 45	80,000 Sq.Ft.	Temp.	Const	Ease.	Only		7	12-18-64	TCE 6-5-64	NOT	RECORDED	
9-012	Earl B. Westover	Lot 25 & Lot 26	73,660 Sq.Ft.	None	~~5360 Sq.Ft.~~	7500 Sq.Ft.	None	66,160 Sq.Ft.	7	12-18-64	Esm't. 9-23-64	2-11-65	215	489-490
9-013	Rupert Stock et ux et al	Lot 26	23,124 Sq.Ft.	Temp.	Const.	Ease	Only		7	12-18-64	TCE 9-23-64	NOT	RECORDED	
9-014	Jay N. Miller et ux	Lot 15	48,150 Sq.Ft.	"	"	"	"		7-8	12-18-64	TCE 6-5-64	NOT	RECORDED	
9-015	George Sleby et ux	Lot 15	48,000 Sq.Ft.	"	"	"	"		8	12-18-64	TCE 6-5-63	NOT	RECORDED	
9-016	Irvin J. Tanner et al	Lot 16	9,400 Sq.Ft.	"	"	"	"		8-9	12-18-64	TCE 6-5-63	NOT	RECORDED	
9-017	Arthur C. & Earnest J. Whiting	Lot 16	10,000 Sq.Ft.	None	None	60 Sq.Ft.	None	9,940 Sq.Ft.	9	12-18-64	Esm't. 9-2-64	1-7-65	213	368-70
9-018	Baula Bennet & Herschel P. Witt et ux	et al Lot 51	80,586 Sq.Ft.	None	None	100 Sq.Ft.	80,486 Sq.Ft.	None	9	12-1-64	TCE 9-2-64	NOT	RECORDED	
9-018-1	Marion L. Tanner	Lot 17	100,565 Sq.Ft.	None	None	340 Sq.Ft.	None	100,225 Sq.Ft.	9	12-1-64	Esm't. 9-2-64	1-7-65	213	257-58
9-018-2	~~Joseph L. Peterson~~ J.G. Petersen et ux	Lot 50	72,500 Sq.Ft.	None	None	150 Sq.Ft.	72,350 Sq.Ft.	None	9	12-1-64	Esm't 10-20-64	1-7-65	213	259-60
9-019	Edwin Webb et ux et al	Lot 18	68,200 Sq.Ft.	None	None	277.5 Sq.Ft.	None	72,222.5 Sq.Ft.	9-10	12-18-64	Esm't 9-2-64	2-11-65	215	485-86
9-020	Dennis J. Sweeney	Lot 18	25,000 Sq.Ft.	None	None	322.5 Sq.Ft.	None	24,617.5 Sq.Ft.	9	12-18-64	Esm't 9-2-64	2-11-65	215	491-92
9-021	Haward Motor Super Service Inc.	Lot 19	202,500 Sq.Ft.	Temp.	Const.	Ease.	Only		10	12-18-64	TCE 6-5-63	NOT	RECORDED	
9-022	Viron A. Hartin et al	Lot 52	79,288.5 Sq.Ft.	None	None	30.5 Sq.Ft.	79,258.5 Sq.Ft.	None	10	12-18-64	Esm't 10-20-64	2-11-65	215	487-88

NOTE:
All lots shown above are situated in Joseph City Townsite, State Plat #1 Recorded in Bk. 2, NARE, Pg. 150; Navajo County.

REDUCED SIZE

FLAGSTAFF-HOLBROOK HWY.
JOSEPH CITY STREETS
NAVAJO COUNTY

REVISIONS				PROJECT NO.	F-008-4-809
C.O.	DATE	BY	DESCRIPTION	DRAWING NO.	D-9-T-219
455	9-30-64	J.B.	Found Sec. Cors. & 1/4 Cors. shown as such; Dist. & Brgs. shown; Temp. Const. Easem'ts added; Drainage Easem'ts added; Exist. R/W just east of P.O.T. 1093 changed to be 41' each side of ℄; Fig. B2 added to Note'; Removed some Drainage Easem'ts.; P.O.T.s. added at Sec. Line Crossings. Typical R/W width shown; Note added to establish R/W width.	SHEET NO.	3 of 12
				DRAWN BY	J.E. Button
				DATE COMP.	6-64
				SCALE	1"=200'

CHECKED BY. Bradley

HARD COPY. 6359-F-1

Found Sec. Cor. - 3/4" I.P. — N.W. Cor. Sec. 16.

T.18N. R.19E.

Found 1/4 Cor. - I.P.

SPIRALS
Δ - 2°00'
a - 1
L - 200'

CURVE DATA
Δ - 5°55'00"
D - 2°00'
T - 348.50'

N.0°55'30"W. - 3948.65'

N.0°22'32"W. 1358.94'

P.O.T. 1081+41.13

P.O.T. 1134+70.47

1085 1090 1095 1100 1105 1110 1115 1120 1125 1130 1135

84 55

to Winslow

S79°49'20"E

C.S. 1085-35.81

S.C. 1087-35.81

D.a SPAIN AVE

C.S. 1090-31.64

S.T. 1093-31.64

McLAWS AVE

HANSEN AVE

RICHARDS AVE

BUSHMAN AVE

WESTOVER AVE

TANNER AVE

SHELLEY AVE

RANDALL DR

LADD ST.

Sheet #4 Sheet #5 Sheet #6 Sheet #7 Sheet #8 Sheet #9 Sheet #10 Sheet #11 Sheet #12

For R/W Width see Typical Below

S89°44'20"E

Constr. ℄ Survey ℄

to Holbrook

F-008-4-809
END R/W PROJ.

F-008-4-809
END CONSTR. PROJ.

1128+08

F-008-4-809
BEG. R/W PROJ.

1090+69

F-008-4(9)
BEG. CONSTR. PROJ.

N.0°55'30"W. - 1472.40'

N.0°22'32"W. 1292.85'

Found Sec. Cor. - 3/4" I.P.
W.C. 66' E. in Fence Line

Found Sec. Cor. - I.P. ℄
Brass Cap U.S.G.L.O. 1944.

INDEX:

The 82' existing R/W shown hereon is in accordance with the Easement from Navajo Co. Board of Supervisors to State Hw'y. Dept. date 9-9-39. Recorded in Book 7, Page 219, on 9-9-39, EXCEPT AS FOLLOWS:

(A) M.P. Rogers-Widow-Parcel 1235-Easement-Recorded 2-24-56; Vol. 77, Pgs. 287-288.

(B) O.W. Rogers, et ux - Parcel 1236-Easement-Recorded 2-24-56; Vol. 77, Pgs. 289-290.

(C) J. McLaws, et ux - Proj. 40E-Easement-Recorded 3-22-32; Bk. 5, N.A.R.E., Pgs. 337-338.

VICINITY MAP
SCALE: 1"=200'

Med. ℄

41'

40'

Typical showing R/W width
From Stas. 1093 to 1134+70.47

Note:
The existing R/W as established by the Arizona Highway Dept. Res. _____ dated _____ is 40' each side of the Const. ℄ Survey ℄.

Click here for SR 40B Index

REDUCED SIZE

DIEVEGEN 120 IMPERIAL 200 8-63

FLAGSTAFF-HOLBROOK HWY.
JOSEPH CITY STREETS
NAVAJO COUNTY

REVISIONS				PROJECT NO.	F-008-4-809
C.O.	DATE	BY	DESCRIPTION	DRAWING NO.	D-9-T-219
455	9-2-64	J.B.	"N. Line shown as Approx. ℄ Dry on R"; New Slope Lines ment removed;	SHEET NO.	4 of 12
5825	6-18-81	D.J.H.	Added abandoned area note & x-ip.	DRAWN BY	J.E.B.
				DATE COMP.	6-64
				SCALE	1"=20'

CHECKED BY. Pallen

HARD COPY 63359-T-1

Area abandoned per Res. No. 78-16-A-54, Rec. 10-17-78, Dkt. 535, Pgs. 906-11.

LOT-35

LOT-37

DE SPAIN AVE.

TOTAL CURVE
Δ = 9°55'00" Lt.
R = 2865.37'
T = 348.59'
L = 695.83'
Ext = 11.34'

MAIN CURVE
Δ = 5°55'00" Lt.
D = 2°00'
R = 2864.79'
L = 295.83'

SPIRAL
a = 1
Δ = 2°00'
L = 200'
o = 0.58'
t = 100'

SPIRAL
a = 1
Δ = 2°00'
L = 200'
o = 0.58'
t = 100'

1086 1087 1088 1089 1090 1091 1092

SC 10877+35.81

CS 1090+31.64

N0°29'E 82.3' S0°02'W

1036' Lt 1090+10

Frame House

Exist. R/W

20'R 20'R

50' 50' 50' 50'

22' 22'

Construction ℄ Survey ℄

36' 36' 24' 32' 24' 32'

Slope Limits

20'

Exist. R/W

Exist. Cons.

N89°38'E 1/16 Sec. Line

East Cons.

Pump Island

16'

55' Rt 1088+39

Garage

48' Rt 1088+58

Cafe

73.5' Rt 1089+37

Pump Islands

80.8' Rt 1089+99

58.2' Rt 1089+99

1090+50

Temporary Constr. Easement

Serv. Sta.

9-001 DELETED

9-002

102.8' Rt 1090+80

123.2' Rt 1089+77

Gasoline Storage Tanks

F-008-4-191
BEGIN CONST. PROJ.

1090+68

F-008-4-809
BEGIN R/W PROJ.

153.4' Rt 1091+16

Frame House

114' Rt 1087+91

Frame House

LOT-34

A B C

Click here for SR 40B Index

FLAGSTAFF–HOLBROOK HWY.
JOSEPH CITY STREETS
NAVAJO COUNTY

REVISIONS					
C.O.	DATE	BY	DESCRIPTION	PROJECT NO.	F-008-4-809
455	9-26-64	J.B.	1/16 Lines shown at 'Approx.' & Brgs at 'R'; Corners shown as Not Fnd.; New Slope Easemt removed; 10'x20' Const Easement removed; Note added to establish Exist R/W width.	DRAWING NO.	D-9-T-219
				SHEET NO.	5 of 12
				DRAWN BY	JEB
				DATE COMP.	6-64
				SCALE	1"=20'

CHECKED BY. 'MILLEY

HARD COPY. 6359-T-1

Click here for SR 40B Index

Not Found

T18N R15E

AVENUE

LOT-37

LOT-38

LOT-40

9-003

1092

1093

1094

1095

1096

1097

1098

ST. 1092+31.64

POT. 1092+50

1003+02.25

82.5'

40'

15'R Typ.

Exist R/W

201.9'(R)

N0°42'W(R)

1/16 Sec. Line

Approx.

Exist R/W (See Note)

200'(R)

641'Lt. 1096+37

Conc. House

Frame House

644'Lt. 1097+234

N0°40'E

78.9'

AVENUE

1007+86

Construction & Survey ℄

S89°44'20"E

Approx. 1/16 Sec. Line

N89°38'E(R)

S.E. Cor. of N.W.¼ of S.W.¼ of Sec. 16

Not Fnd.

79'(R)

54.9'(R)

197.9'(R)

20'

24'

32'

40'

Exist R/W

N.E. Cor Lot 34

N.W. Cor Lot 33

N.E. Cor Lot 32

Temporary Constr. Easement

725'Rt. 1003+58.9

765'Rt. 1004+12.8

694'Rt. 1005+27.2

638'Rt. 1006+28.2

699'Rt. 1007+03.7

Shed

Brick House

House

Conc. Slab

Conc. House

N0°02'E

130'(R)

N0°35'E

N0°16'E

80.3'

77'(R)

LOT-34

LOT-33

LOT-32

9-002

9-004

9-005

9-006

9-007

9-008

Mc LAWS

HANSEN

Note:
The existing R/W as established by the Arizona Highway Dept. Res. _____ dated _____ is 40' each side of the Const. & Survey ℄. (From McLaws Ave. East.)

REDUCED SIZE

DIETZGEN 126 IMPERIAL 200 R-63

FLAGSTAFF-HOLBROOK HWY.
JOSEPH CITY STREETS
NAVAJO COUNTY

REVISIONS				PROJECT NO.	F-008-4-809
C.O.	DATE	BY	DESCRIPTION	DRAWING NO.	D-9-T-219
455	9-28-64	J.B.	1/16 Line shown as Approx.; Brg. as 'R.'; 2 Drainage Easements removed; Note added to establish Exist R/W width	SHEET NO.	6 of 12
				DRAWN BY	JEB.
				DATE COMP.	6-64
				SCALE	1"=20'

CHECKED BY. _____

HARD COPY 6359-T-1

Motel

AVENUE

Service Station

LOT-41

1098

1099

1097+86

N0°21'E

534' Lt 1098+78.2

40.3' Lt 1099+32.7

15 R

Pump Island

199.8'(R)

Exist. R/W (See Note)

9-010

9-010-1

N0°17'E

PROT. 1100

Brick House

1101

65' Lt 1101+03.9

LOT-43

N0°46'E

40' Lt 1101+59

Building

Building

1102

Grocery

40' Lt 1102+25

200'(R)

79.3'

AVENUE

1102+61.20

40'

1103

N7°13'E

Service Station

Conc Slab

528' Lt 1103+08

LOT-44

Motel

525' Lt 1103+82

1104

Pump Islands

Exist. R/W (See Note)

1948'(R) to S.E. Cor. Lot 44

40' Lt 1103+23

32'

24'

Construction ℄ Survey ℄

S 89°44'20"E

Approx. 1/16 Sec. Line

N89°38'E.(R)

N.E. Cor. Lot 28

199.0'(R)

15 R

40'

Exist. R/W (See Note)

N.W. Cor. Lot 27

193.2'(R) to N.E. Cor. Lot 27

N.W. Cor. Lot 29

201.5'(R)

Exist. R/W (See Note)

N.E. Cor. Lot 29 N.W. Cor. Lot 28

15 R

74 R

1097+85

N0°07'W

760' Lt 1099+12

Restaurant

LOT-29

9-009

100'(R)

N0°01'E

48'(R)

704' Rt 1101+03

Frame House

LOT-28

42' Rt 1101+54

1101+54

415' Rt 1102+27

Business Building

N0°42'W

1102+63

79.0'

N0°03'W

675' Rt 1103+90

RICHARDS

LOT-27

LDS Church

HANSEN

Note:
The existing R/W as established by the Arizona Highway Dept. Res. _____ dated _____ is 40' each side of the Const. & Survey ℄.

Click here for SR 40B Index

DIETZGEN 135 IMPERIAL 200 3-63

FLAGSTAFF–HOLBROOK HWY.
JOSEPH CITY STREETS
NAVAJO COUNTY

REVISIONS				PROJECT NO.	F-008-4-809
C.O.	DATE	BY	DESCRIPTION	DRAWING NO.	D-9-T-219
415	8/76A	J.B.	Added 25'x300' Drainage Easc. to Parcel 9-012. Changed New R/W to Temp. Const. Ease.; Added Trees.	SHEET NO.	7 of 12
455	9/26A	J.B.	1/16 Lines shown as Approx.; Brgs. as R'; Lot Line added between Lots 25 & 26 thru Drain. Easmt. with distanes chgd accordingly. Corners shown Not Fnd. Note added to establish Exist. R/W width.	DRAWN BY	J.E.B.
				DATE COMP.	6-64
				SCALE	1"=20'

Click here for SR 40B Index

HARD COPY 6359-T-1 CHECKED BY Halley

Motel
LOT-44
Business Building
LOT-45
9-011
Frame House
LOT-46
LOT-47
1104
1105
1106
1107
1108
1109
P.O.T. 1110
50.5' Lt. 1103+82
62.8' Lt. 1104+22
S 2°40'W
932' Lt. 1106+38
N 2°14'E
91.0'
BUSHMAN AVE.
N 1°18'2"
N 0°31'W (R)
Approx. 1/4 Sec. Line
S 1°25'W
Not Found
Temporary Const. Easement
15' R
40'
15' R
10'
Typ.
1107+40.71
199.8' (R)
Exist. R/W (See Note)
198.0' (R)
Exist. R/W (See Note)
Approx. 1/16 Sec. Line N89°38'E (R)
S89°44'20"E
Construction & Survey ℄
Not Found
S.E. Cor. of N.E.1/4 of S.W.1/4 of Sec. 16
24'
32'
24'
32'
32'
24'
Exist. R/W (See Note)
Fence Cor. 40.8' Rt. Sta. 1105+00
60' Rt. Sta. 1105+00
Const. Ease.
Craig-Link Fence ℄ (Apparent Lot Line)
311.9' (R)
Exist. R/W (See Note)
238.5'
20'
268'
℄ Slope Limits
177.5' (R)
10'
10'
Exist. R/W (See Note)
N.E. Cor. Lot 26
N.W. Cor. Lot 15
Temporary Const. Easement
12.5'
25'
Drainage Easement
60' Rt. Sta. 1107+68
70.7' Rt. 1108+30
House
9-012
9-013
9-014
LOT-15
NOSTAW
25'x300'
200'
100'
LOT 26
LOT 25
LOT-27
L.D.S. Church
Not Found

Note:
The existing R/W as established by the Arizona Highway Dept. Res.____ dated____ is 40' each side of the Const. & Survey ℄.

REDUCED SIZE

FLAGSTAFF–HOLBROOK HWY.
JOSEPH CITY STREETS
NAVAJO COUNTY

REVISIONS				
C.O.	DATE	BY	DESCRIPTION	
455	9-28-64	J.B.	1/16 Line shown as Approx.; Brg as R; Note added to establish Exist. R/W width.	

PROJECT NO.	F-008-4-809
DRAWING NO.	D-9-T-2.9
SHEET NO.	8 of 12
DRAWN BY	JEB
DATE COMP.	6-64
SCALE	1"=20'

CHECKED BY. Pfaller

HARD COPY... 6359-T-1

LOT-47

Frame House

Conc House

WESTOVER AVE.

Brick House

LOT-48

LOT-49

House

House

P.O.T. 1110

S 1°25' W

776' Lt. 1110+70

871' Lt. 1111+48

1111

1112

1112+27

1113

1114

1115

1116

810'

1214' Lt. 1112+93

834' Lt. 1114+646

S 1°14' W

842' Lt. 1114+91

15' R typ.

40'

15' R

Exist. R/W (See Note) 199.3'(R)

Exist. R/W (See Note) 198.4'(R)

204.0'(R) to S.E. Cor. Lot 49

24'

32'

Approx. 1/16 Sec. Line N 89°38' E. (R)

Construction & Survey ℄ S 89°44'20" E

Exist. R/W (See Note)

10'

Temporary Constr. Easement

45' Rt. 1111+68

4'

1111+89

Cafe

615.8'(R)

1.5' Cor Lot 26 N.W. Cor Lot 15

N 0°51' W

235' Rt. 1110+82

Conc House

9-014

62' Rt. 1113+00

Brick Motel

9-015

LOT-15

Exist. R/W (See Note)

N.E. Cor. Lot 15 N.W. Cor Lot 16

88.1' Rt. 1115+02.3

Building

S 1°46' W

9-016

Note:
The existing R/W as established by the Arizona Highway Dept. Res. _____ dated _____ is 40' each side of the Const. & Survey ℄.

Click here for SR 40B Index

REDUCED SIZE

FLAGSTAFF-HOLBROOK HWY.
JOSEPH CITY STREETS
NAVAJO COUNTY

REVISIONS				PROJECT NO.	F-008-4-809
C.O.	DATE	BY	DESCRIPTION	DRAWING NO.	D-9-T-219
455	9-28-64	J.B.	Changed New R/W To Temp. Const Easc. Added 2 Drainage Easmts; Marked 1/16 Lines as Approx.'d Brgs as R; Cors. marked 'Not Fnd.'; Note added to establish Exist. R/W. width.	SHEET NO.	9 of 12
				DRAWN BY	JEB
				DATE COMP.	6-64
				SCALE	1"=20'

CHECKED BY. Fuller

HARD COPY 6359-T-1

LOT-49 Brick House 1116 731'Lt 1116+37 NO°35'E 80.1' TANNER AVE. 55'(R) Conc House 129.5'Lt 1117+57 LOT-50 House 1117 1117+005 1118 150'(R) NO°35'E 85'Lt 1118+54 New Drainage Easement 1119 9-018-2 S0°30'W 128'Lt 1119+62 Frame Motel POT. 1120 LOT-51 9-018 Service Station 1121 Rental Rooms Not Found N0°04'E 105'Lt 1121+30 SHELLEY AVE. 1122 72'Lt 1120+61 Rest Rooms 227'Lt 1121+23 41'Lt 1121+17 Pump Islands Temporary Constr. Easement 1121+88

Exist. R/W (See Note) 15'R 40' 15'R 200.6'(R) 3'Gole 15' 10' 68' 200'(R) Exist. R/W (See Note) 10' 15'R 40' 15'R

Approx. 1/16 Sec. Line N89°38'E (R) Not Fnd. S.E. Cor. of N.W.1/4 of S.E.1/4 of Sec.16

Construction & Survey ℄ S89°44'20"E

24' 32' 24' 32' 32' 24'

N.E. Cor Lot 15 N.W. Cor Lot 16 Exist. R/W (See Note) 241.7'(R) Slope Limits 100' 10' Temp Const Easement 124' 30' 3' 17' 20' 106.5' 10' Slope Limits 280.1' to N.E. Cor Lot 18 10' Exist. R/W (See Note) 21.5' 15' 18.5' Temp. Const. Easement

N.E. Cor. Lot 16 N.W. Cor Lot 17 1118+25 New Drainage Easement Temporary Constr. Easement 1118+75 1119+22 Slant 1119+38 41'Rt. 1119+39 N.E. Cor Lot 17 N.W. Cor Lot 18 New Drainage Easement

41'Rt. Sta 1116+18± 51'Rt. Sta 1116+18± S1°46'W 100'(R) 100'(R) S0°15'E 68'Rt. 1118+92 69'Rt. 1120+17 200'(R) N0°20'W (R) 1/16 Sec. Line 200'(R)

9-016 9-017 9-018-1 9-019 9-020 9-019

LOT-16 LOT-17 LOT-18

157'Rt. 1116+13 Frame House Frame House Frame House

Approx. Not Found

Note:
The existing R/W as established by the Arizona Highway Dept. Res. _____ dated _____ is 40' each side of the Const. & Survey ℄.

REDUCED SIZE

DIETZGEN 136 IMPERIAL 200 8-63

Click here for SR 40B Index

FLAGSTAFF-HOLBROOK HWY.
JOSEPH CITY STREETS
NAVAJO COUNTY

REVISIONS				PROJECT NO.	F-008-4-809
C.O.	DATE	BY	DESCRIPTION	DRAWING NO.	D-9-T-219
455	9/64	J.B.	1/16 Line shown as Approx. ℄ Brg as R' Drainage Easem't added. Note added to establish Exist. R/W width.	SHEET NO.	10 of 12
501	10/64	J.B.	Changed Drain. Easement Lt. P.O.T. 1122+33	DRAWN BY	J.E.B.
				DATE COMP.	6-64
				SCALE	1"=20'

HARD COPY 6359-T-1 CHECKED BY Fuller

SHELLEY AVE.

1121+89

1122

S0°04'W

9-022

1123

LOT-52

Garage 134.5' Lt. 1123+86

House 67.5' Lt. 1123+49

1124

S5°26'E

63.5' Lt. 1124+86

Conc. House

1125

Garage 110.2' Lt. 1125+30

LOT-53

1126

Conc. House 86.2' Lt. 1126+80.2

1127

S5°35'E

LOT-54

1128

New Drainage Easement

Temp. Const. Easement

15'R

7'

Exist. R/W (See Note)

2240'(R)

2740'(R)

Exist. R/W (See Note)

Approx. 1/16 Sec. Line ℄

N89°38'E.(R)

Construction ℄ Survey ℄

S89°44'20"E

24'

32'

21.5'

1.5'

30'

18.5'

Exist. R/W (See Note)

10'

Temp. Const. Easement

N.E. Cor. Lot 18 N.W. Cor. Lot 19

E Slope Limits

219'

402.5'(R)

1124+50±

Exist. R/W (See Note)

10'

15'R

N.E. Cor. ℄ of 19

40'

15'R Typ.

N.W. Cor. Lot 22

Exist. R/W (See Note)

200'(R)

New Drainage Easement

S1°16'E

LOT-18

9-020

9-019

104.1' At 1123+10

LOT-19

9-021

Brick House

S2°02'E

1126+67

700'

LADD AVE.

N1°23'W

396.1' At 1127+07

Building

231.1' At 1127+91.0

LOT-22

Brick House

Note:
The existing R/W as established by the Arizona Highway Dept. Res. _____ dated _____ is 40' each side of the Const. ℄ Survey ℄.

Click here for SR 40B Index

REDUCED SIZE

DIETZGEN 128 IMPERIAL 800 9.83

FLAGSTAFF–HOLBROOK HWY.
JOSEPH CITY STREETS
NAVAJO COUNTY

REVISIONS				
C.O.	DATE	BY	DESCRIPTION	
455	9-28-64	J.B.	"1/16 Line shown as Approx. ℄ Brg. as 'R'. Note added to establish Exist R/W width.	

PROJECT NO.	F-008-4-809
DRAWING NO.	D-9-T-219
SHEET NO.	11 of 12
DRAWN BY	J.E.B.
DATE COMP.	6-64
SCALE	1"=20'

CHECKED BY. Pauley

HARD COPY. 6359-T-1

LOT-54

LOT-55

LOT-84

1128 | 1129 | POT. 1130 | 1131 | 1132 | 1133 | 1134

N5°42'W

N10°01'W

To S.W. Cor. Lot 54 ~ 232.4' (R)

Exist. R/W (See Note)

339.7'(R)

164.8'(R) to S.E. Cor. Lot 84

Approx. 1/16 Sec. Line
N89°38'E (R)

Construction ℄ Survey ℄

S89°44'20"E

32' | 24' | 66'

To N.W. Cor. Lot 22 ~ 509.4' (R)

Exist. R/W (See Note)

N.E. Cor. Lot 22
N.W. Cor. Lot 24

38.8' R

2520'-S39°42'E (R)

N0°10'E

84' Rt 1129+50 Hogan

93.6' Rt 1130+21

90' Rt 1131+60 Hogan

LOT-22

Trading Post

LOT-24

F-008-4(9)
END CONST. PROJ.

F-008-4-809
END R/W PROJ.

1128+08

BEGIN R/W PROJ.

Note:
The existing R/W as established by the Arizona Highway Dept. Res.____ dated____ is 40' each side of the Const. ℄ Survey ℄.

Click here for SR 40B Index

REDUCED SIZE

DIETZGEN 133 IMPERIAL 800 8-63

FLAGSTAFF-HOLBROOK HWY.
JOSEPH CITY STREETS
NAVAJO COUNTY

REVISIONS				PROJECT NO.	F-008-4-809
C.O.	DATE	BY	DESCRIPTION	DRAWING NO.	D-9-T-219
455	9-2864	J.B.	Sec. Cor. & 1/4 Cor. marked 'Found'; Dist. from 1/4 Cor. to	SHEET NO.	12 of 12
			E changed; 1/16 Line shown as 'Approx.'; 1/16 Cor. shown	DRAWN BY	JEB
			'Not Found'; Note added to establish Exist R/W	DATE COMP.	6-64
			width.	SCALE	1"=20'

CHECKED BY. Bailey

HARD COPY. 6359-T-1

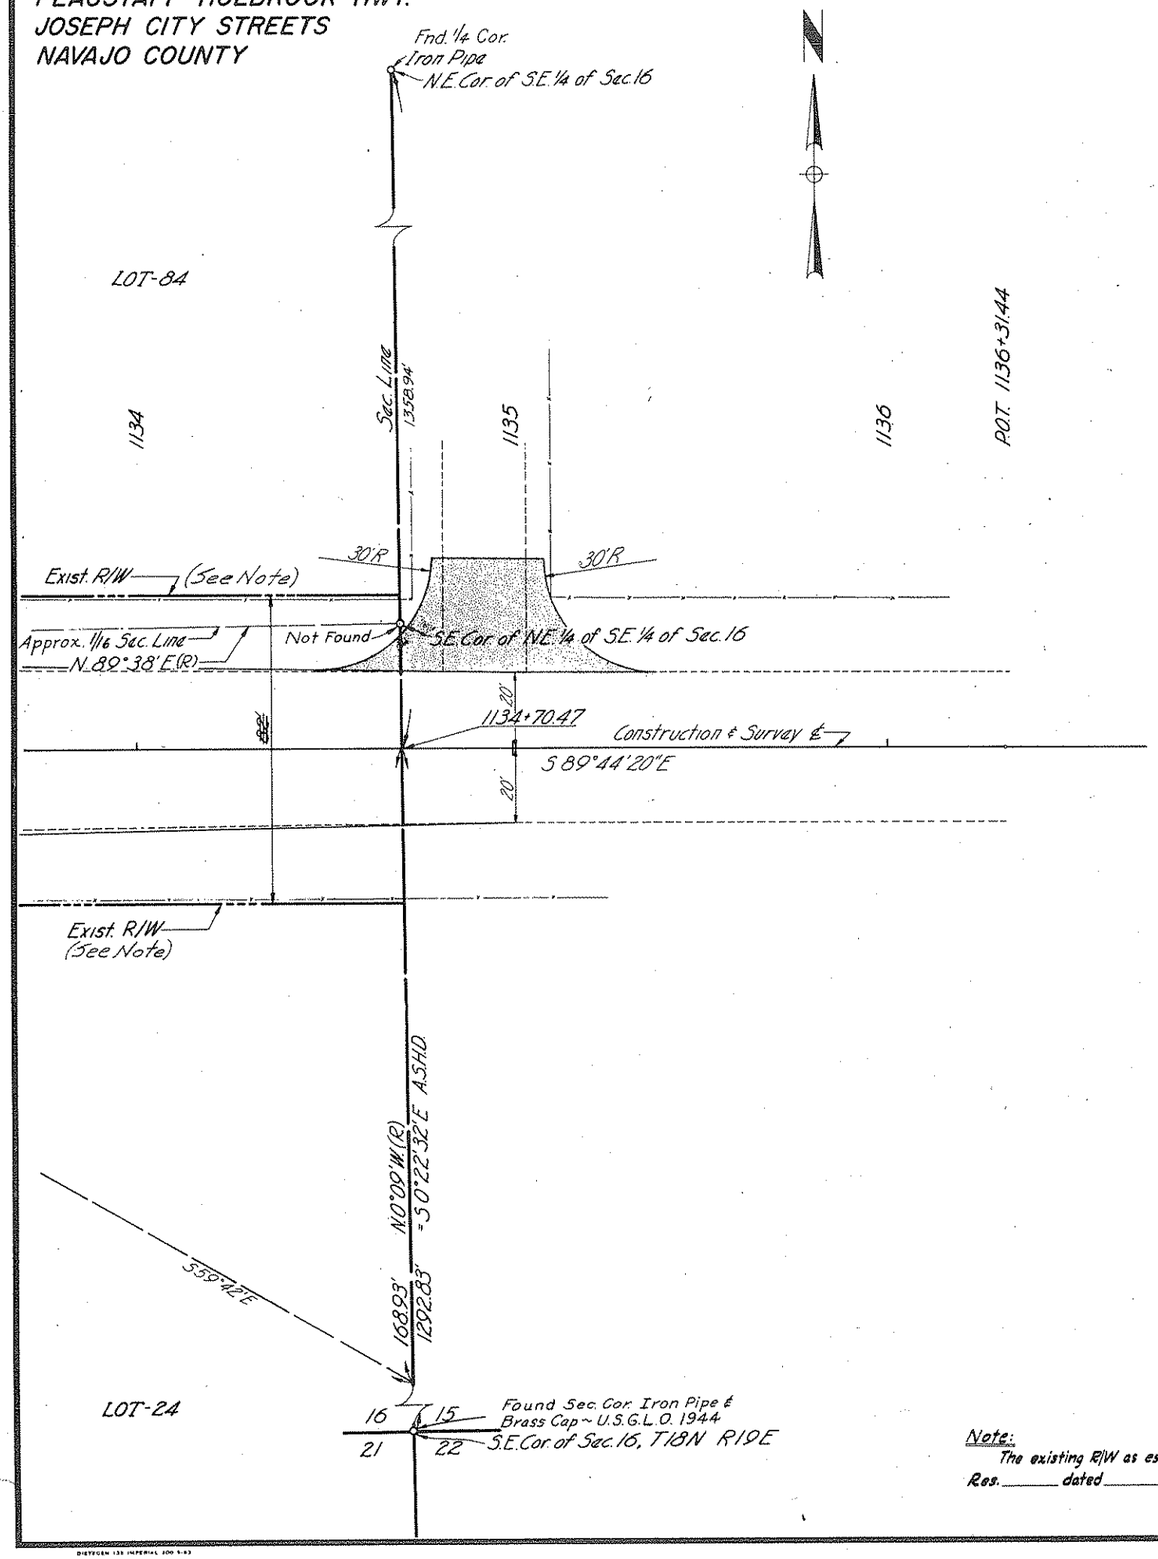

Note:
The existing R/W as established by the Arizona Highway Dept. Res. _____ dated _____ is 40' each side of the Const. & Survey ℄.

Click here for SR 40B Index

REDUCED SIZE

DIETZGEN 135 IMPERIAL 200 5-63