B-2 T 383

NOGALES ~ LOWELL HWY.

BUENA SCHOOL ~ MILLER CANYON SECTION

COCHISE COUNTY

FED. RD. DIV. NO.	STATE	PROJECT NO.	SHEET NO.	TOTAL SHEETS	AS BUILT
7	ARIZ.	F-012-1(5)	5	13	

OWNERSHIP RECORD

ITEM	OWNER	DESCRIPTION
A-303	Laura Louella Wilcox	SW1/4 SW1/4 NW1/4 & N1/2 NW1/4 N W1/4 SW1/4 Sec. 17 T.23S. R.21W.
A-304	Nick Gregovich	Sec. 18 T.23S. R.21W.

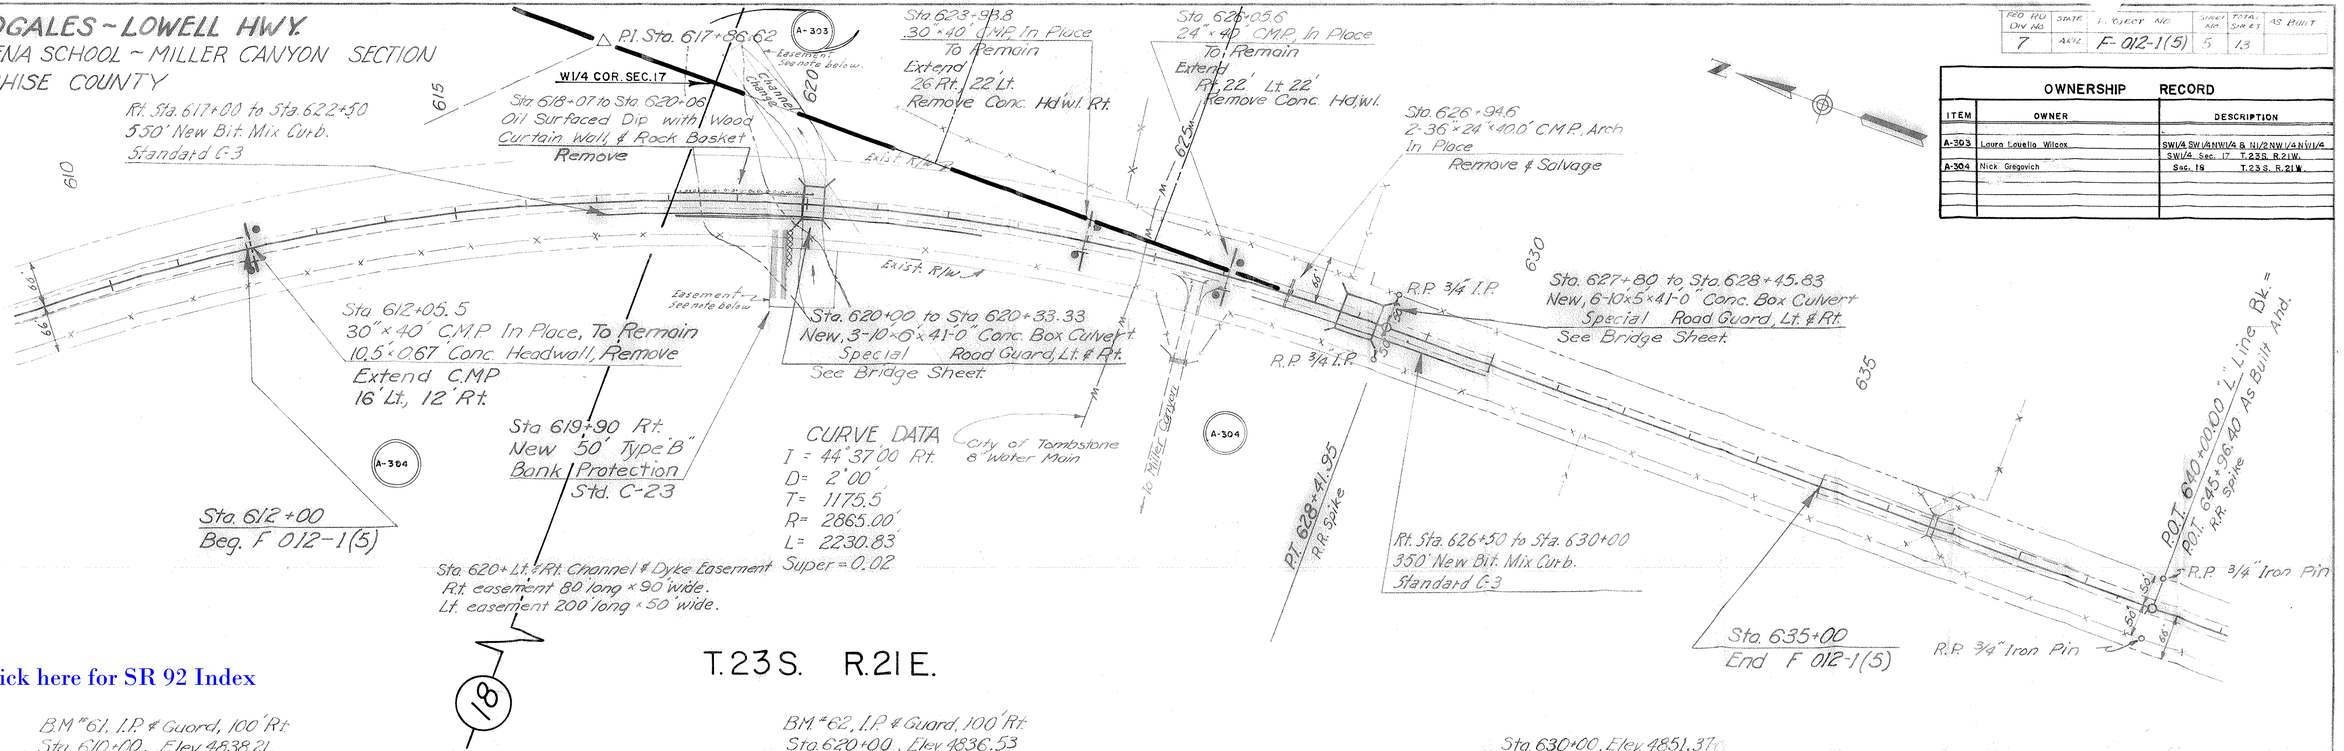

Click here for SR 92 Index

B-2T-383