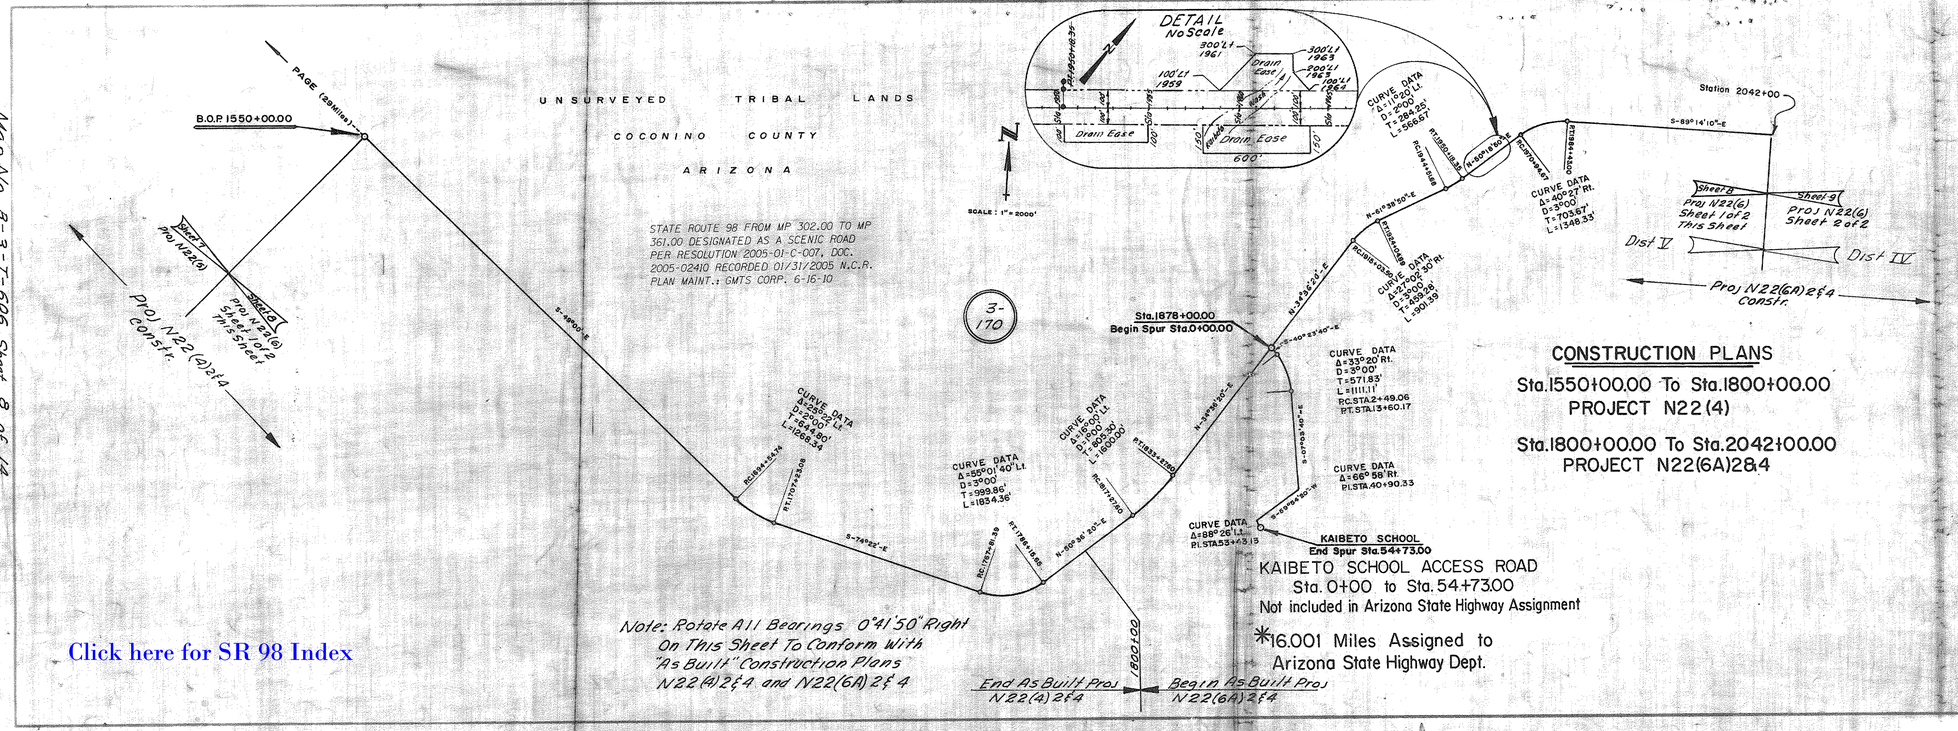

Note: Rotate All Bearings 0°41'50" Right On This Sheet To Conform With "As Built" Construction Plans N22(4) 2&4 and N22(6A) 2&4

CONSTRUCTION PLANS

Sta.1550+00.00 To Sta.1800+00.00
PROJECT N22(4)

Sta.1800+00.00 To Sta.2042+00.00
PROJECT N22(6A)2&4

Click here for SR 98 Index

U.S. DEPARTMENT OF THE INTERIOR
BUREAU OF INDIAN AFFAIRS
NAVAJO AREA · BRANCH OF ROADS
NAVAJO
INDIAN RESERVATION
RIGHT OF WAY MAP

760 5569

ROUTE NO. 22 PROJ. N22(6) LENGTH ~~17.038~~ 387.903 MI. *16.001 MI.

100 Feet left and 100 Feet right of ℄ of road ~~412.120~~ Acres

STATE OF ARIZONA
COUNTY OF COCONINO } SS

ROMAN E. WELFL, Being duly sworn, says he is the AGENCY Road Engineer, NAVAJO INDIAN RESERVATION, Bureau of Indian Affairs, Navajo Area Office, herein after designated the applicant, that the survey of Project N22(6) over and across Indian Lands, County of COCONINO was made under his direction and authority of the Bureau of Indian Affairs, and that such survey is accurately represented on this map which consists of 2 sheet

BUREAU OF INDIAN AFFAIRS
Roman E. Welfl
Agency Road Engineer

Sworn and subscribed to me on this 2nd day of September 1966.

Margy J. Betts
Notary Public in and for the County of Coconino
My commission expires Feb 16, 1968

APPROVED:
Pursuant to the provisions of the Act of February 5, 1948 (62 Stat 17) and the Department Regulations 25 CFR 161 and 162 (Revised January 1, 1958) subject to any prior valid existing right or claim. Damages Waived. Tribal Resolution No. CN-5E-47

Asst. AREA DIRECTOR Date
Tribal Council Date 9-27-66

The State of Arizona being satisfied that the map and survey hereon shown is of sufficient accuracy, herewith accepts this map of definite location

Approved: Wm. N. Price for Date 7/22/76
State Engineer

Arizona State Route 98
ADOT Project No S-559-601
ADOT Right of Way Map No. B-3-T-606
Sheet No. 8 of 14

Sheet No. 1 of 2

Map No. B-3-T-606 Sheet 8 of 14